



7855 SPRING DR. RESIDENCE

SCOPE OF WORK

DECONSTRUCTION & RECONSTRUCTION OF NEW SINGLE FAMILY RESIDENCE

ZONING

ER (ESTATE RESIDENTIAL)
FRONT SETBACK: 35 FEET
SIDE SETBACK: 10 FEET
REAR SETBACK: 25 FEET
HEIGHT LIMIT: 30 FEET

LOT AREA = 2.1 ACRES

FLOOR AREAS

PREVIOUS:

BASEMENT: 798 SF
MAIN FLOOR: 1,940 SF
SECOND FLOOR: 702 SF
SHED: 196.42 SF

*TOTAL RSF = 3,636.42 SF
(DECONSTRUCTED)

PROPOSED:

BASEMENT: 1,529 SF
MAIN FLOOR: 3,051 SF
SECOND FLOOR: 695 SF
GARAGES: 1,173 SF

*TOTAL RSF = 6,448 SF

4 BED, 5.5 BATH

TOTAL PROPOSED
CONDITIONED SF
= 5,275 SF

TRANSFERABLE DEVELOPMENT CREDITS
REQ'D OVER 6,000 SF

CODES

- 2021 IRC + LOCAL AMENDMENTS
- 2023 NEC
- WILDFIRE ZONE 2 (IGNITION RESISTANT CONSTRUCTION & 3' GRAVEL BORDER) - WILDFIRE PARTNERS PATH
- 13D FIRE SPRINKLER REQ'D
- HERS 0 ENERGY RATING

GRADING CALCS

SEE CIVIL PLANS


SITEWORK

- EXISTING DRIVEWAY ACCESS
- UPGRADE EXISTING SEPTIC
- UPGRADE EXISTING 200 AMP ELECTRICAL SERVICE
- PROVIDE EROSION CONTROL
- REVEGETATION W/ NATIVE SEED REQ'D AT ALL AREAS OF DISTURBANCE

Plains Seed Mix

Below 5,500 Feet Elevation

Common Name	Species Name	Variety	% of Mix	#PLS/ Acre
Side Oats Grama	<i>Bouteloua curtipendula</i>	Vaughn	15%	2.74
Blue Grama	<i>Bouteloua gracilis</i>	Native, Alma, or Hachita	20%	0.84
Buffalograss	<i>Buchloe dactyloides</i>	Native	15%	9.33
Western Wheatgrass	<i>Pascopyrum smithii</i>	Arriba	12.5%	3.96
Western Wheatgrass	<i>Pascopyrum smithii</i>	Native	12.5%	3.96
Little Bluestem	<i>Schizachyrium scoparium</i>	Cimarron or Pastura	13%	1.74
Green Needlegrass	<i>Stipa viridula</i>	Lodorm or Native	12%	2.31
Totals:			100%	24.88

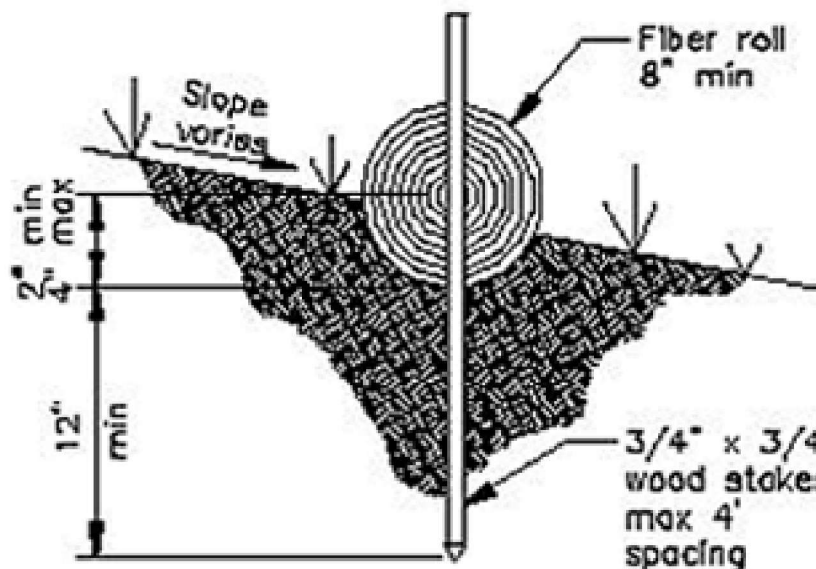

Driveway Section
1/4" = 1'-0"

Drawing Index

Sheet Number	Sheet Name
000-A	Site Plan & Cover
1	Grading Plan
A100	Basement Plans
A101	Main Floor Plan
A102	Second Floor Plan
A103	Roof Plan
A200	Exterior Elevations
A201	Exterior Elevations
A202	Renderings & Materials
A300	Building Sections
A400	Wall Sections
A401	Schedules & Details
A500	Fireplace Details
A600	Interior Views
E0.1	One Line Diagram
E0.2	Basement Electrical
E1	Level 1 Electrical
E2	Level 2 Electrical
S1.1	Foundation Plan
S1.2	Main Floor Framing Plan
S1.3	Upper Floor & Lower Roof Framing Plan
S1.4	Upper Roof Framing Plan
S2.1	Foundation Details
S2.2	Framing Details

enContext Architecture, llc
Integrate. Iterate. Generate.
www.Context-Architect.com

THESE DOCUMENTS ARE PROVIDED FOR THE DESIGN INTENT OF THIS SPECIFIC PROJECT AND ONLY THIS PROJECT. THE CONTRACTOR SHALL BE RESPONSIBLE FOR ALL CONSTRUCTION COORDINATION, METHODS, AND SEQUENCING. THE ARCHITECT SHALL NOT BE RESPONSIBLE FOR THE COMPLETION OF THE PROJECT. THIS INCLUDES BUT IS NOT LIMITED TO THE QUALITY OF WORKMANSHIP AND MATERIALS REQUIRED FOR EXECUTION OF THESE DOCUMENTS AND WORK OR MATERIALS SUPPLIED BY ANY SUBCONTRACTORS. ALL WORK SHALL COMPLY WITH ALL GOVERNING CODES AND ORDINANCES. THE ARCHITECT SHALL BE RESPONSIBLE FOR VERIFYING ALL DOCUMENTS AND SHALL NOTIFY THE ARCHITECT IMMEDIATELY OF ANY DISCREPANCIES IN THE DRAWINGS, FIELD CONDITIONS OR DIMENSIONS.


7855 SPRING DRIVE
BOULDER, CO 80303
NEW RESIDENCE


CONSTRUCTION SET -
REV 2
1/16/26

SHEET
No.

000-A

Site Plan & Cover

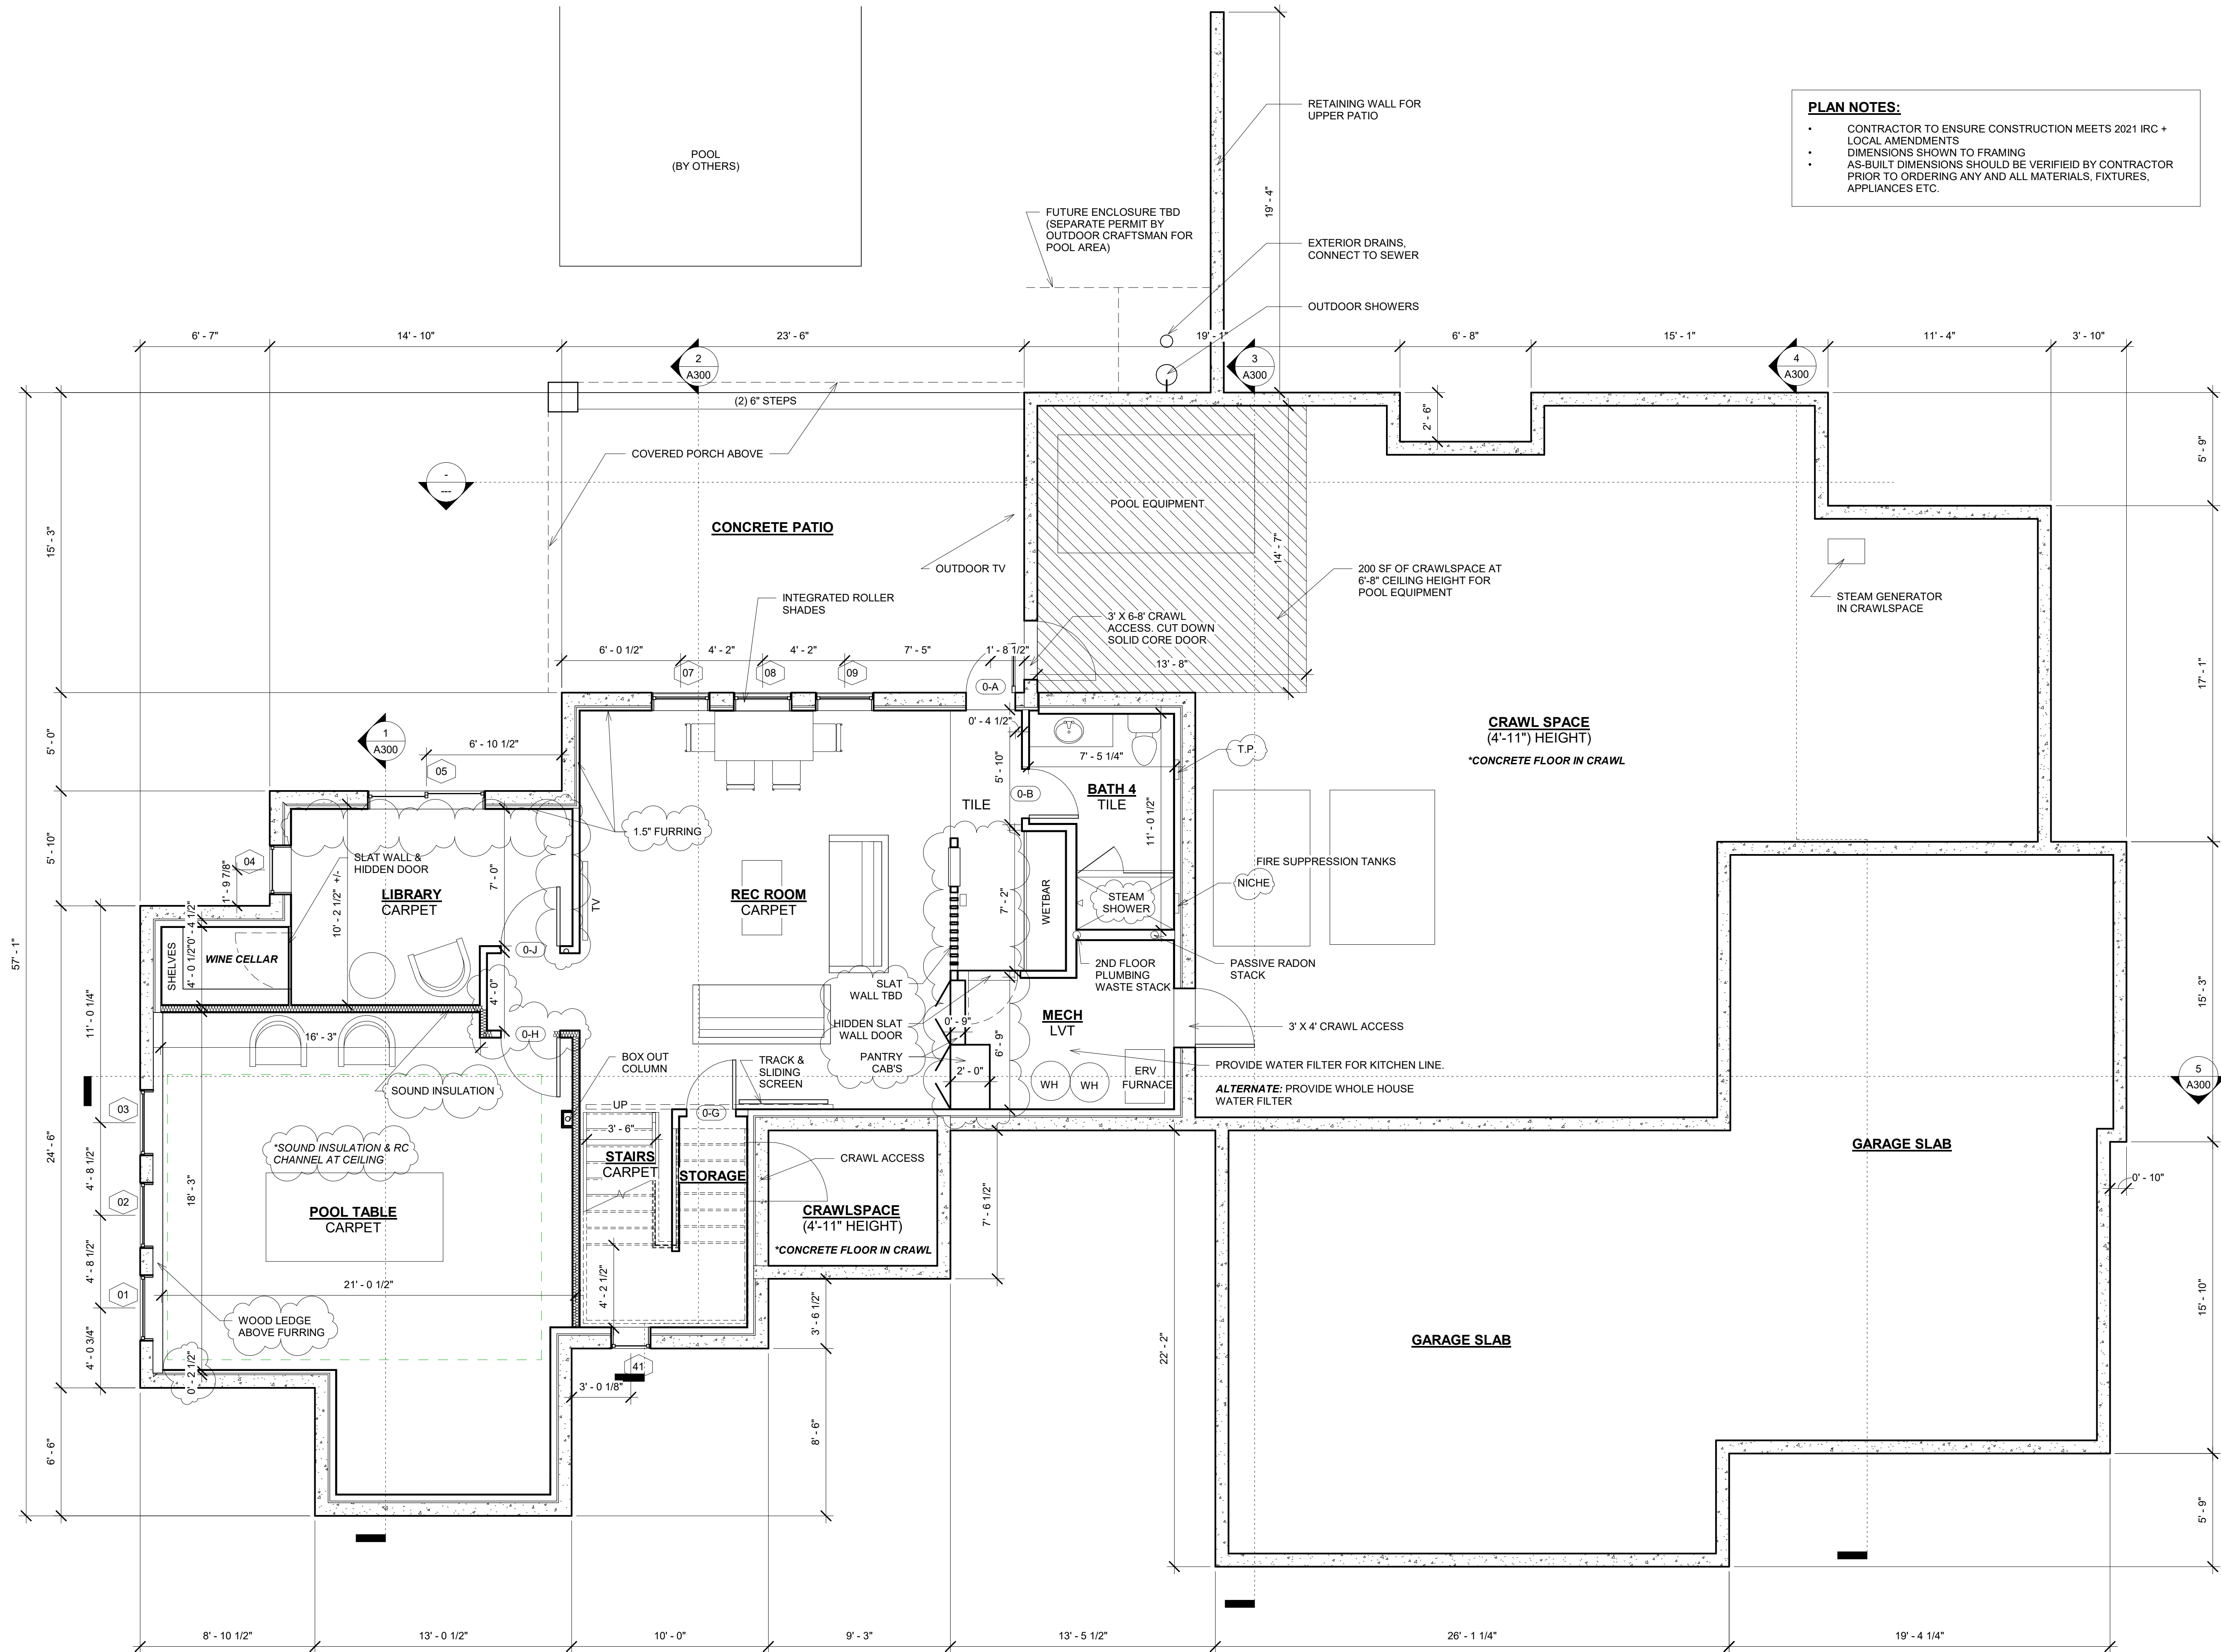

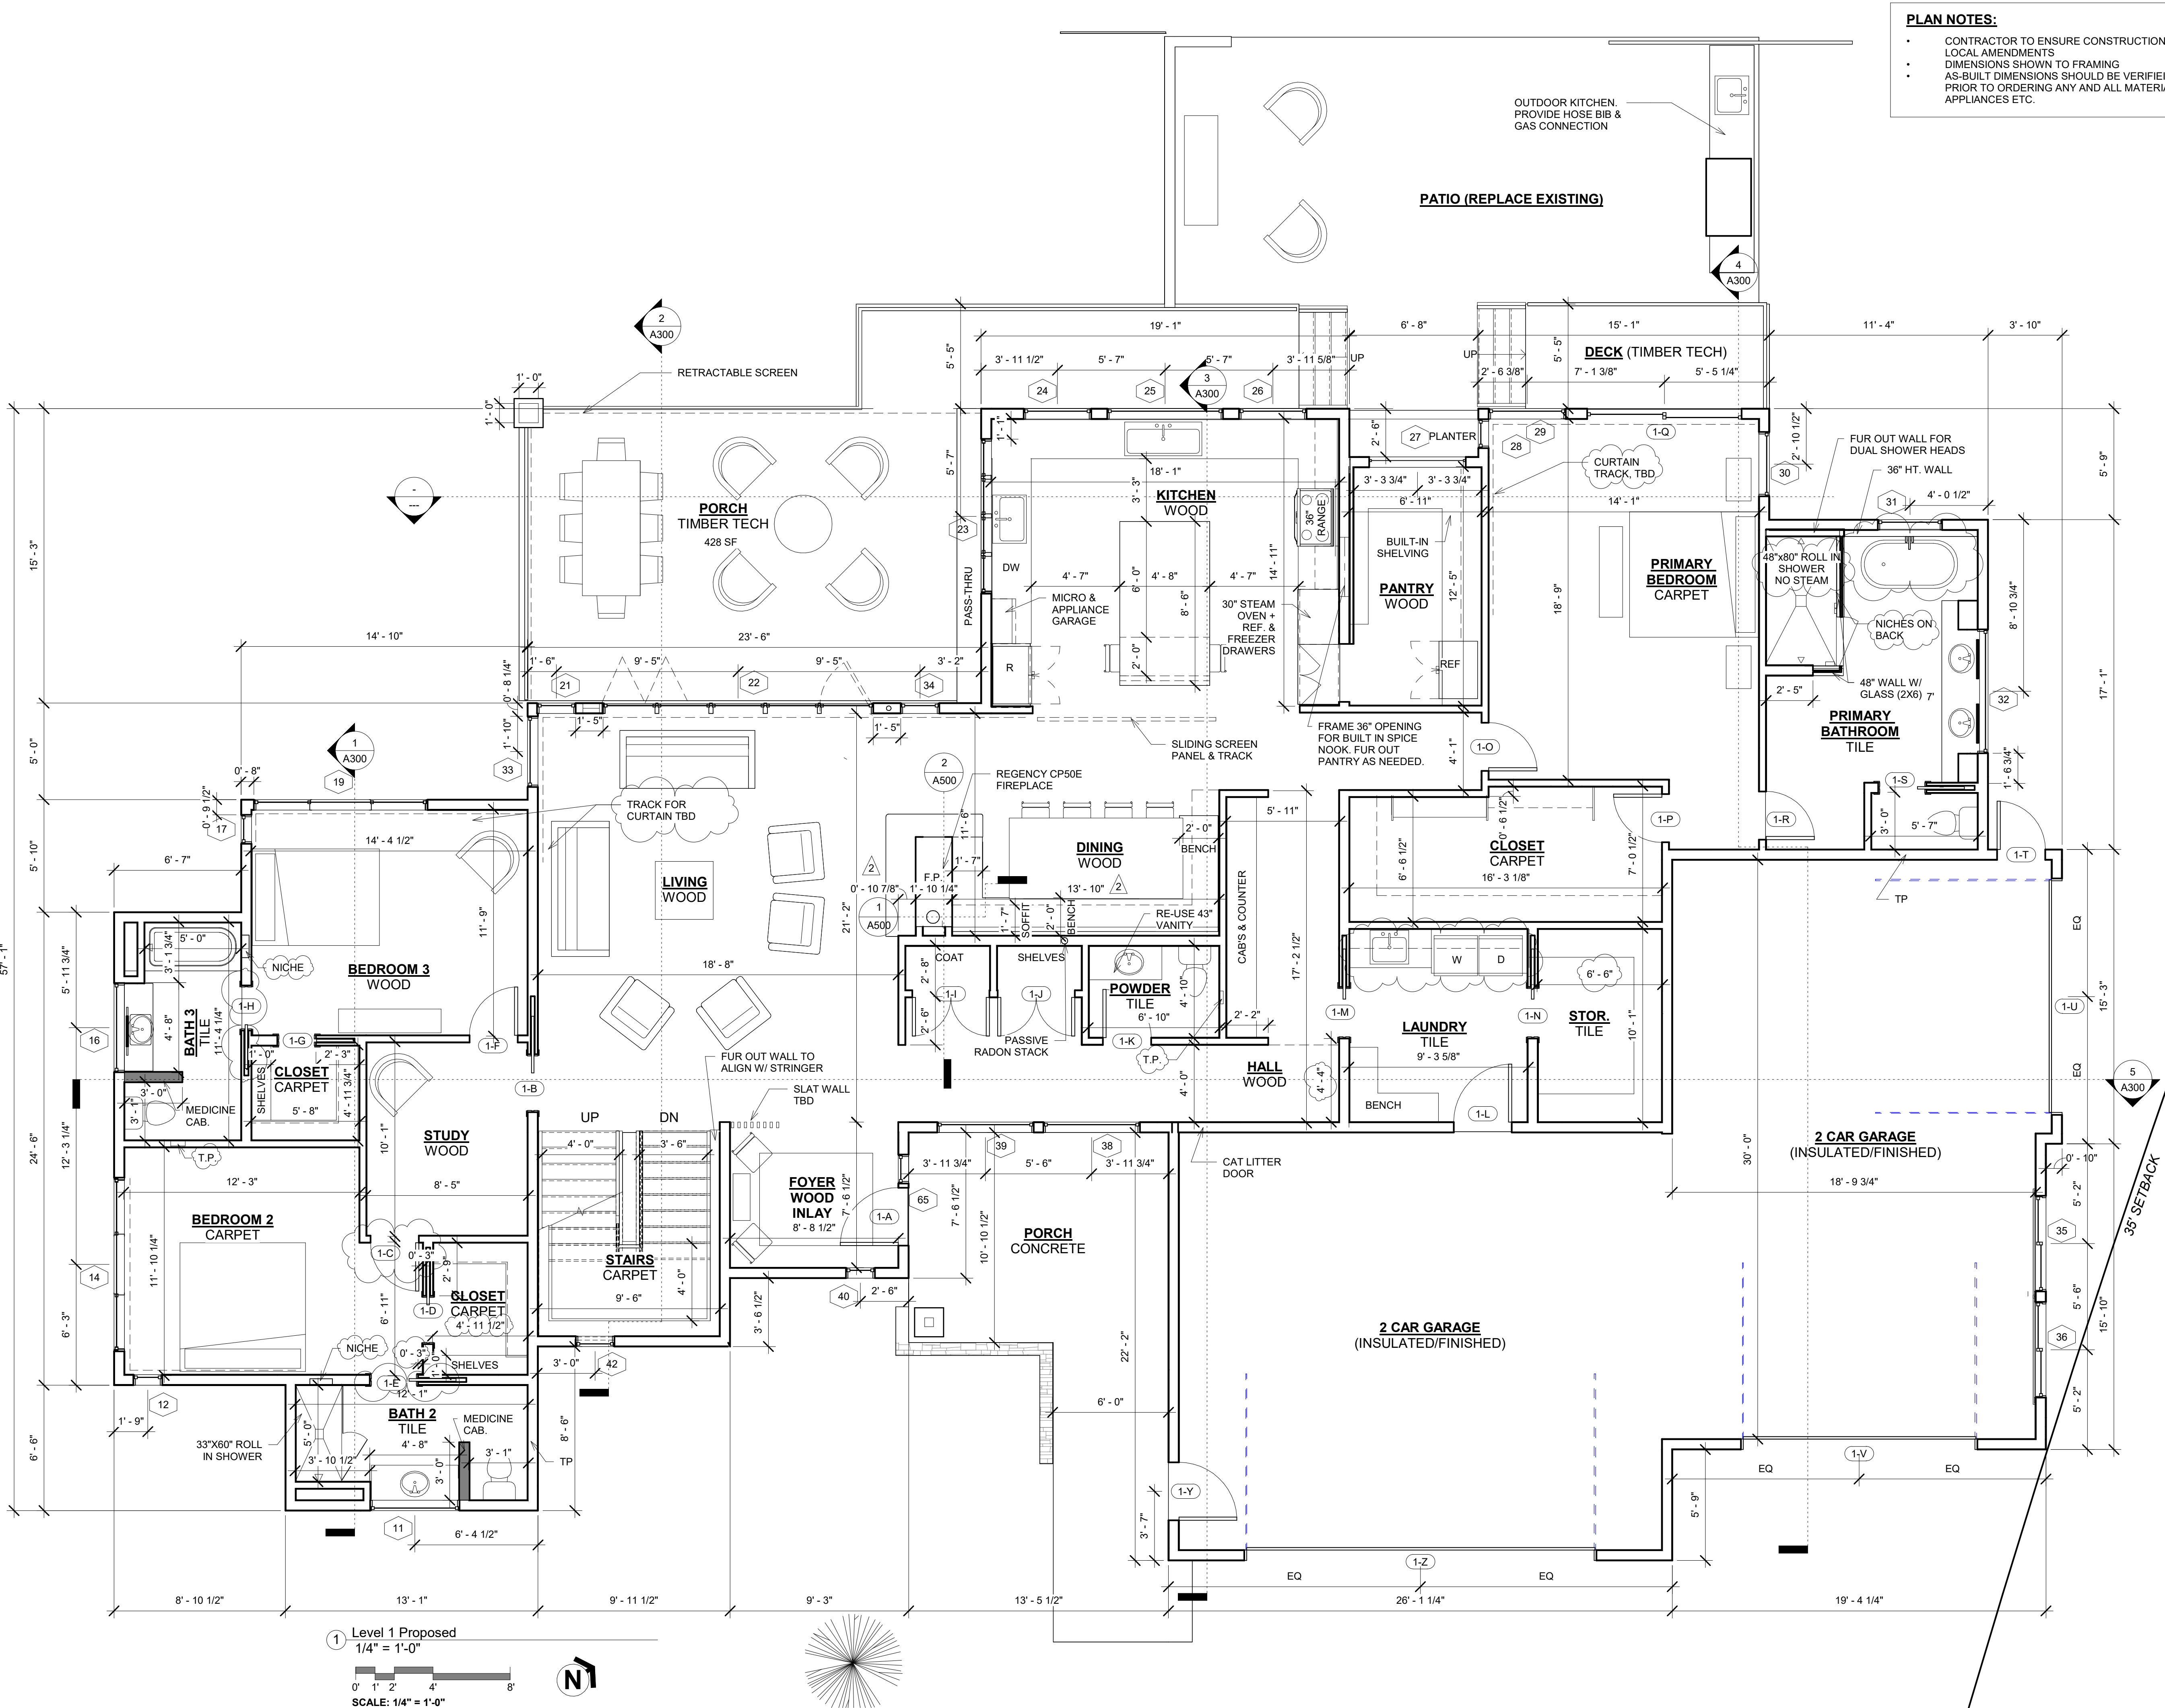

- PLAN NOTES:**
- CONTRACTOR TO ENSURE CONSTRUCTION MEETS 2021 IRC + LOCAL AMENDMENTS
 - DIMENSIONS SHOWN TO FRAMING
 - AS-BUILT DIMENSIONS SHOULD BE VERIFIED BY CONTRACTOR PRIOR TO ORDERING ANY AND ALL MATERIALS, FIXTURES, APPLIANCES ETC.

enContext Architecture, llc
Integrate. Iterate. Generate.
www.Context-Architect.com

THESE DOCUMENTS ARE PROVIDED FOR THE DESIGN INTENT OF THIS SPECIFIC PROJECT AND ONLY THIS PROJECT. THE CONTRACTOR SHALL BE RESPONSIBLE FOR ALL CONSTRUCTION COORDINATION, METHODS, AND MATERIALS. THE ARCHITECT SHALL NOT BE RESPONSIBLE FOR THE COMPLETION OF THE PROJECT. THIS INCLUDES BUT IS NOT LIMITED TO THE QUALITY OF WORKMANSHIP AND MATERIALS REQUIRED FOR EXECUTION OF THESE DOCUMENTS AND WORK OR MATERIALS SUPPLIED BY ANY SUBCONTRACTORS. ALL WORK SHALL COMPLY WITH GOVERNING CODES AND ORDINANCES. THE ARCHITECT SHALL BE RESPONSIBLE FOR VERIFYING ALL DIMENSIONS AND SHALL NOTIFY THE ARCHITECT IMMEDIATELY OF ANY DISCREPANCIES IN THE DRAWINGS, FIELD CONDITIONS OR DIMENSIONS.

7855 SPRING DRIVE
BOULDER, CO 80303
NEW RESIDENCE

CONSTRUCTION SET -
REV 2
1/16/26

SHEET
No.
A101
Main Floor Plan


DOCUMENTS AND WORK OR MATERIALS SUPPLIED BY ANY SUBCONTRACTORS. ALL WORK SHALL COMPLY WITH GOVERNING CODES AND ORDINANCES. THE

BOULDER, CO 80303

REV 2
1/16/26

SHEET
No.


A102

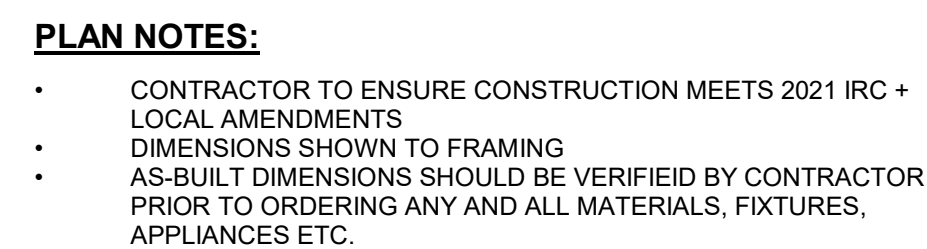


**7855 SPRING DRIVE
BOULDER, CO 80303
NEW RESIDENCE**


A103

Roof Plan

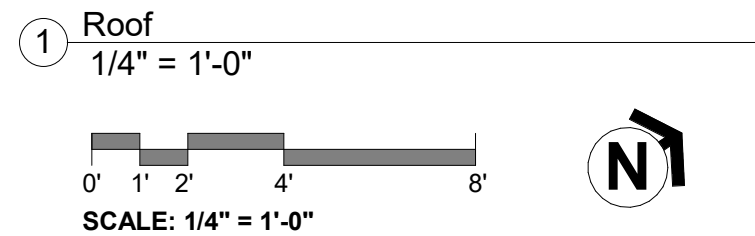


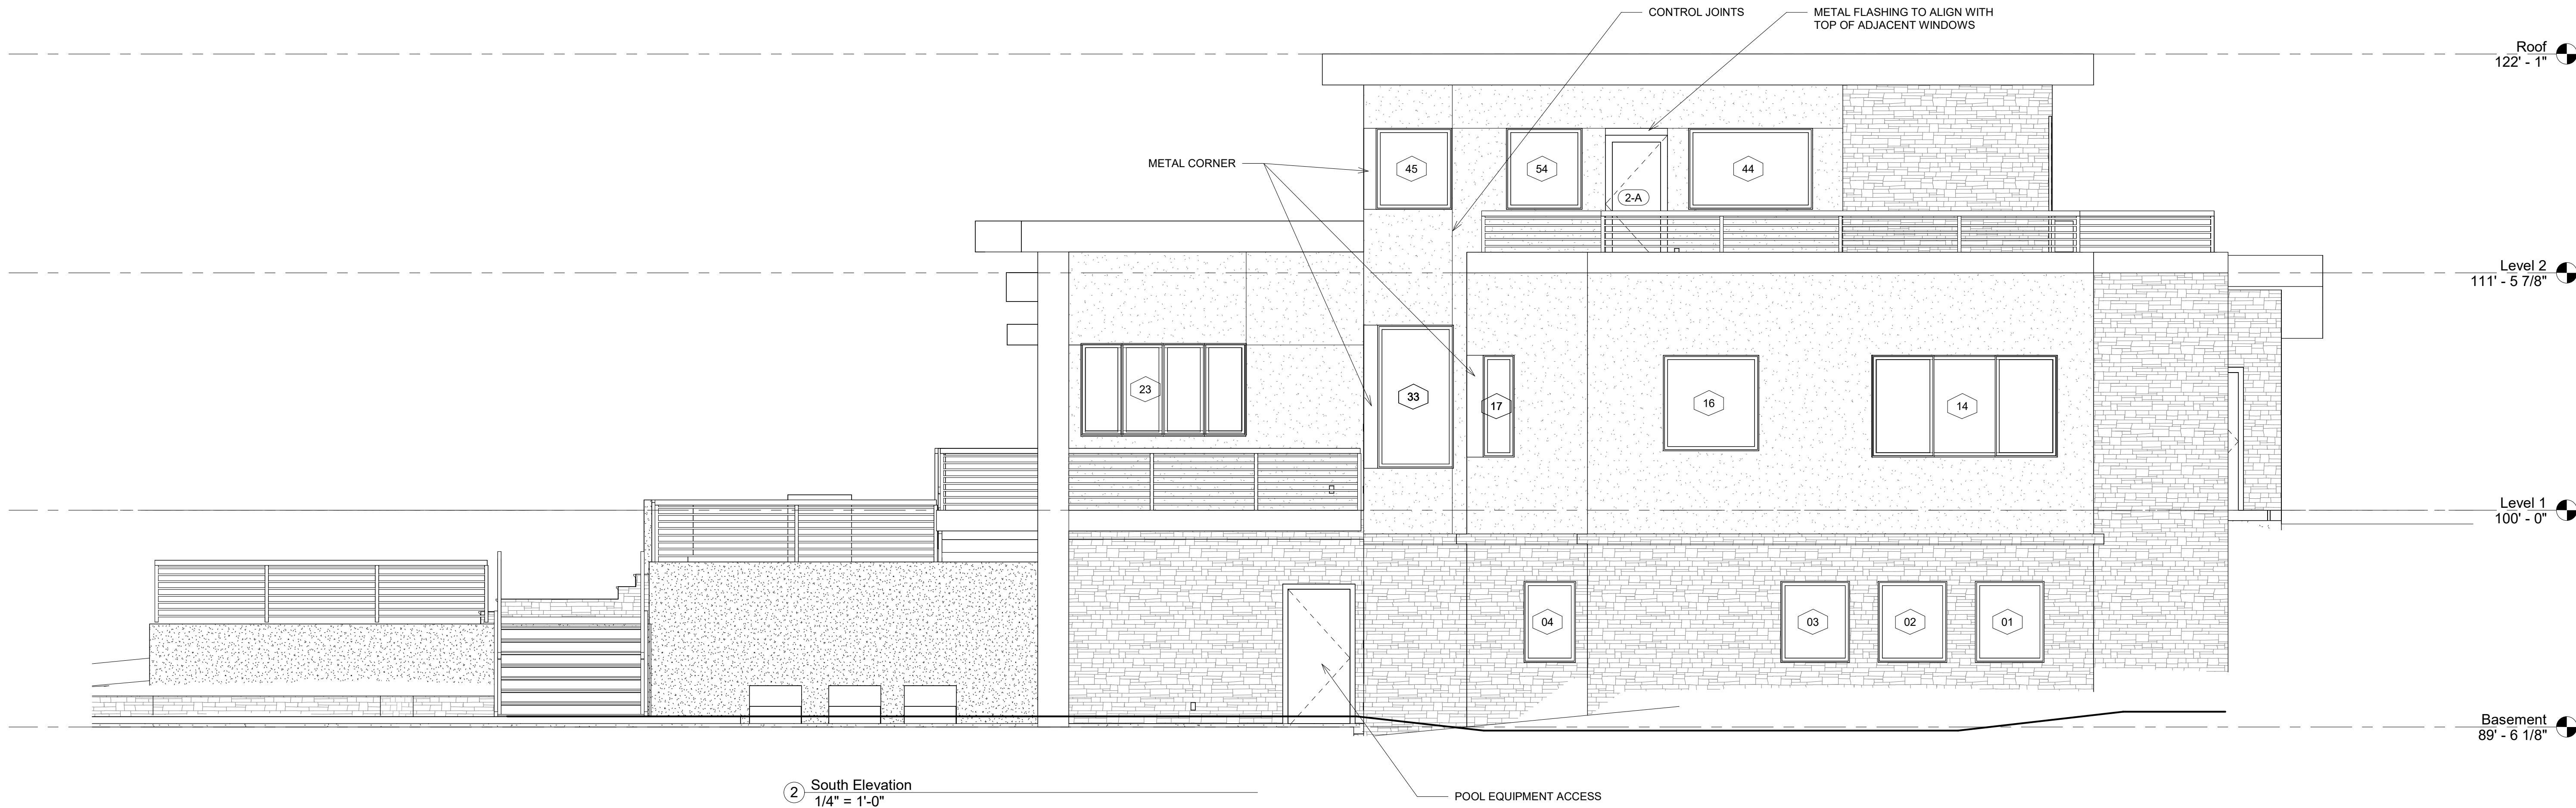


② South Elevation
1/4" = 1'-0"

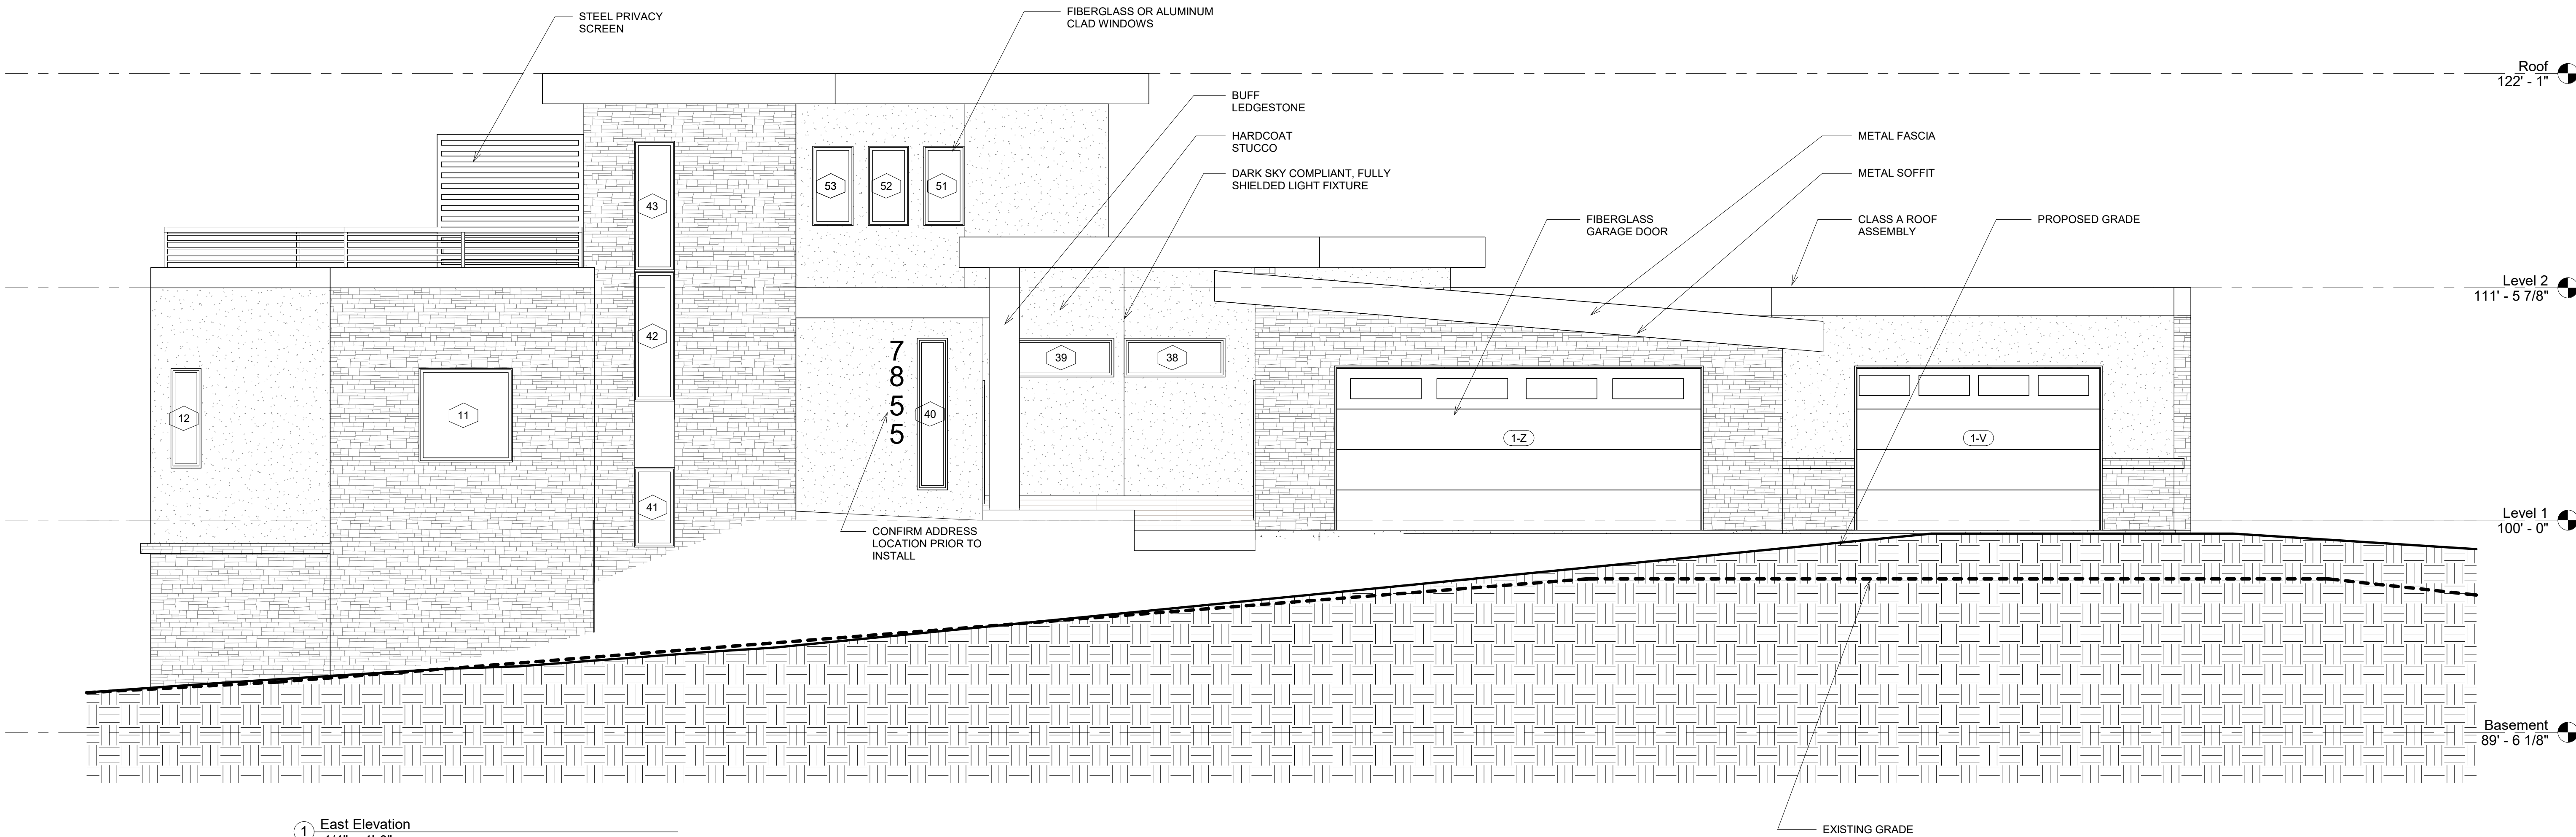

① East Elevation
1/4" = 1'-0"

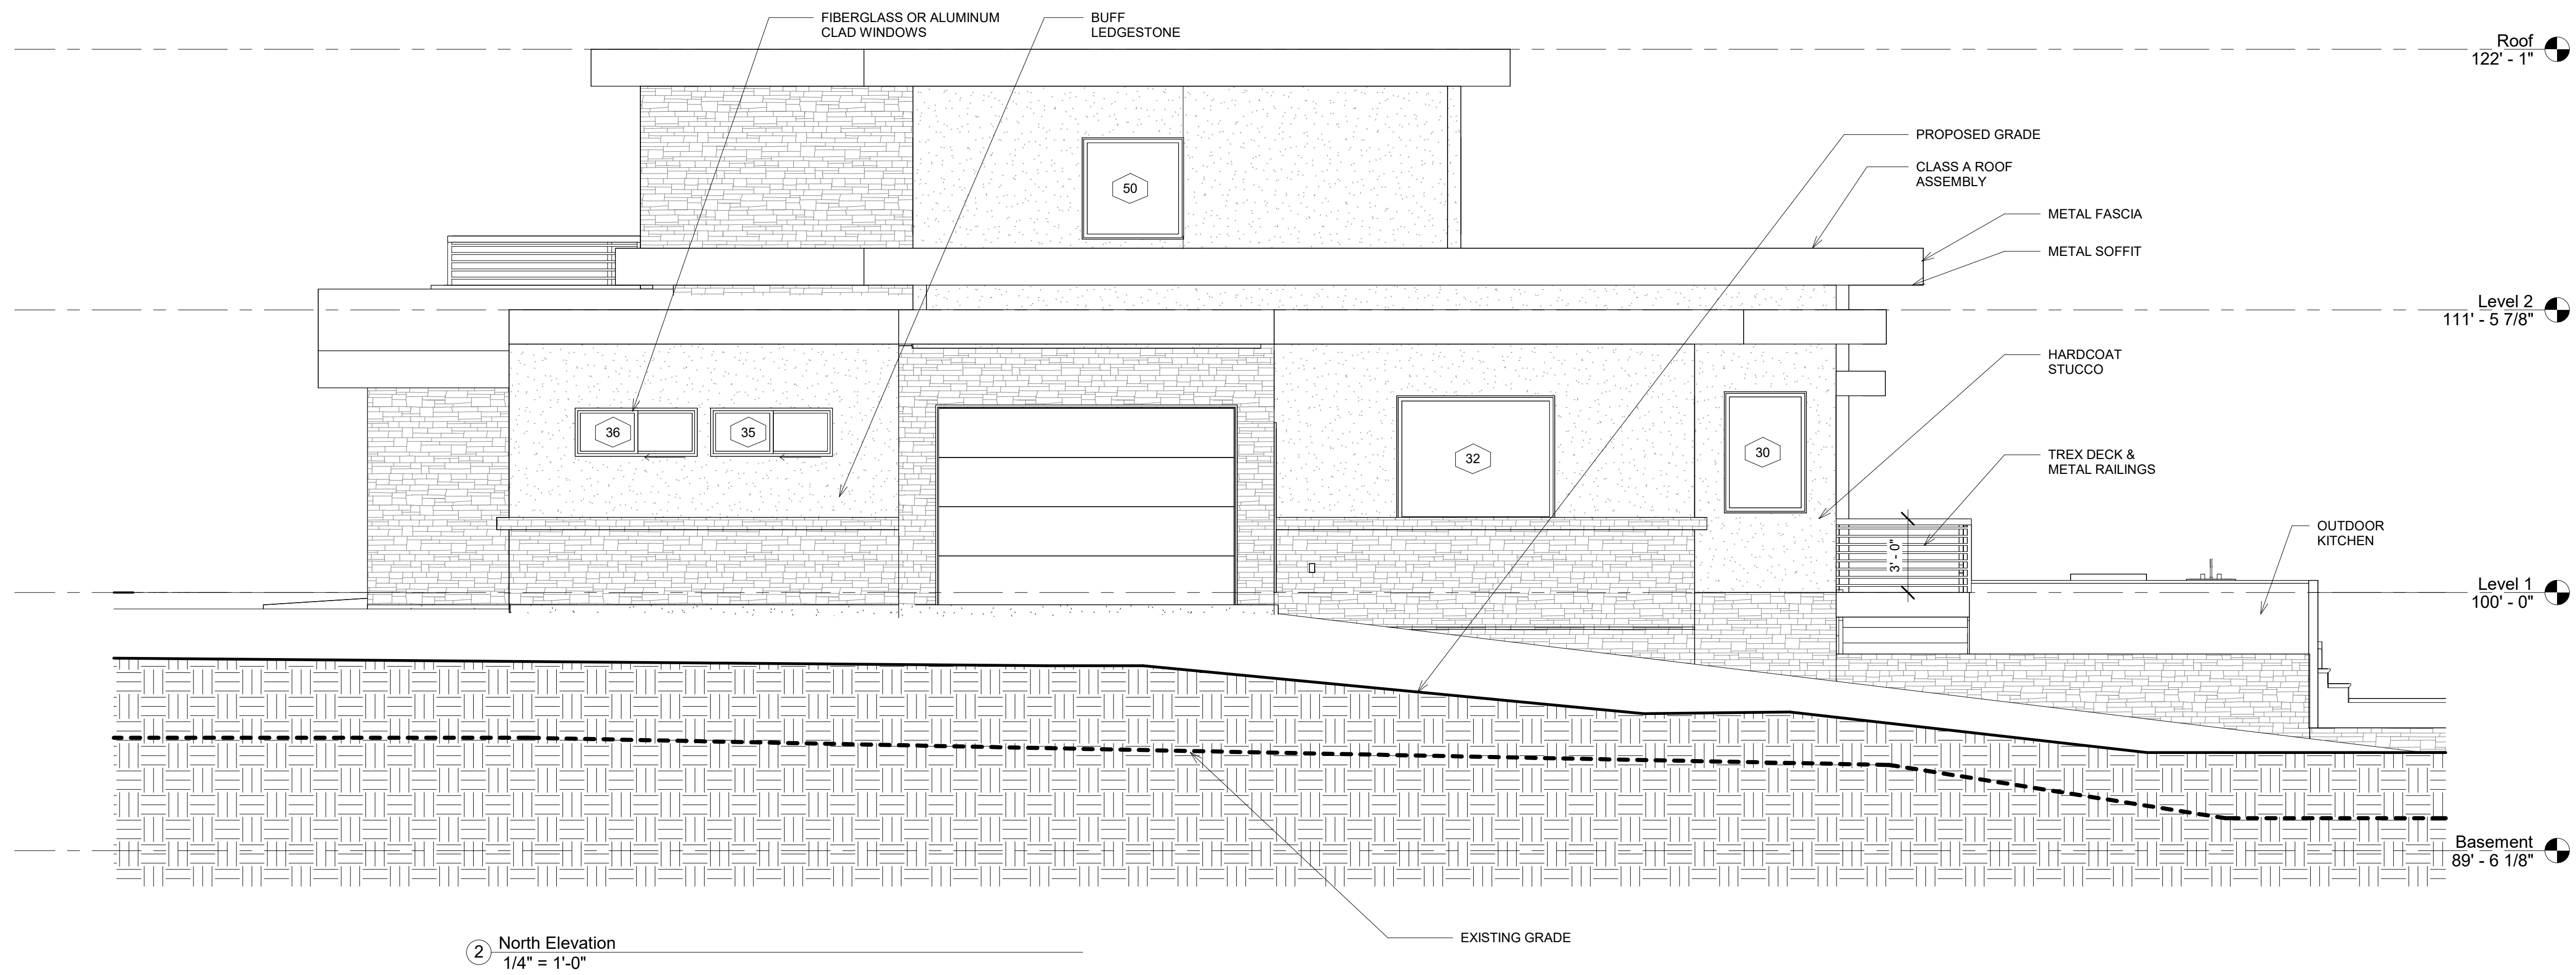

② North Elevation
1/4" = 1'-0"

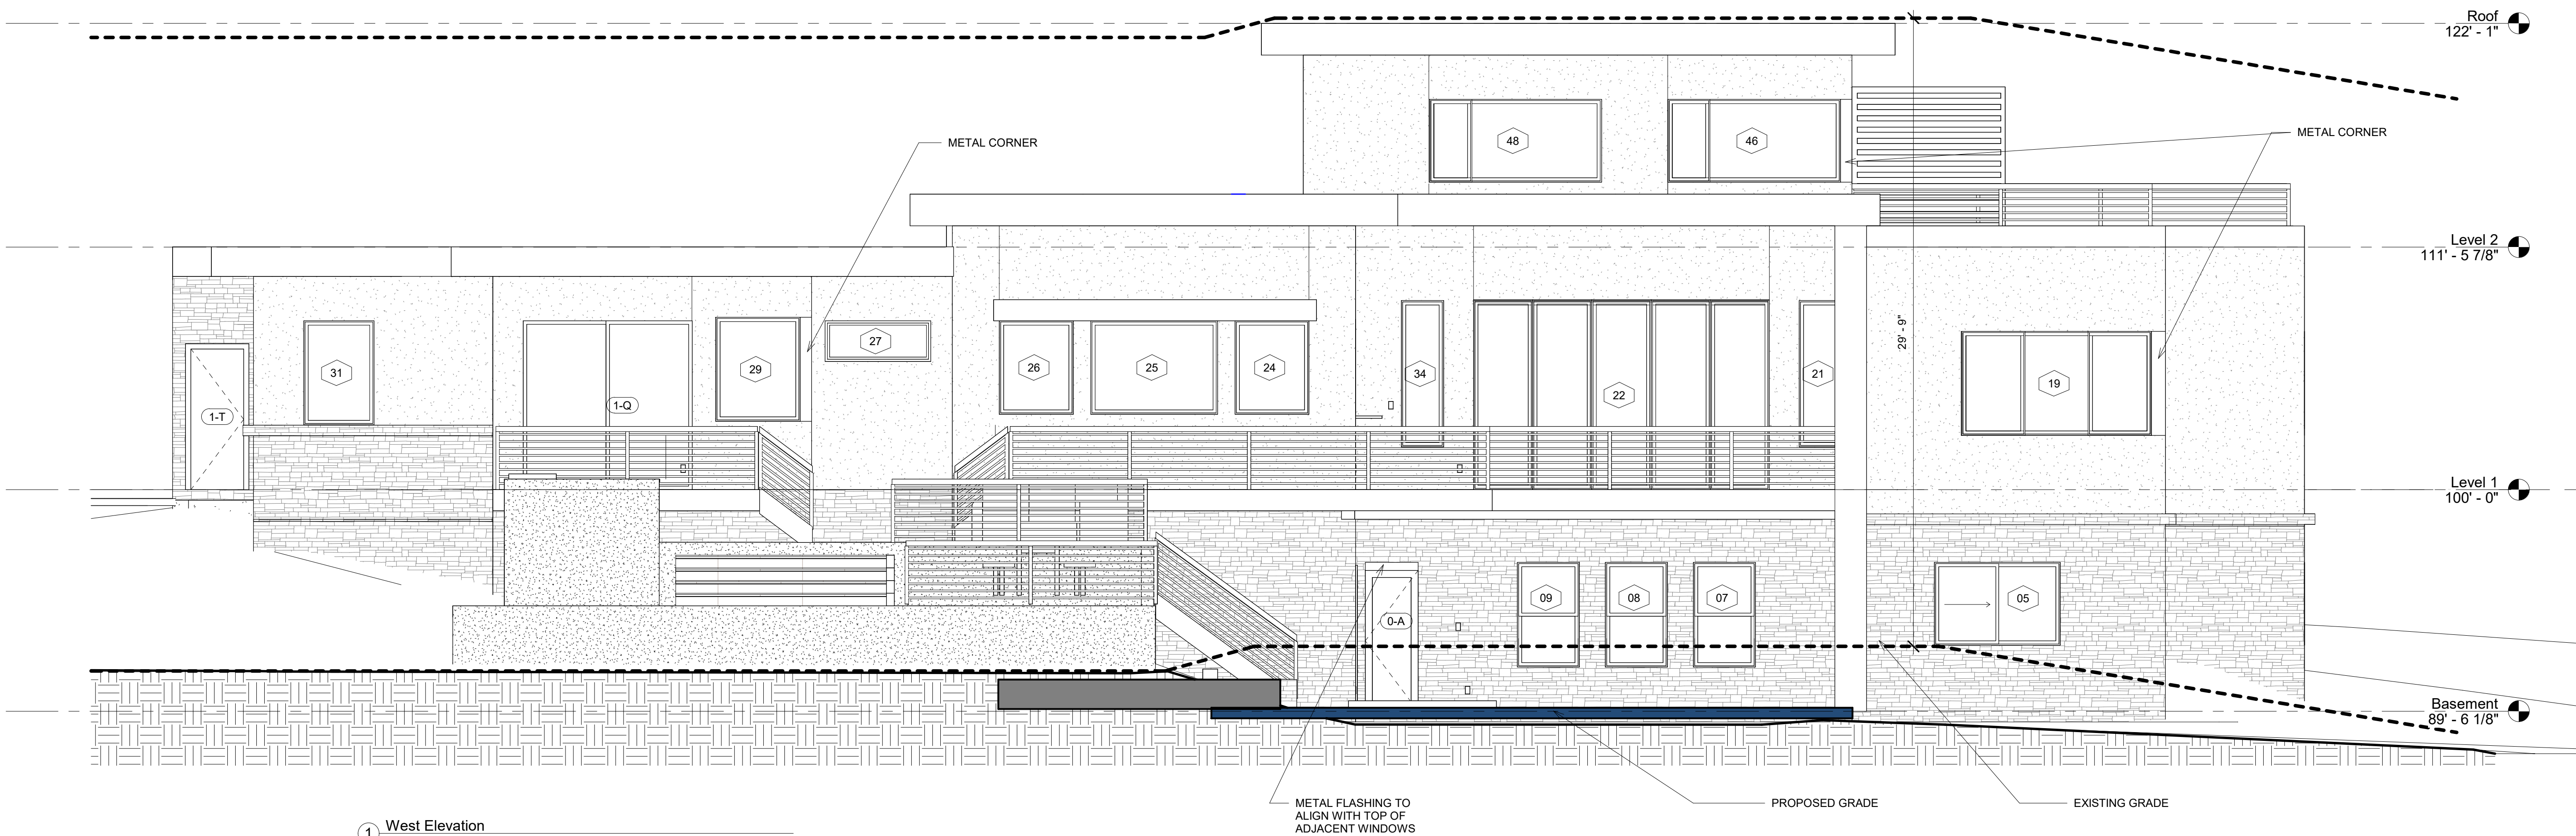

① West Elevation
1/4" = 1'-0"


DISCLAIMER:
THESE DOCUMENTS ARE PROVIDED FOR THE DESIGN INTENT OF THIS SPECIFIC PROJECT AND ONLY THIS PROJECT. THE CONTRACTOR SHALL BE RESPONSIBLE FOR ALL CONSTRUCTION COORDINATION, METHODS AND MATERIALS REQUIRED FOR THE SUCCESSFUL COMPLETION OF THE PROJECT. THIS INCLUDES BUT IS NOT LIMITED TO THE QUALITY OF WORKMANSHIP AND MATERIALS REQUIRED FOR EXECUTION OF THESE DOCUMENTS AND WORK OR MATERIALS SUPPLIED BY ANY SUBCONTRACTORS. ALL WORK SHALL COMPLY WITH GOVERNING CODES AND ORDINANCES. THE CONTRACTOR SHALL REVIEW AND UNDERSTAND ALL DOCUMENTS AND SHALL NOTIFY THE ARCHITECT IMMEDIATELY OF ANY DISCREPANCIES IN THE DRAWINGS, FIELD CONDITIONS OR DIMENSIONS.



5 Front View



7 Rear View

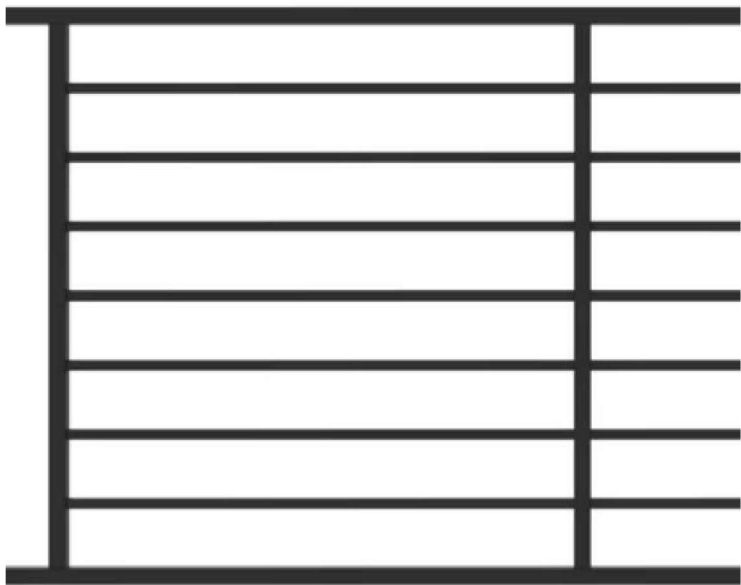


BLACK METAL RAILINGS
PROVIDE ALTERNATE DETAILS FOR COST COMPARISON



BURNISHED SLATE
METAL FASCIA & SOFFIT
MOCKUP PRIOR TO INSTALL



LYRA LIMESTONE **MOCKUP**
PRIOR TO INSTALL

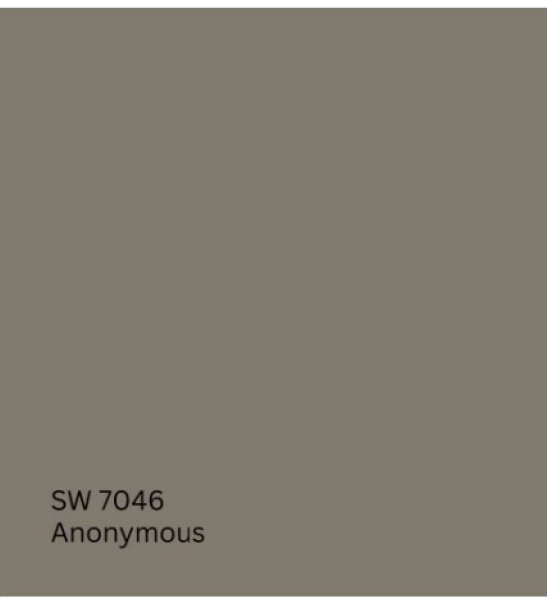

HARDCOAT STUCCO - BODY
SW 7046 ANONYMOUS
PROVIDE SWATCH ON BLDG
PRIOR TO INSTALL



ROOF DECK PAVERS - TBD
PROVIDE SAMPLES



TREX ENHANCE
COASTAL BLUFF
PROVIDE ALTERNATES FOR
CONSIDERATION



WHITE EPDM (FLAT ROOFS)



BLACK EPDM (SLOPED
GARAGE ROOF)

7855 SPRING DRIVE
BOULDER, CO 80303
7855 SPRING DR, BOULDER, CO 80303

CONSTRUCTION SET
REV 3
4/29/26

SHEET
No.


A202
Renderings &
Materials

THESE DOCUMENTS ARE PROVIDED FOR THE DESIGN INTENT OF THIS SPECIFIC PROJECT AND ONLY THIS PROJECT. THE CONTRACTOR SHALL BE RESPONSIBLE FOR ALL CONSTRUCTION COORDINATION METHODS AND MATERIALS REQUIRED FOR THE PROPER COMPLETION OF THE PROJECT. THIS INCLUDES BUT IS NOT LIMITED TO THE QUALITY OF WORKMANSHIP AND MATERIALS REQUIRED FOR EXECUTION OF THESE DOCUMENTS AND WORK OR MATERIALS SUPPLIED BY ANY SUBCONTRACTORS. ALL WORK SHALL COMPLY WITH ALL GOVERNING CODES AND ORDINANCES. THE CONTRACTOR SHALL BE RESPONSIBLE FOR VERIFYING ALL DOCUMENTS AND SHALL NOTIFY THE ARCHITECT IMMEDIATELY OF ANY DISCREPANCIES IN THE DRAWINGS, FIELD CONDITIONS OR DIMENSIONS.


7855 SPRING DRIVE
BOULDER, CO 80303
NEW RESIDENCE

CONSTRUCTION SET -
REV 2
1/16/26


SHEET
No.
A300
Building Sections

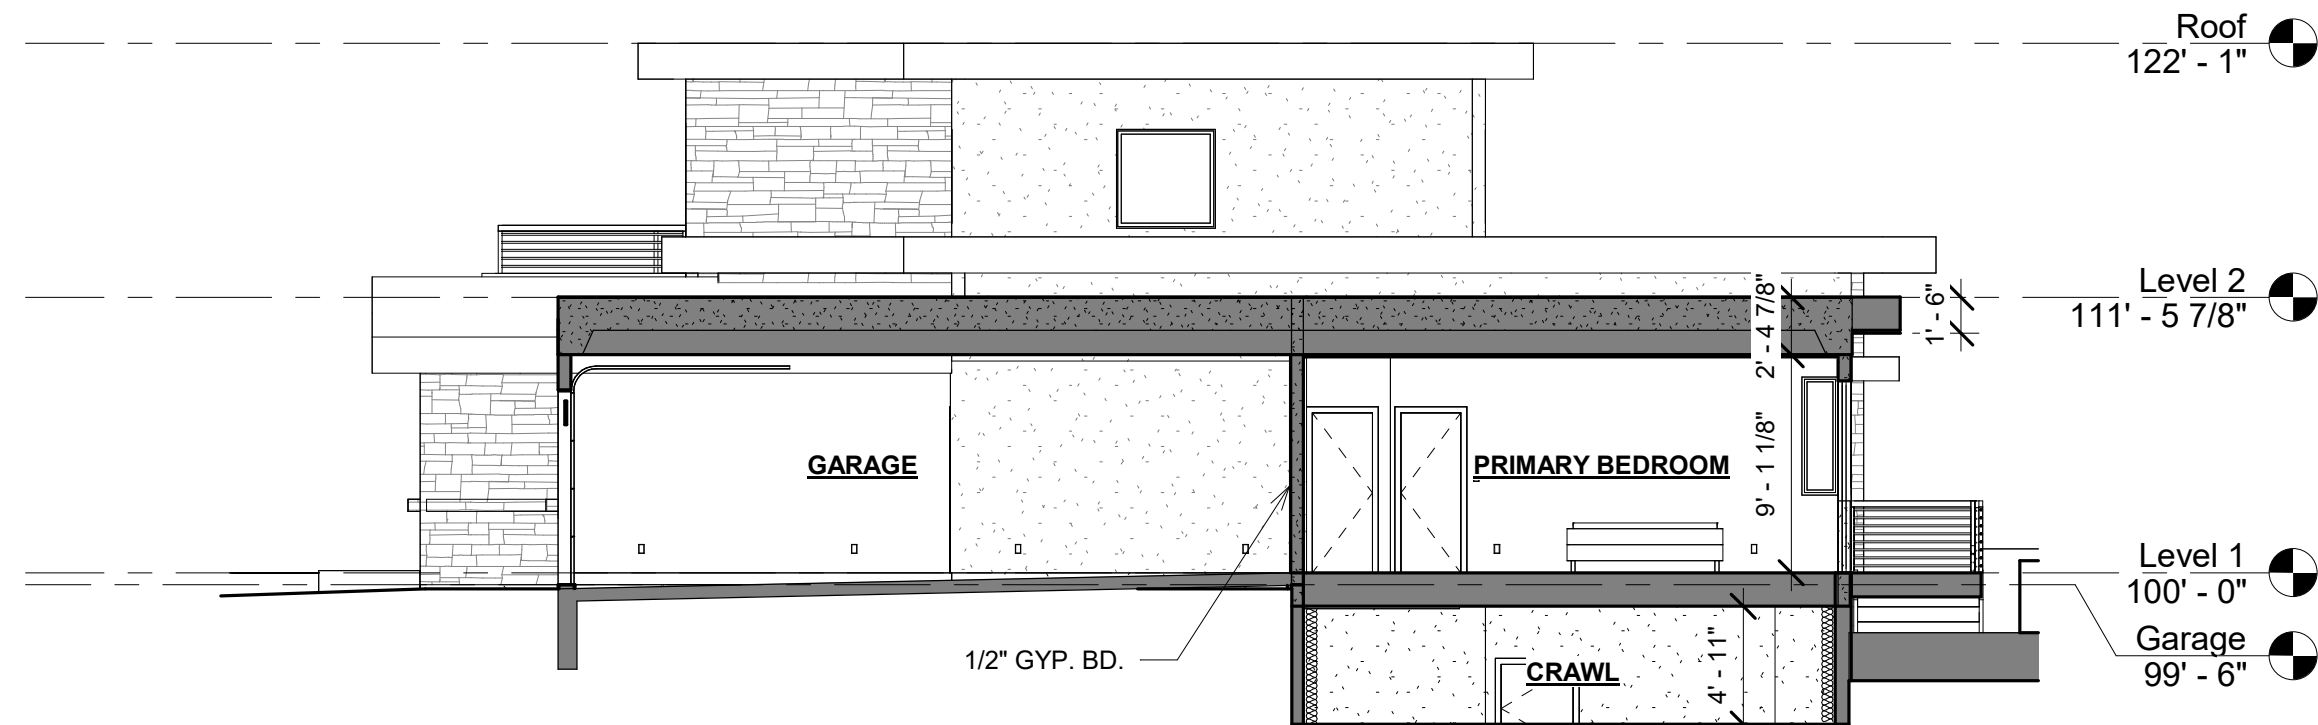


④ Section 4
1/8" = 1'-0"

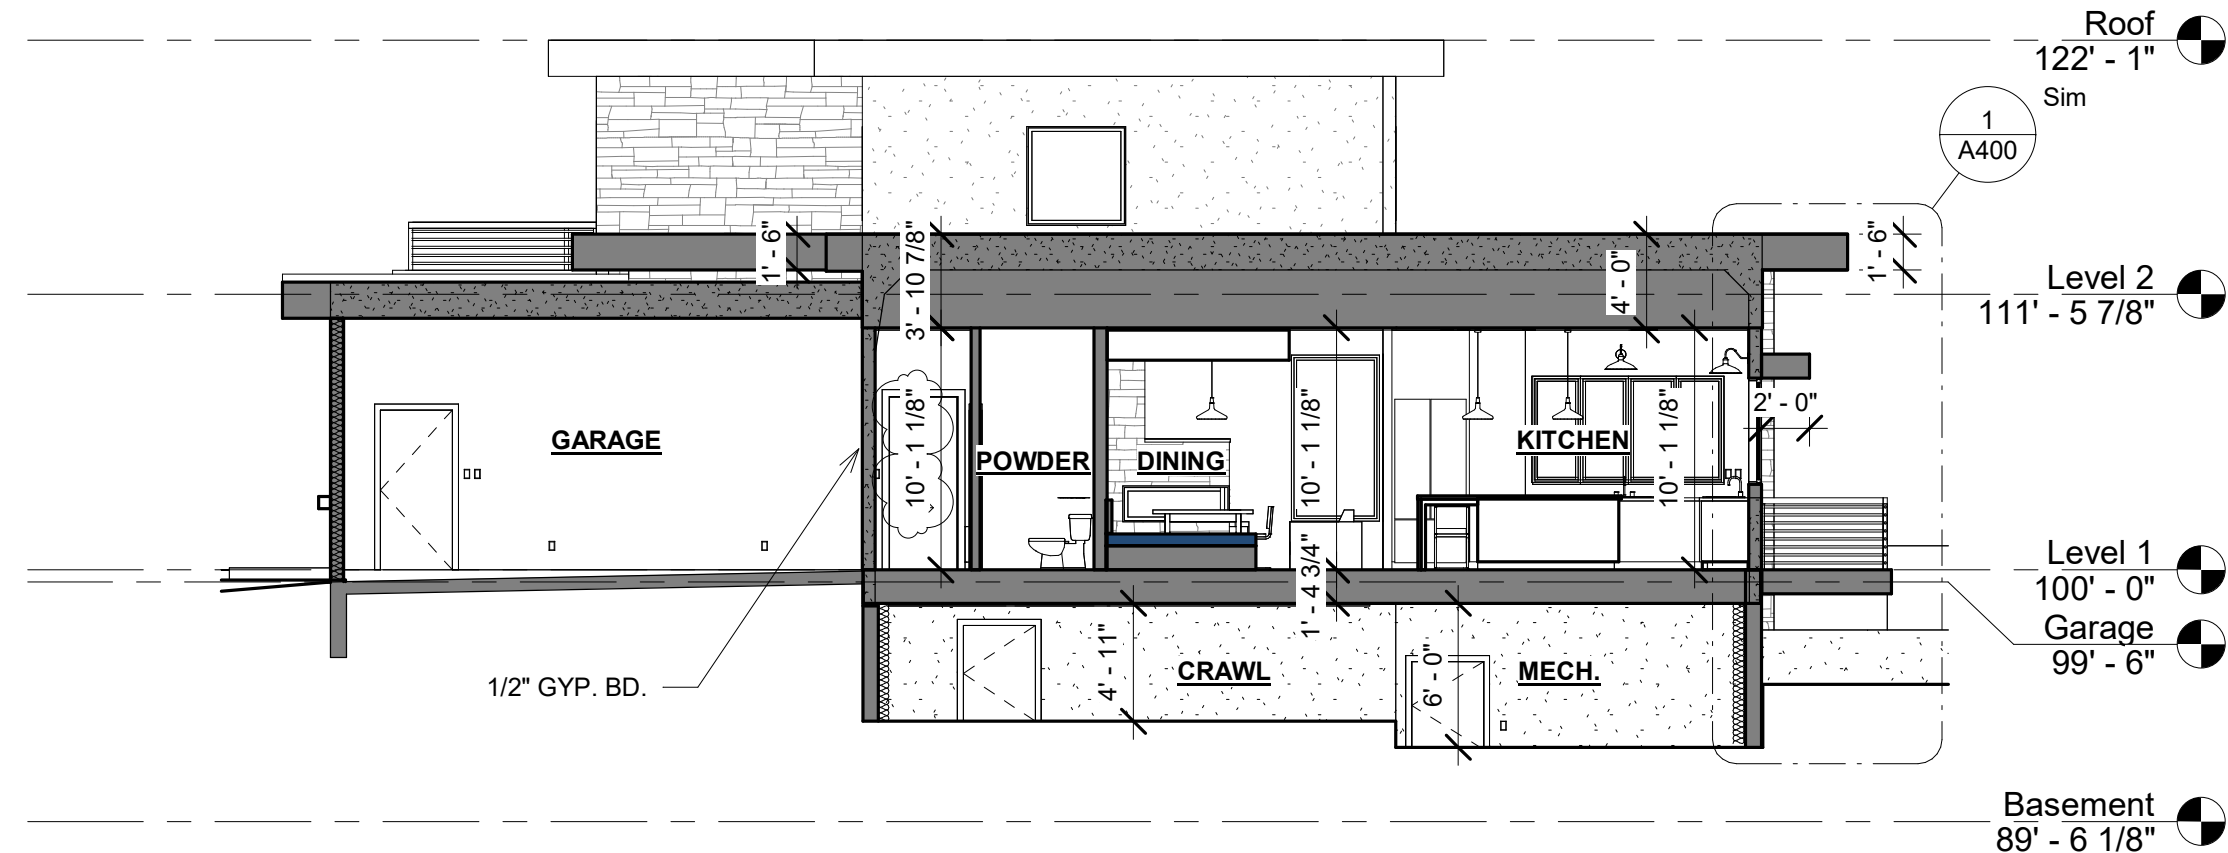


③ Section 3
1/8" = 1'-0"

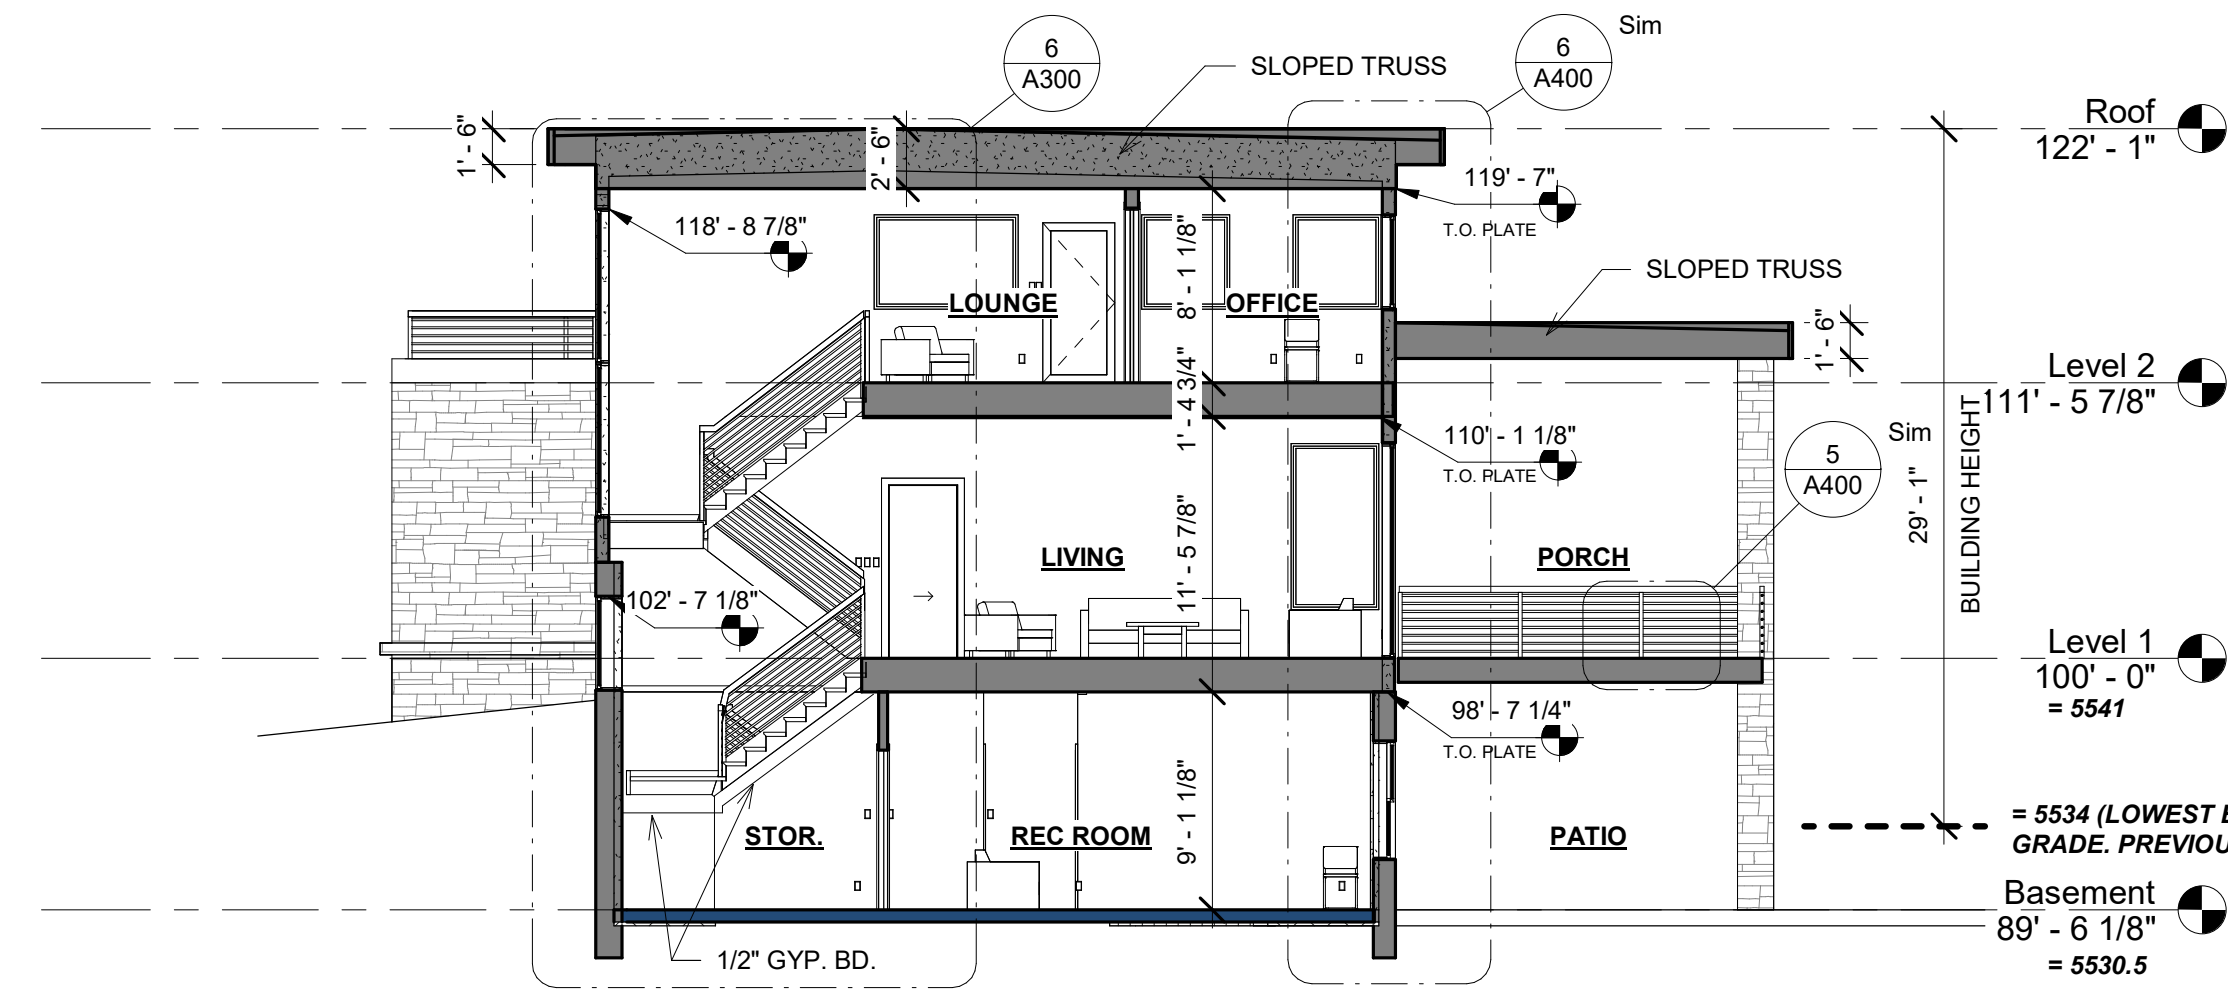


② Section 2
1/8" = 1'-0"

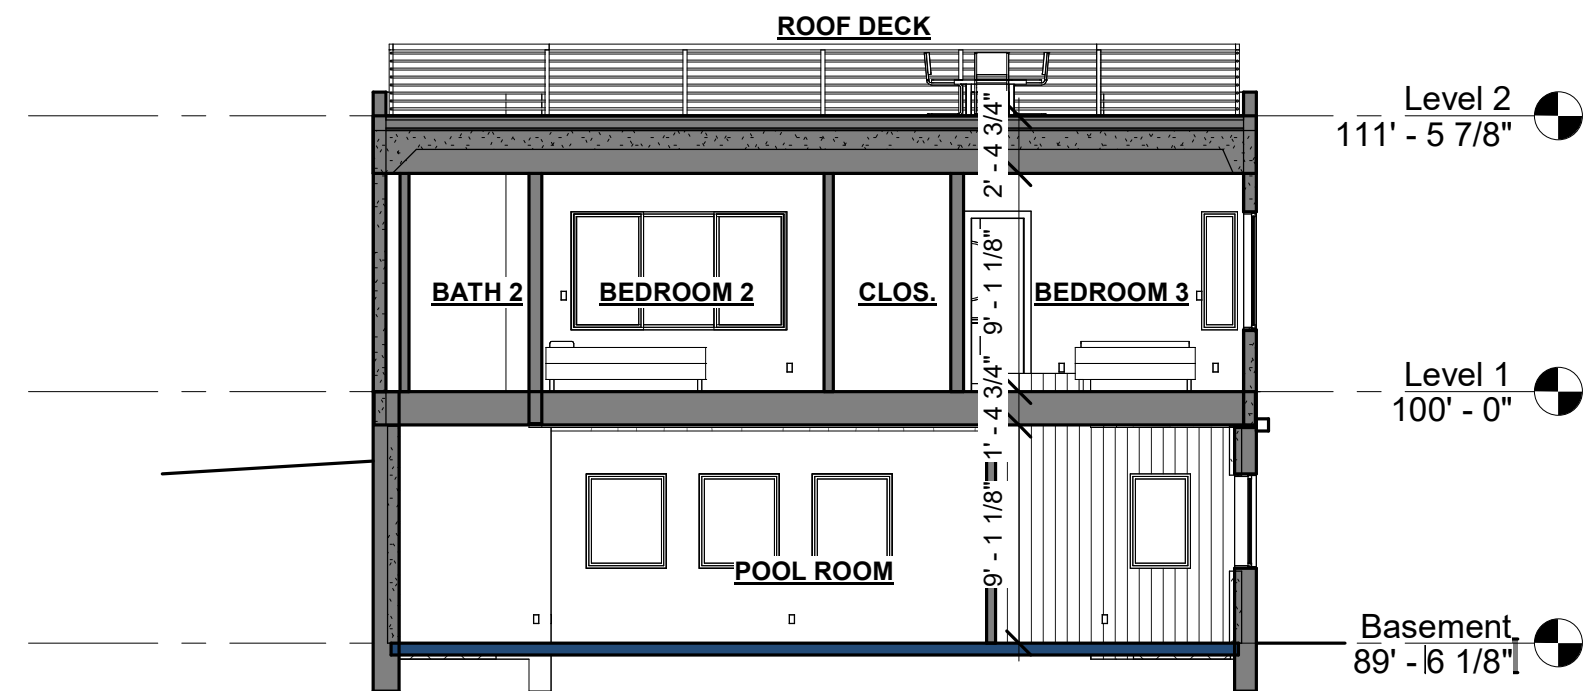


① Section 1
1/8" = 1'-0"

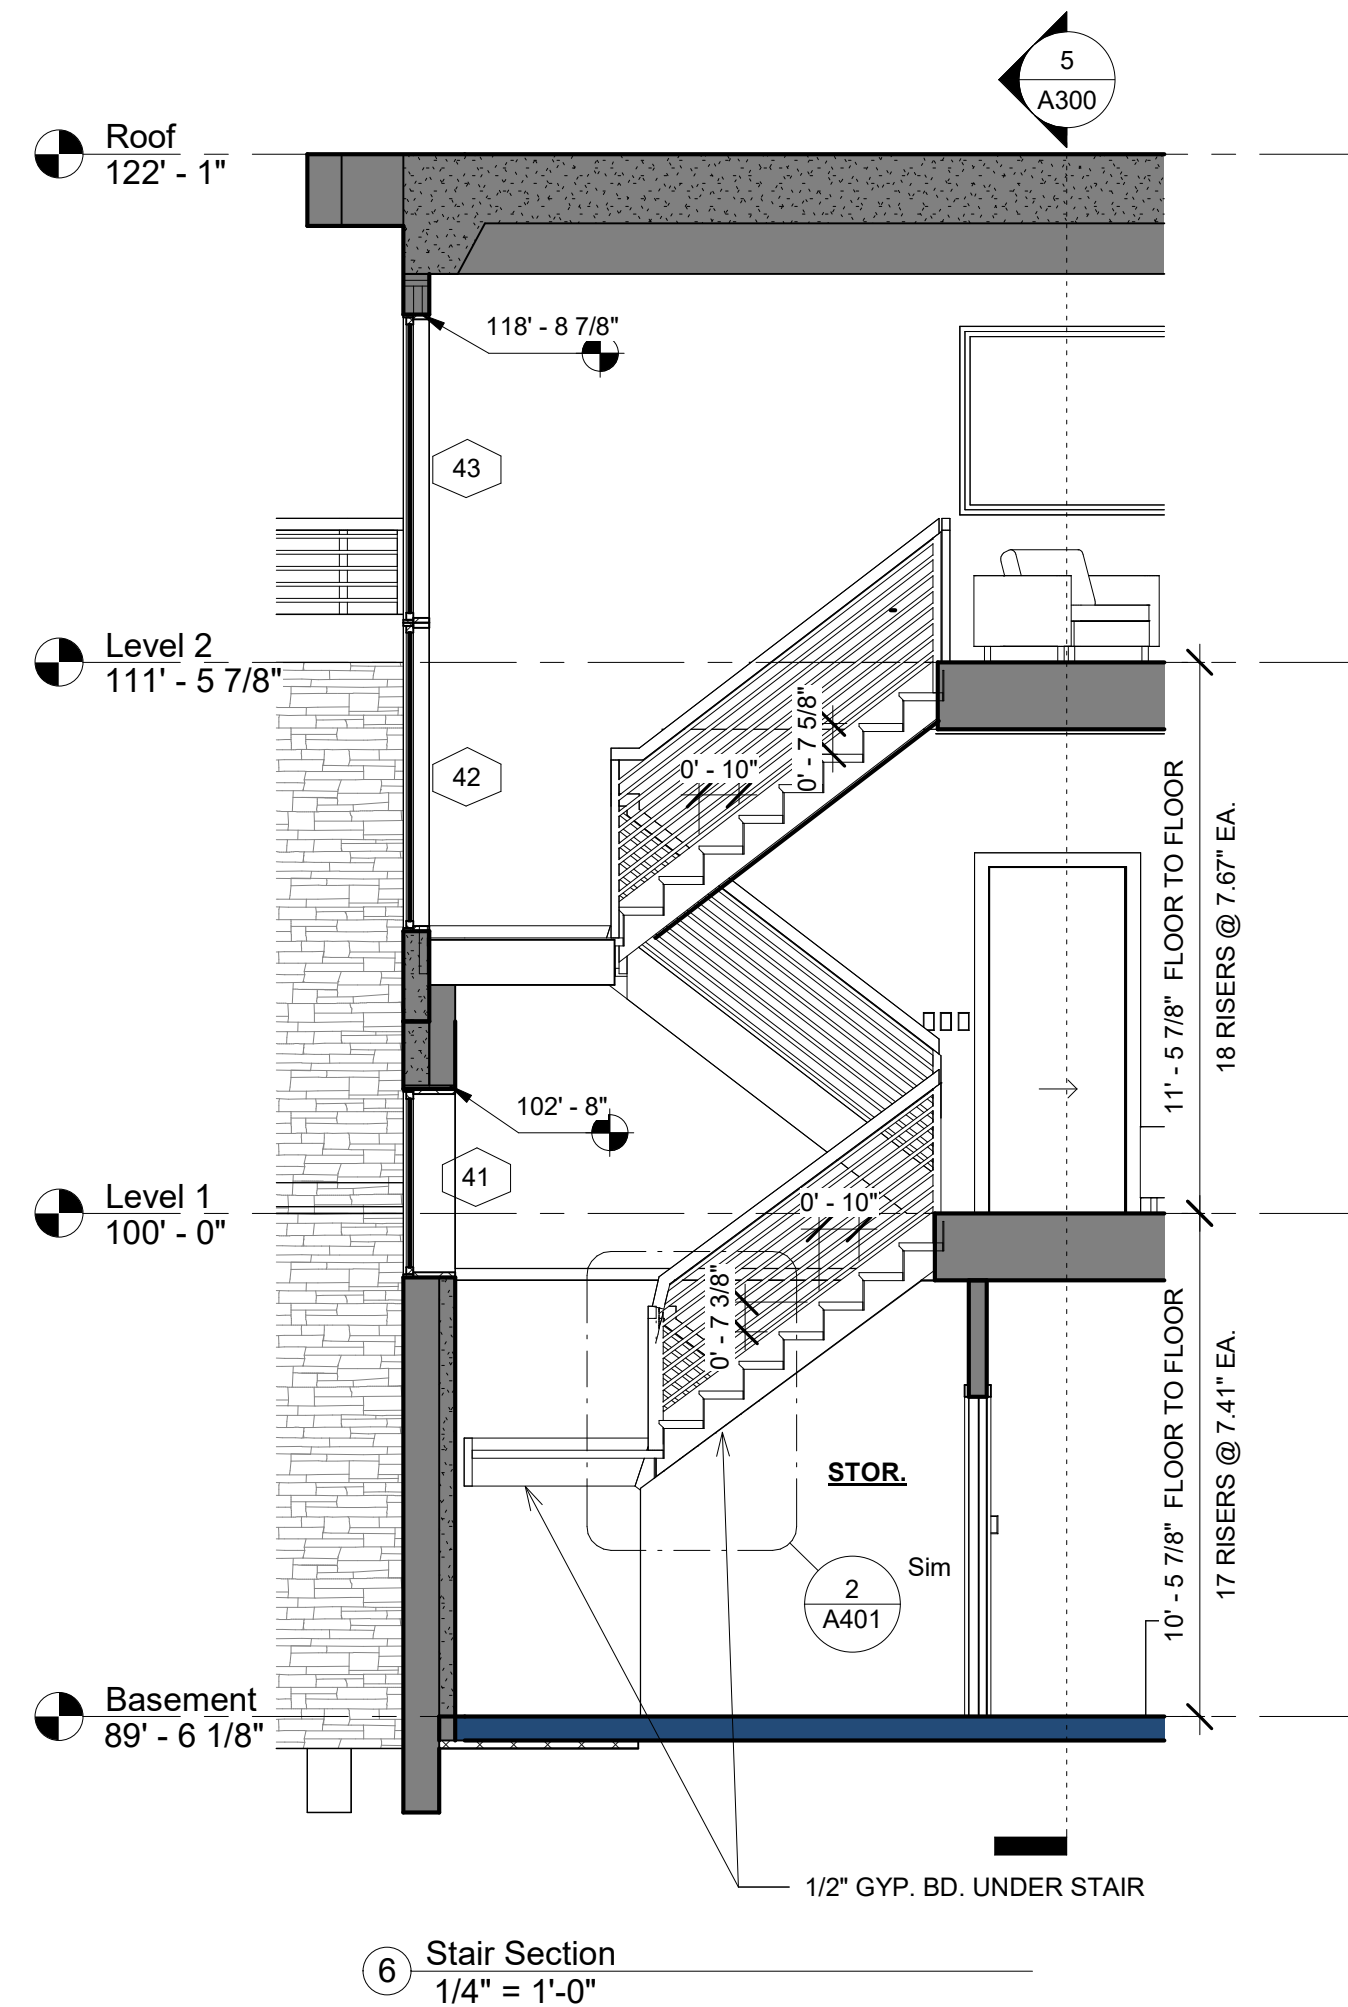


⑥ Stair Section
1/4" = 1'-0"

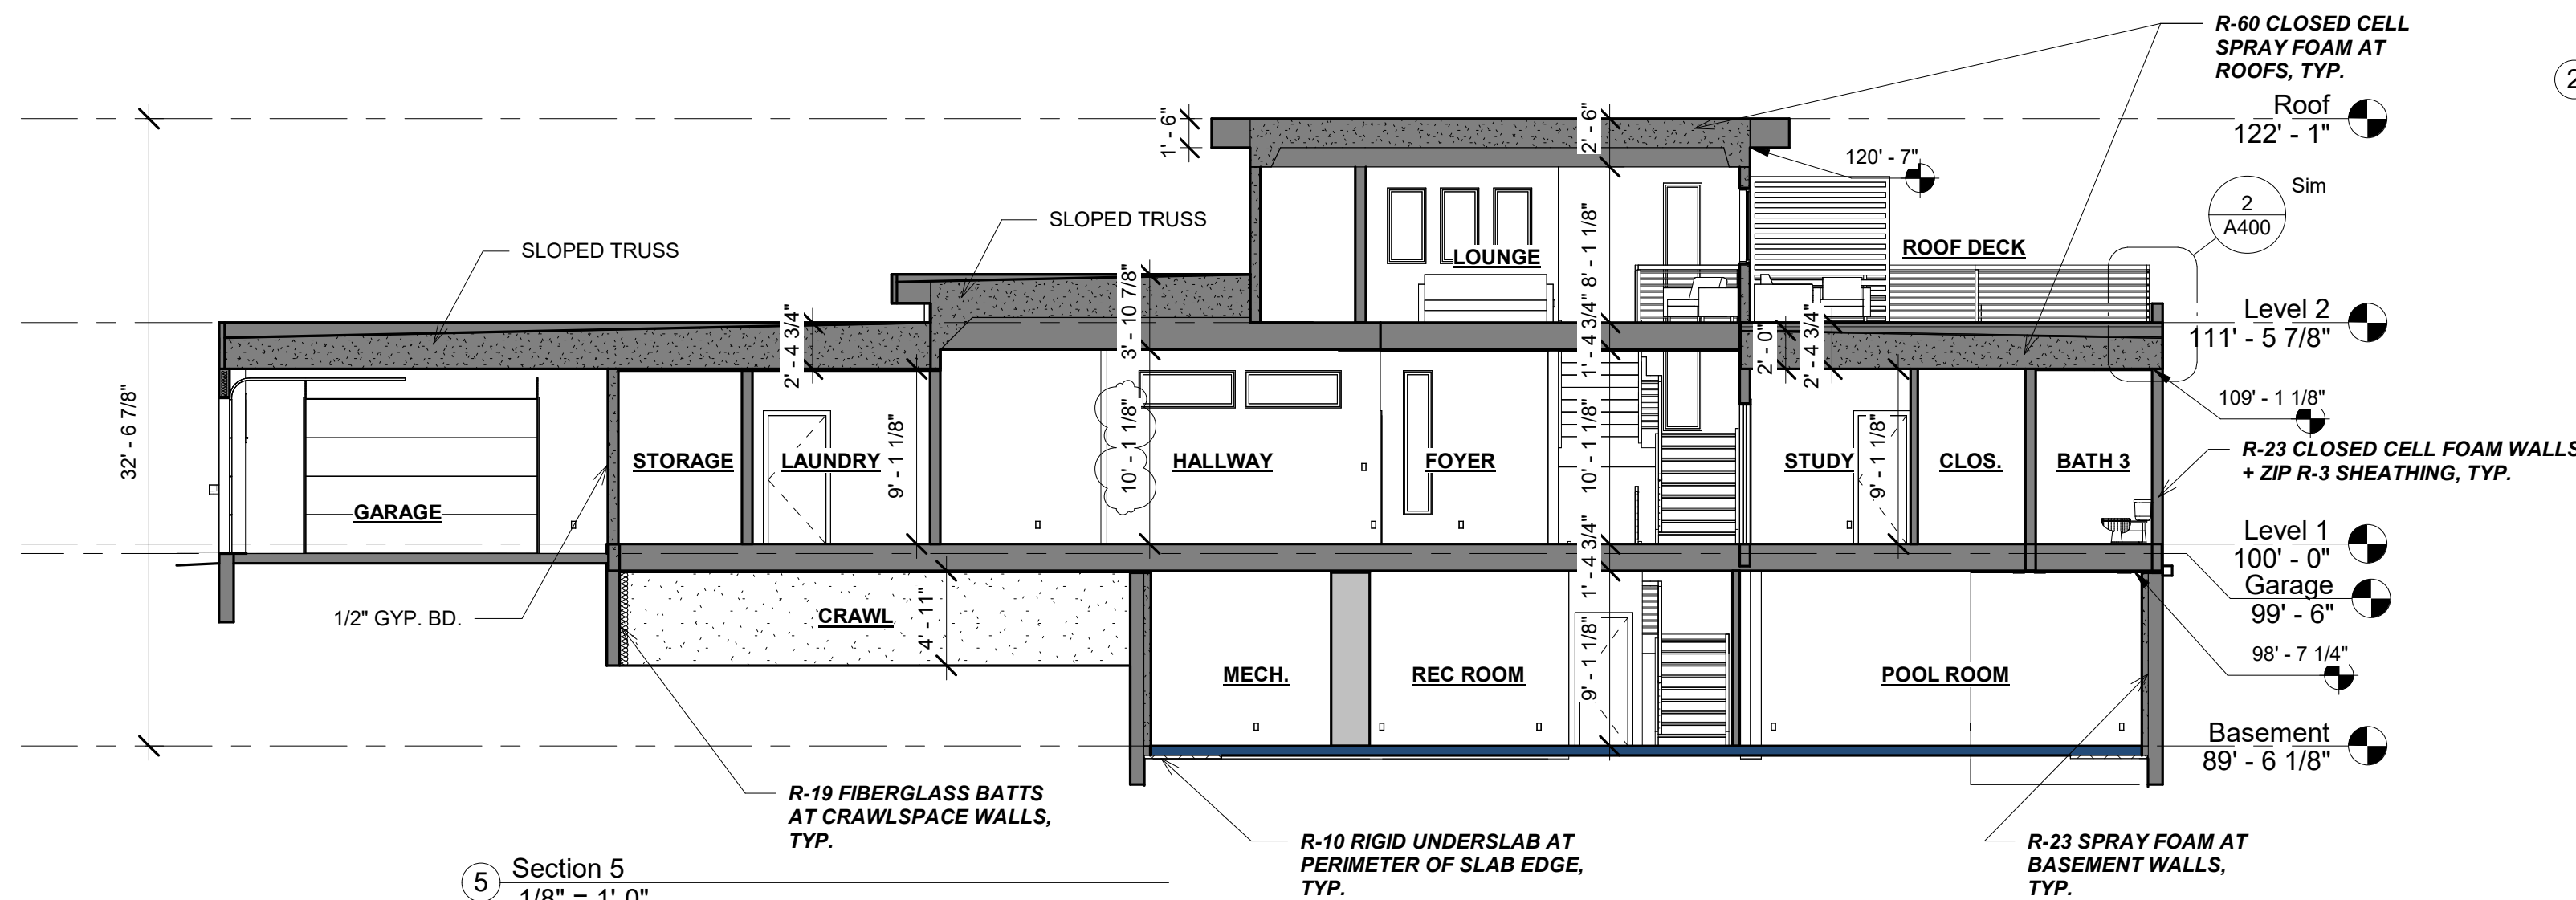


⑤ Section 5
1/8" = 1'-0"

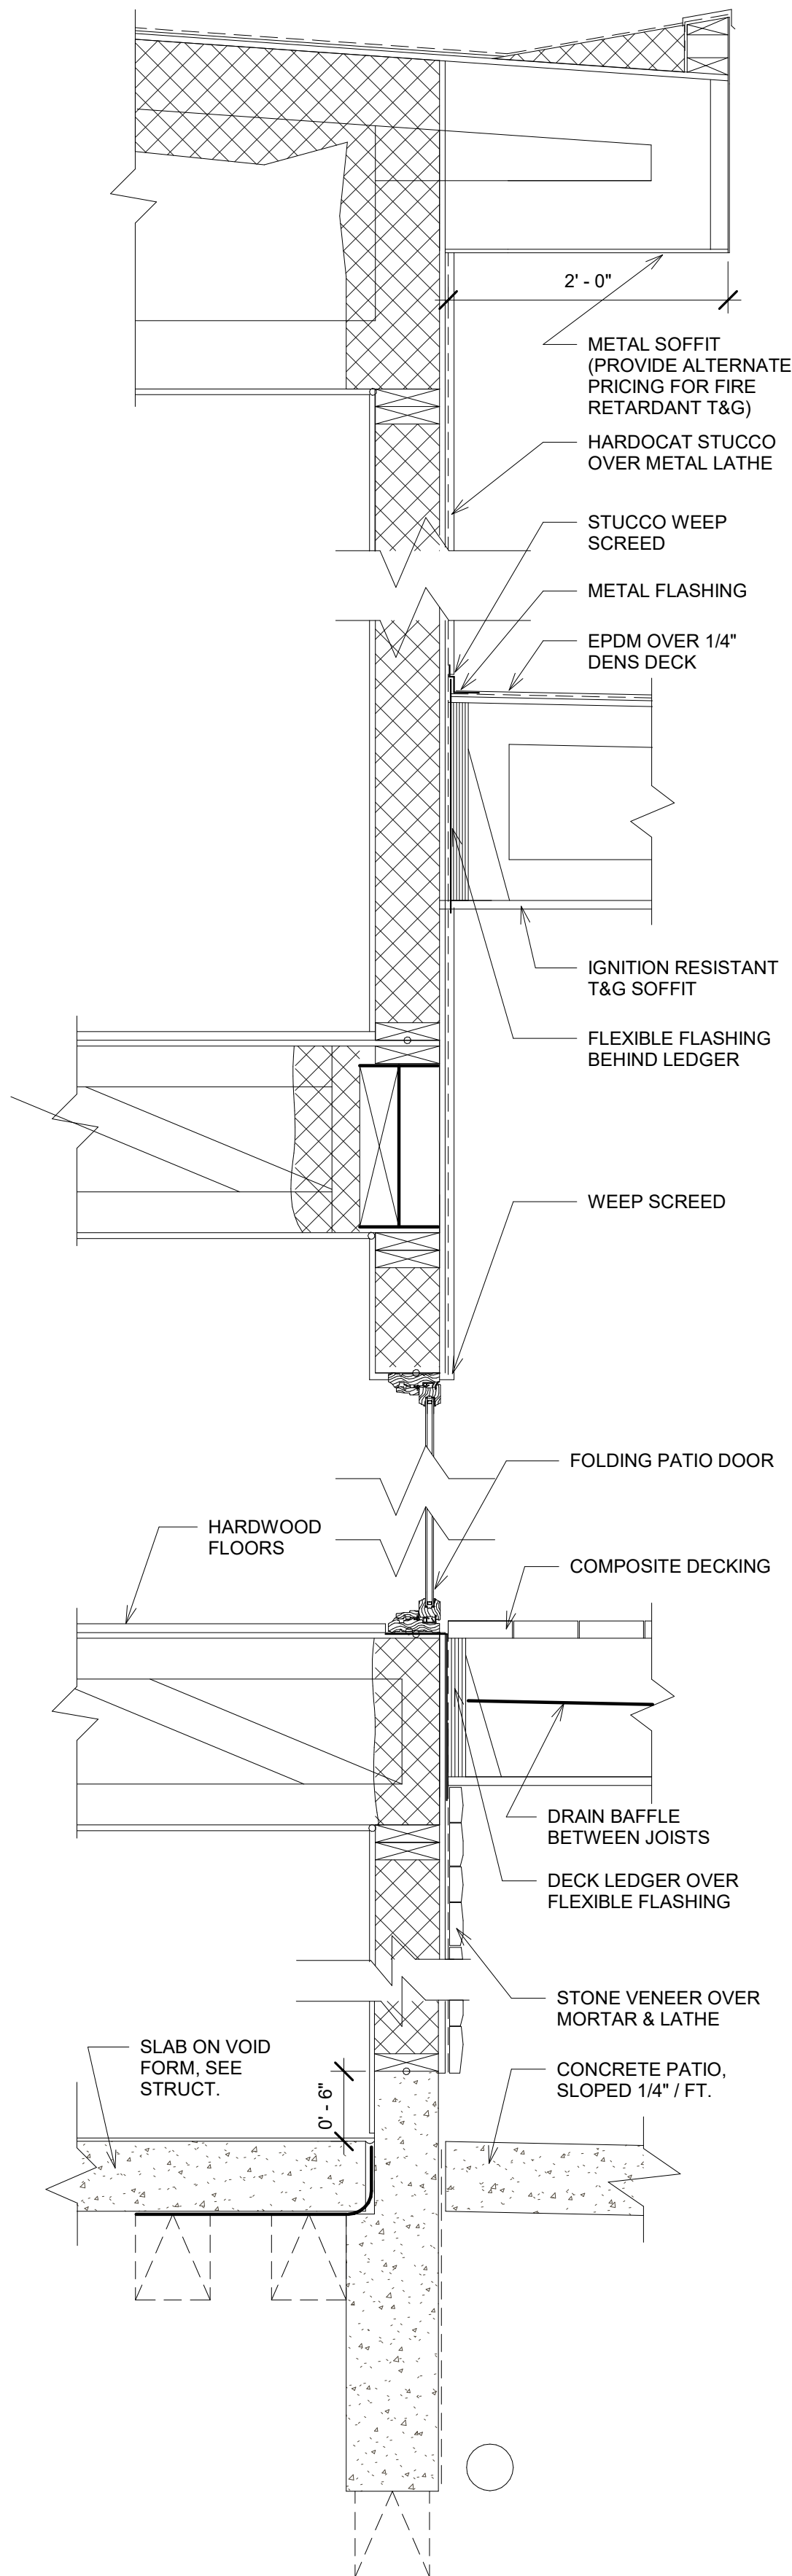


6 Wall Section @ Porch
1" = 1'-0"

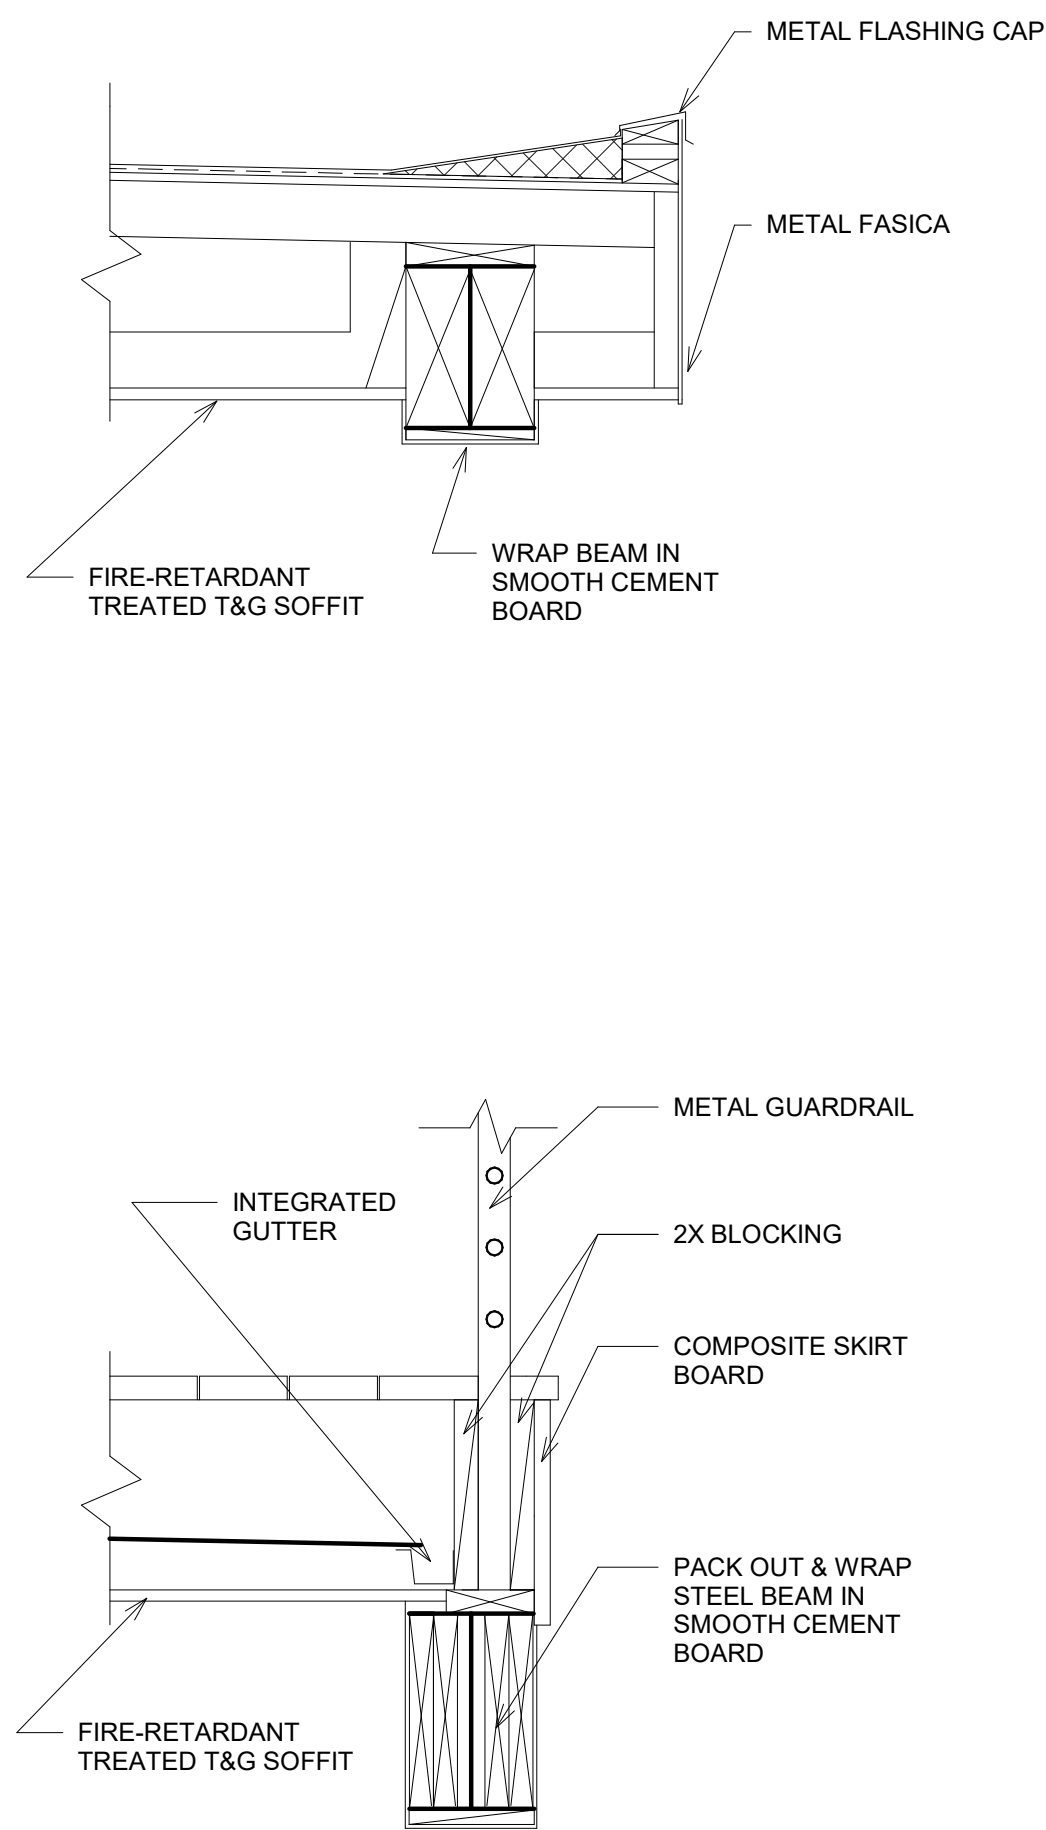


3 Typical Wall Section
1" = 1'-0"

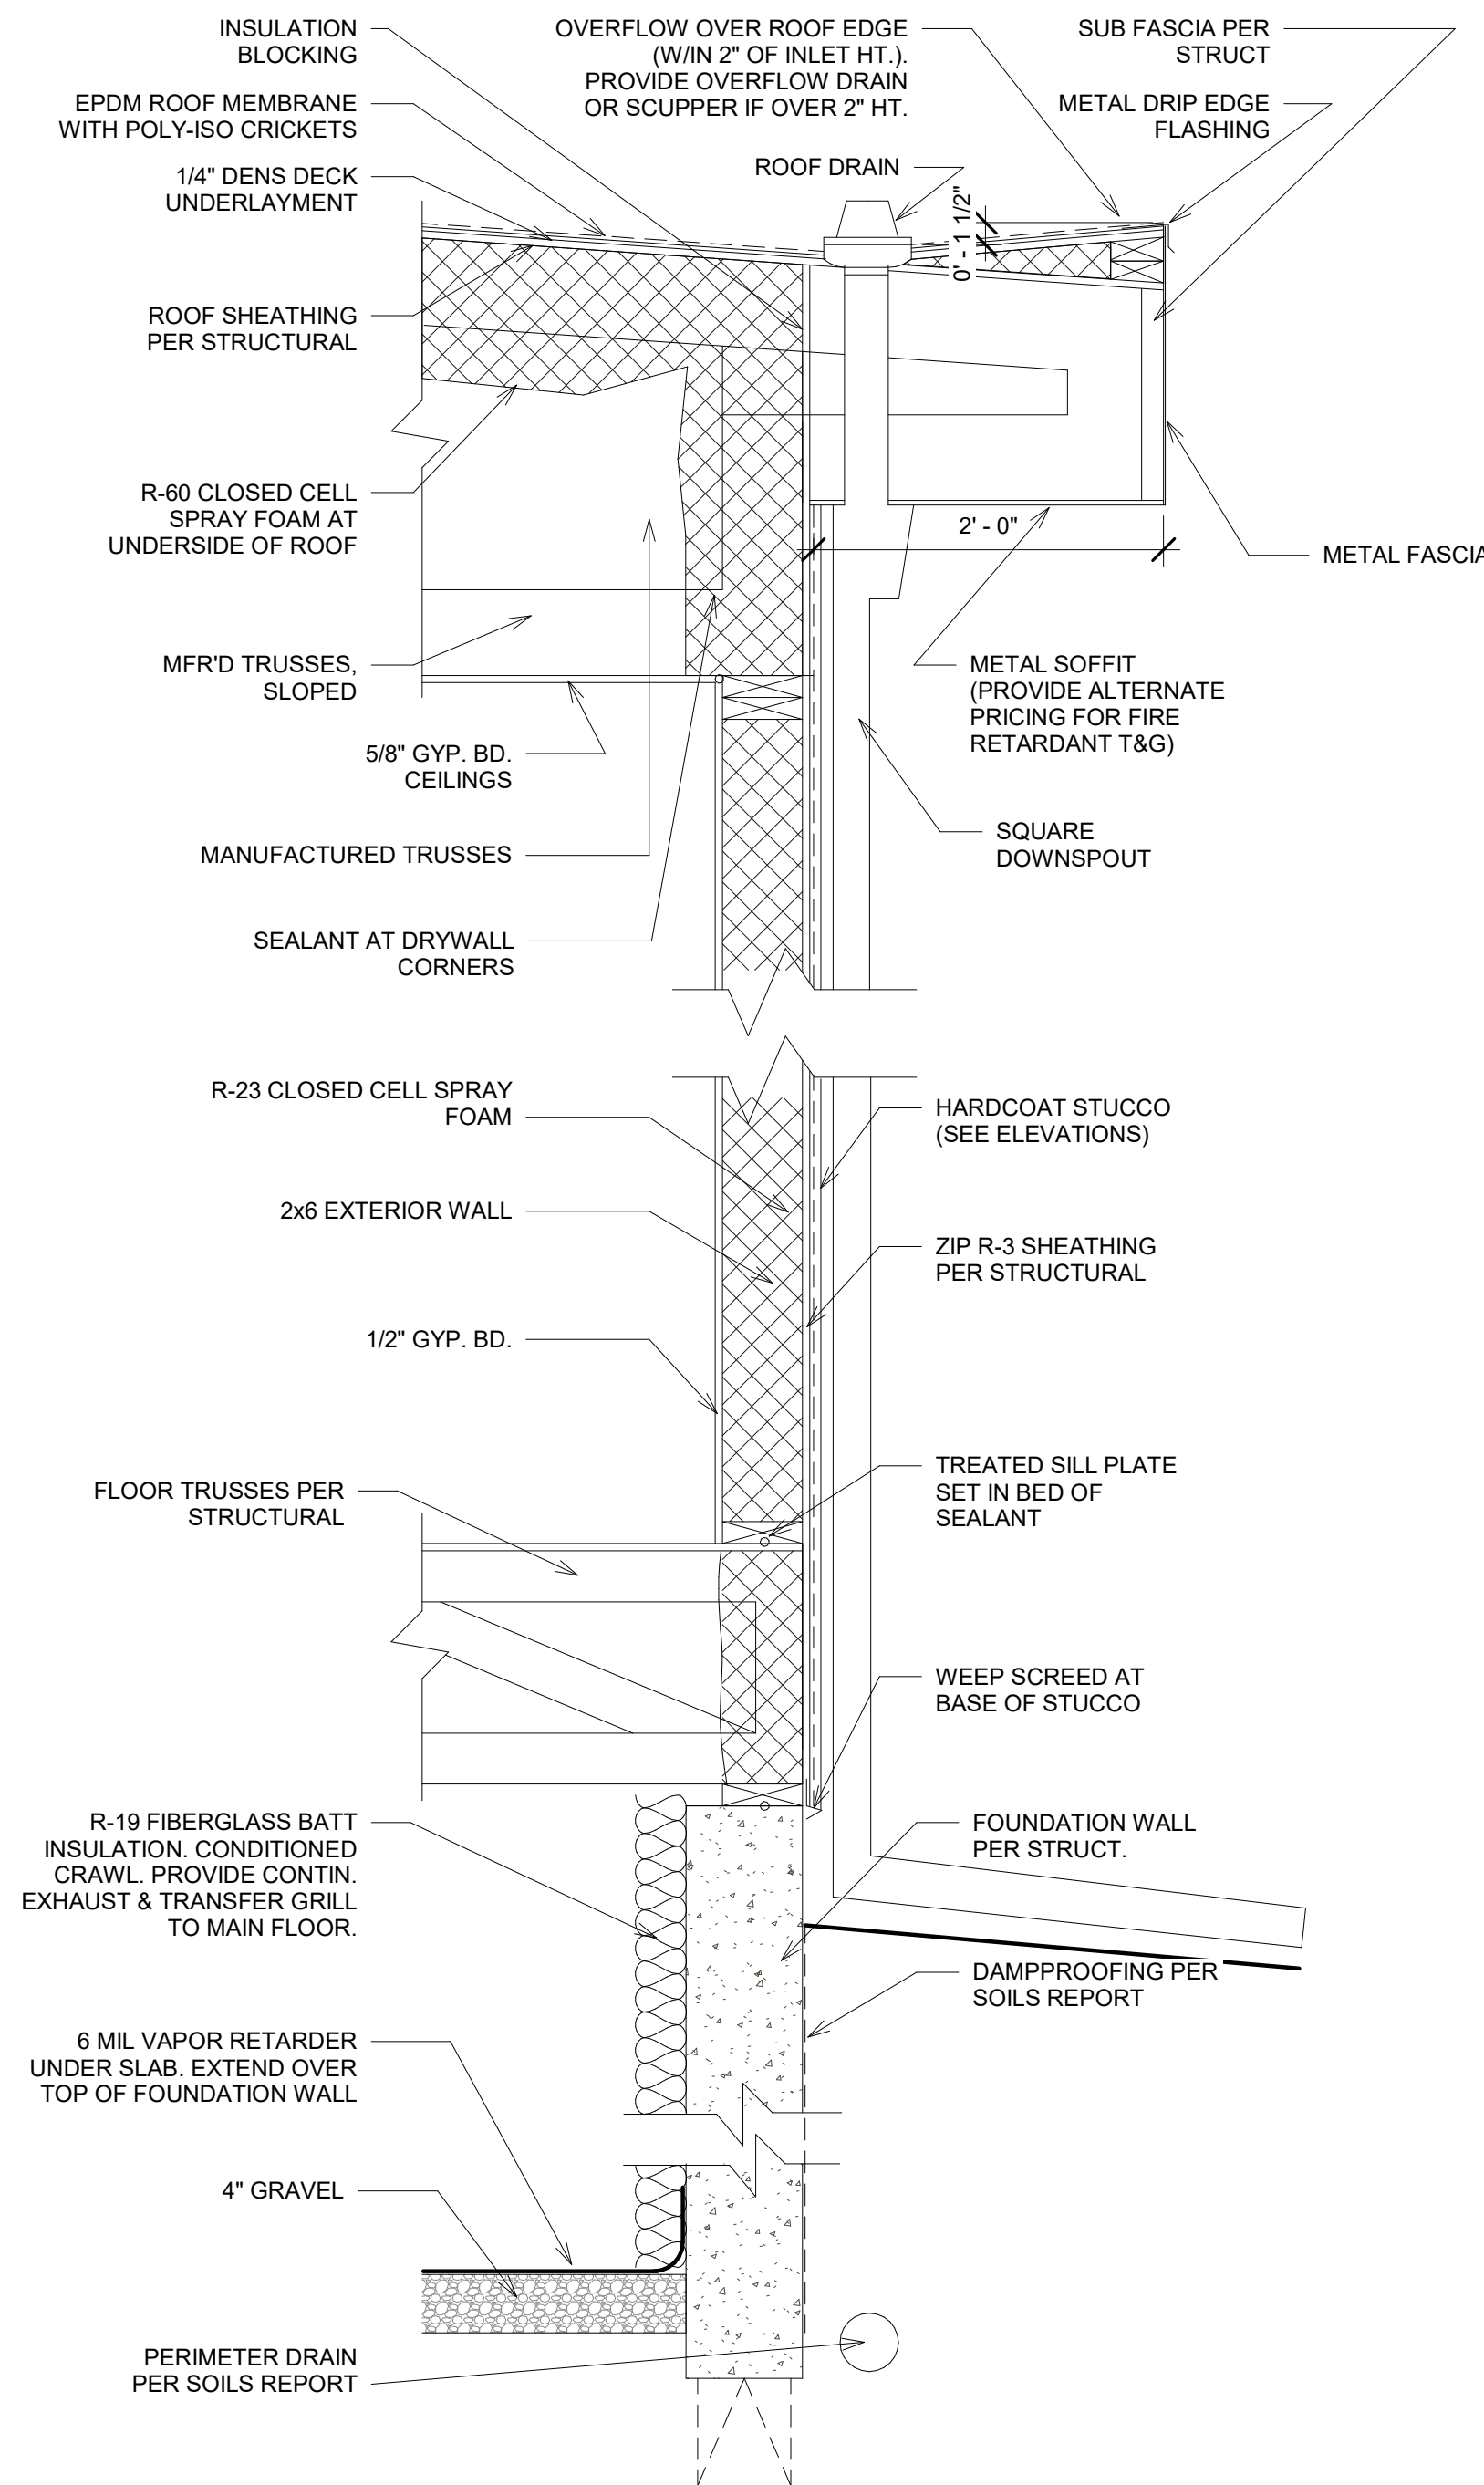


3 Typical Wall Section
1" = 1'-0"

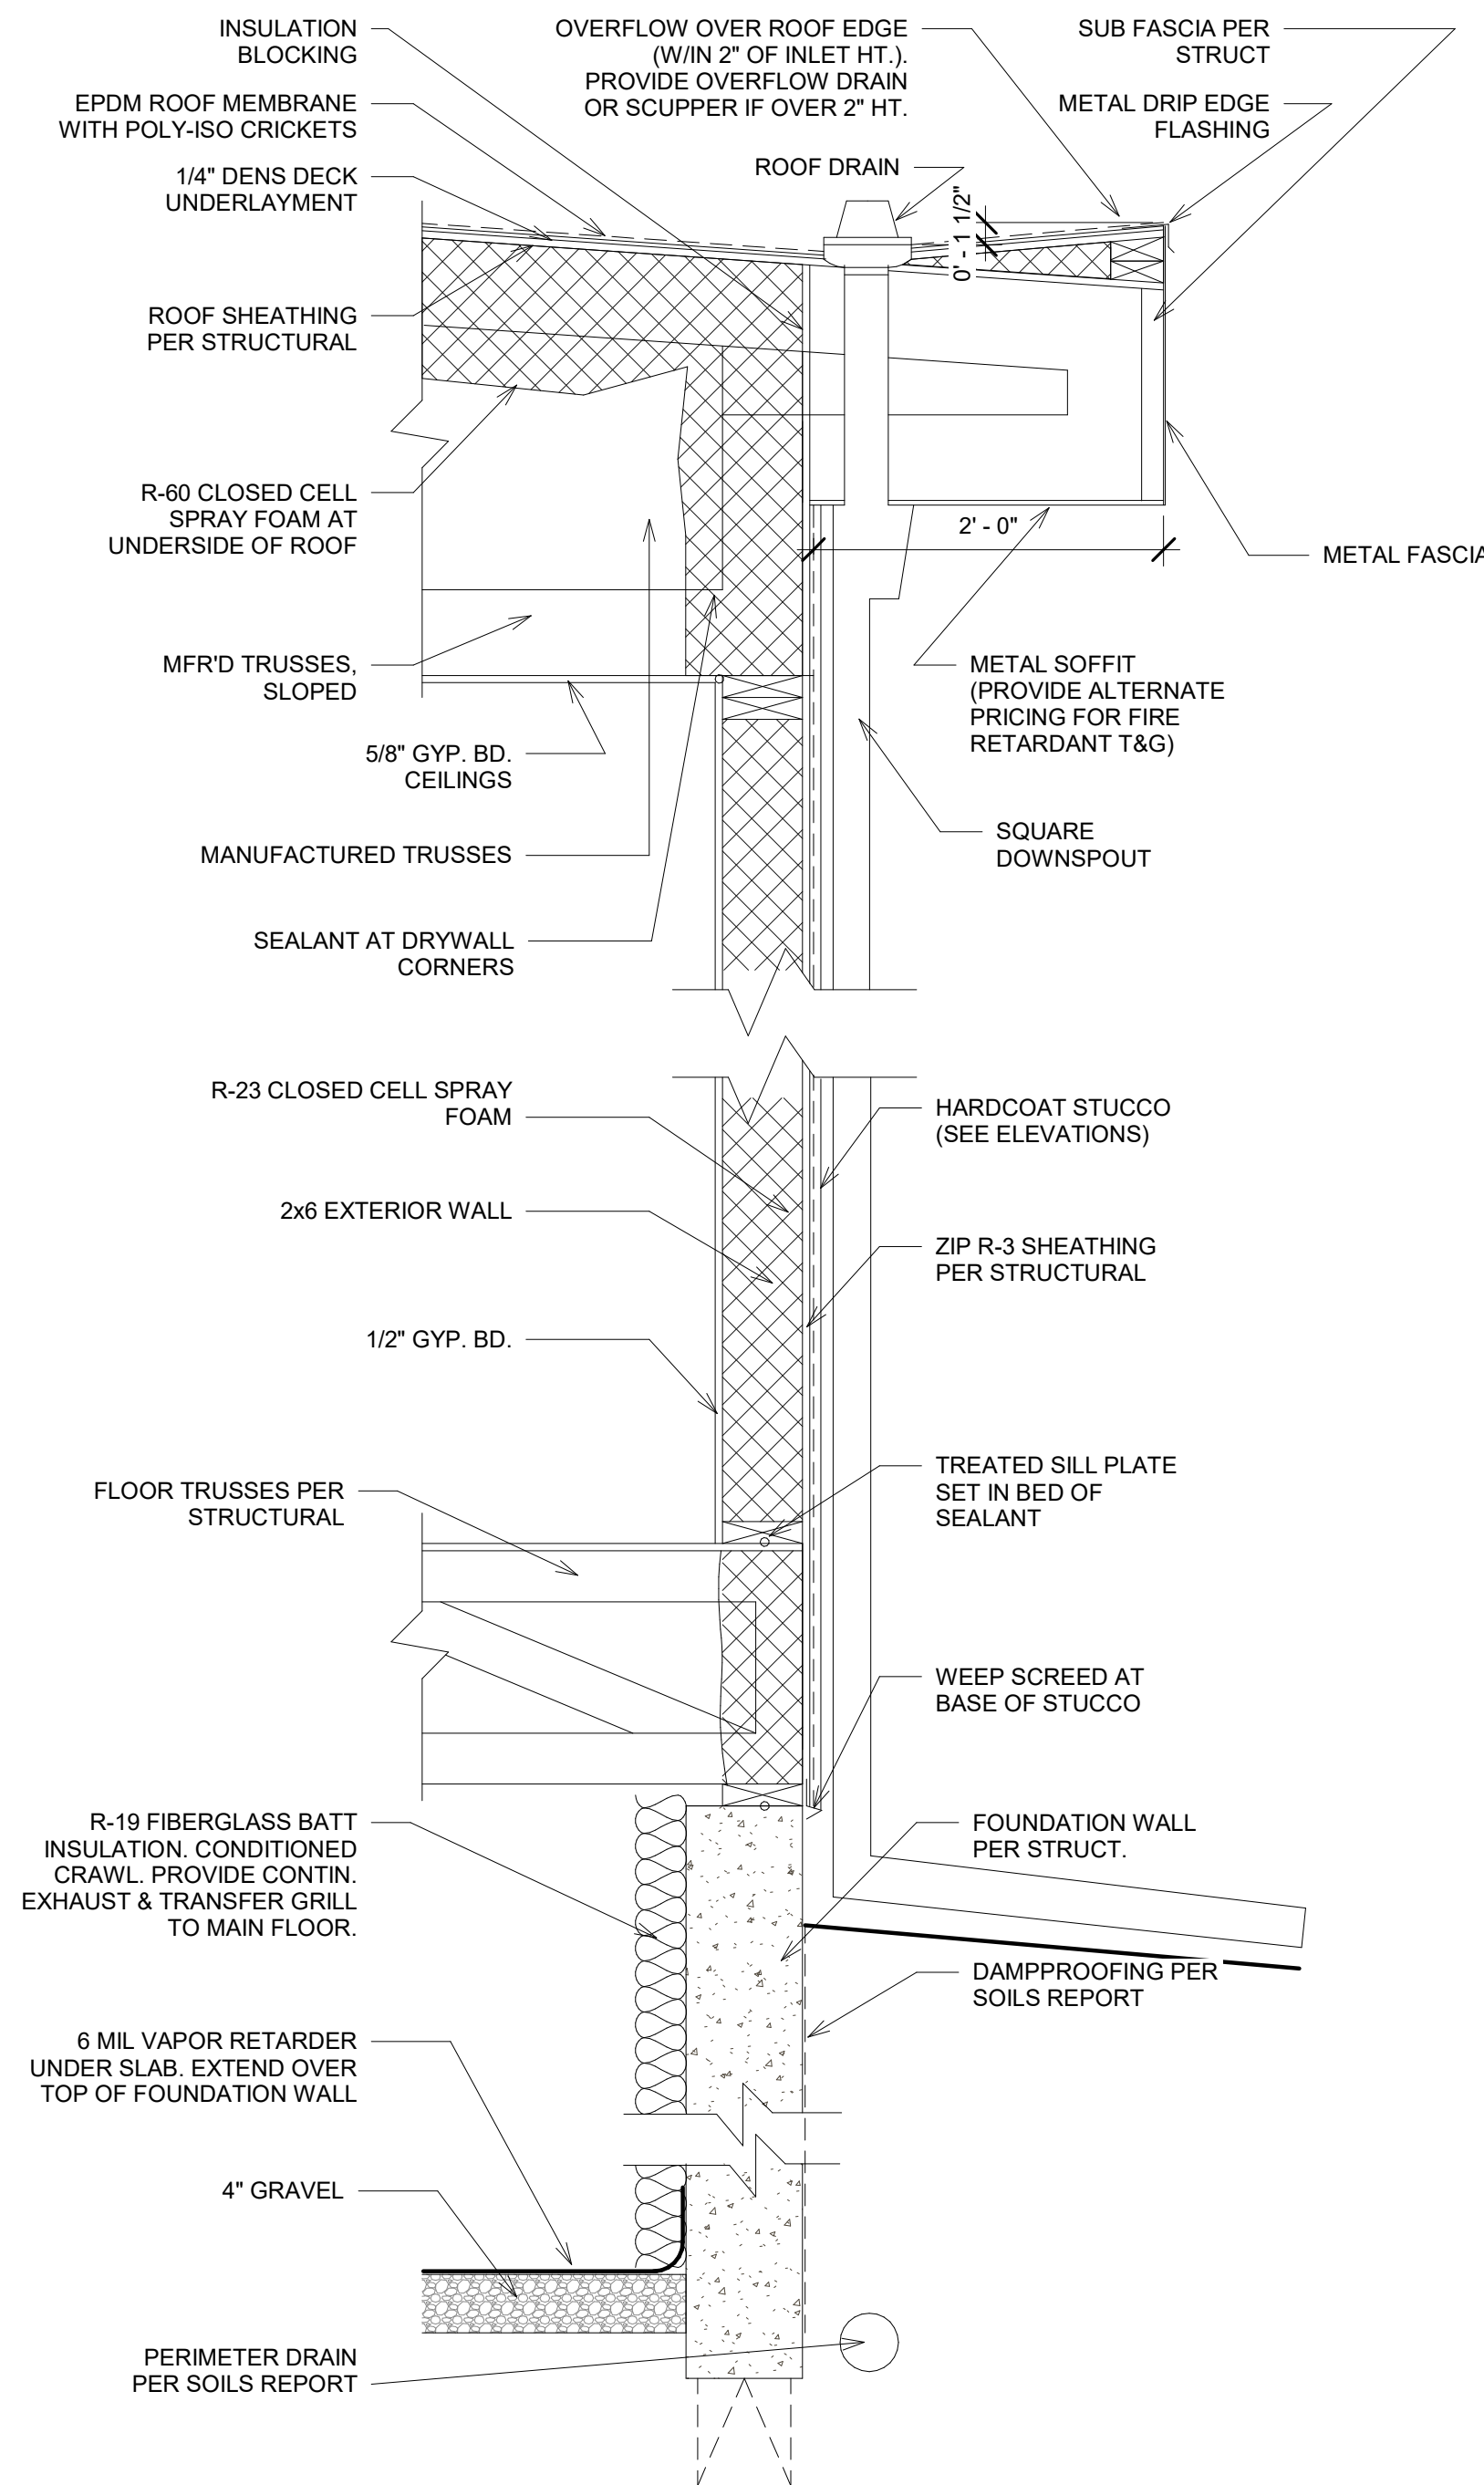


3 Typical Wall Section
1" = 1'-0"

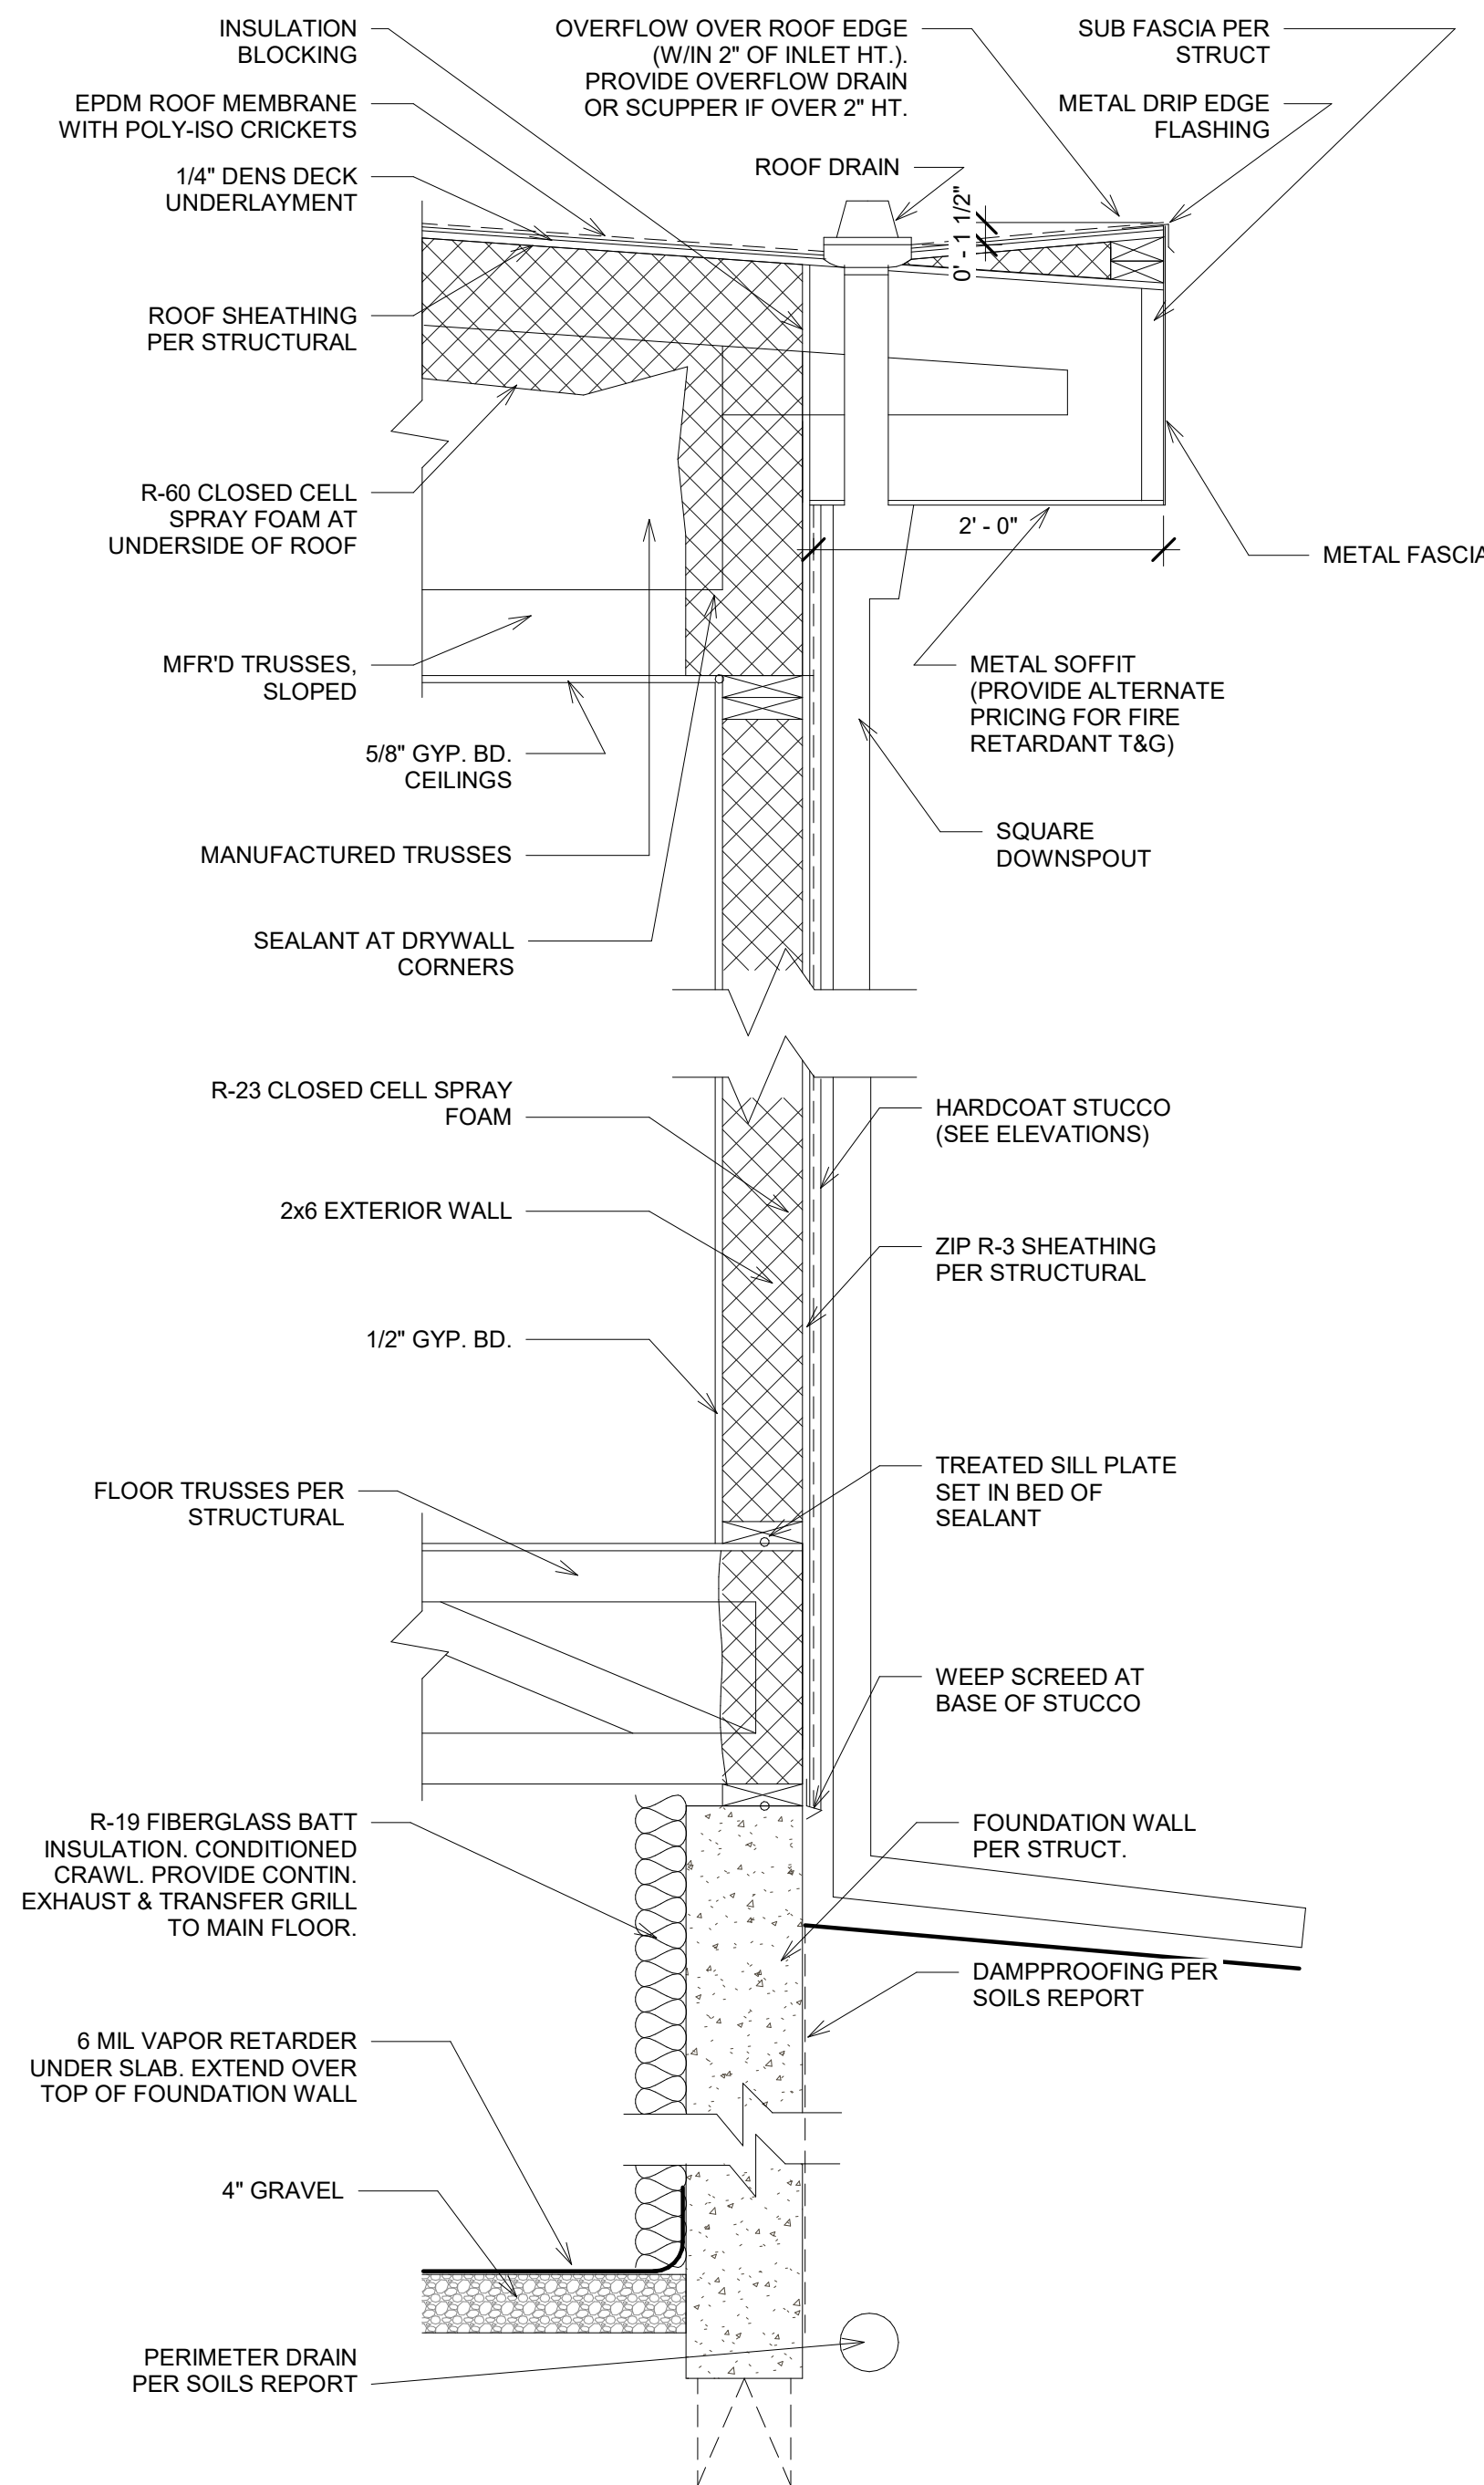


3 Typical Wall Section
1" = 1'-0"

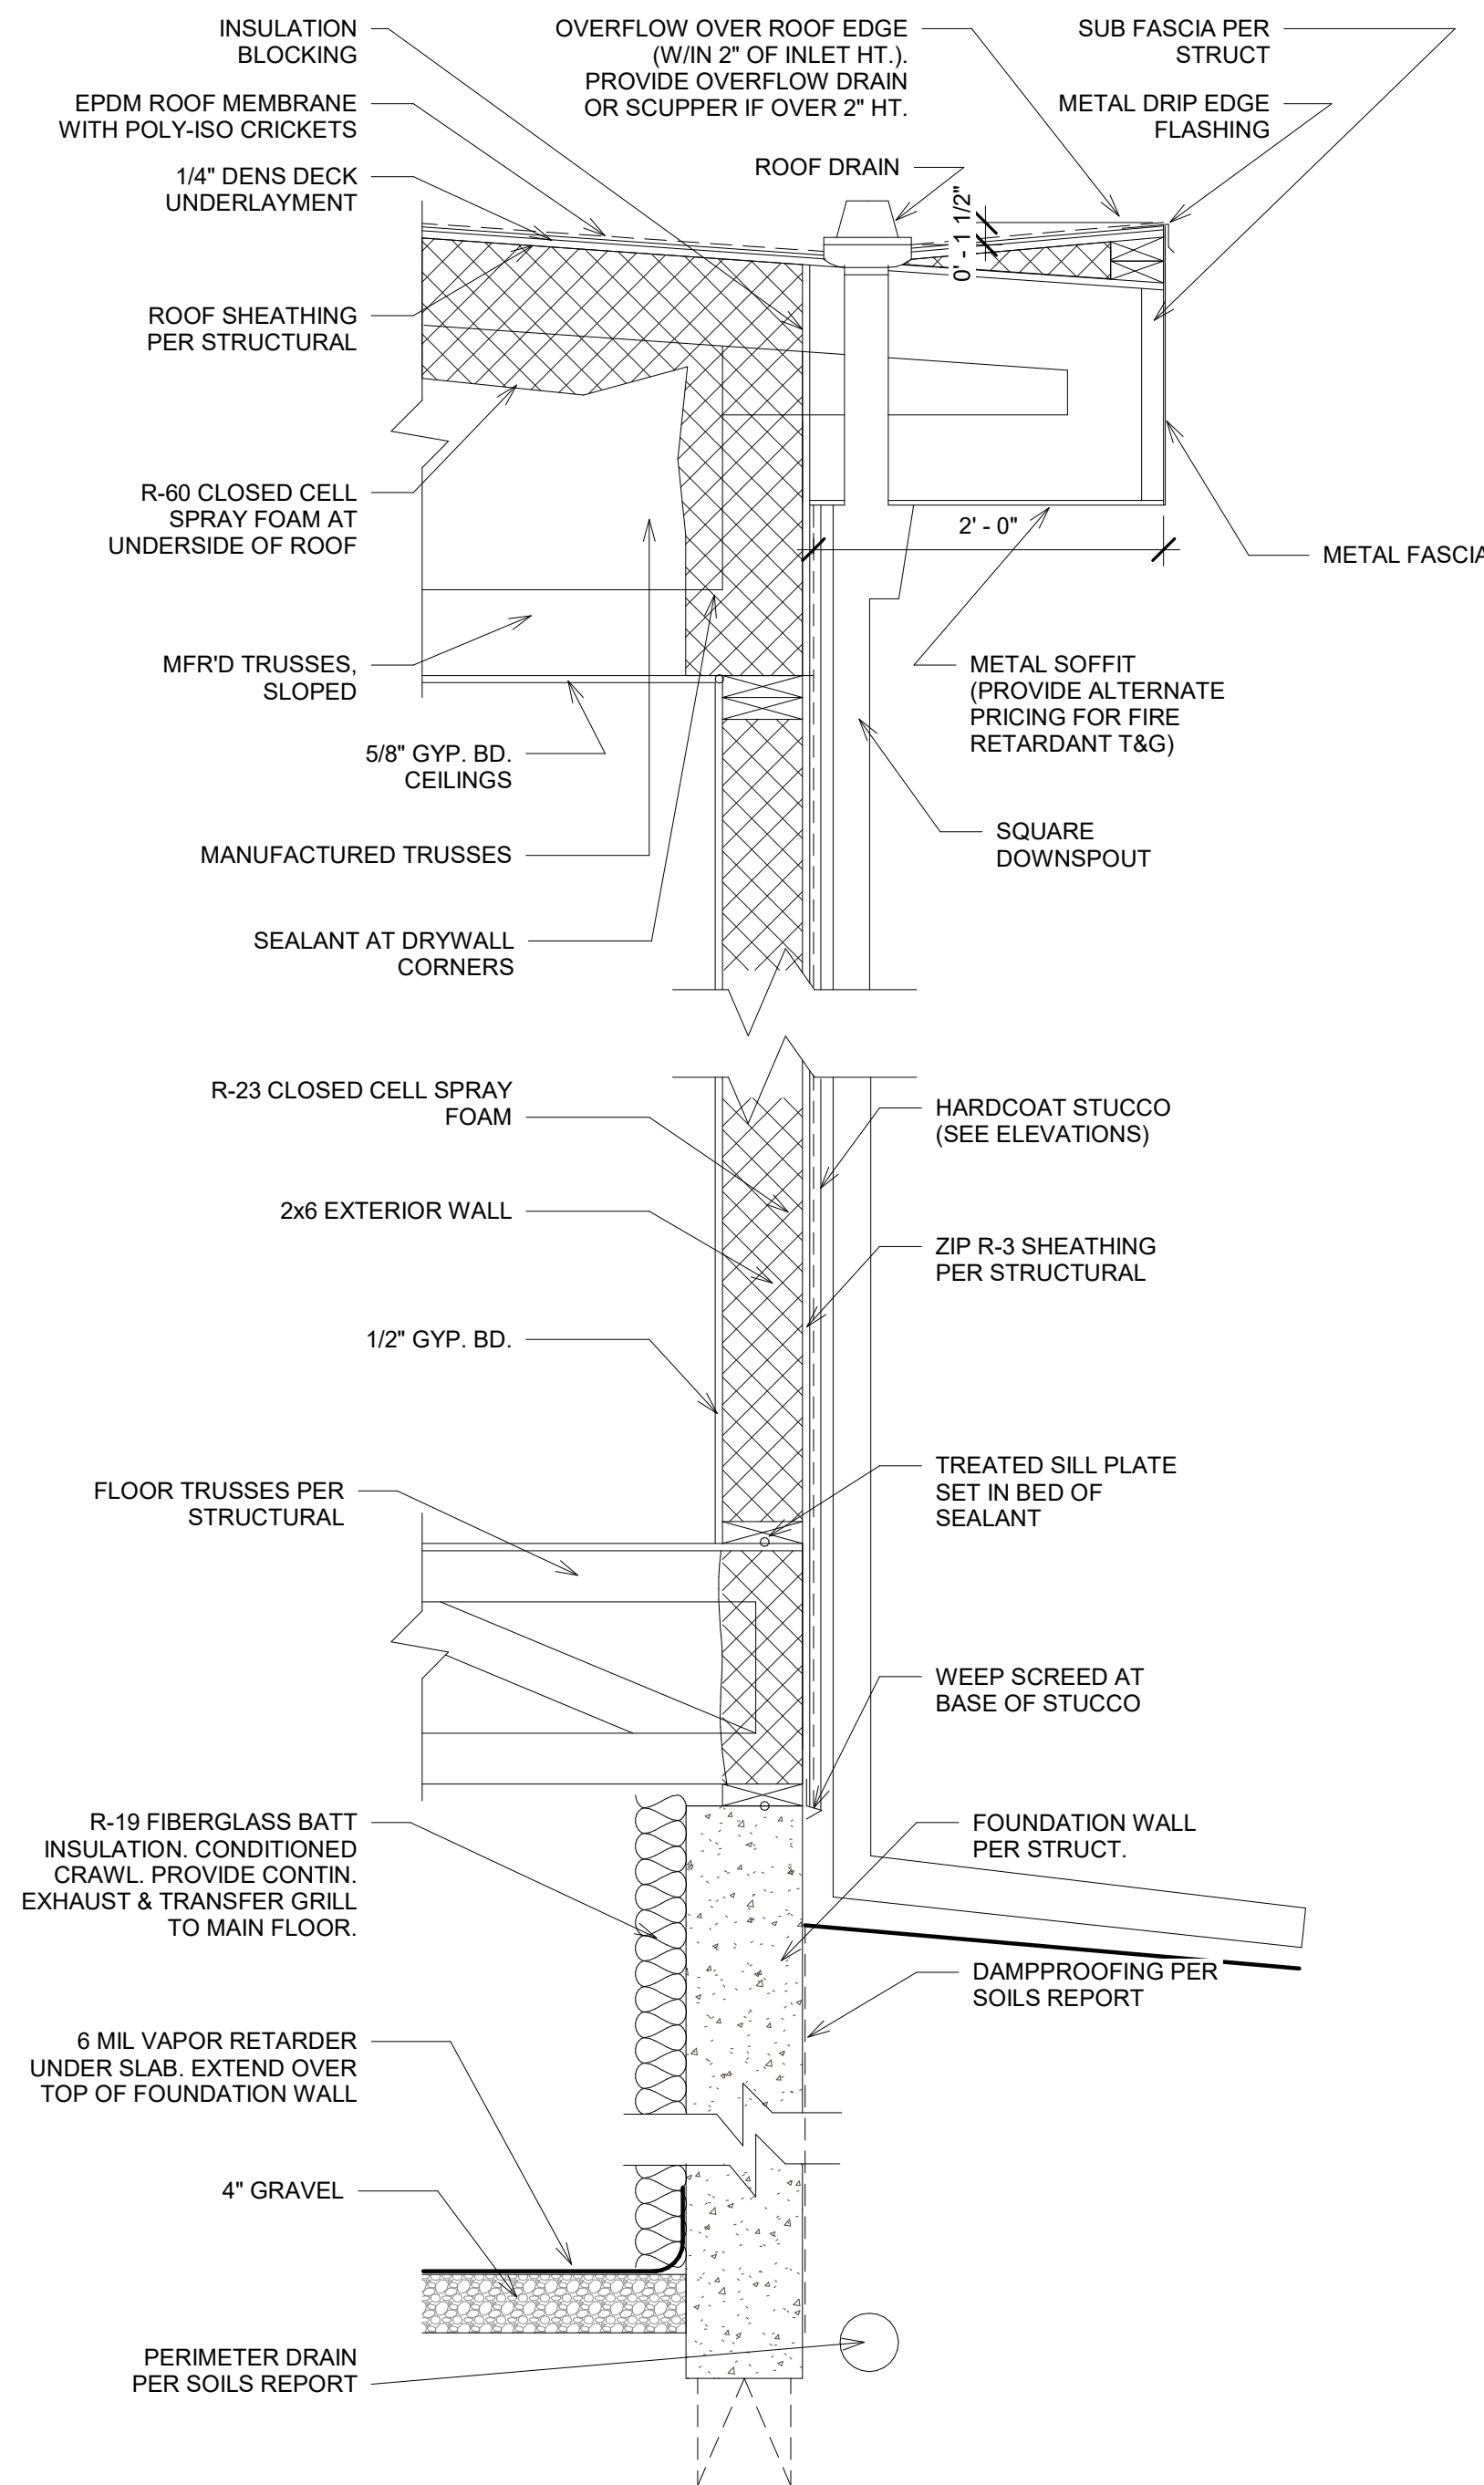


3 Typical Wall Section
1" = 1'-0"

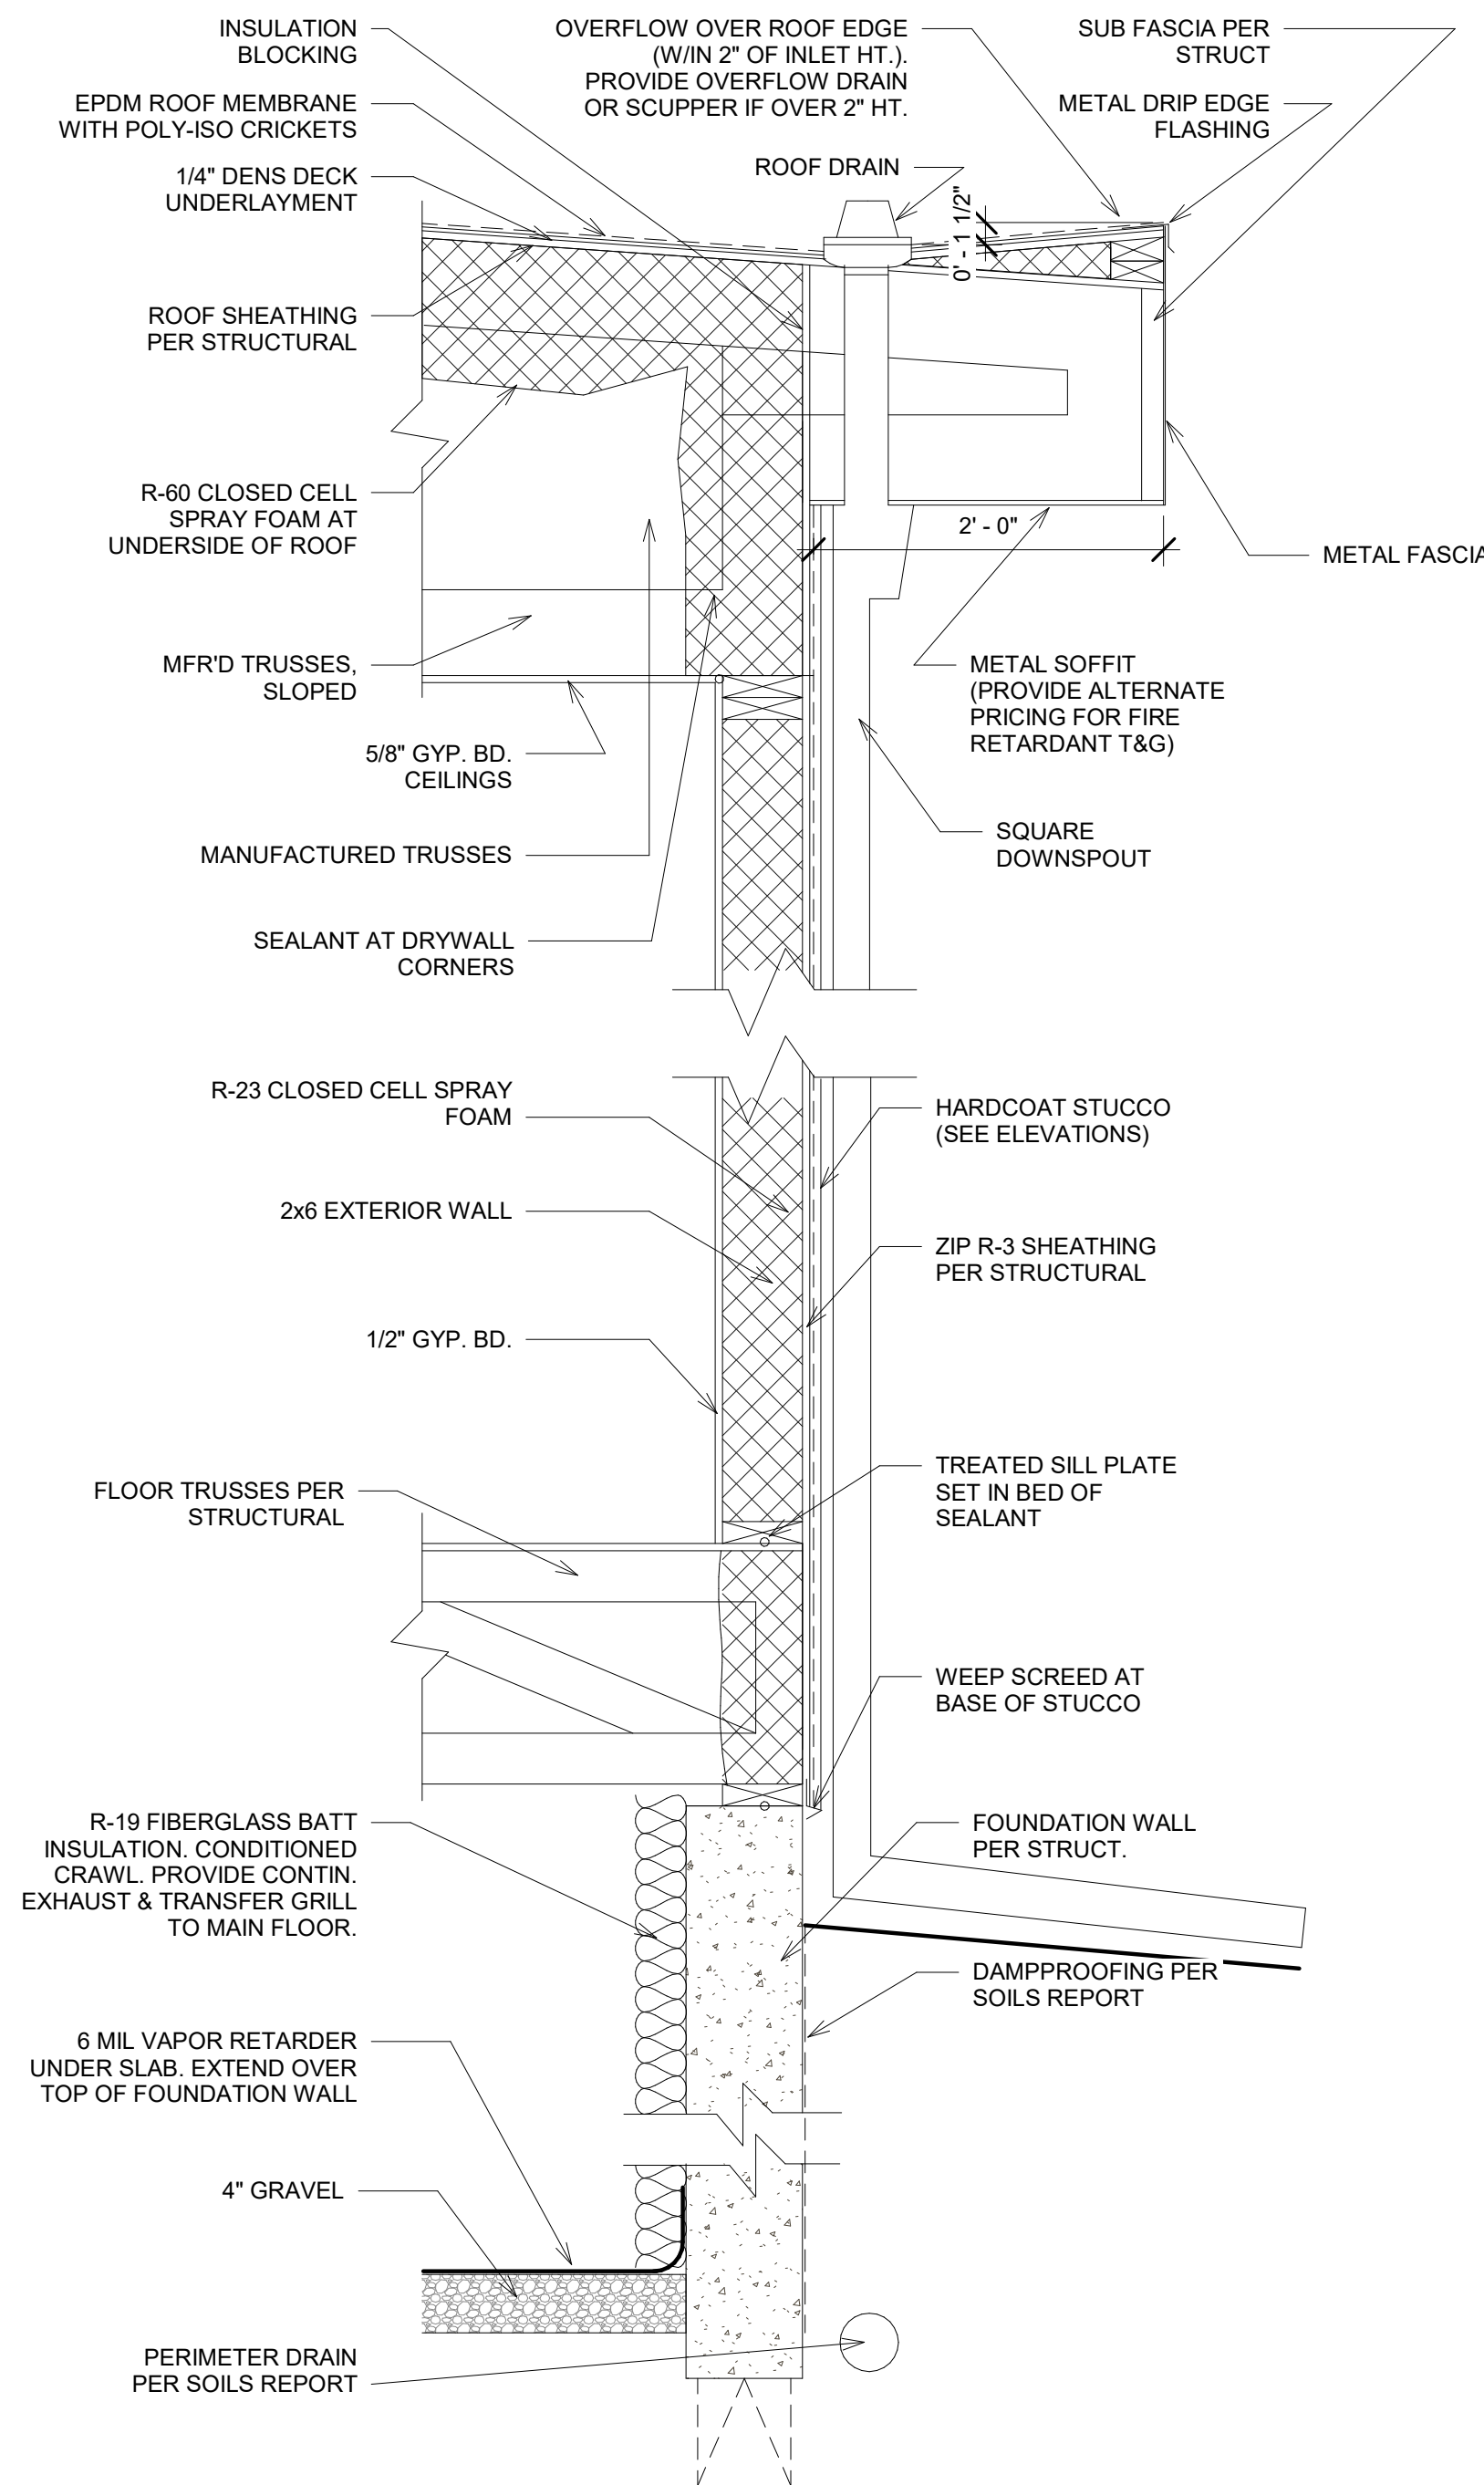


3 Typical Wall Section
1" = 1'-0"

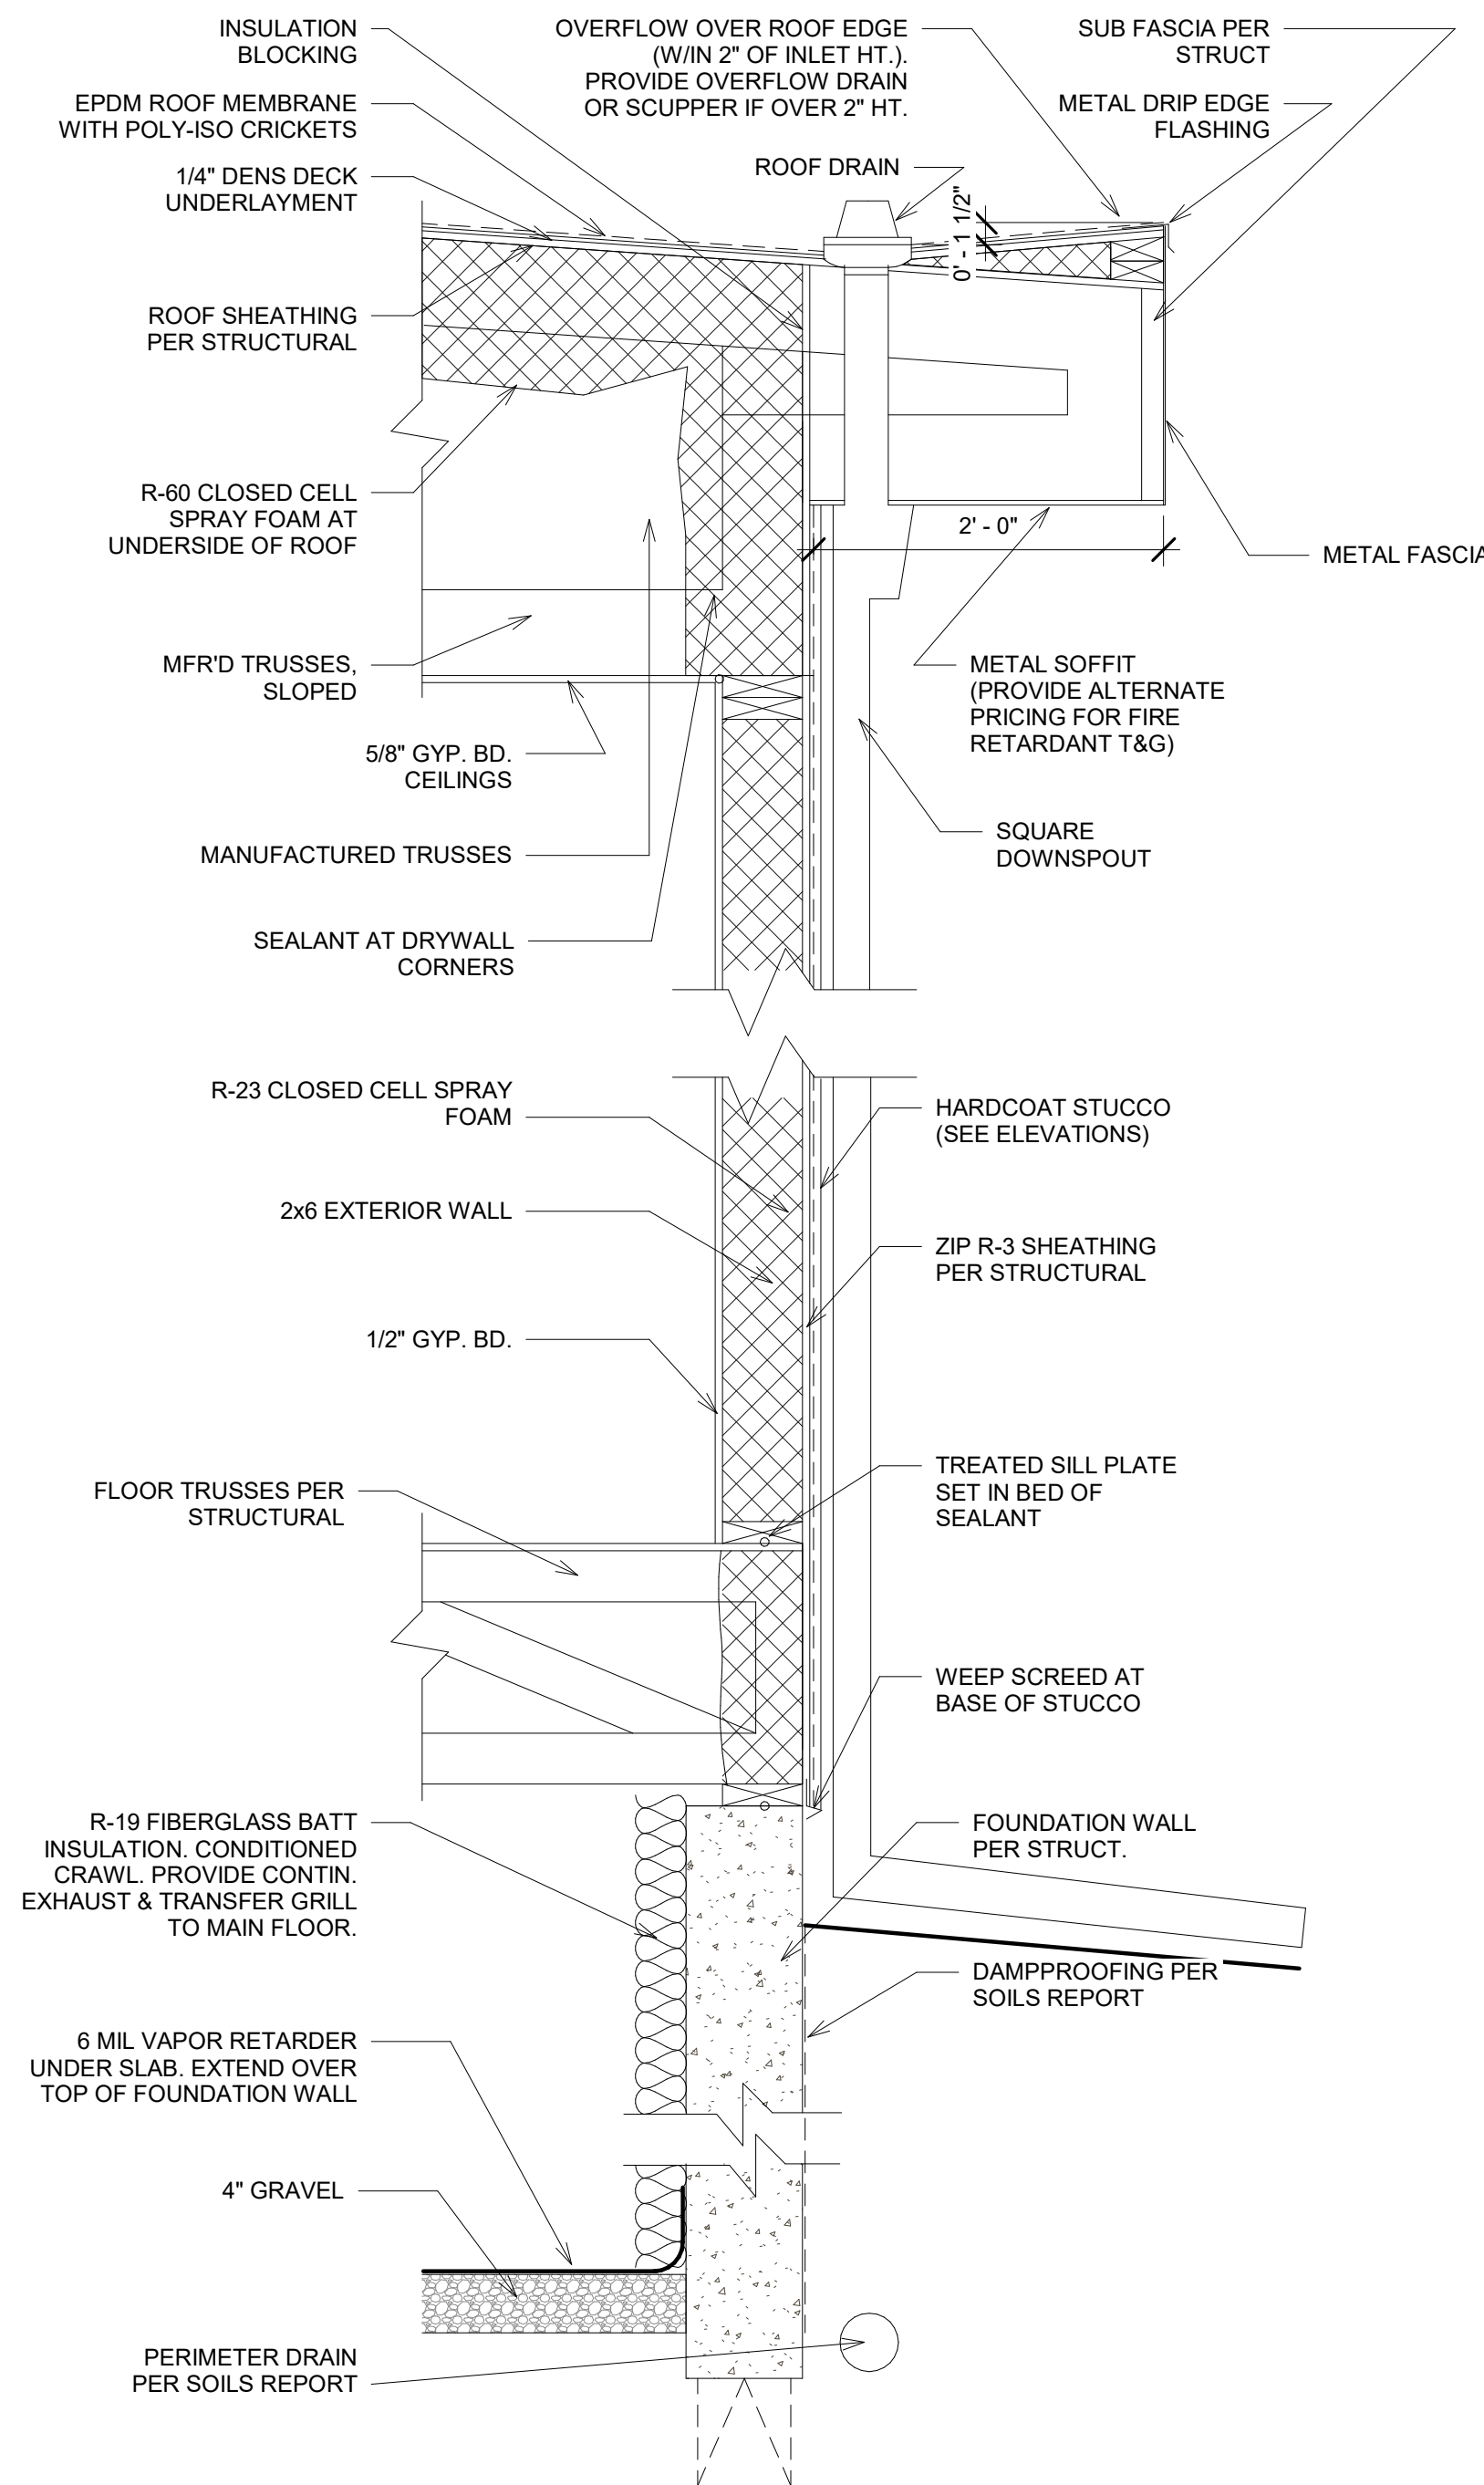


3 Typical Wall Section
1" = 1'-0"

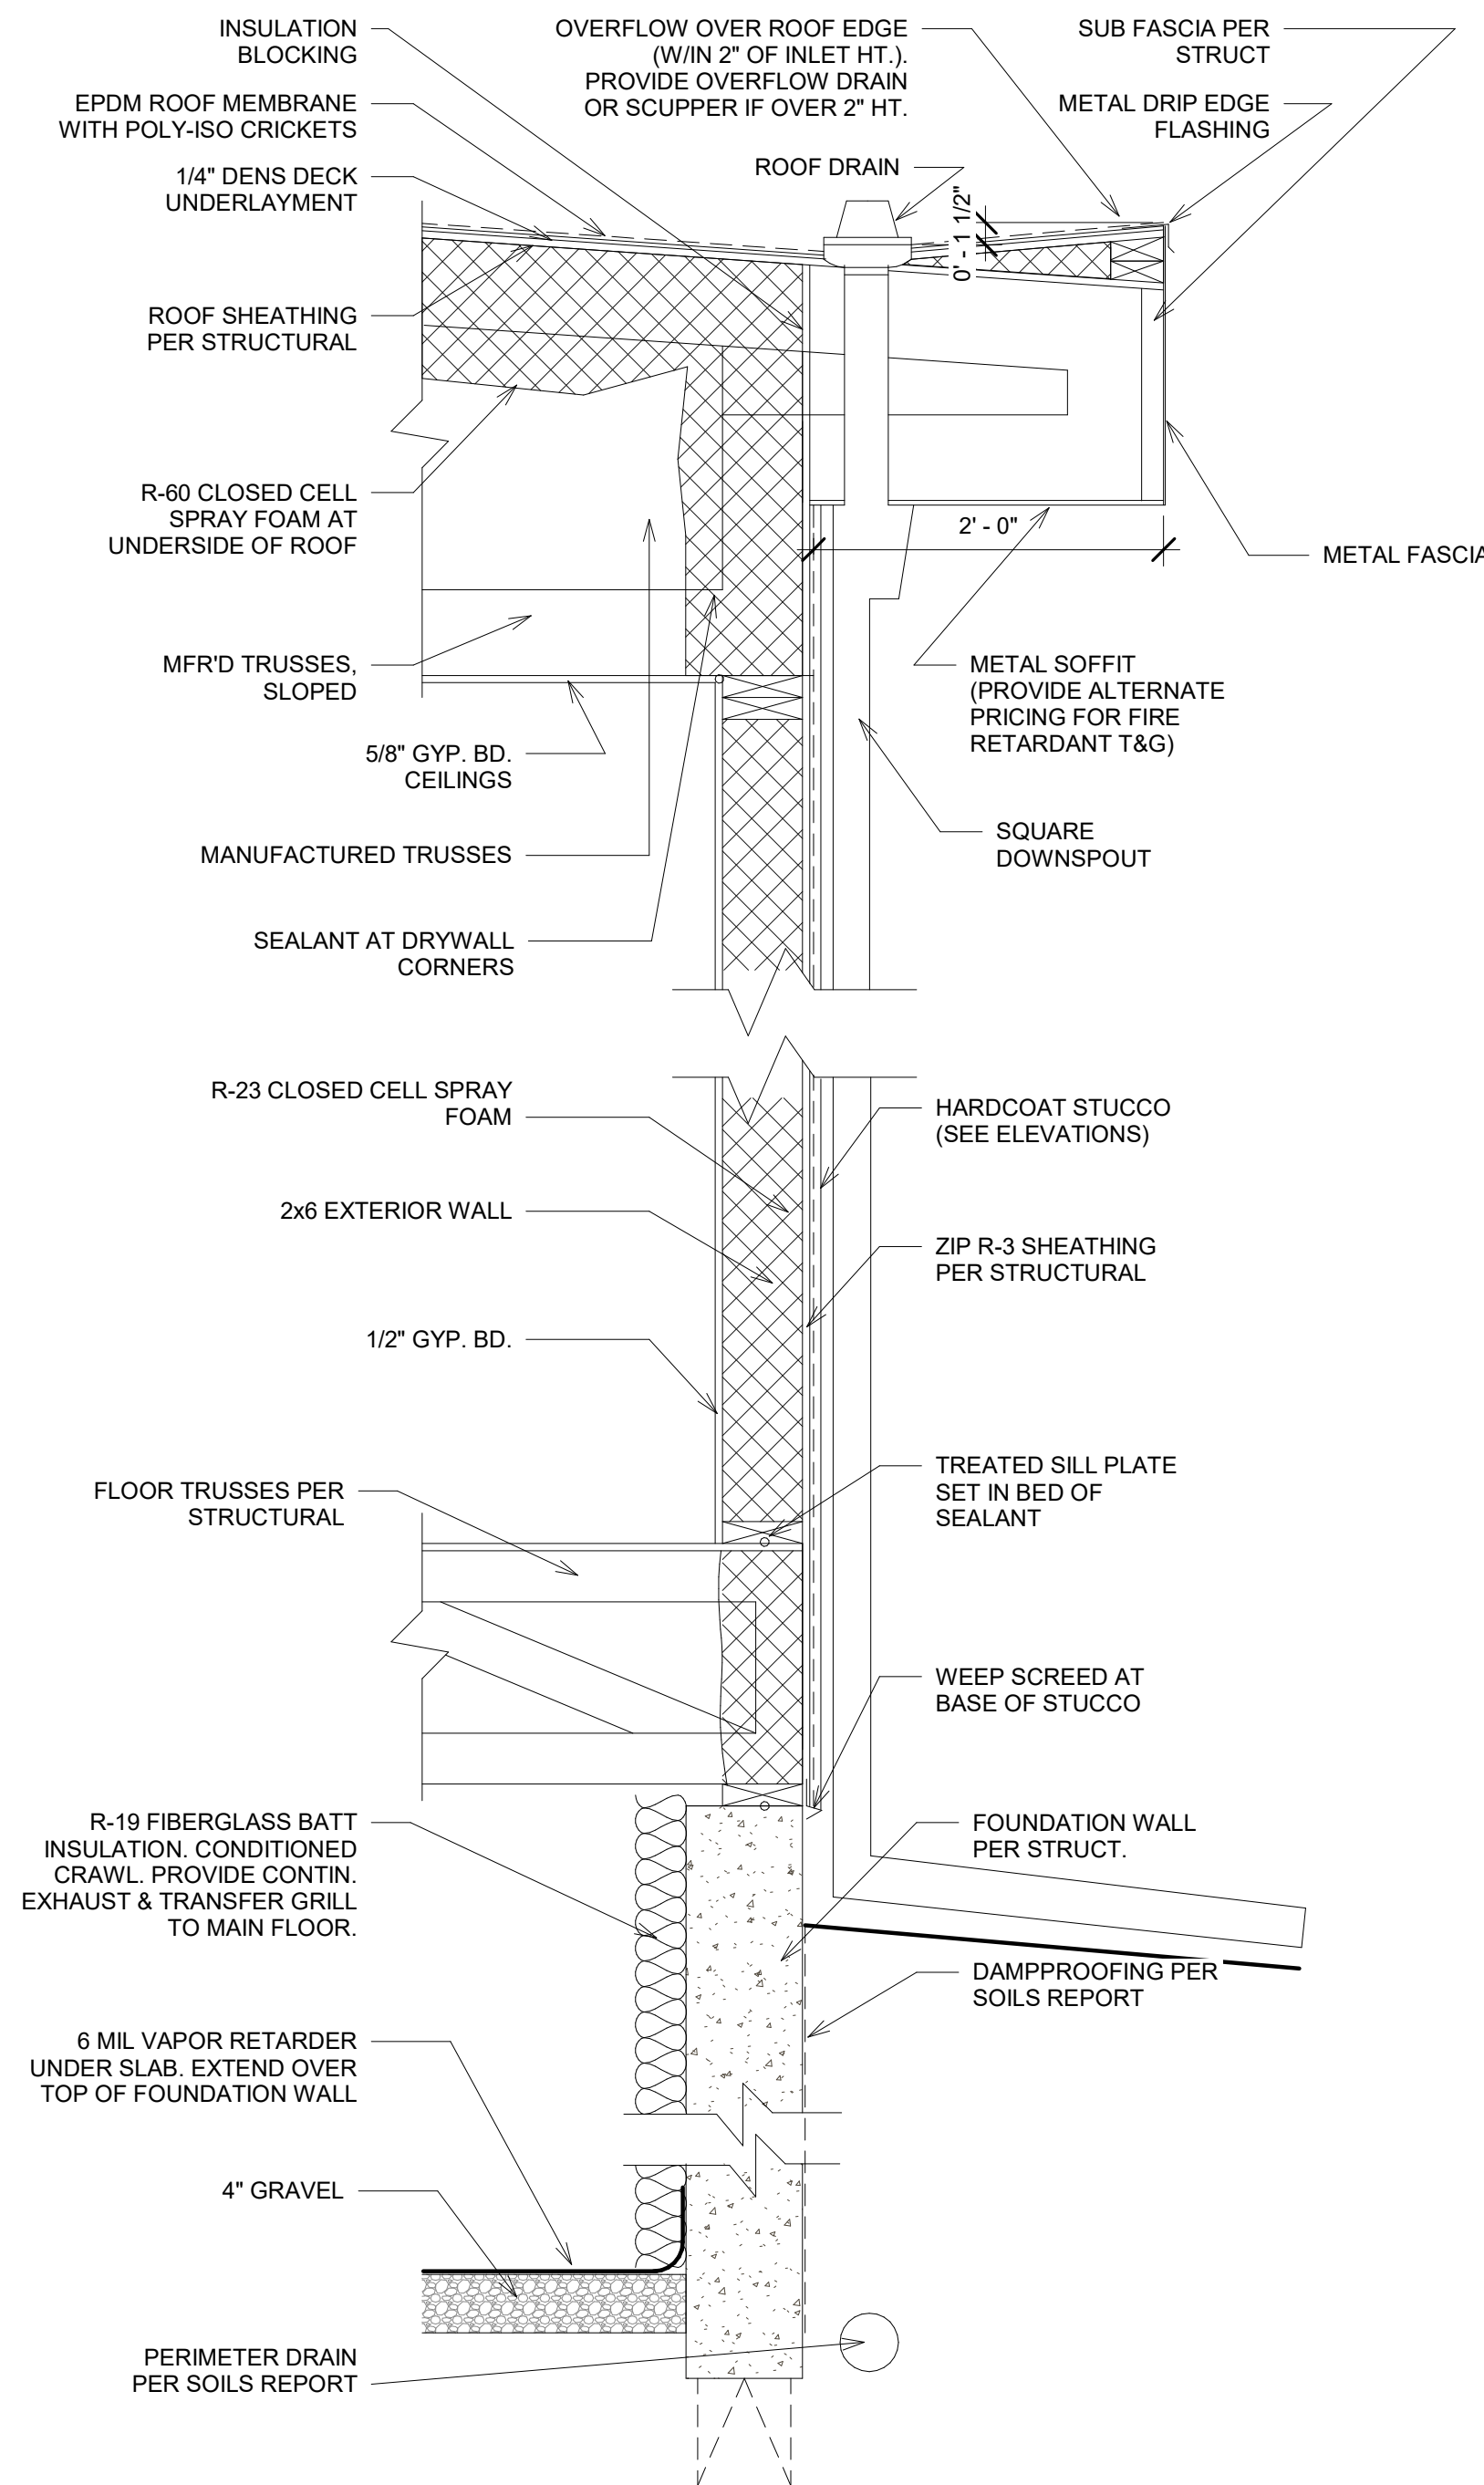


3 Typical Wall Section
1" = 1'-0"

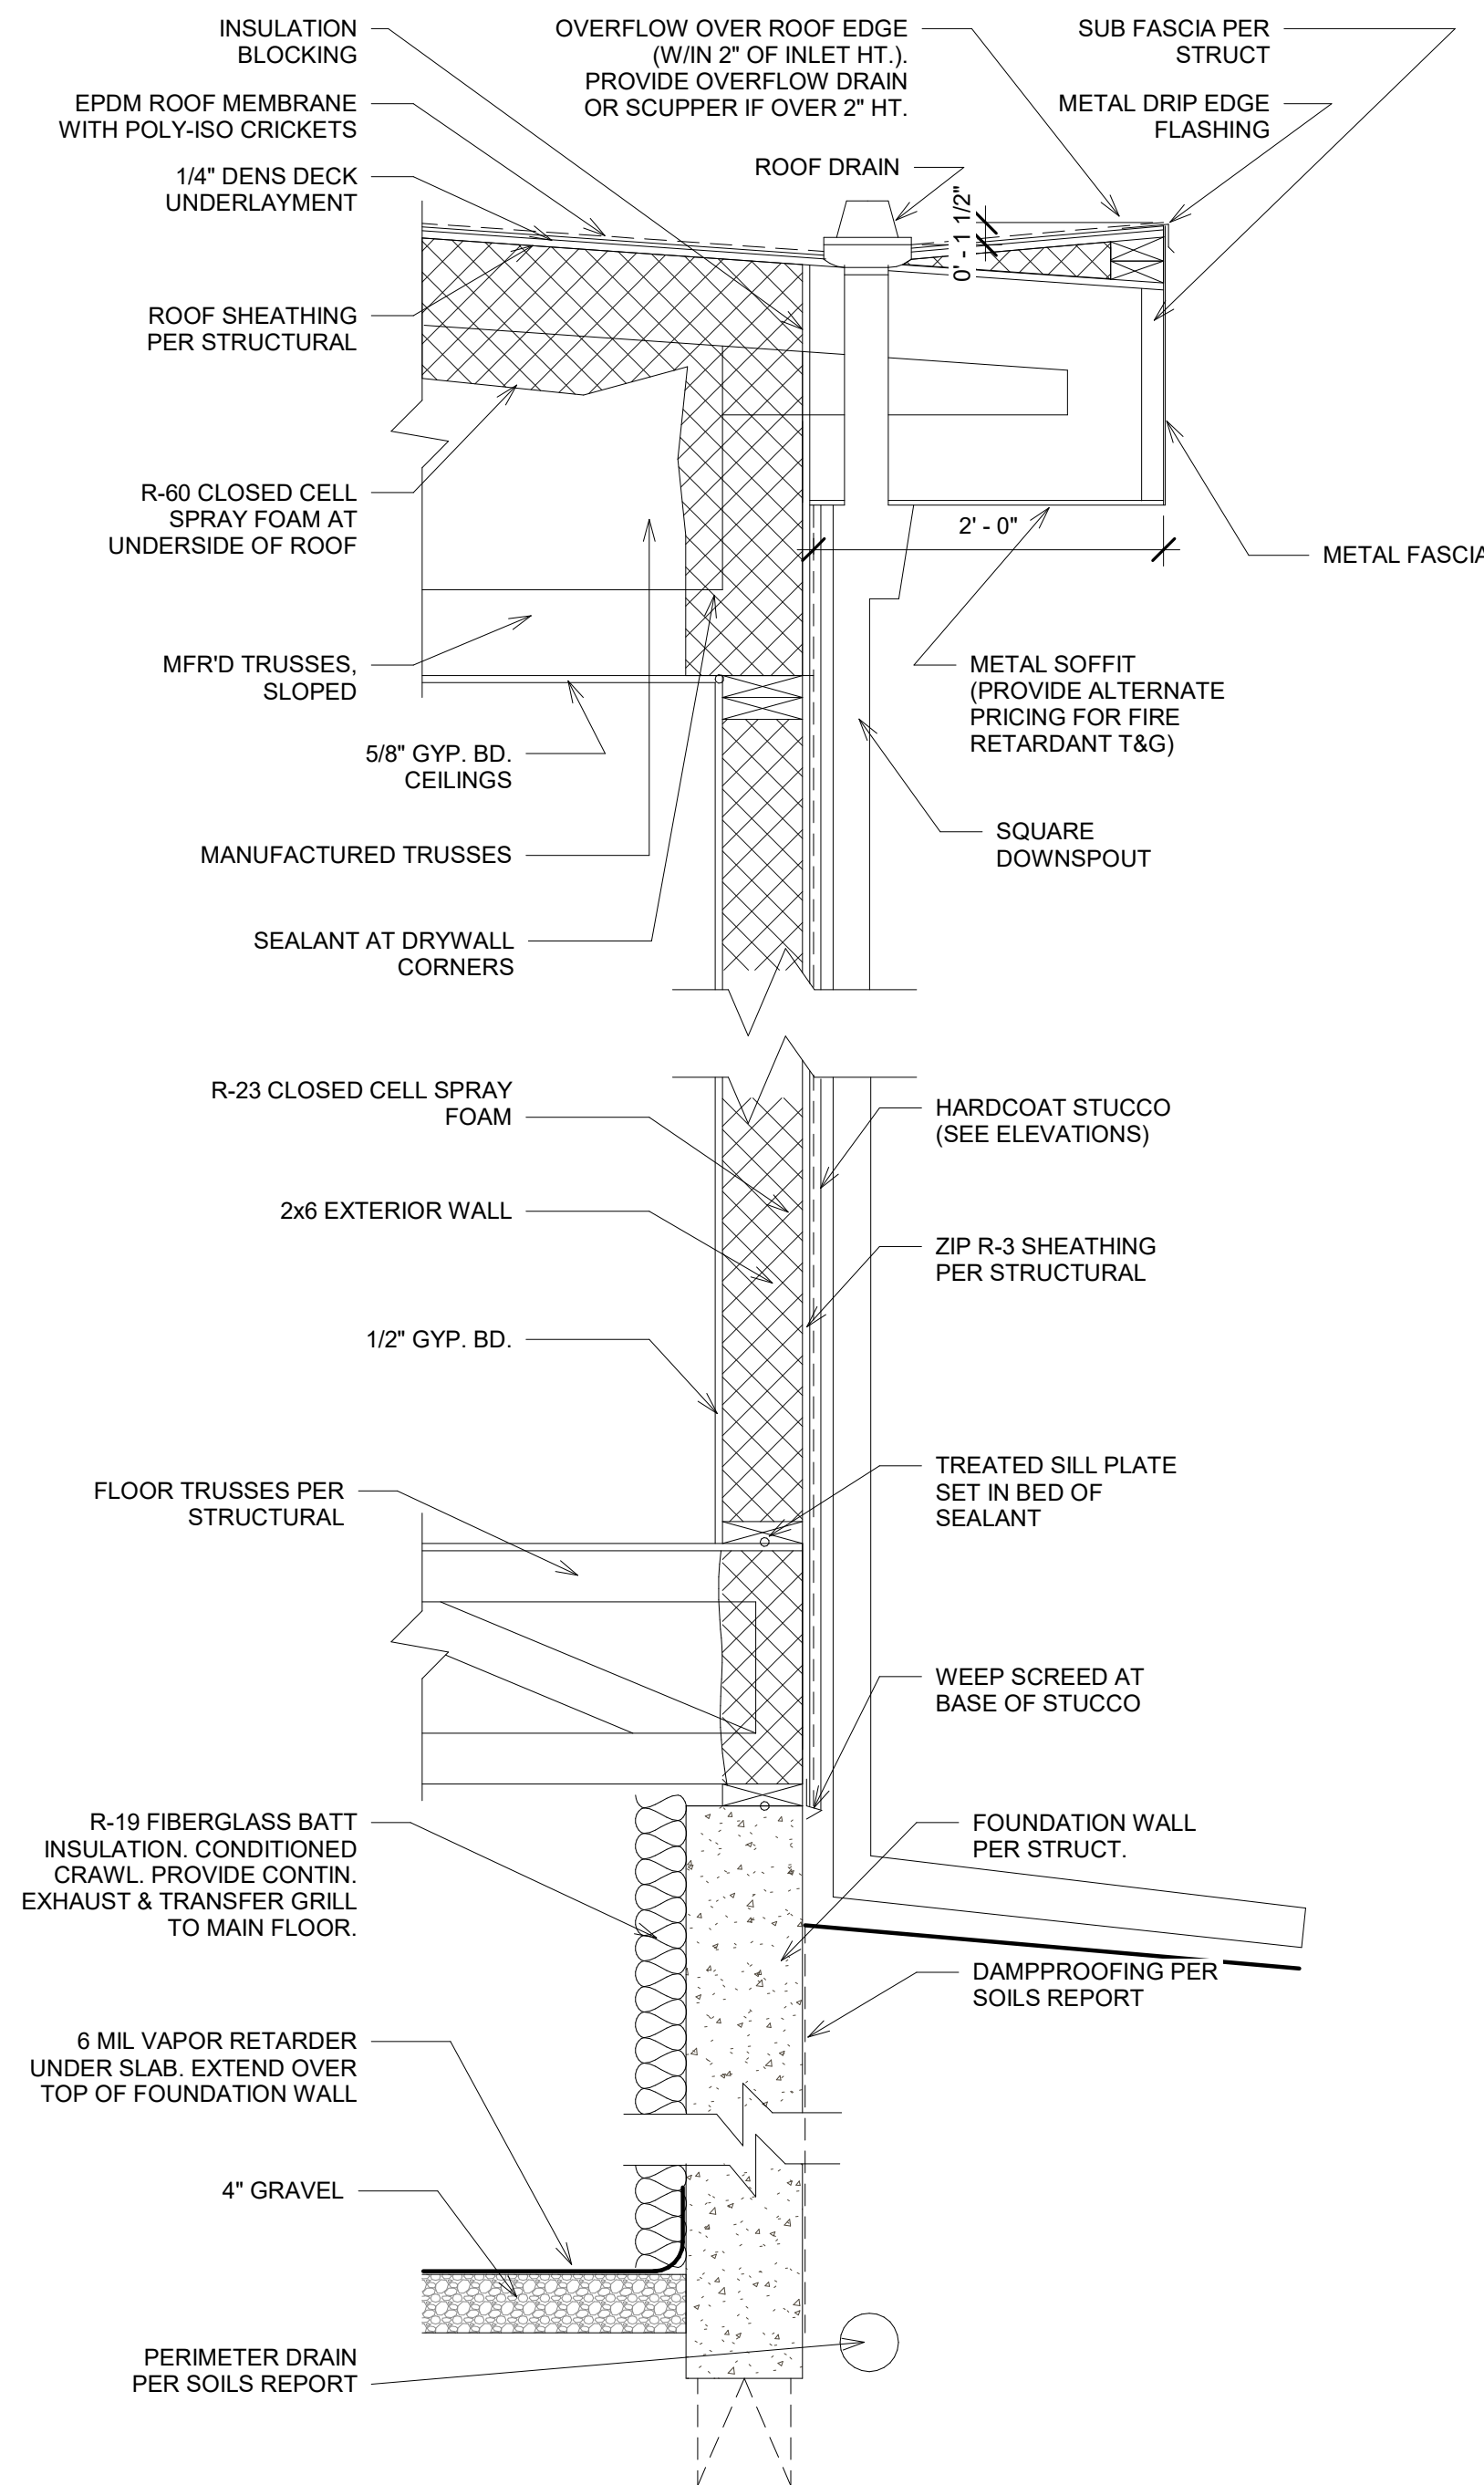


3 Typical Wall Section
1" = 1'-0"

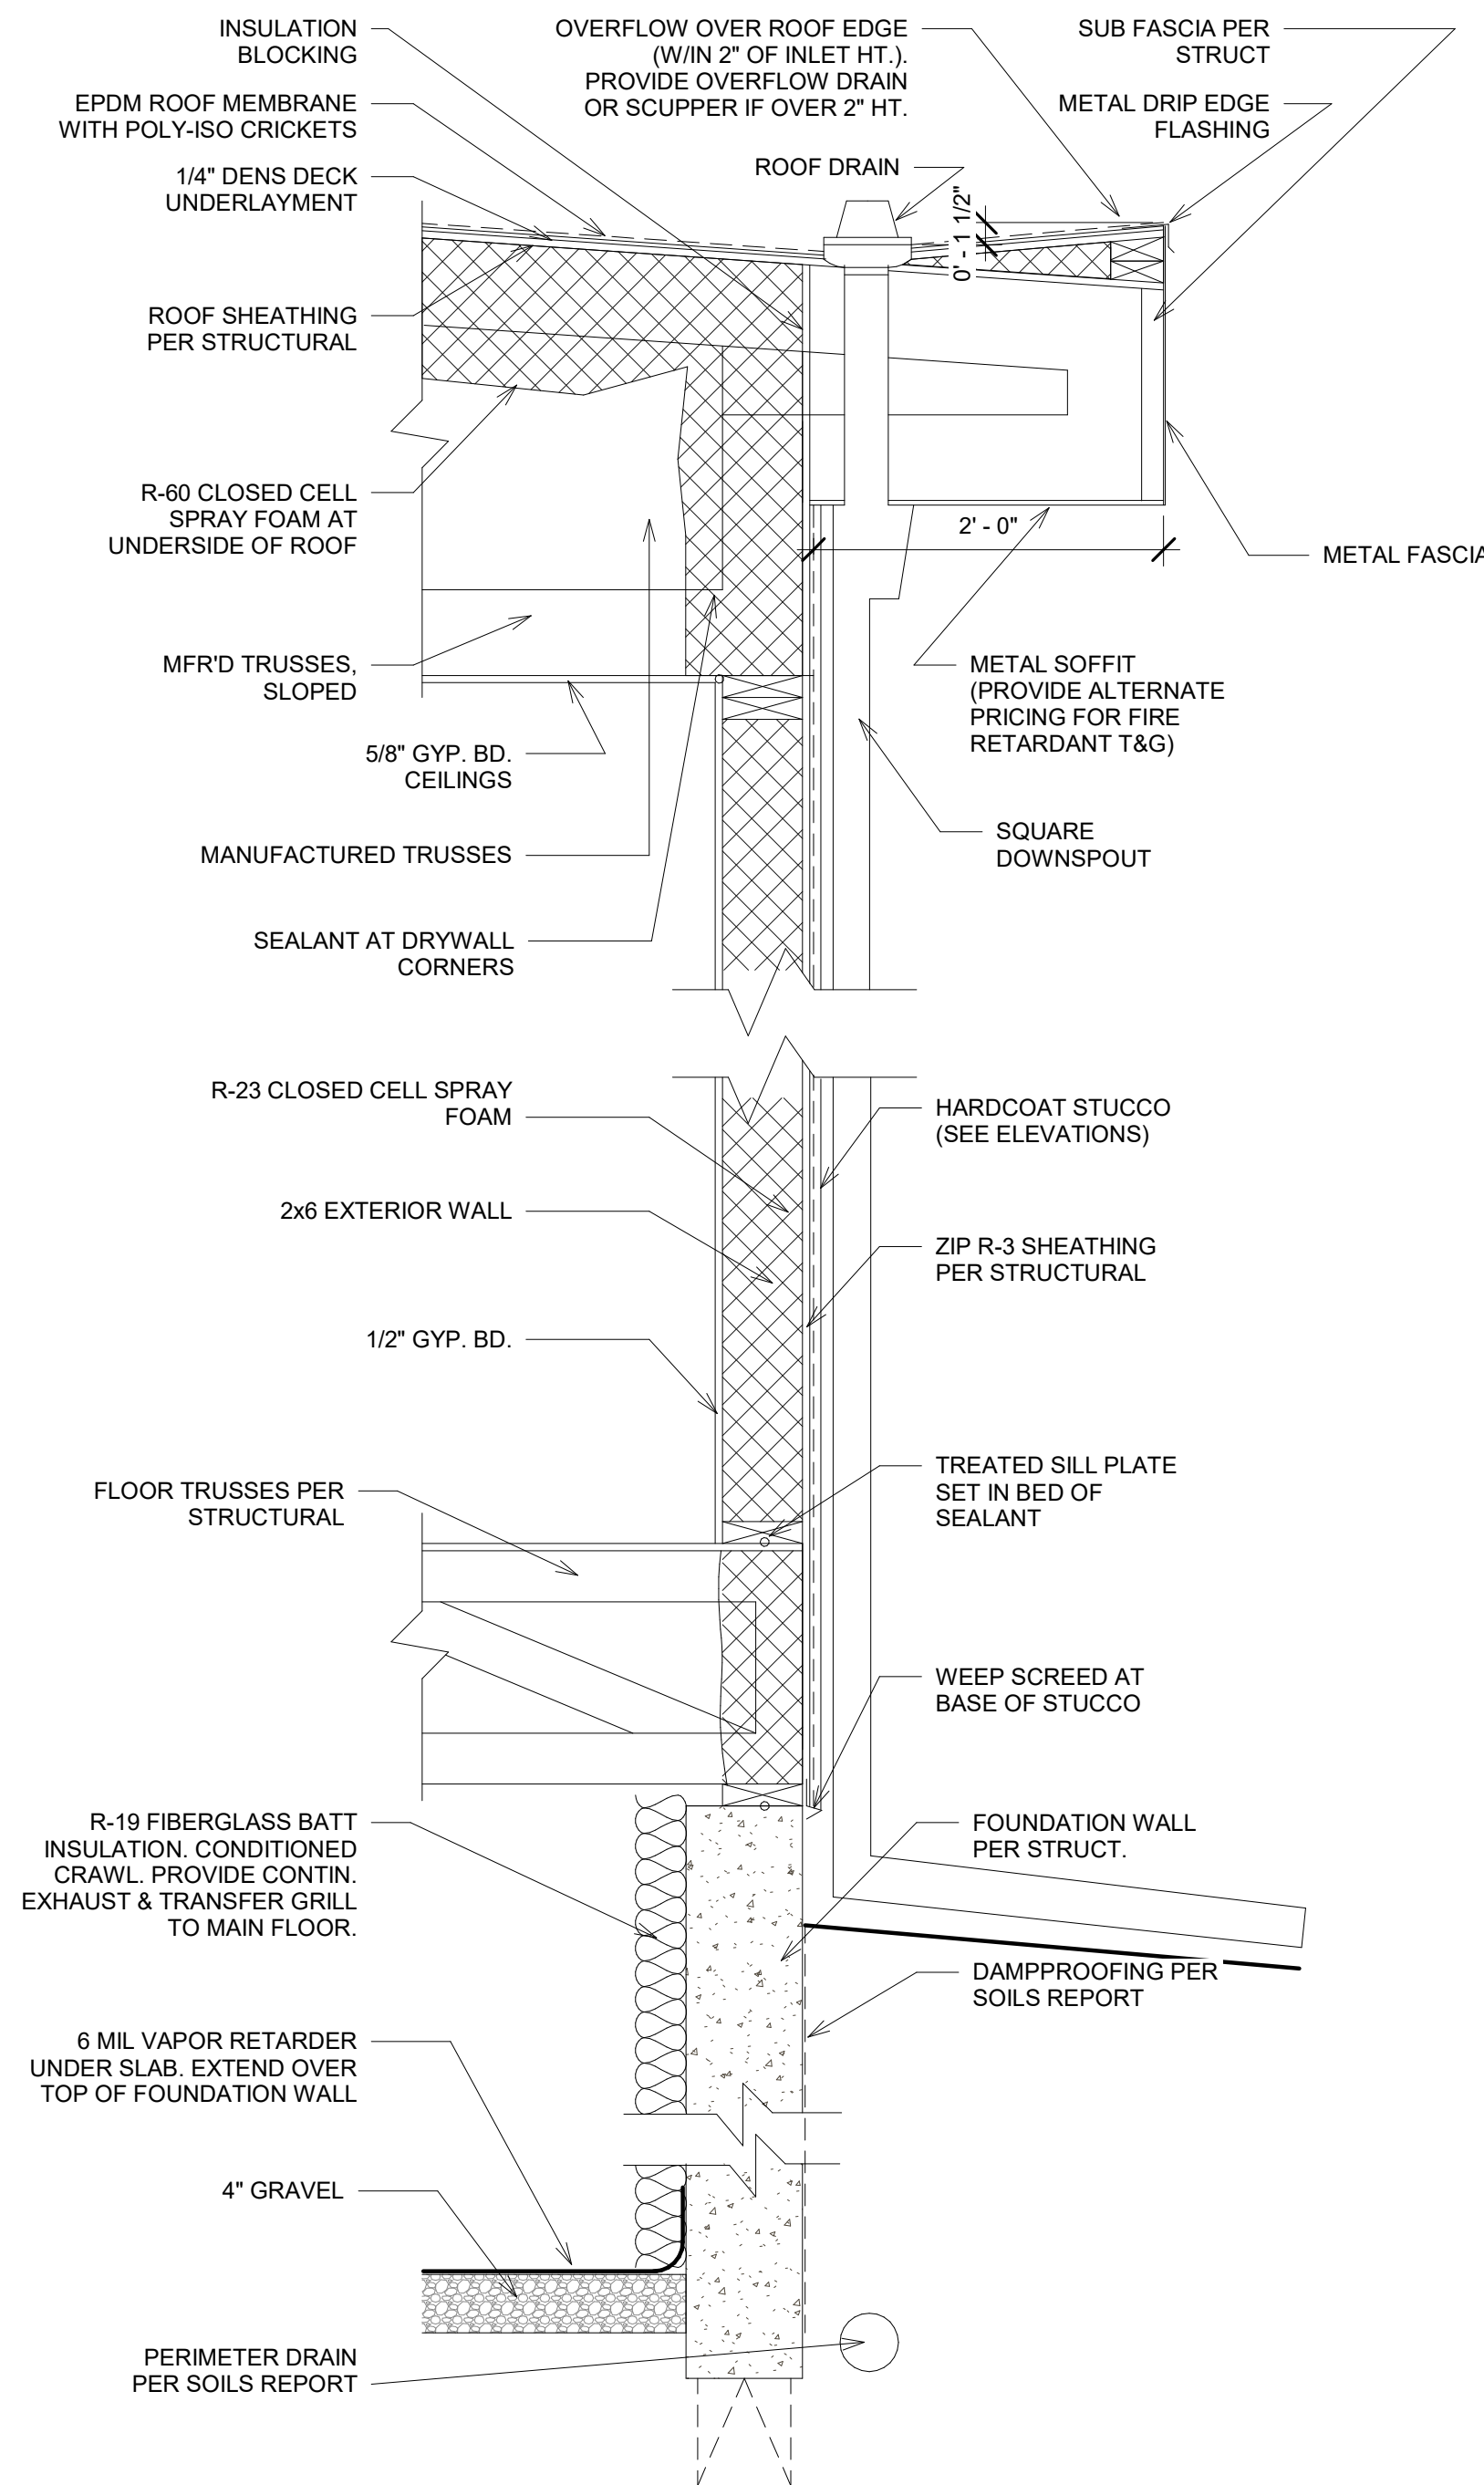


3 Typical Wall Section
1" = 1'-0"

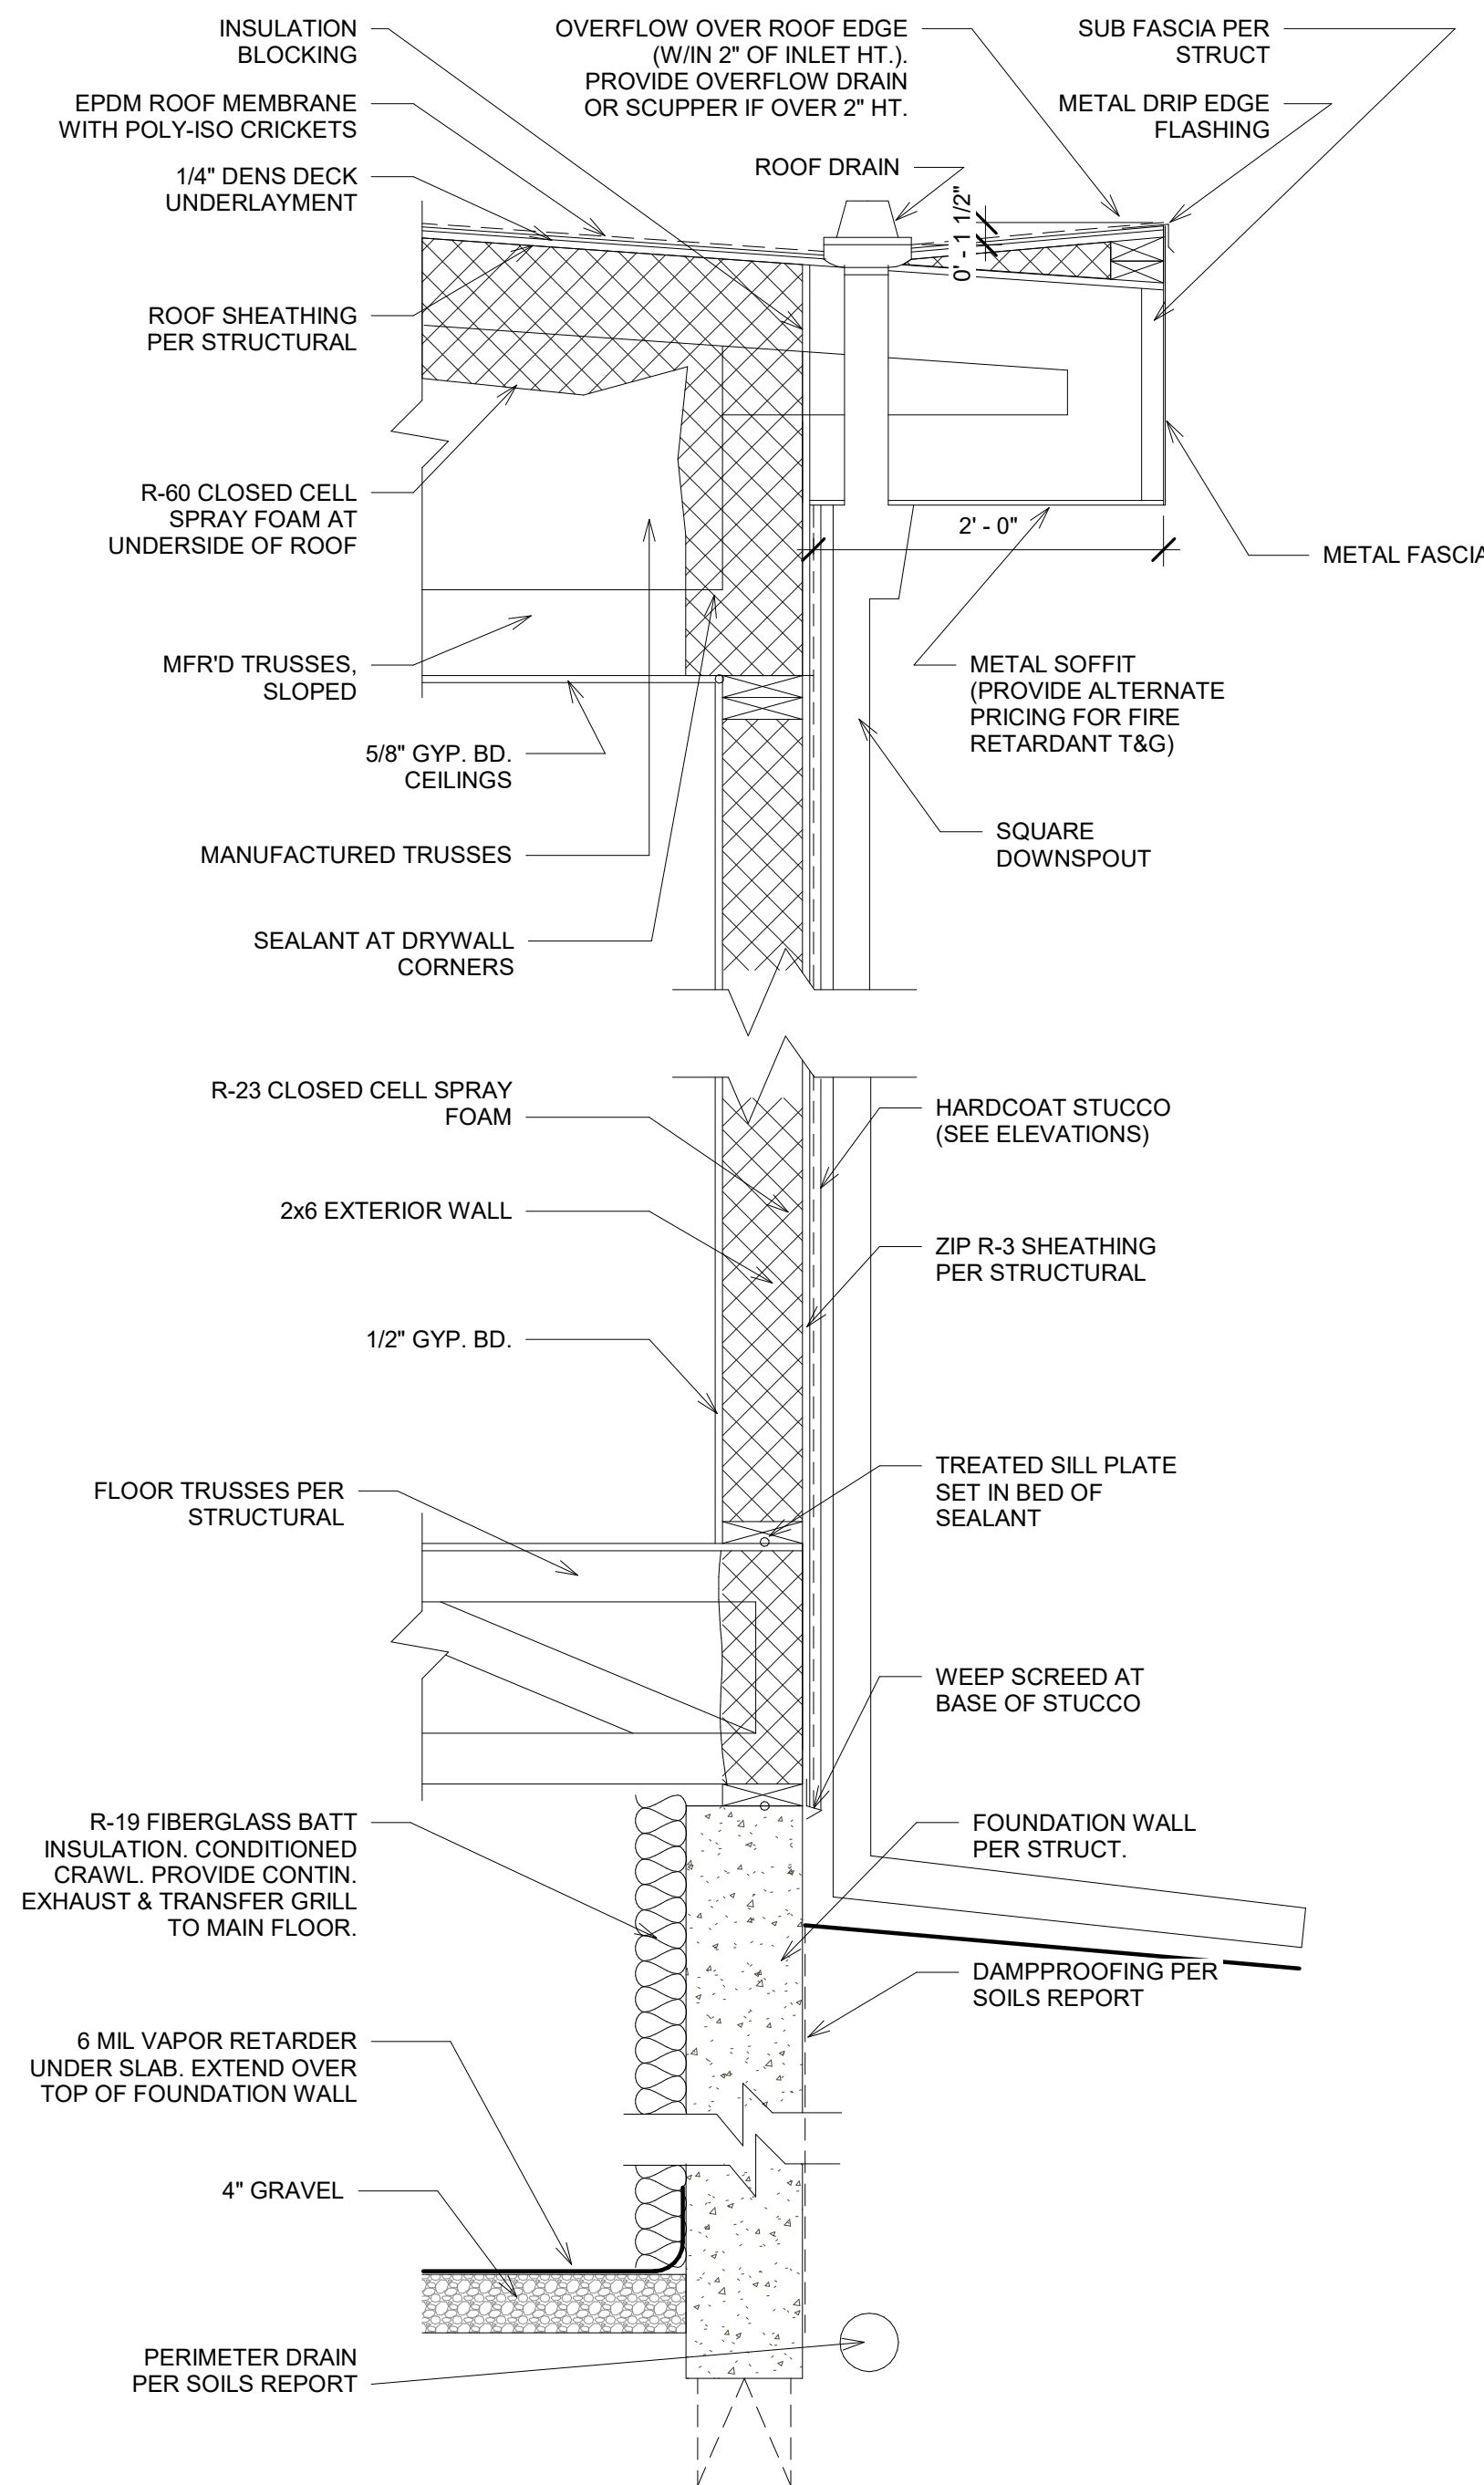


3 Typical Wall Section
1" = 1'-0"

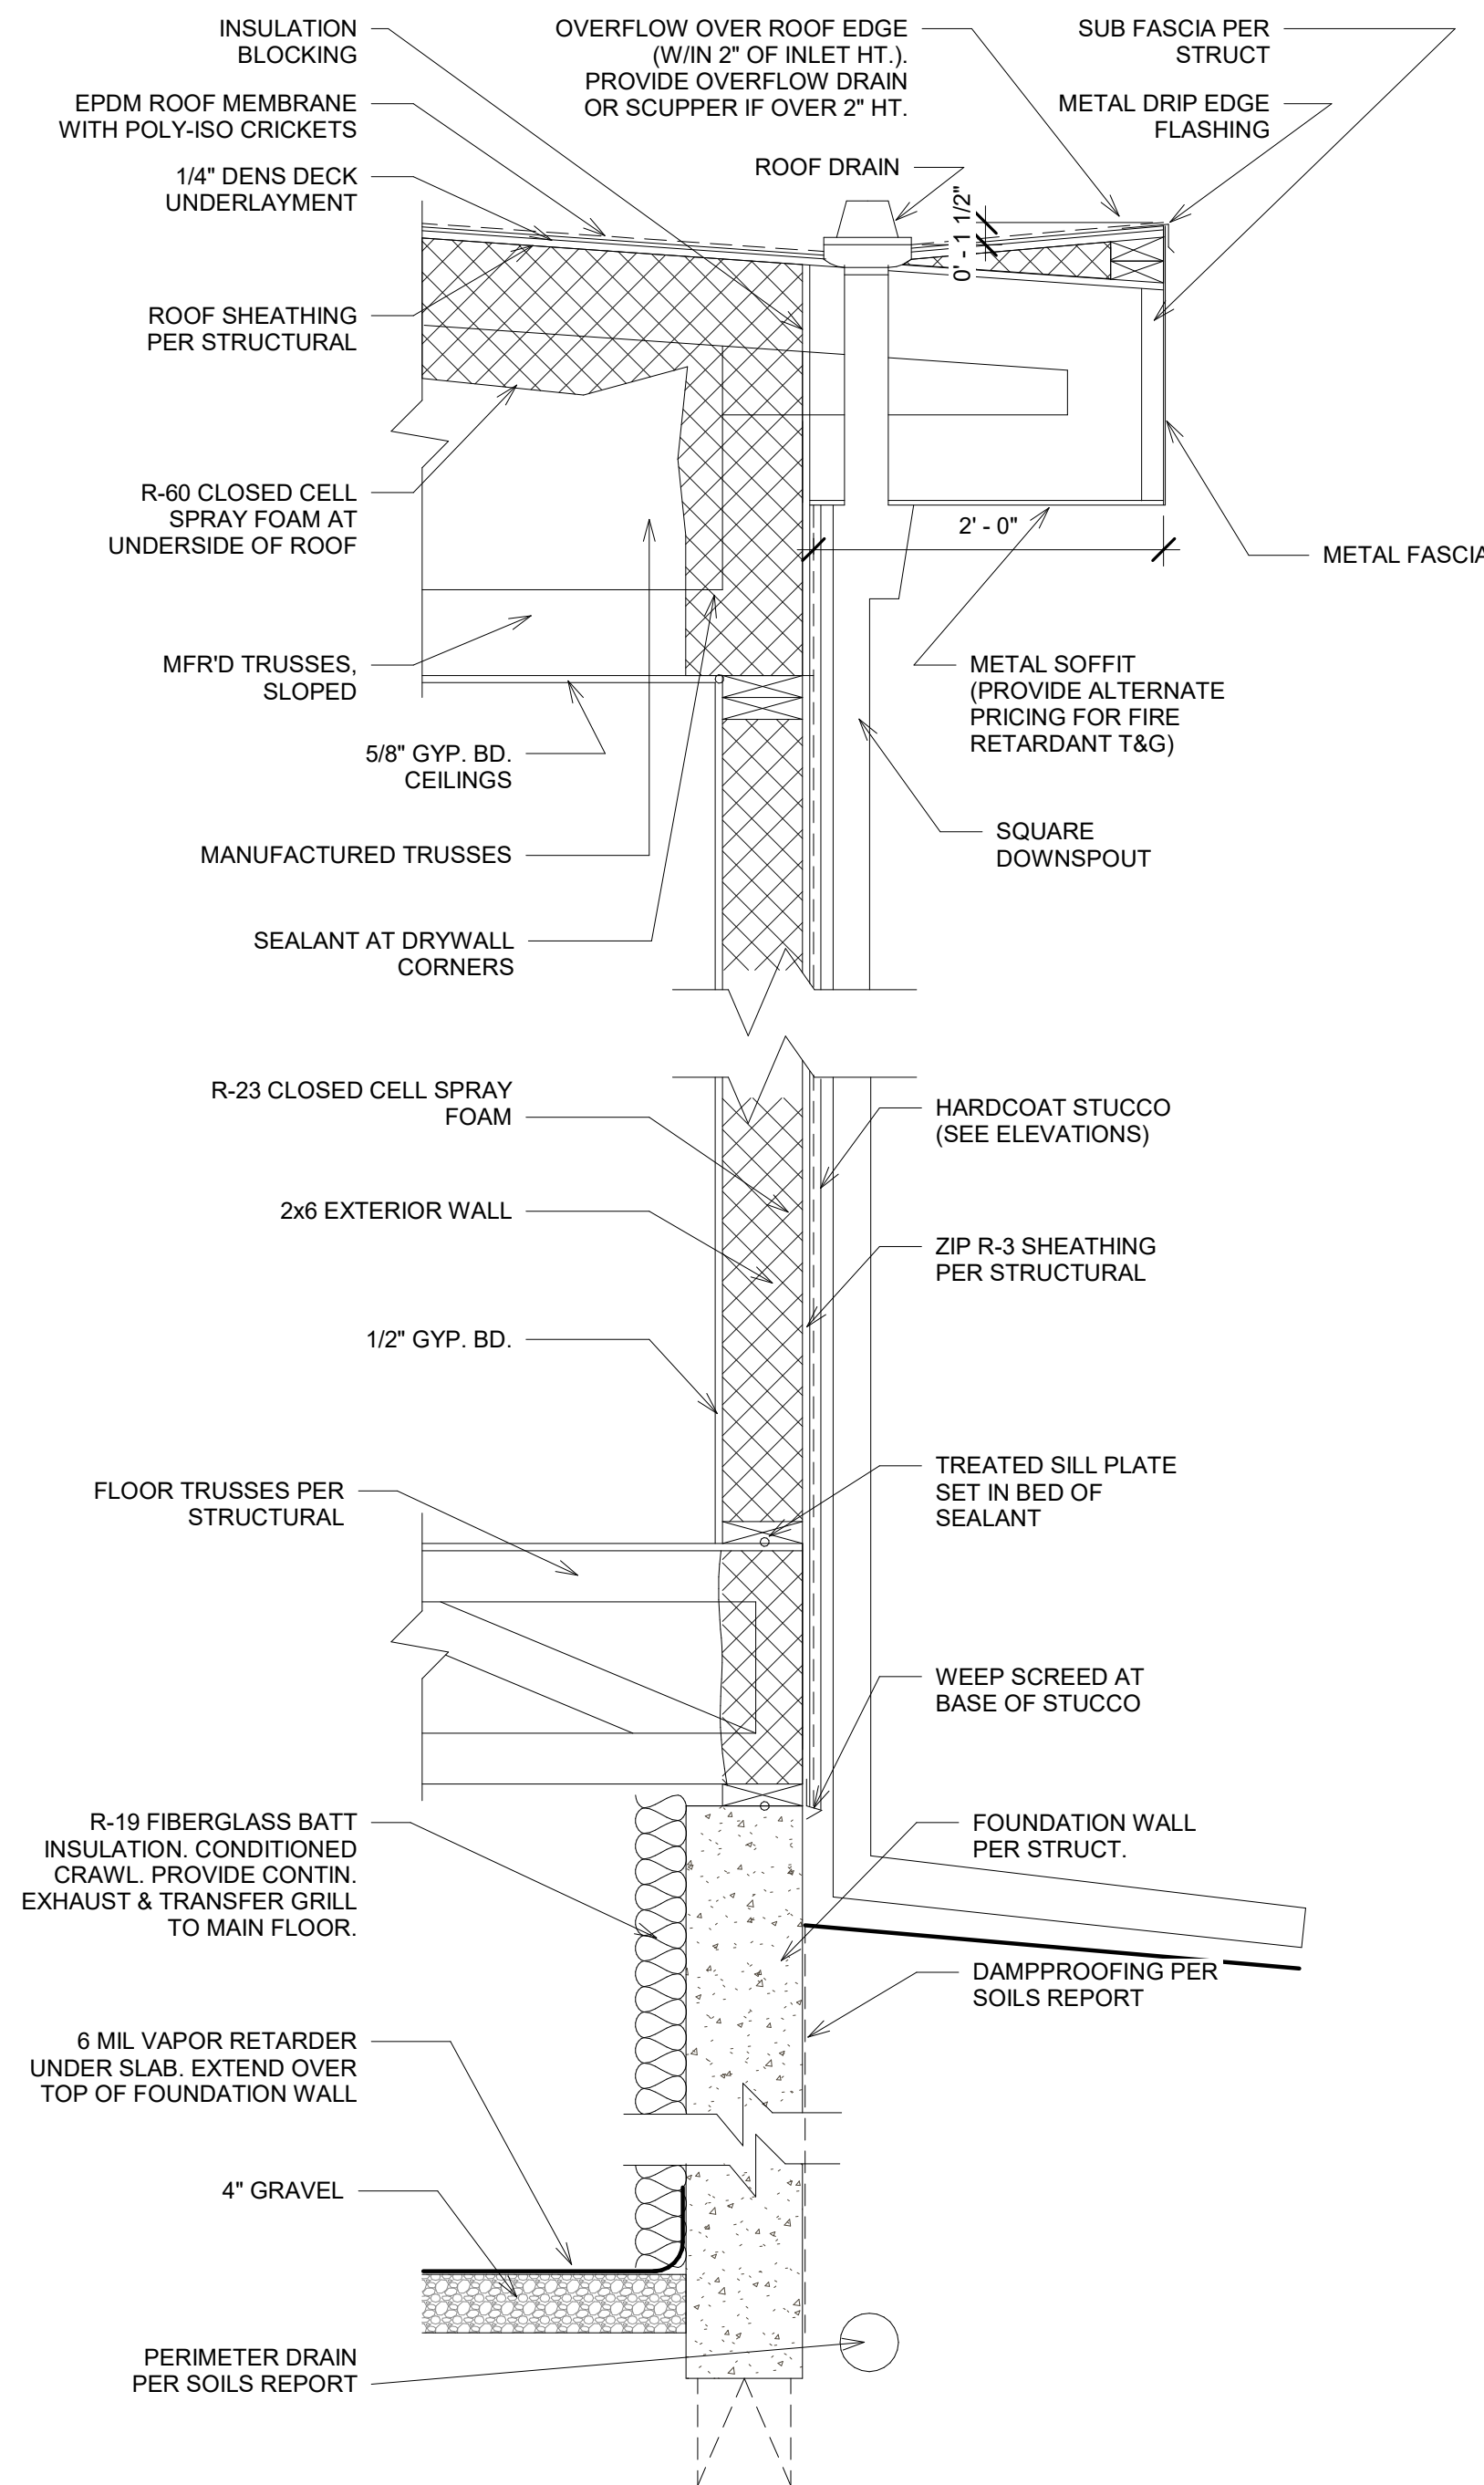


3 Typical Wall Section
1" = 1'-0"

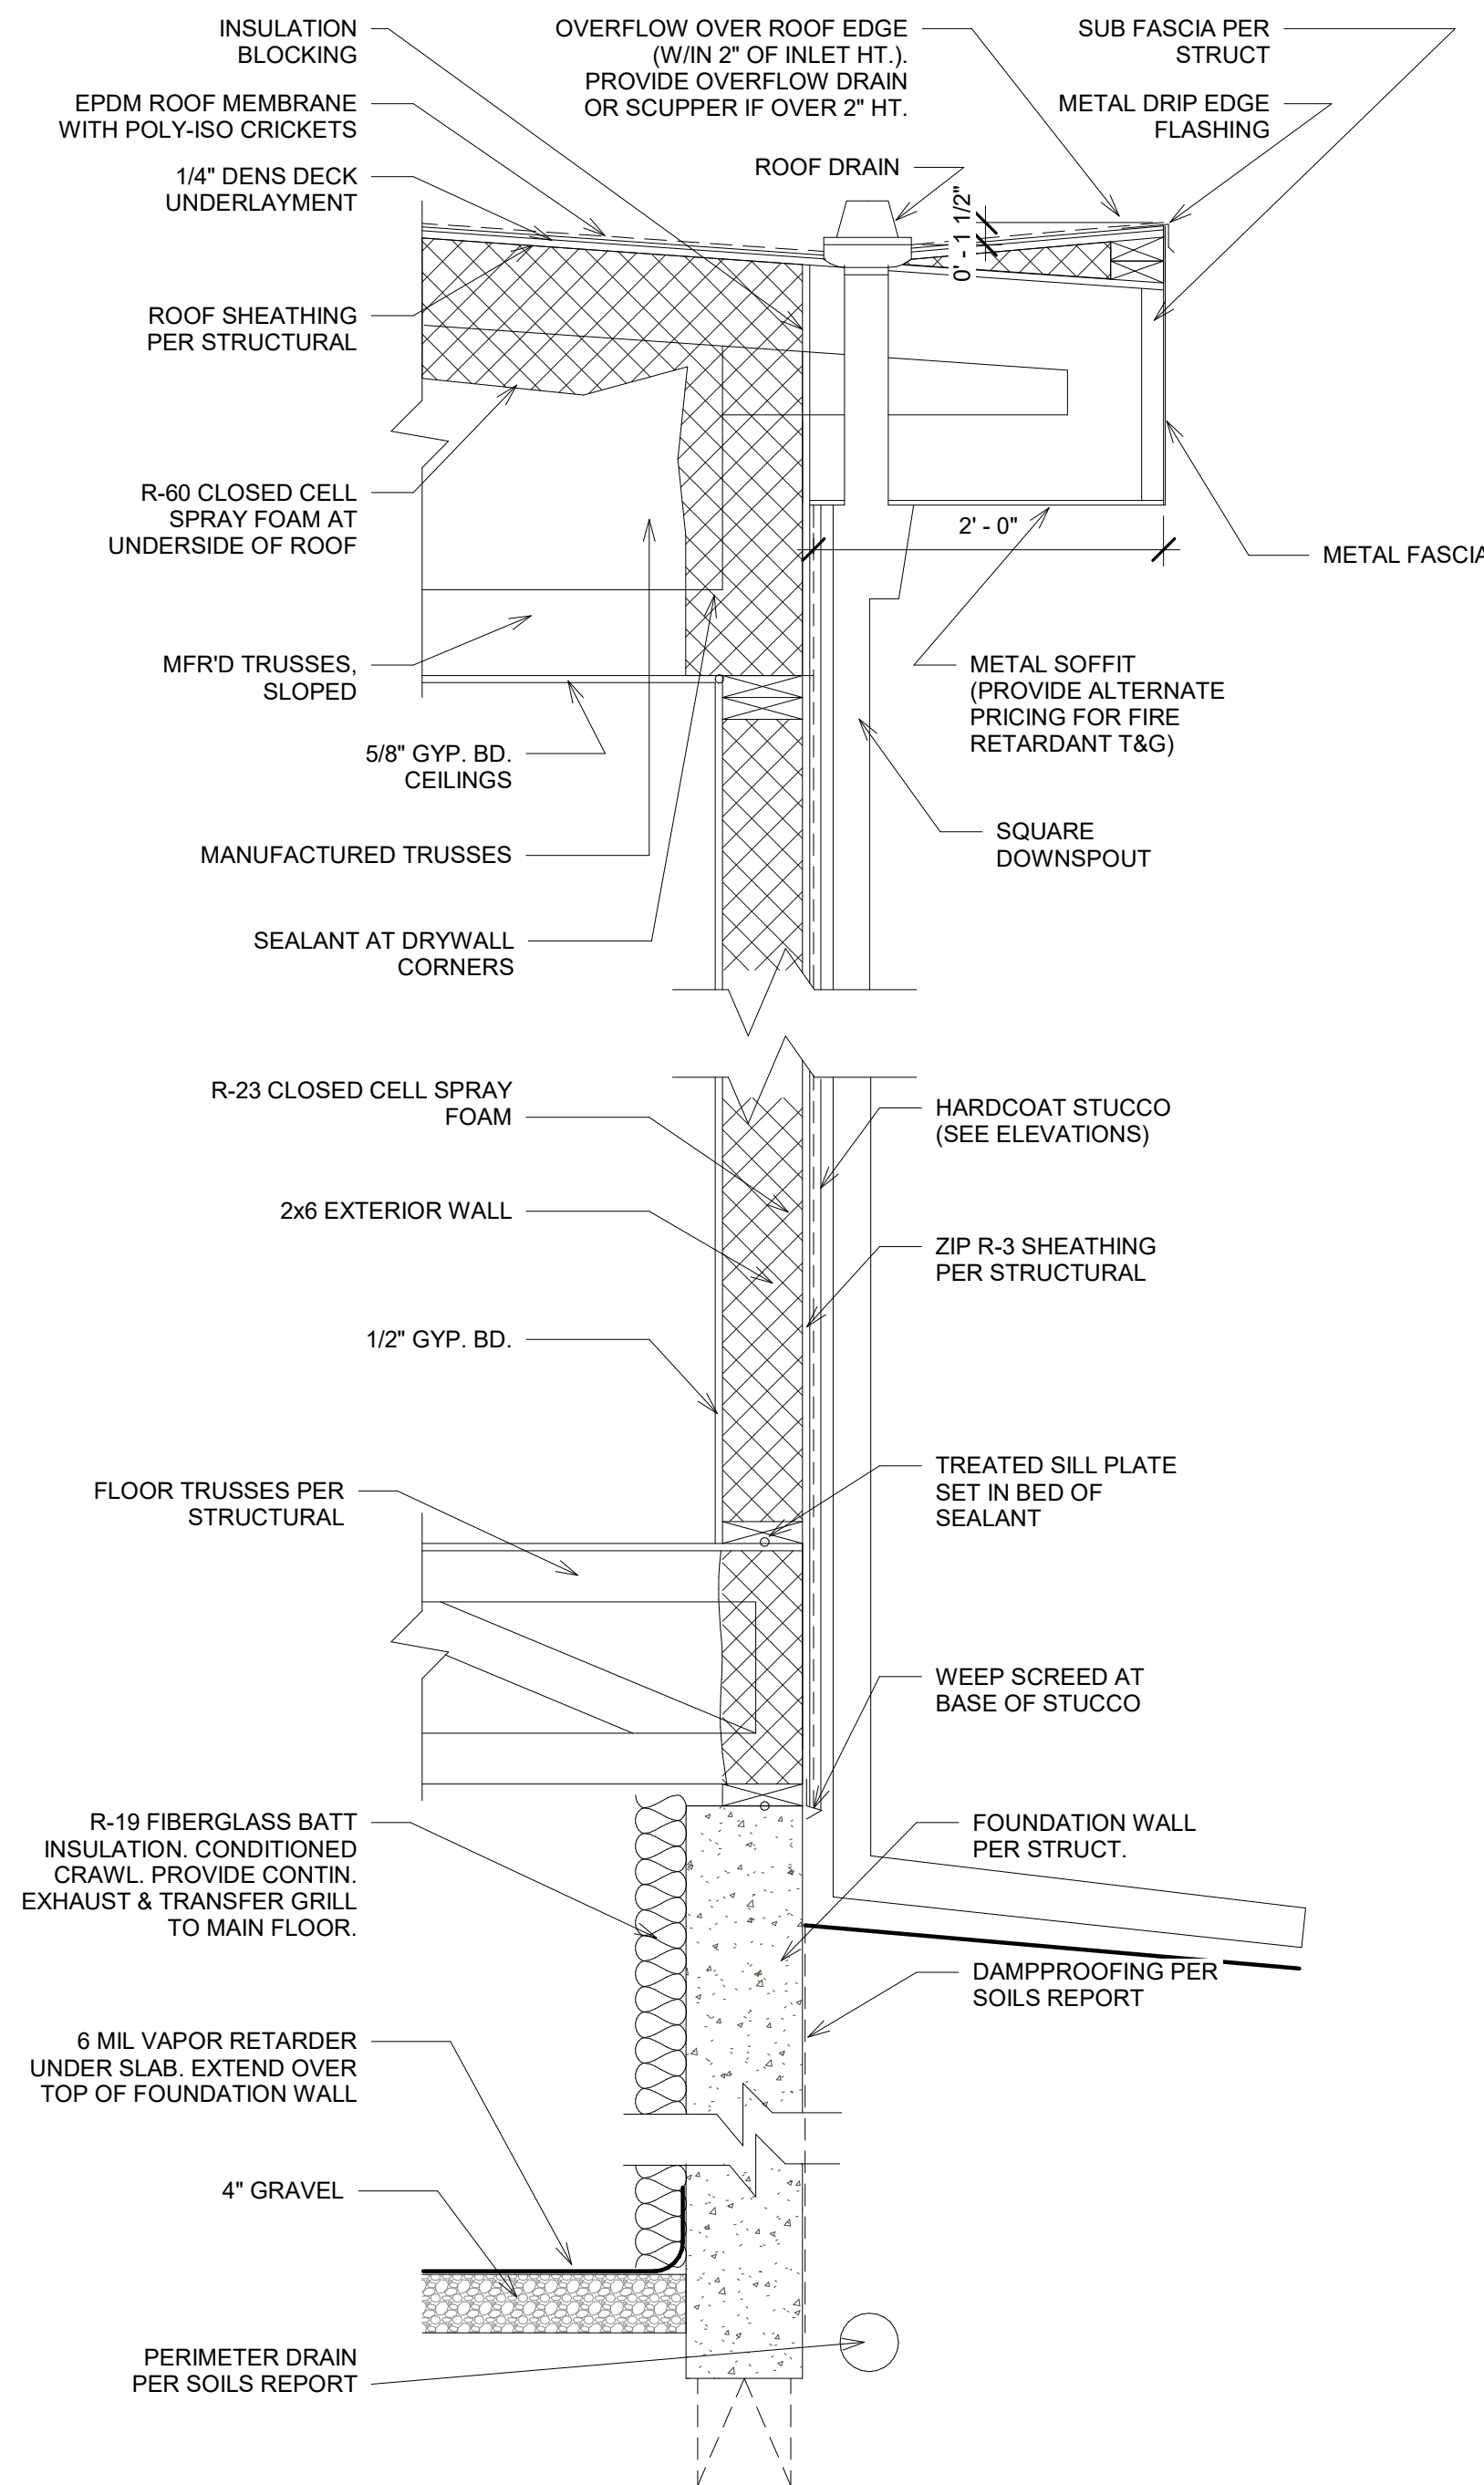


3 Typical Wall Section
1" = 1'-0"

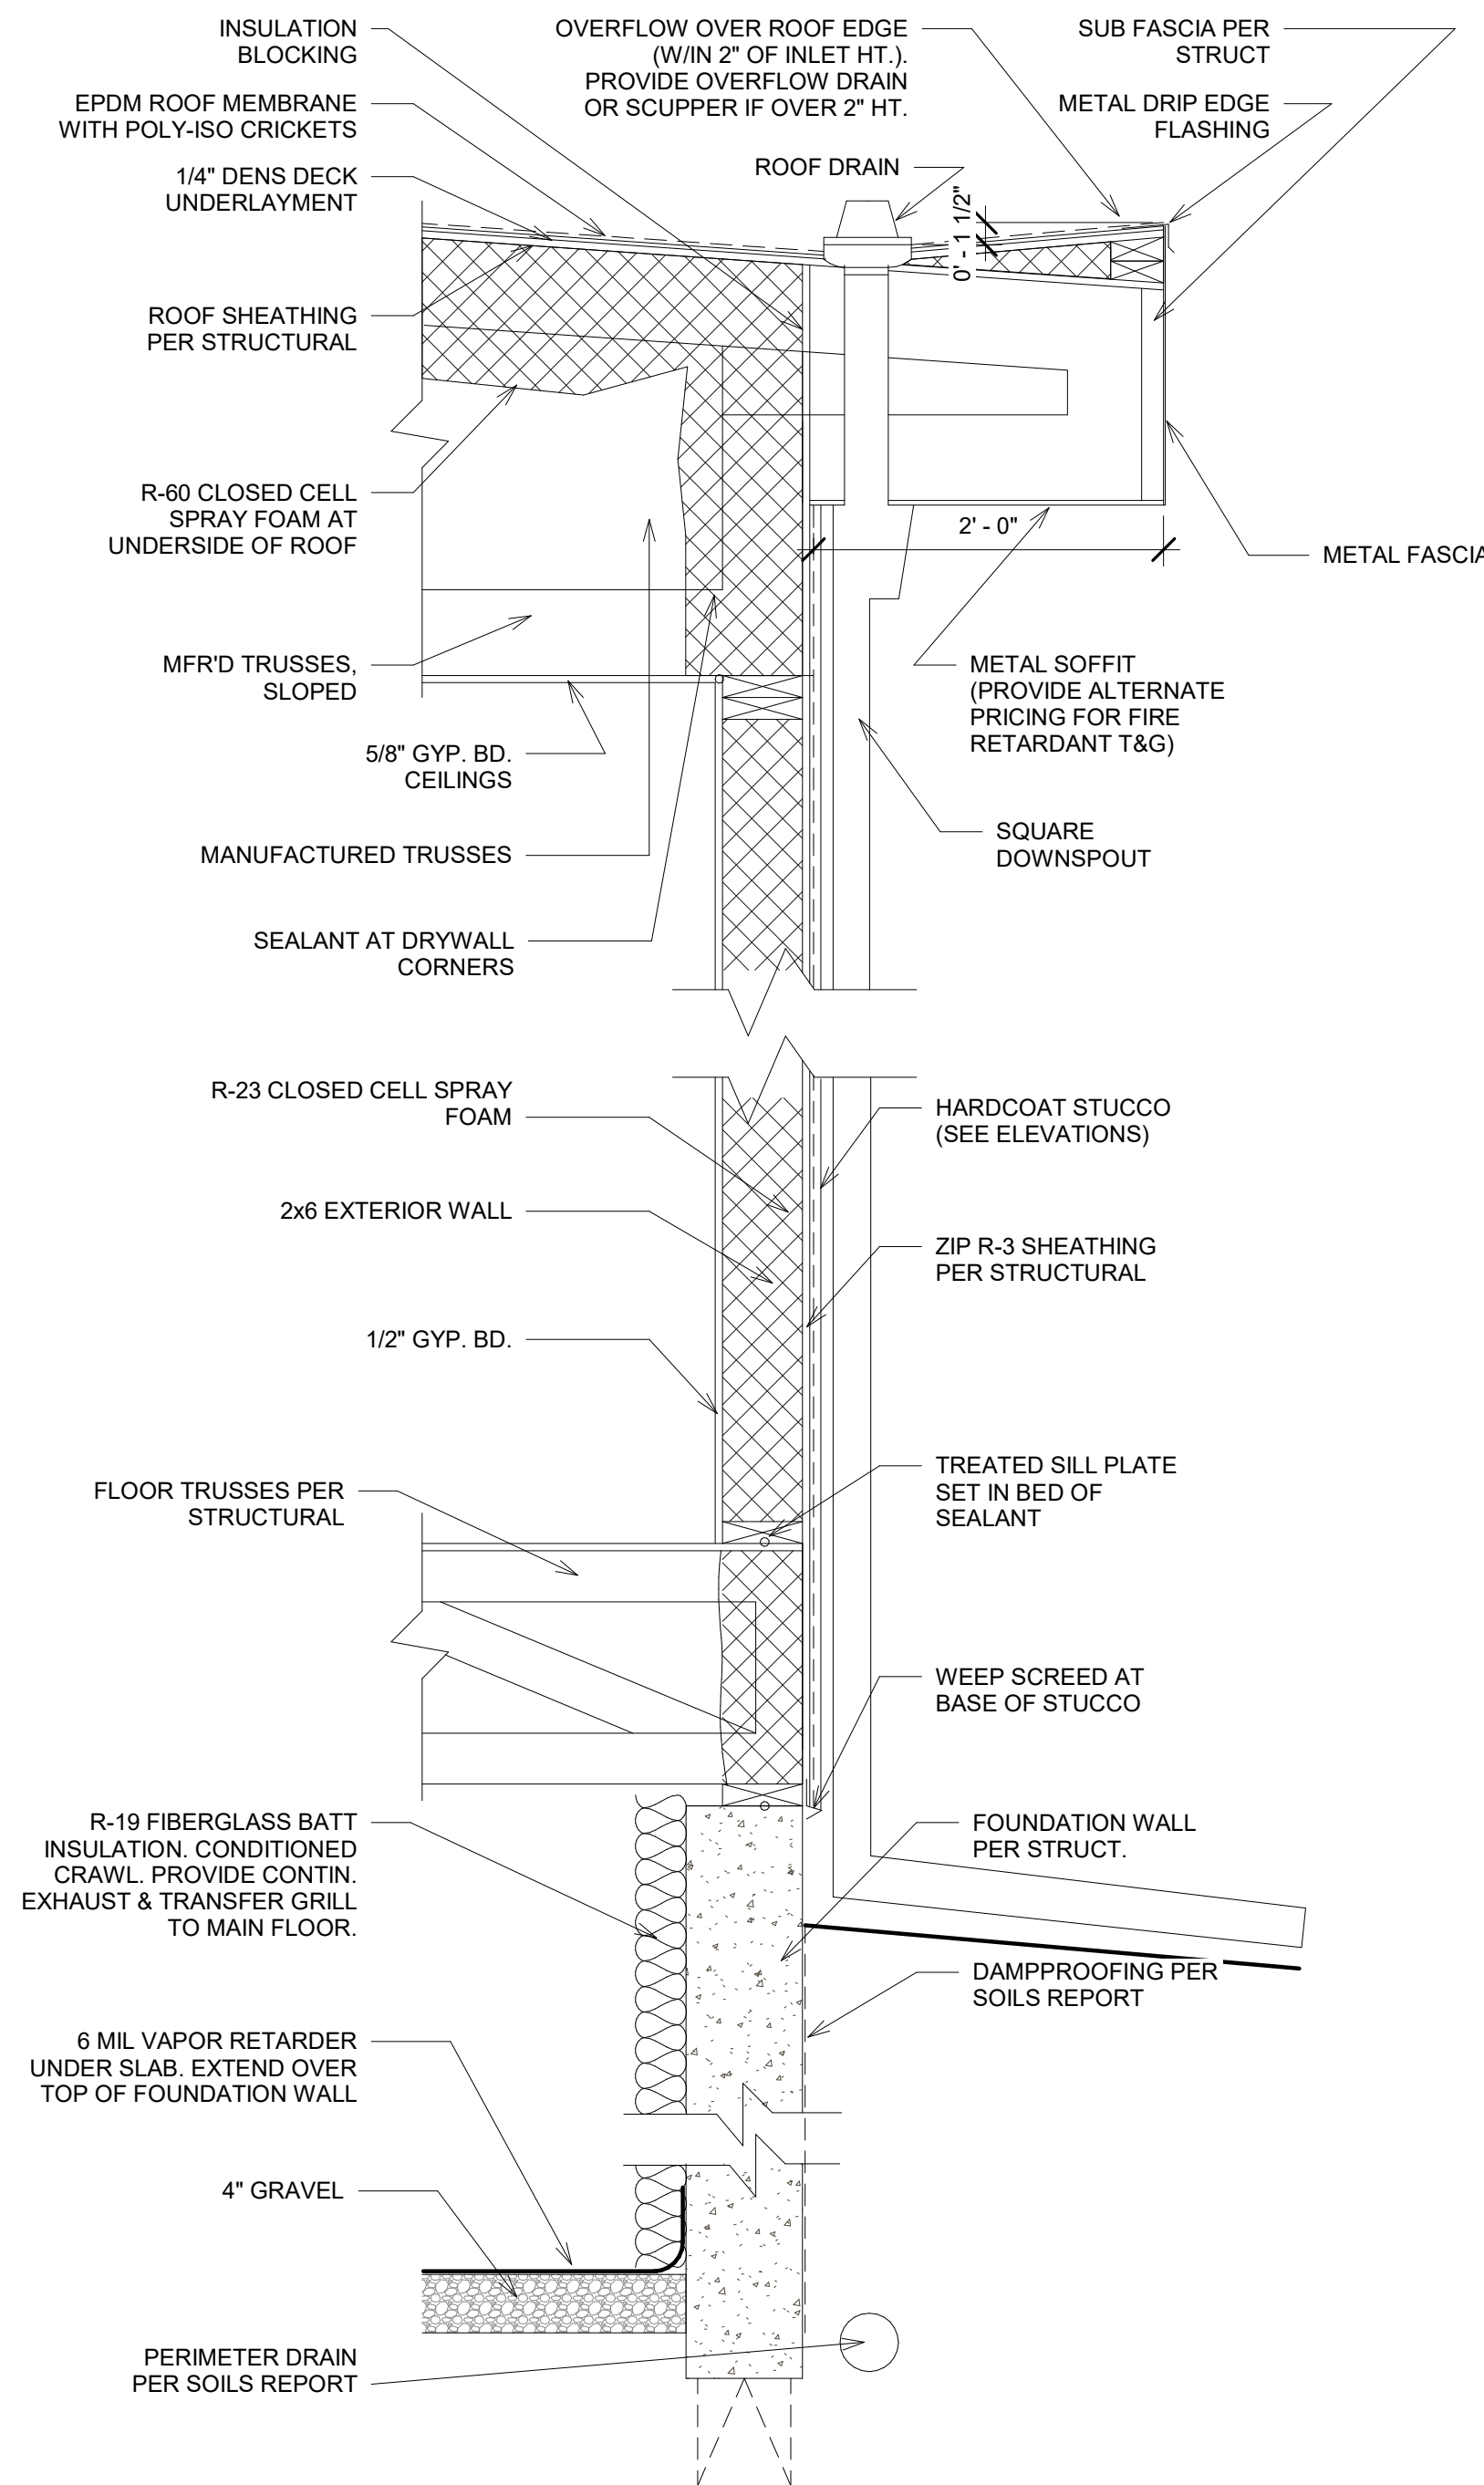


3 Typical Wall Section
1" = 1'-0"

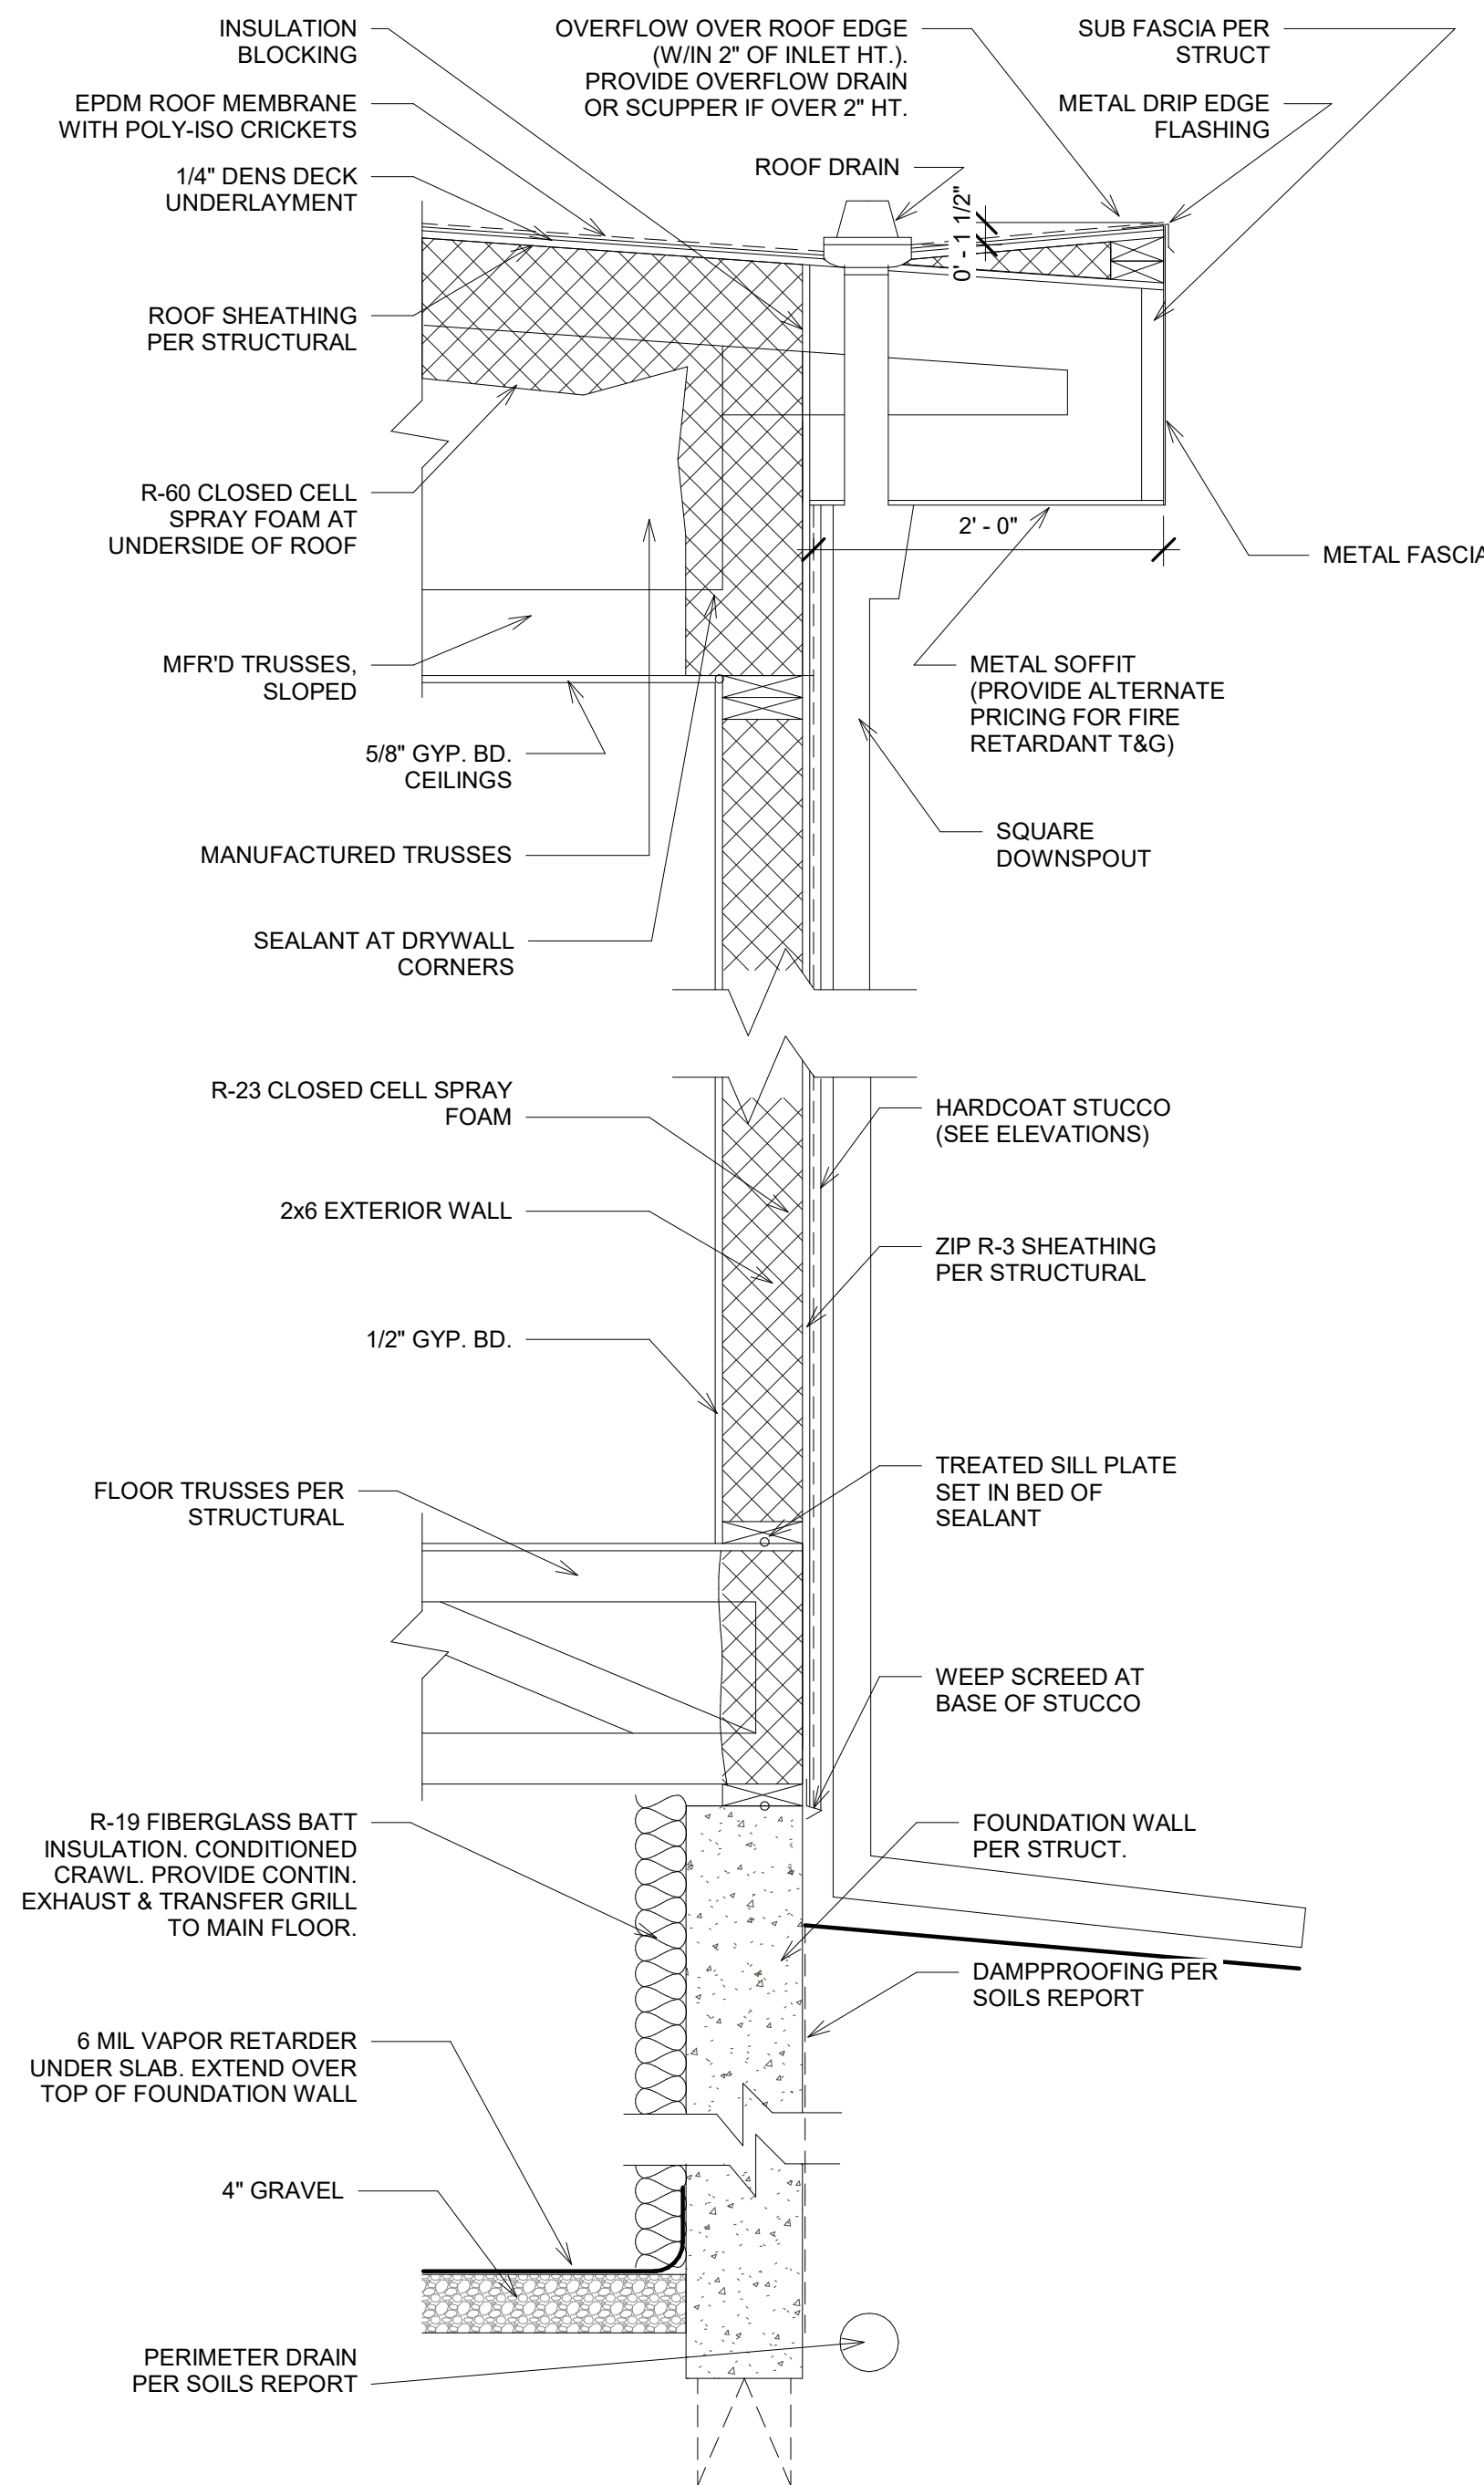


3 Typical Wall Section
1" = 1'-0"

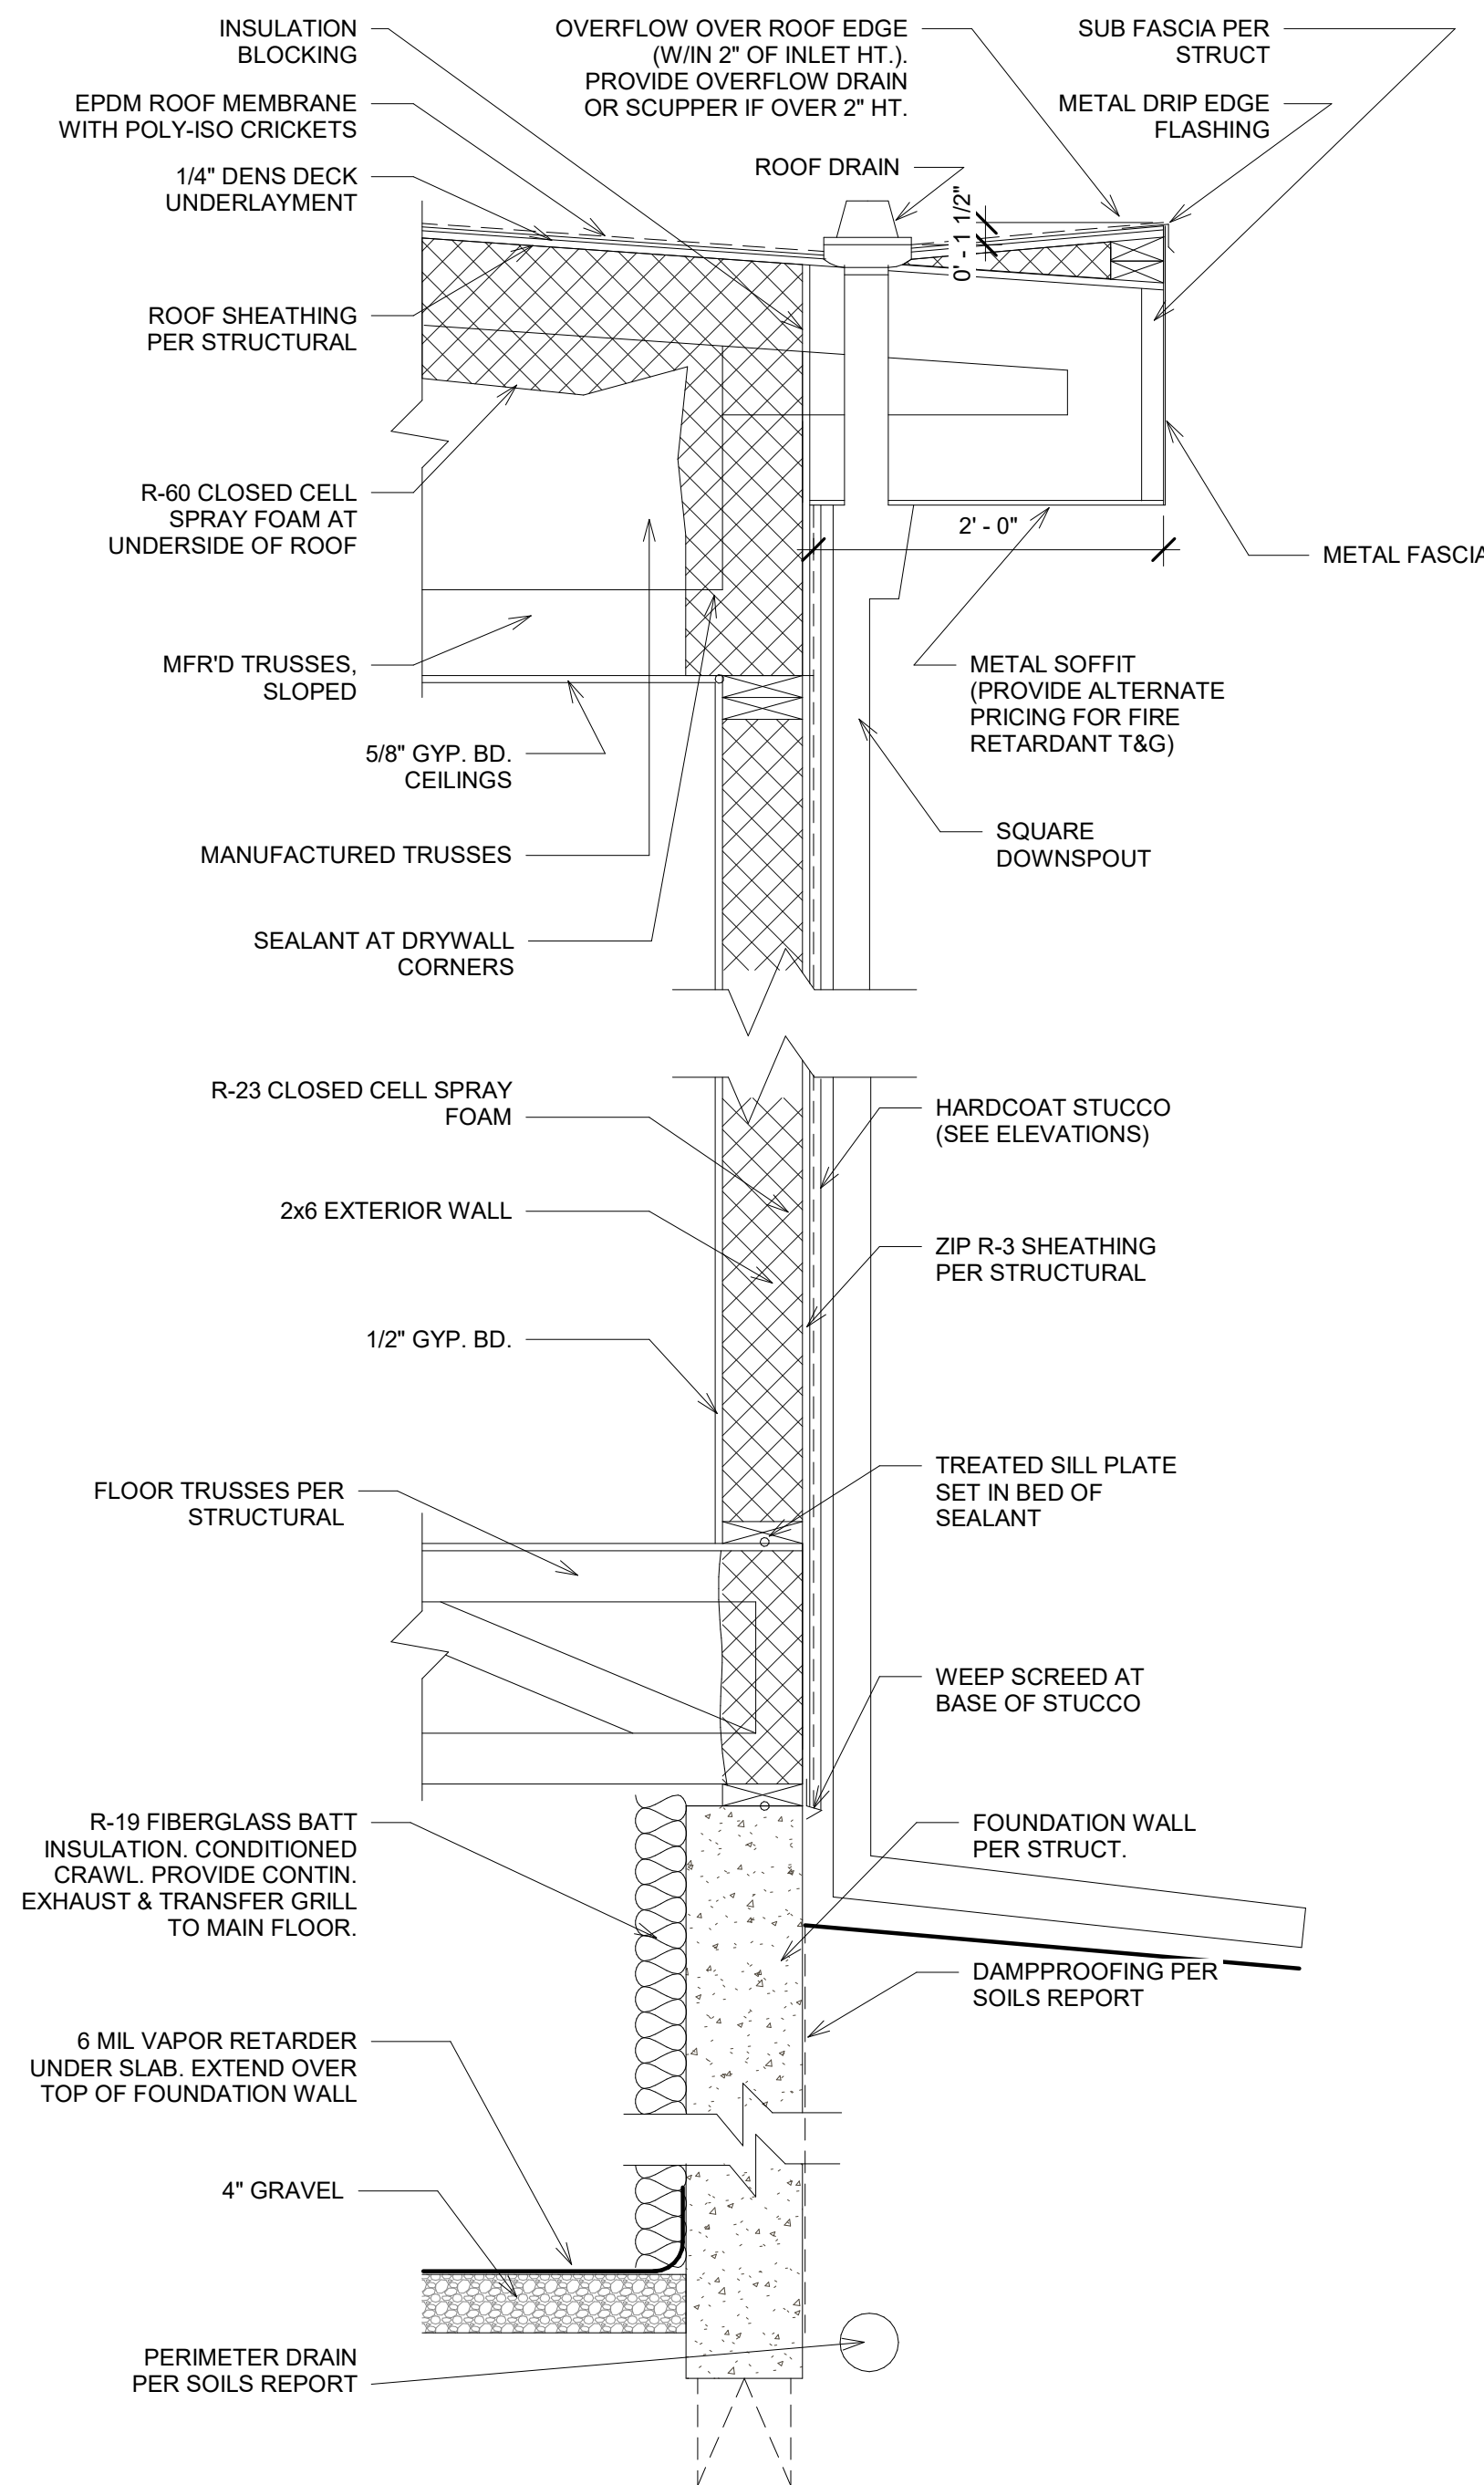


3 Typical Wall Section
1" = 1'-0"

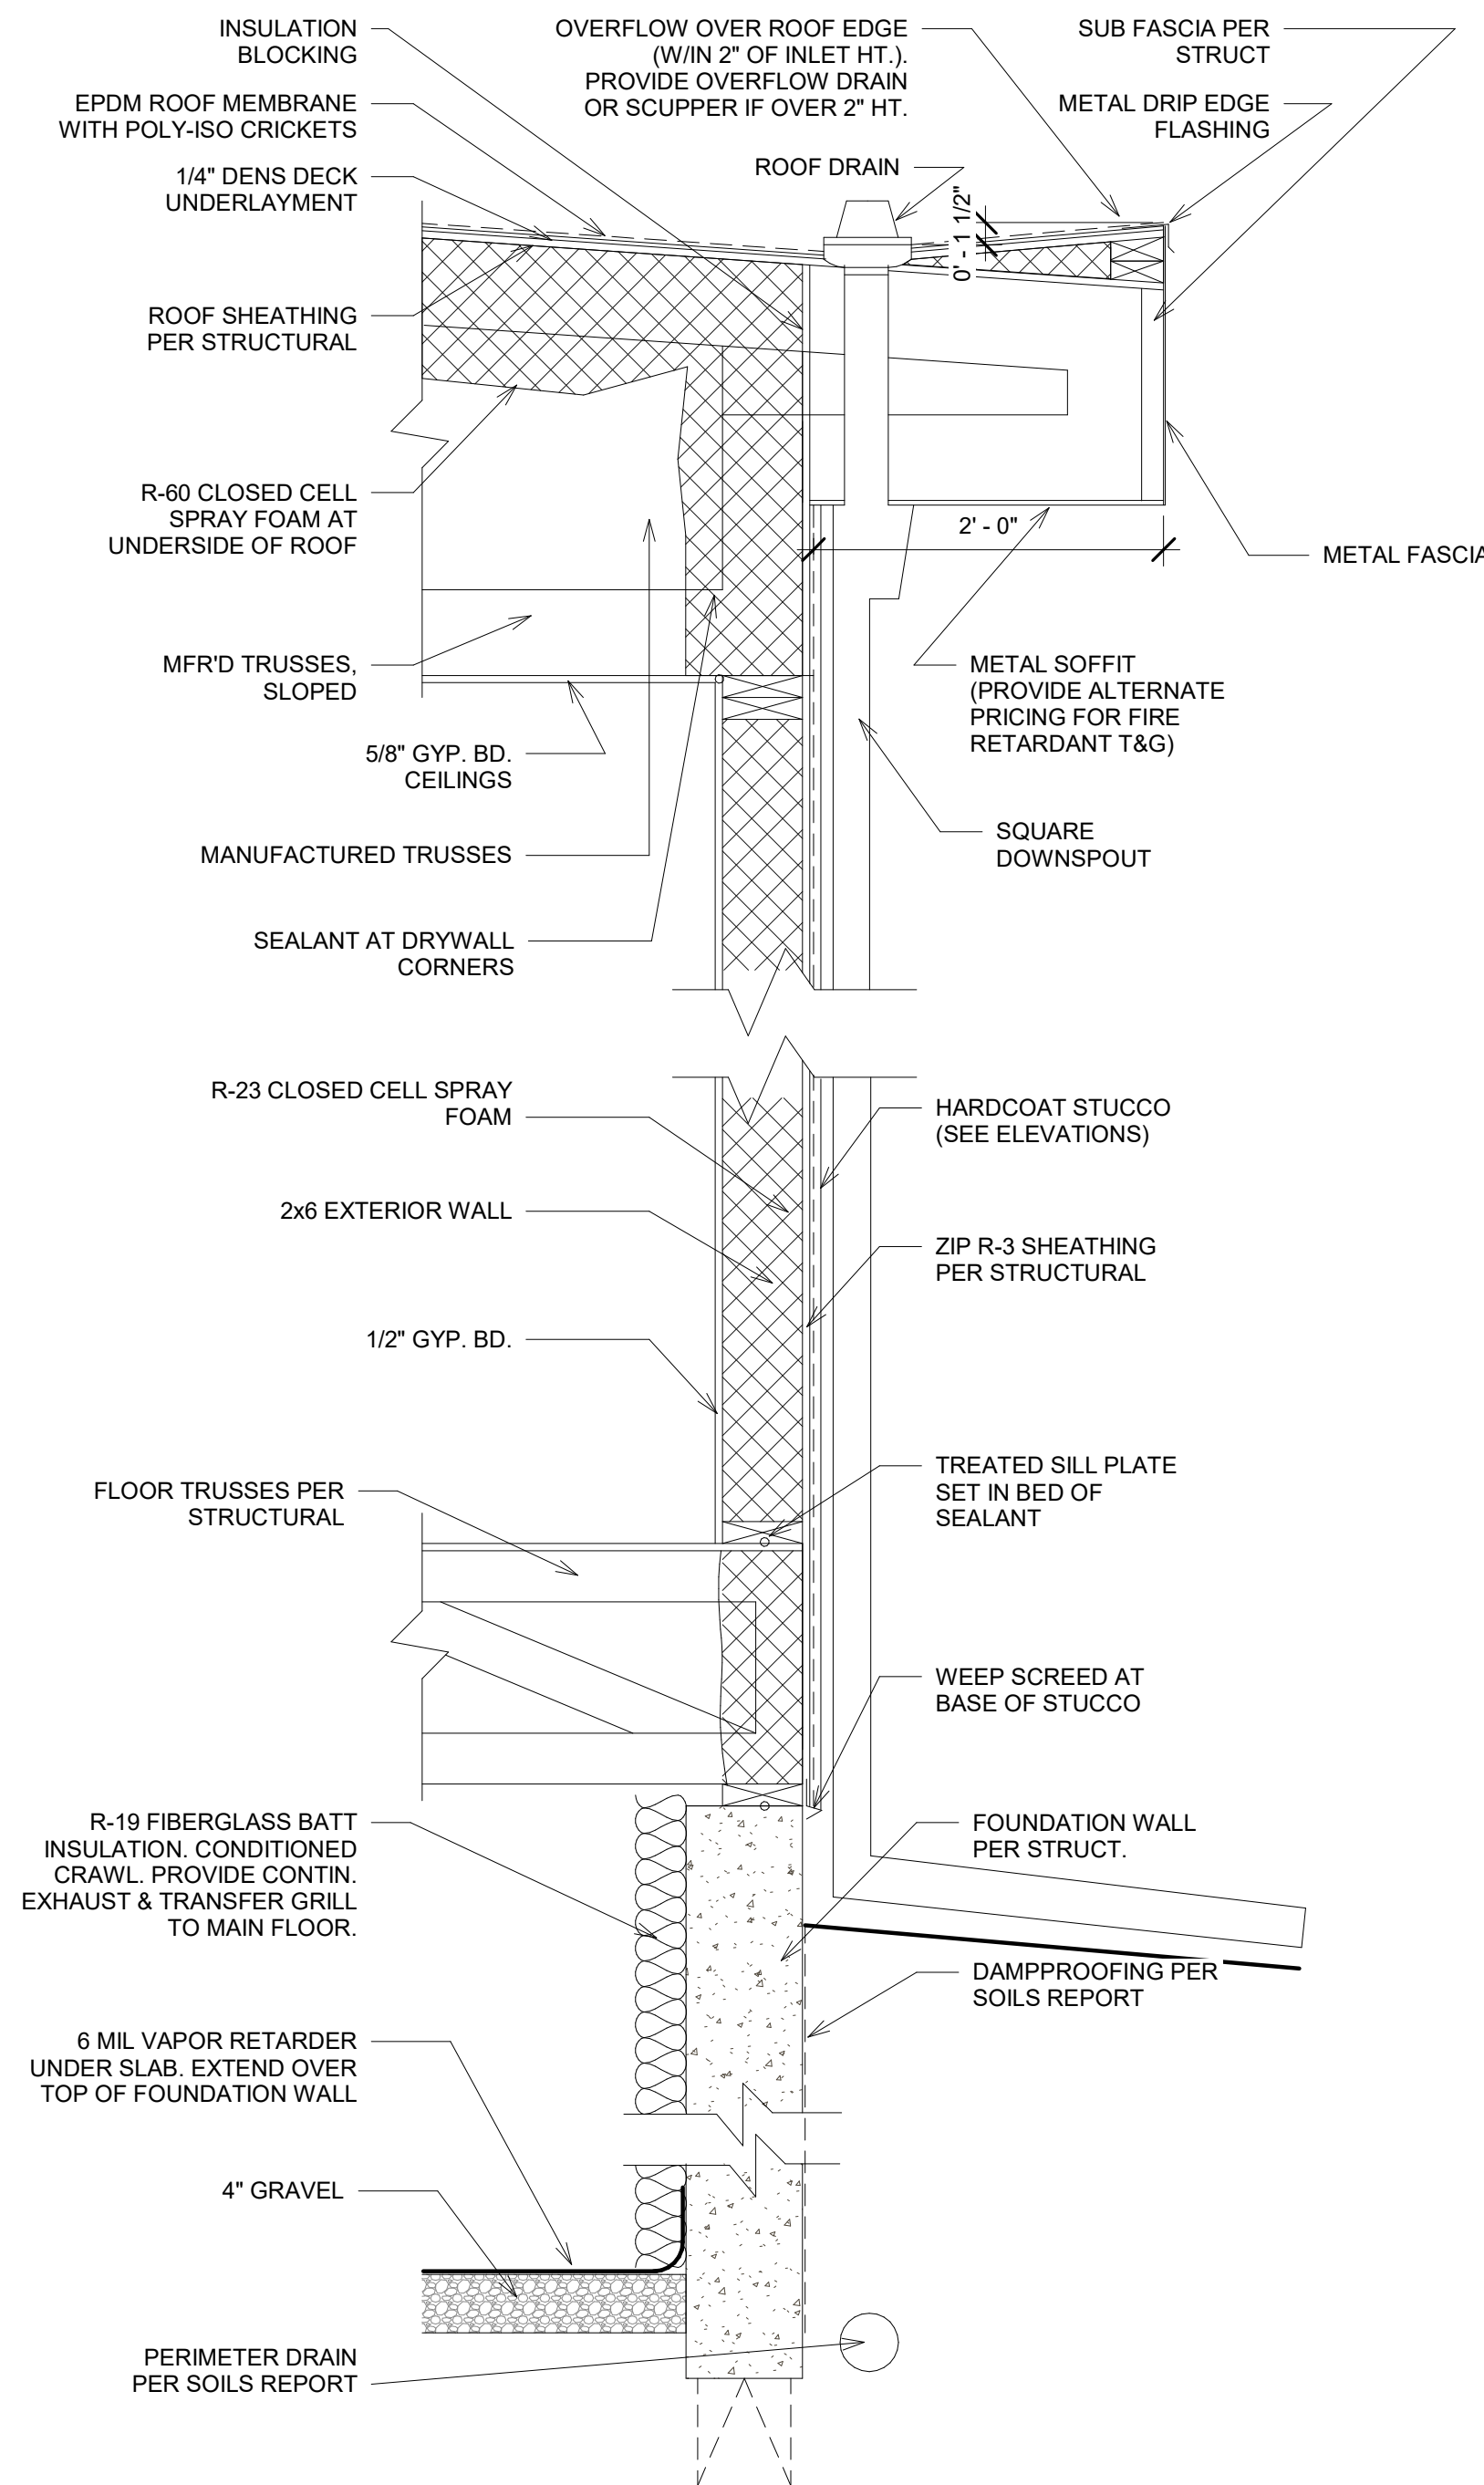


3 Typical Wall Section
1" = 1'-0"

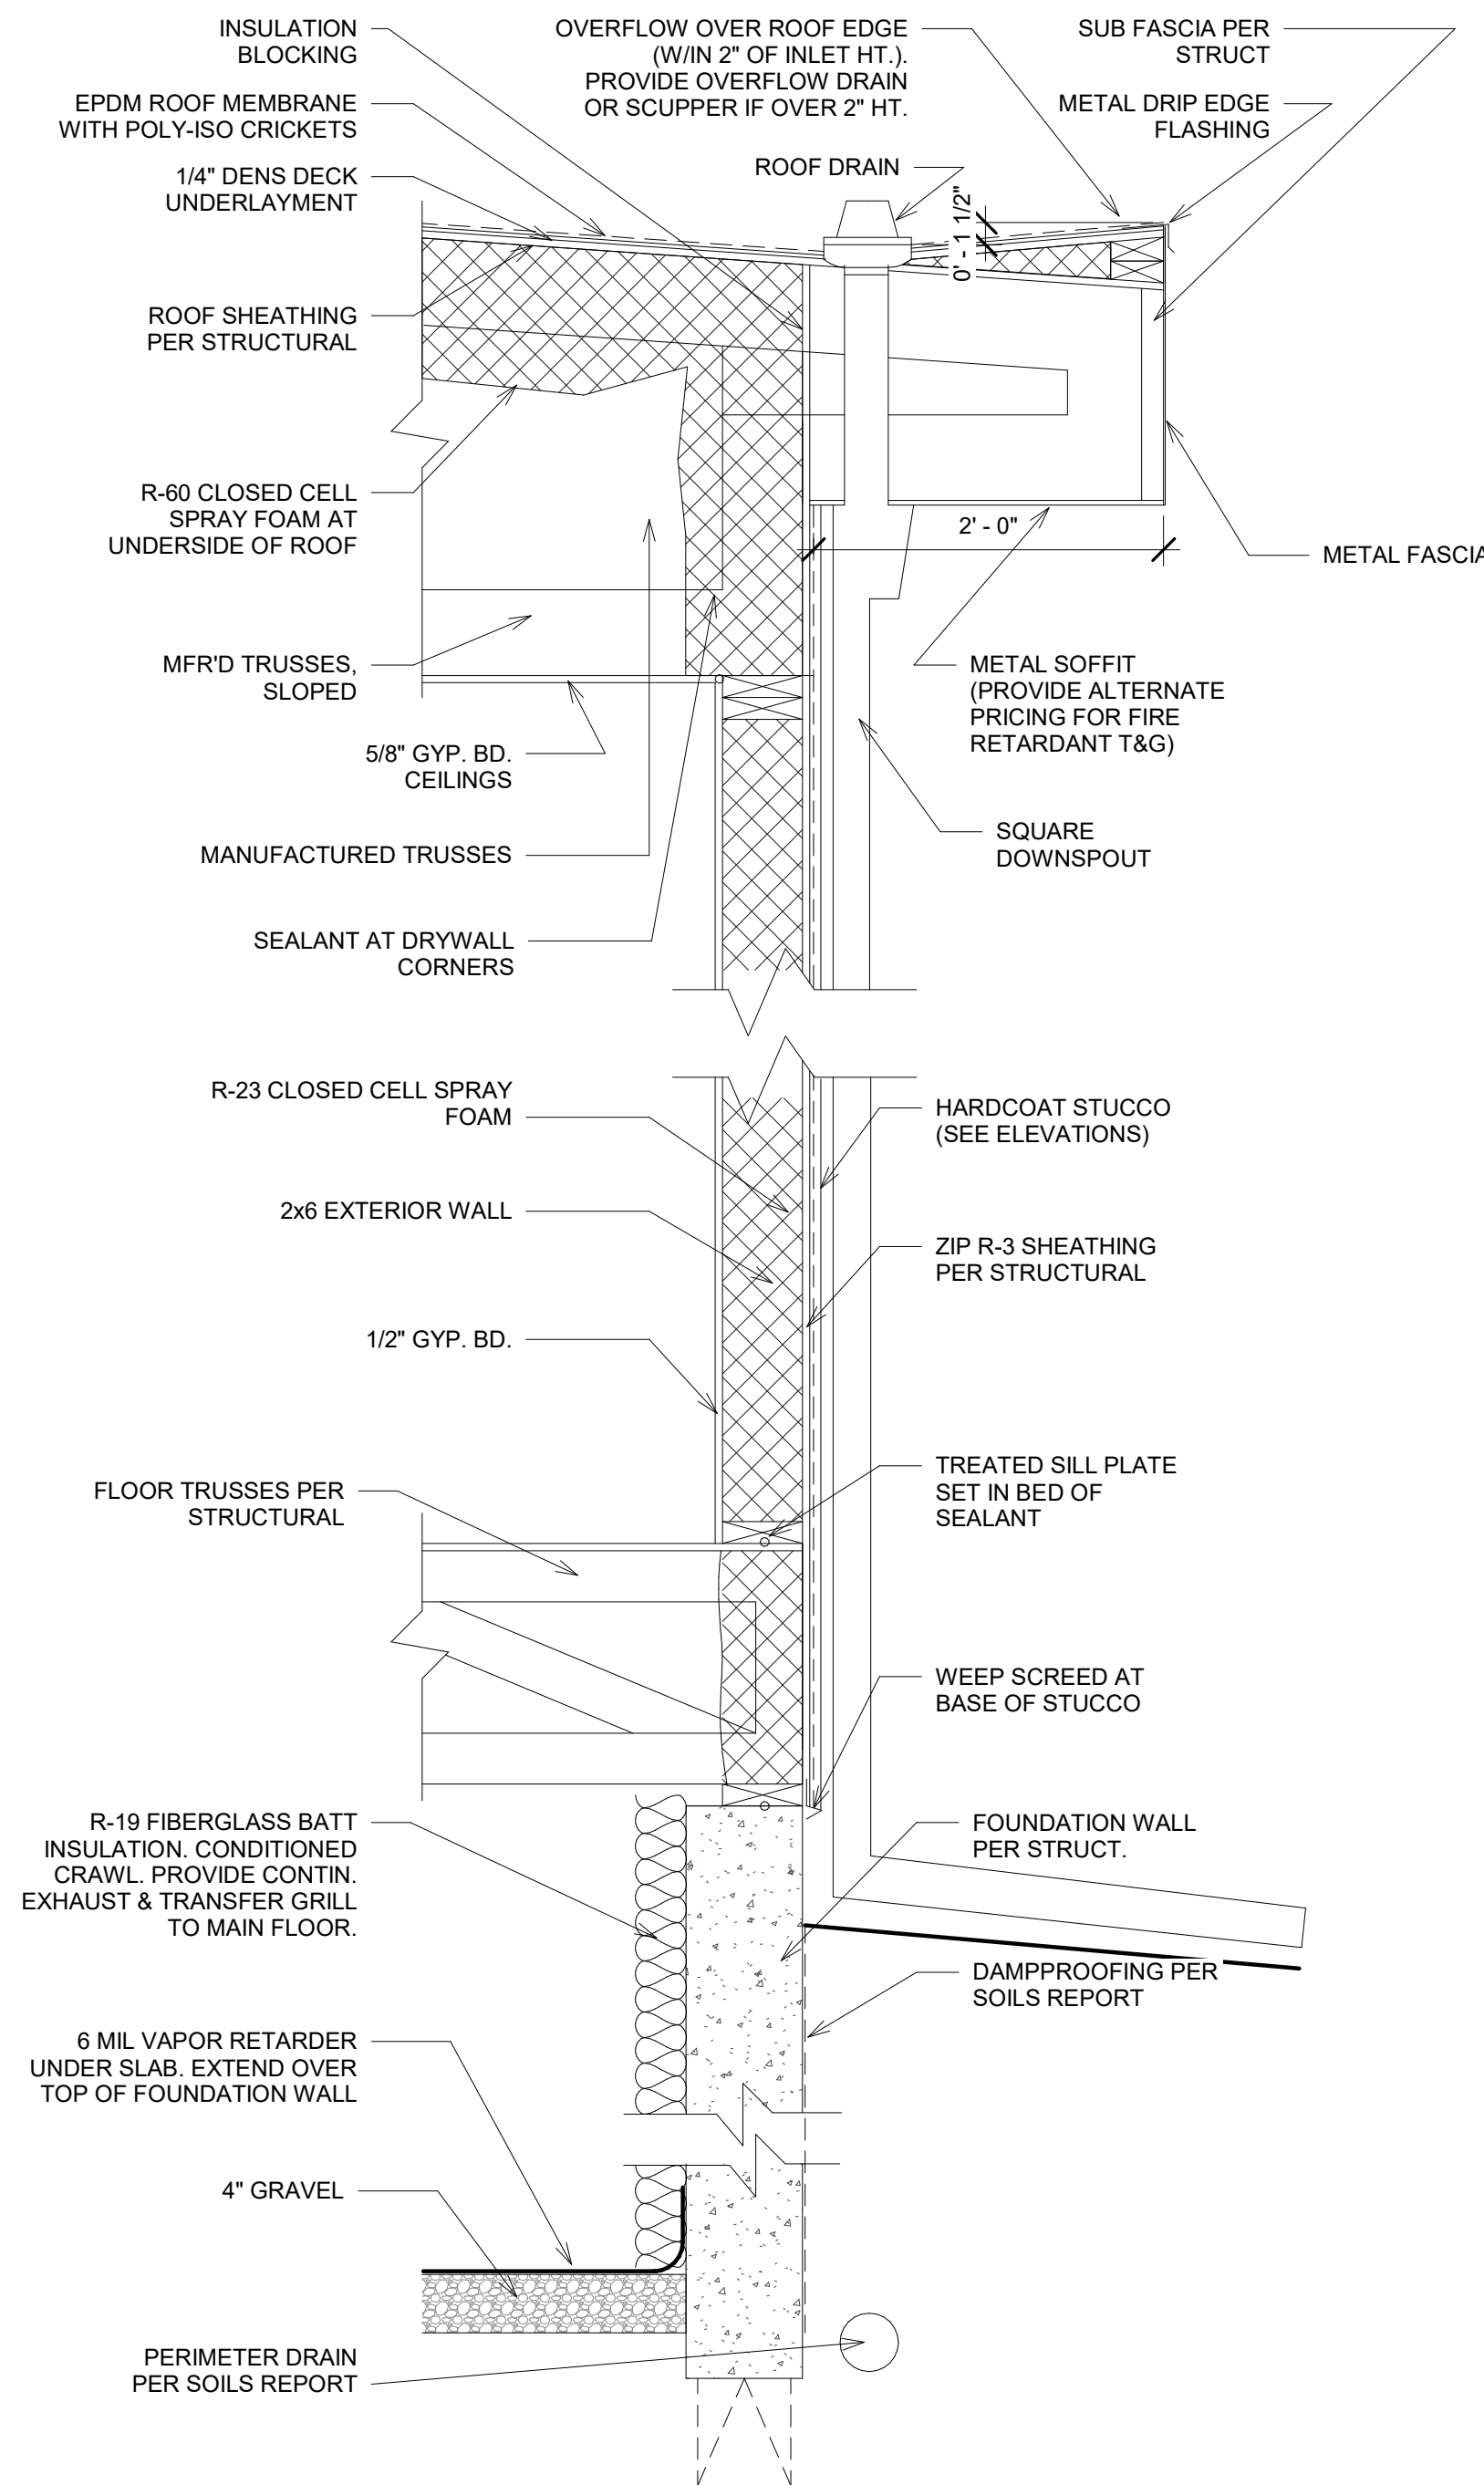


3 Typical Wall Section
1" = 1'-0"

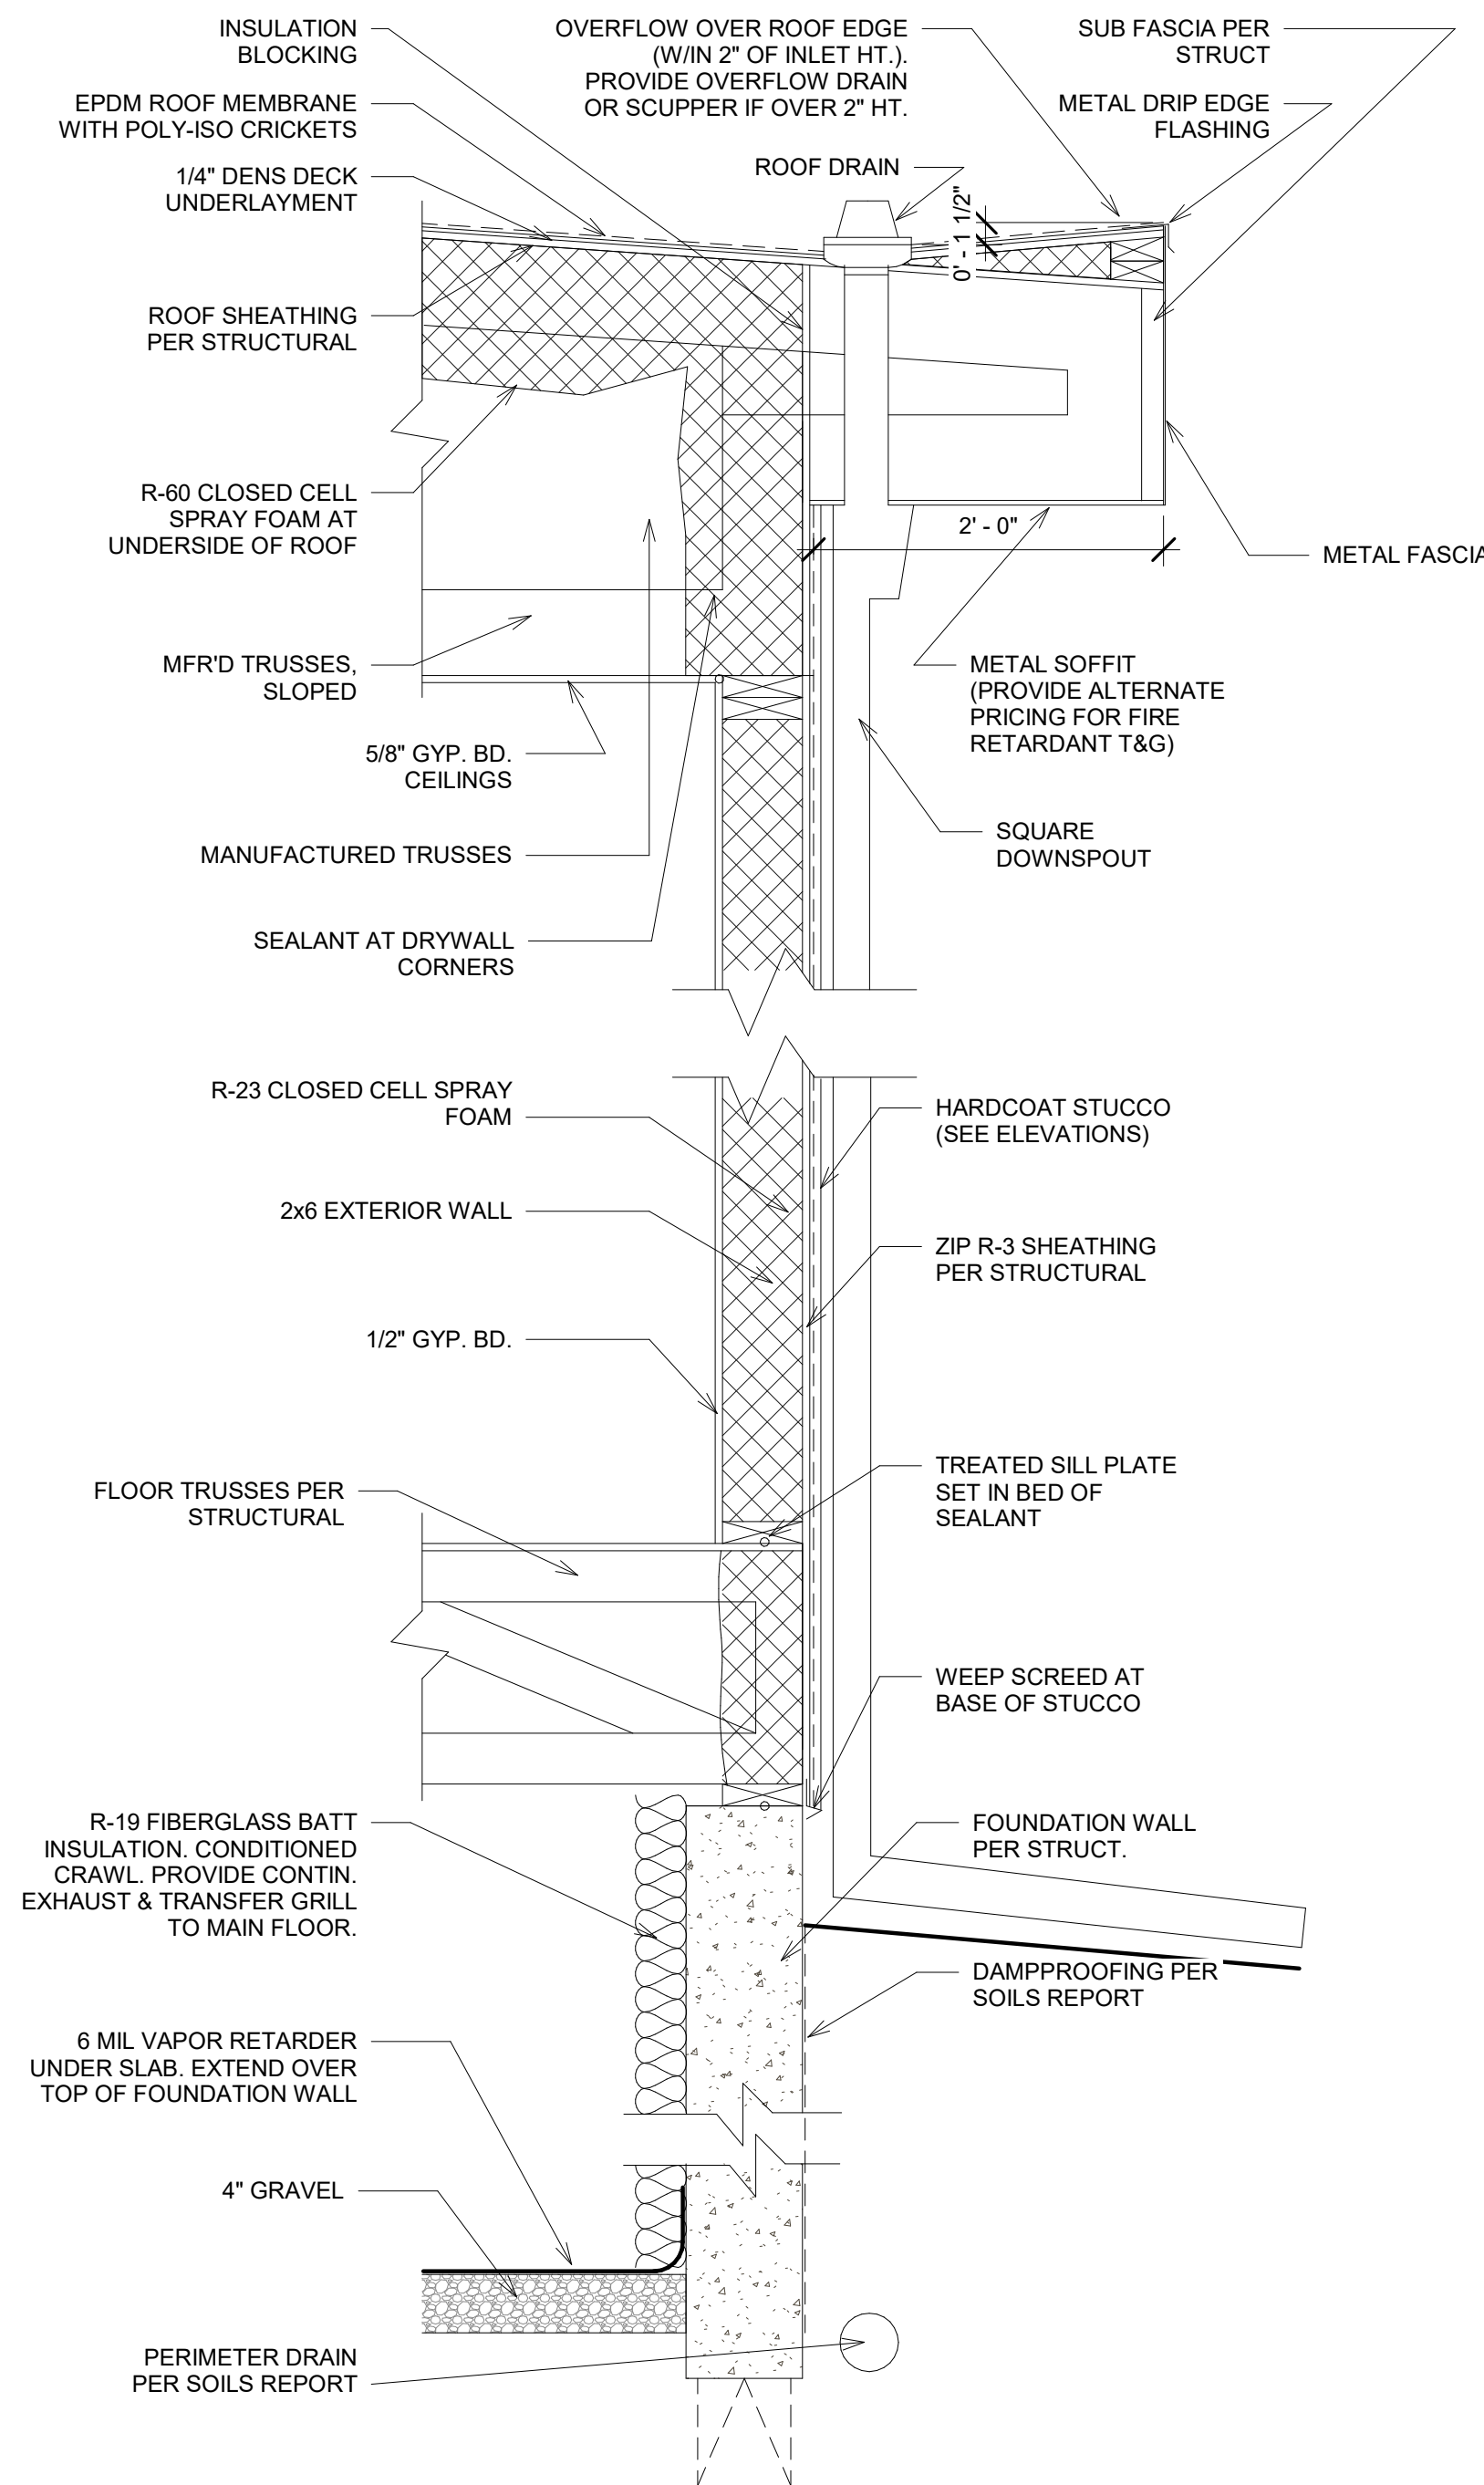


3 Typical Wall Section
1" = 1'-0"

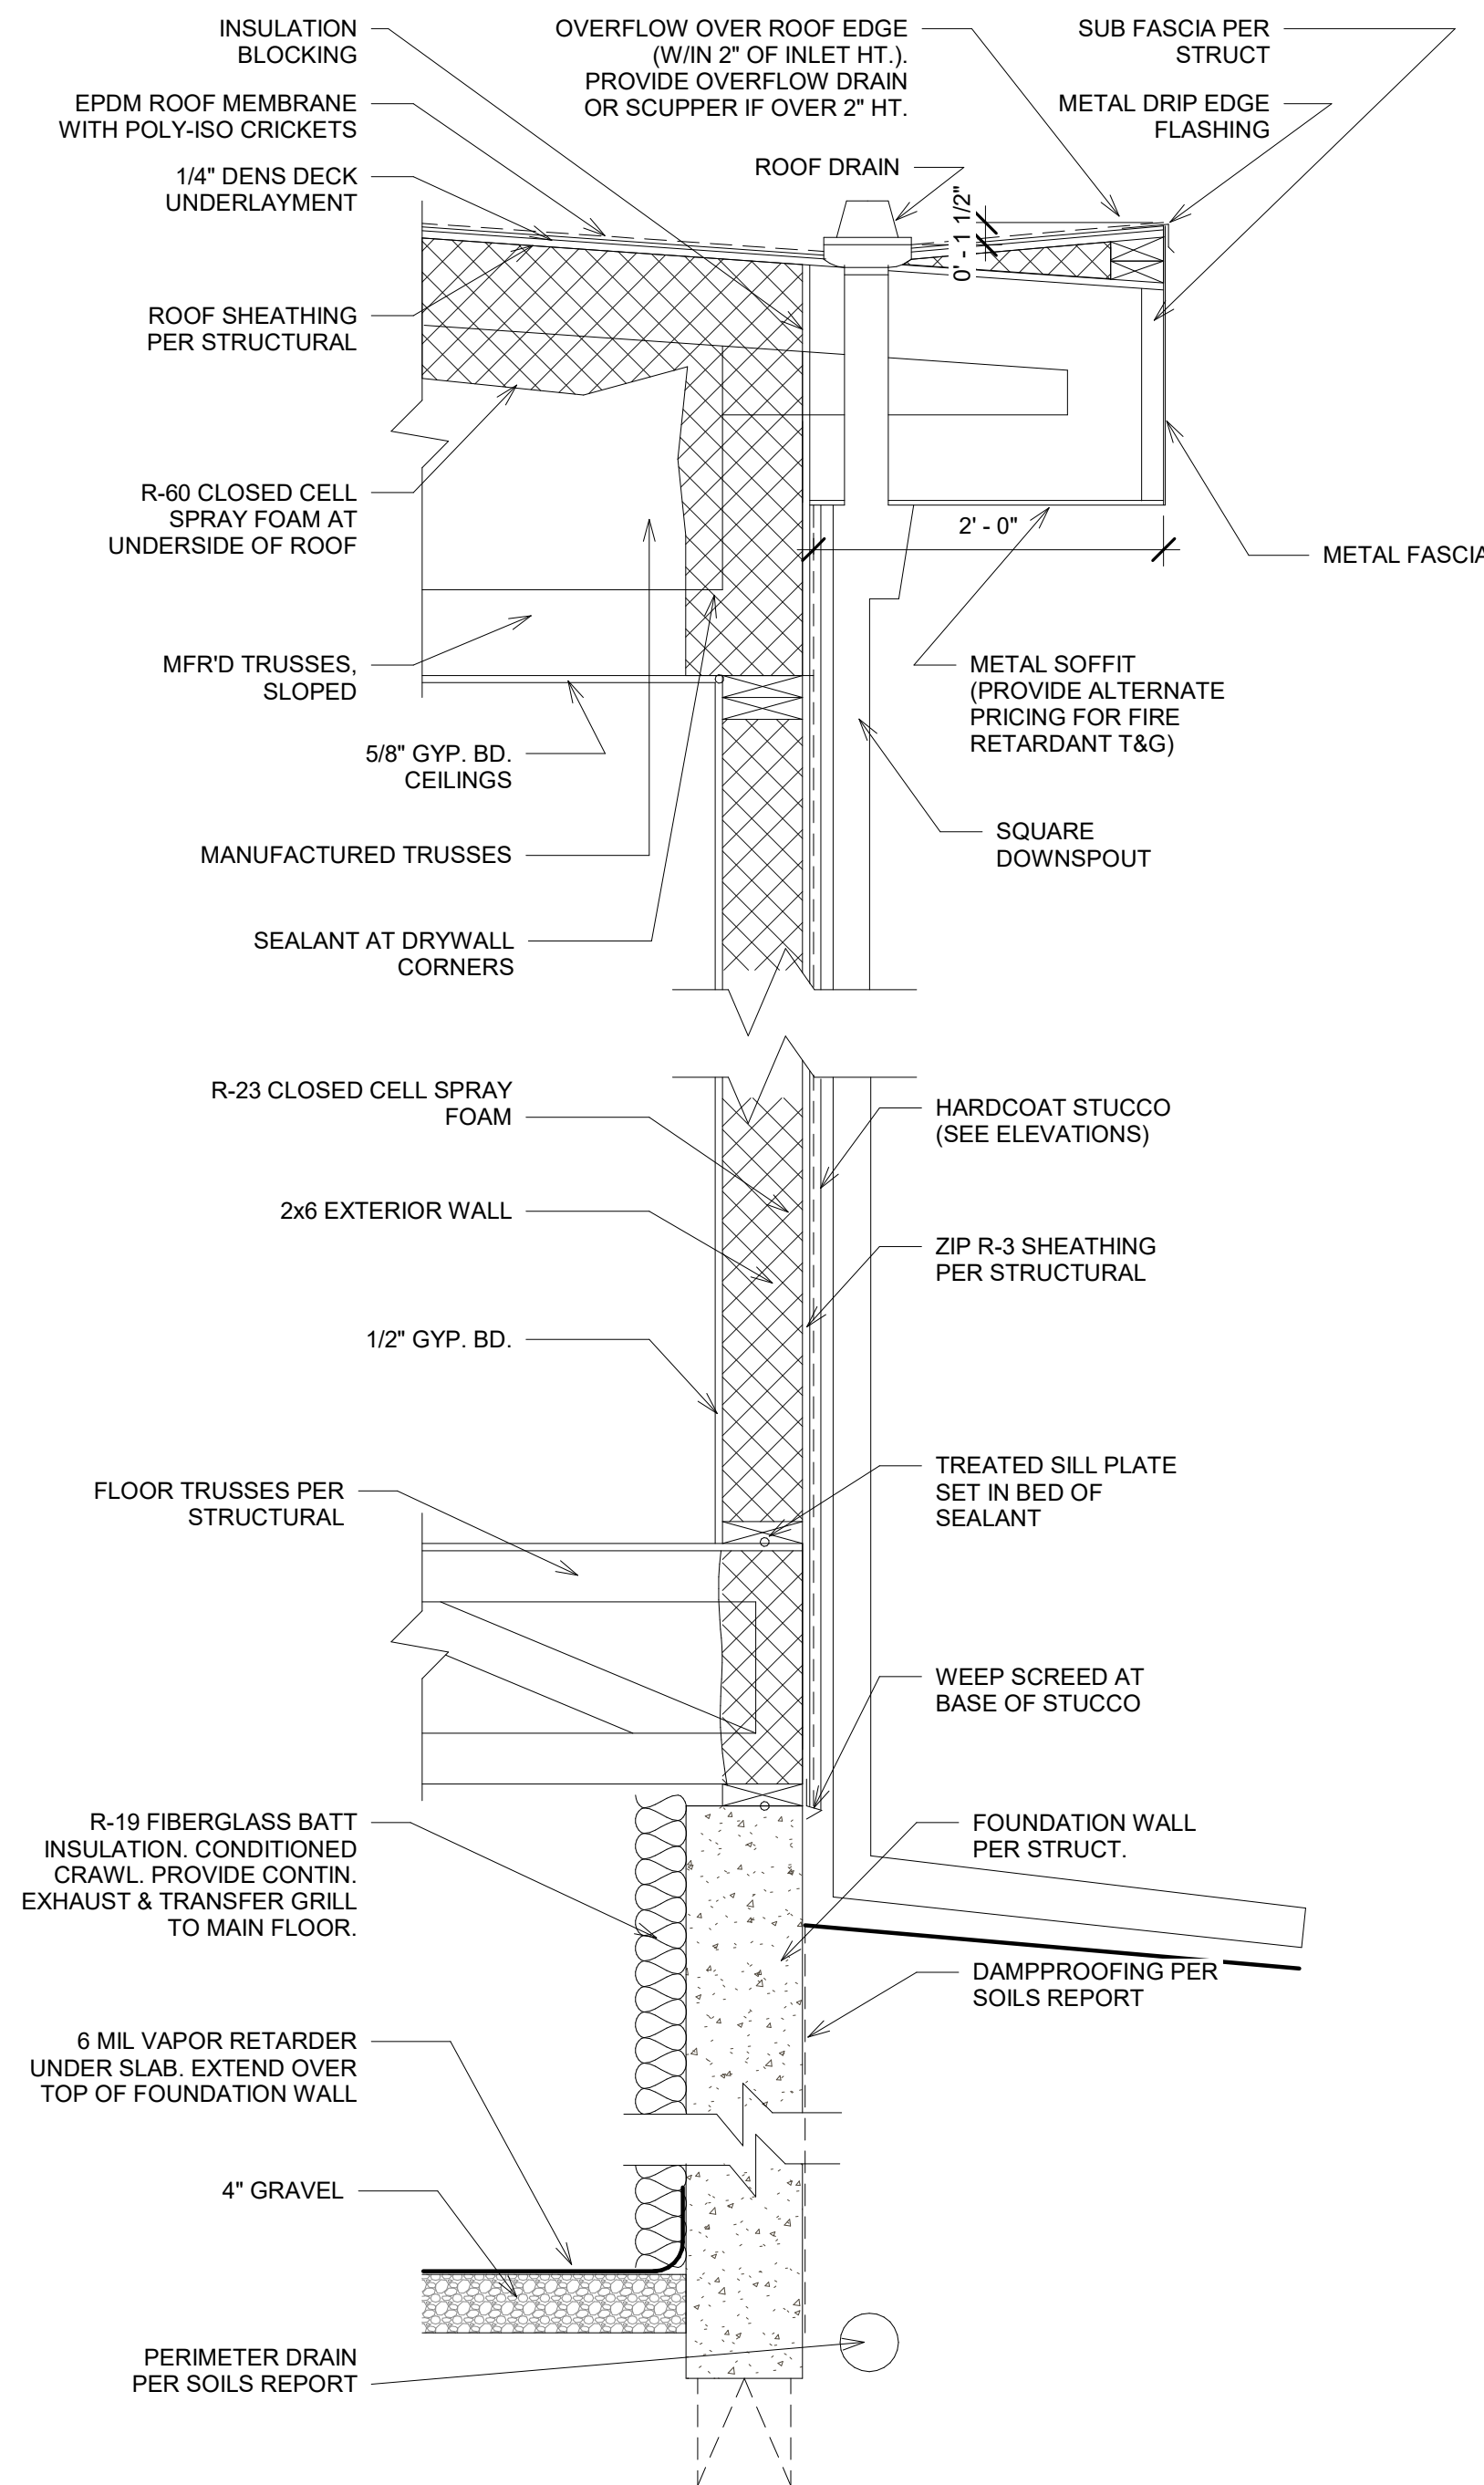


3 Typical Wall Section
1" = 1'-0"

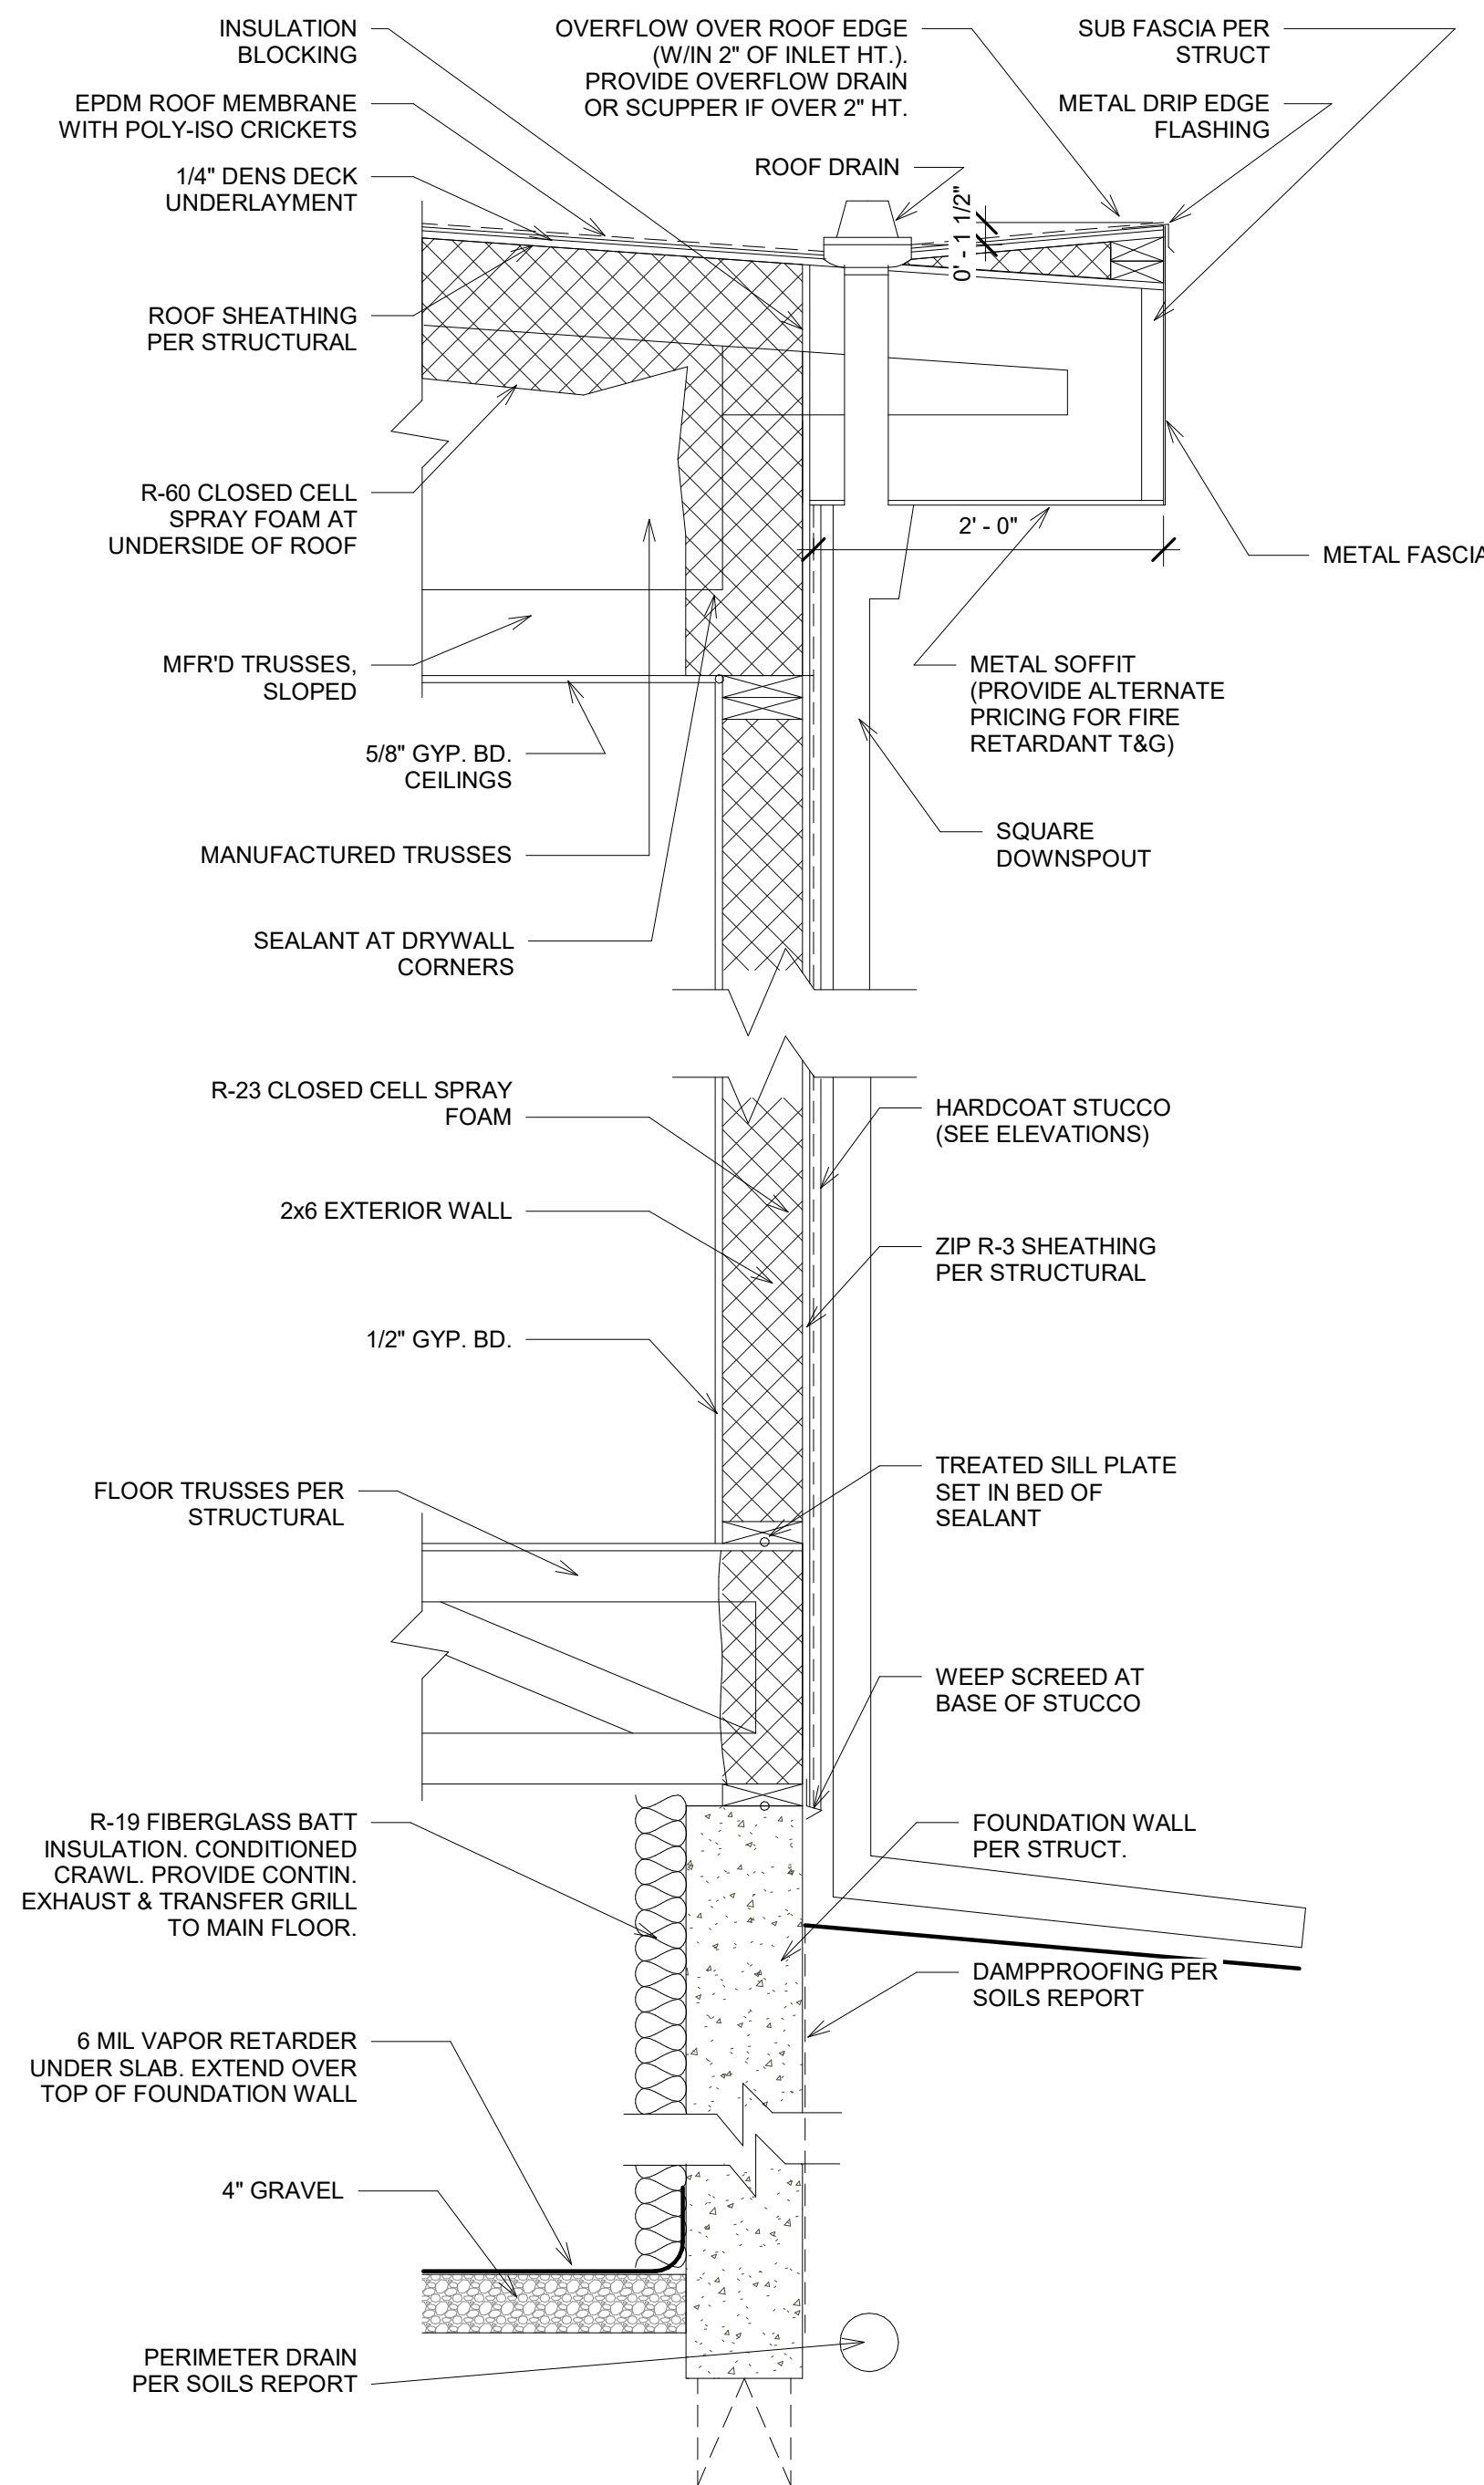


3 Typical Wall Section
1" = 1'-0"

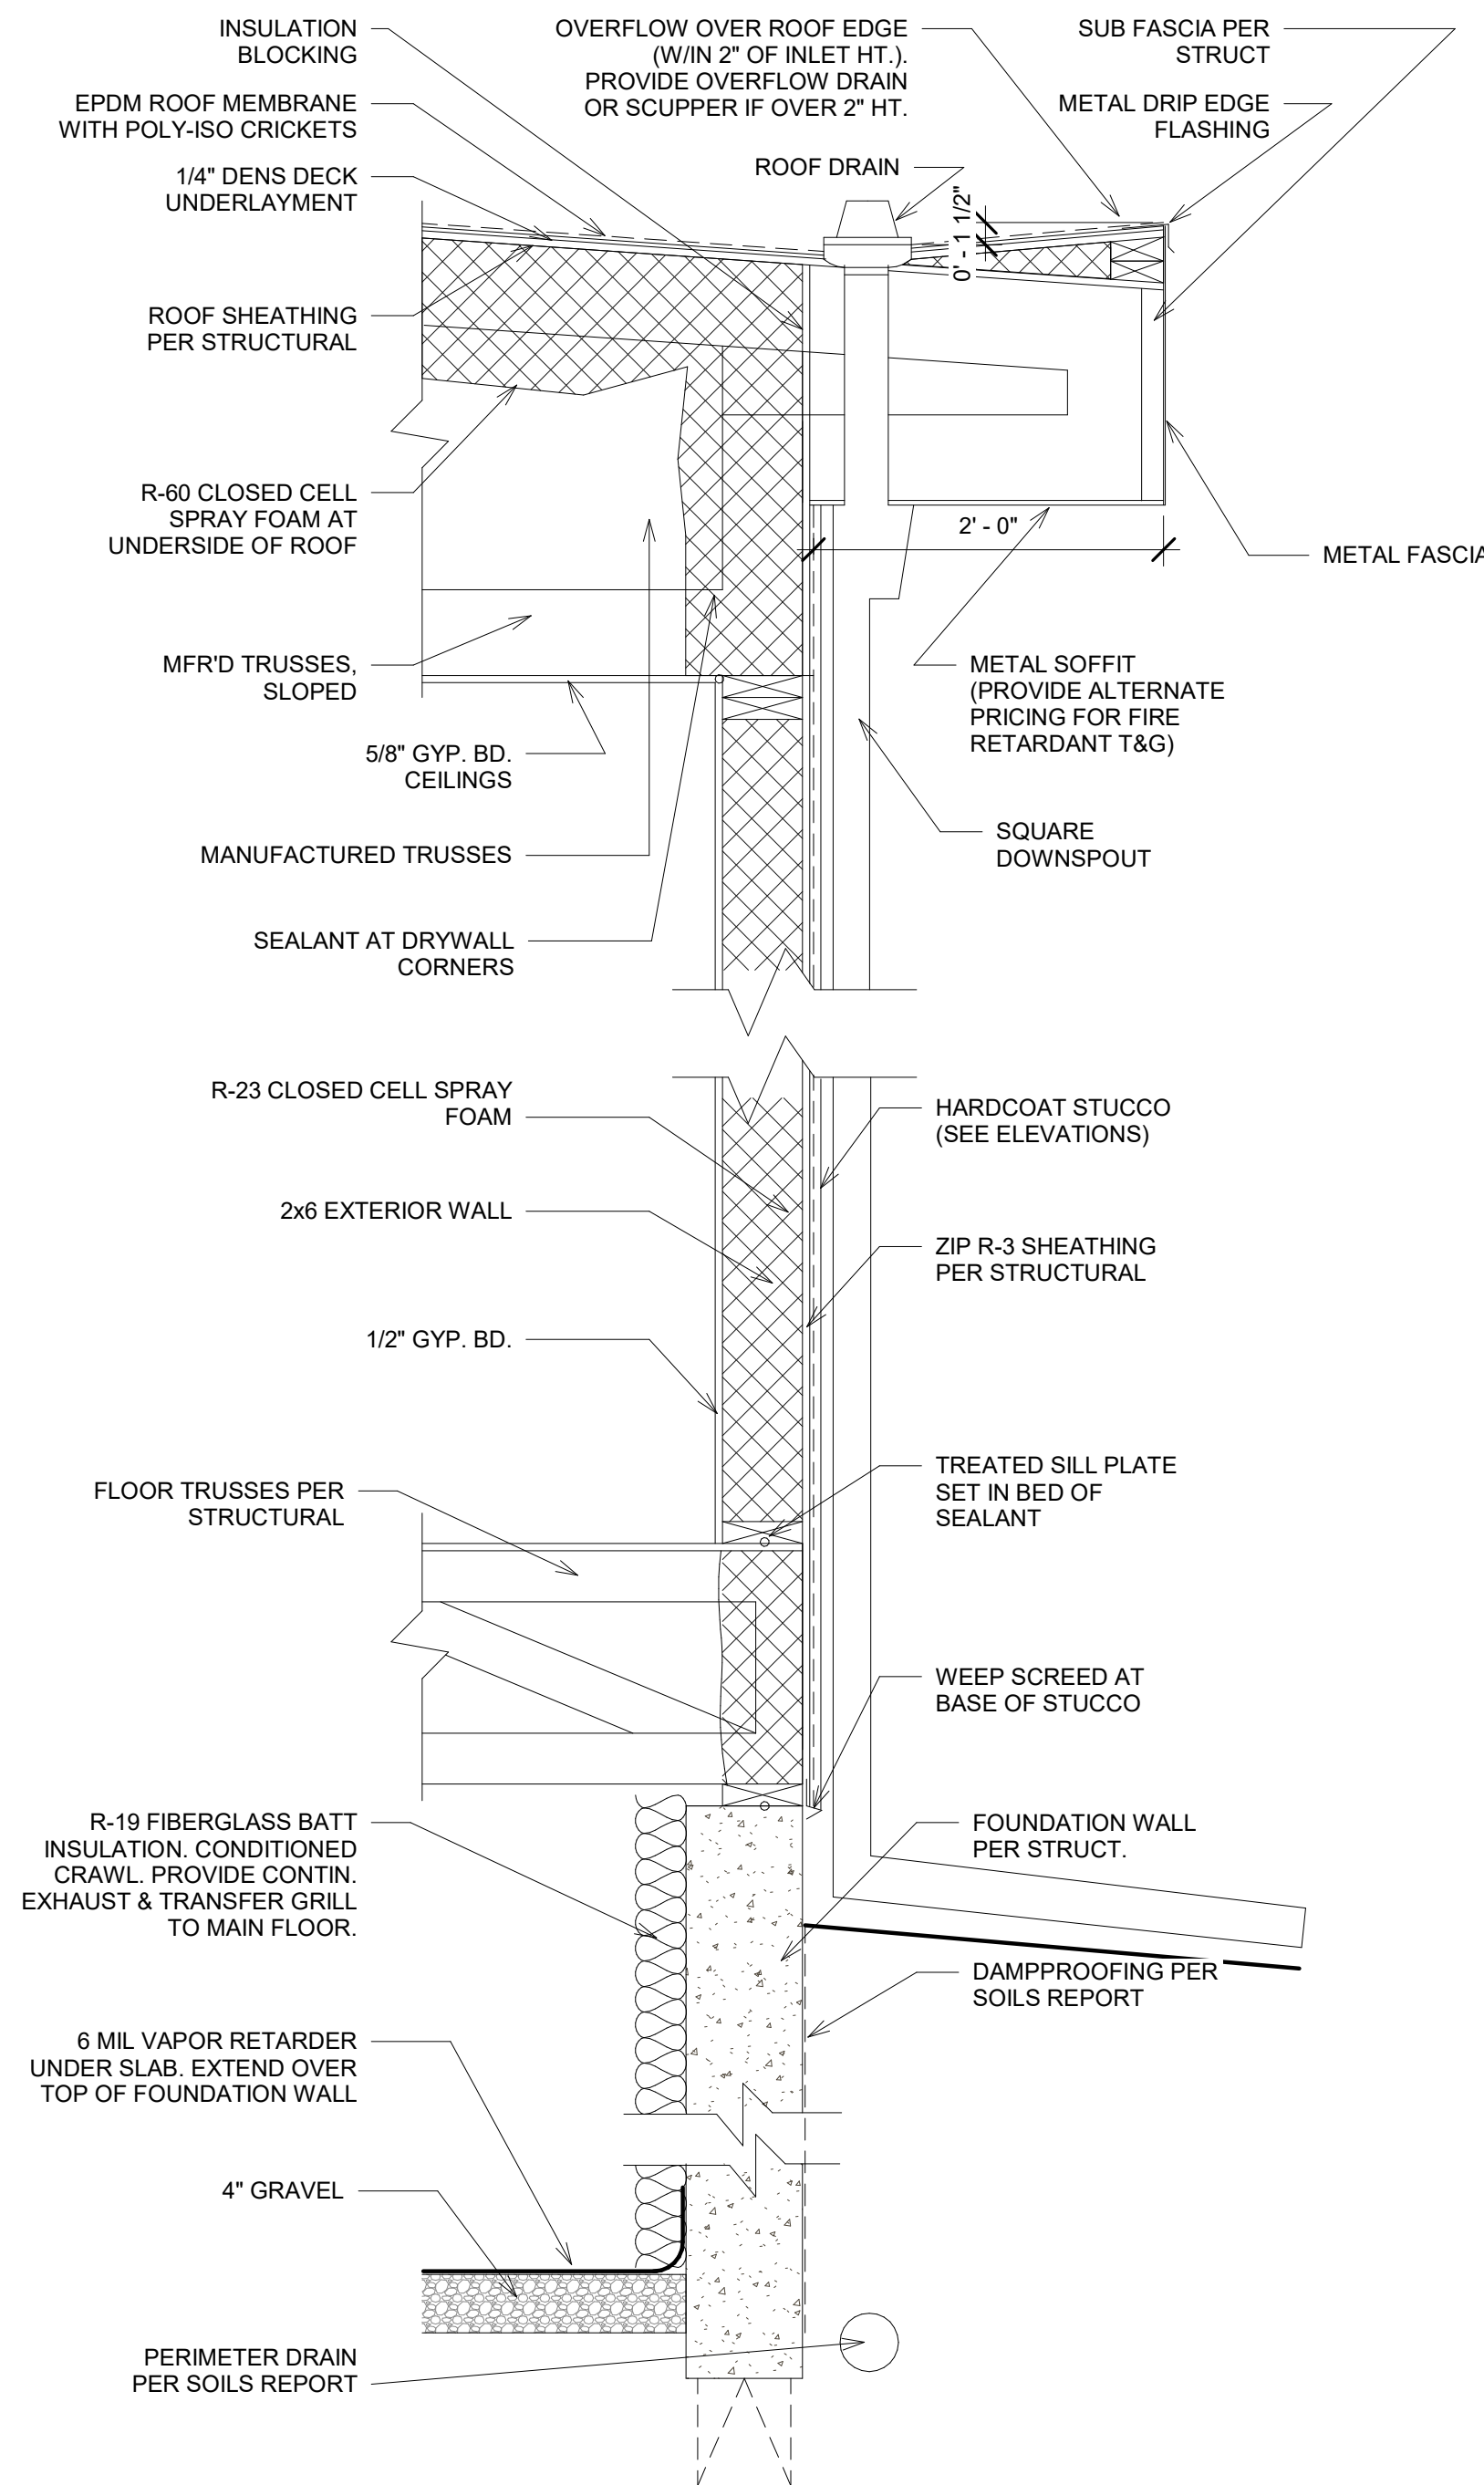


3 Typical Wall Section
1" = 1'-0"

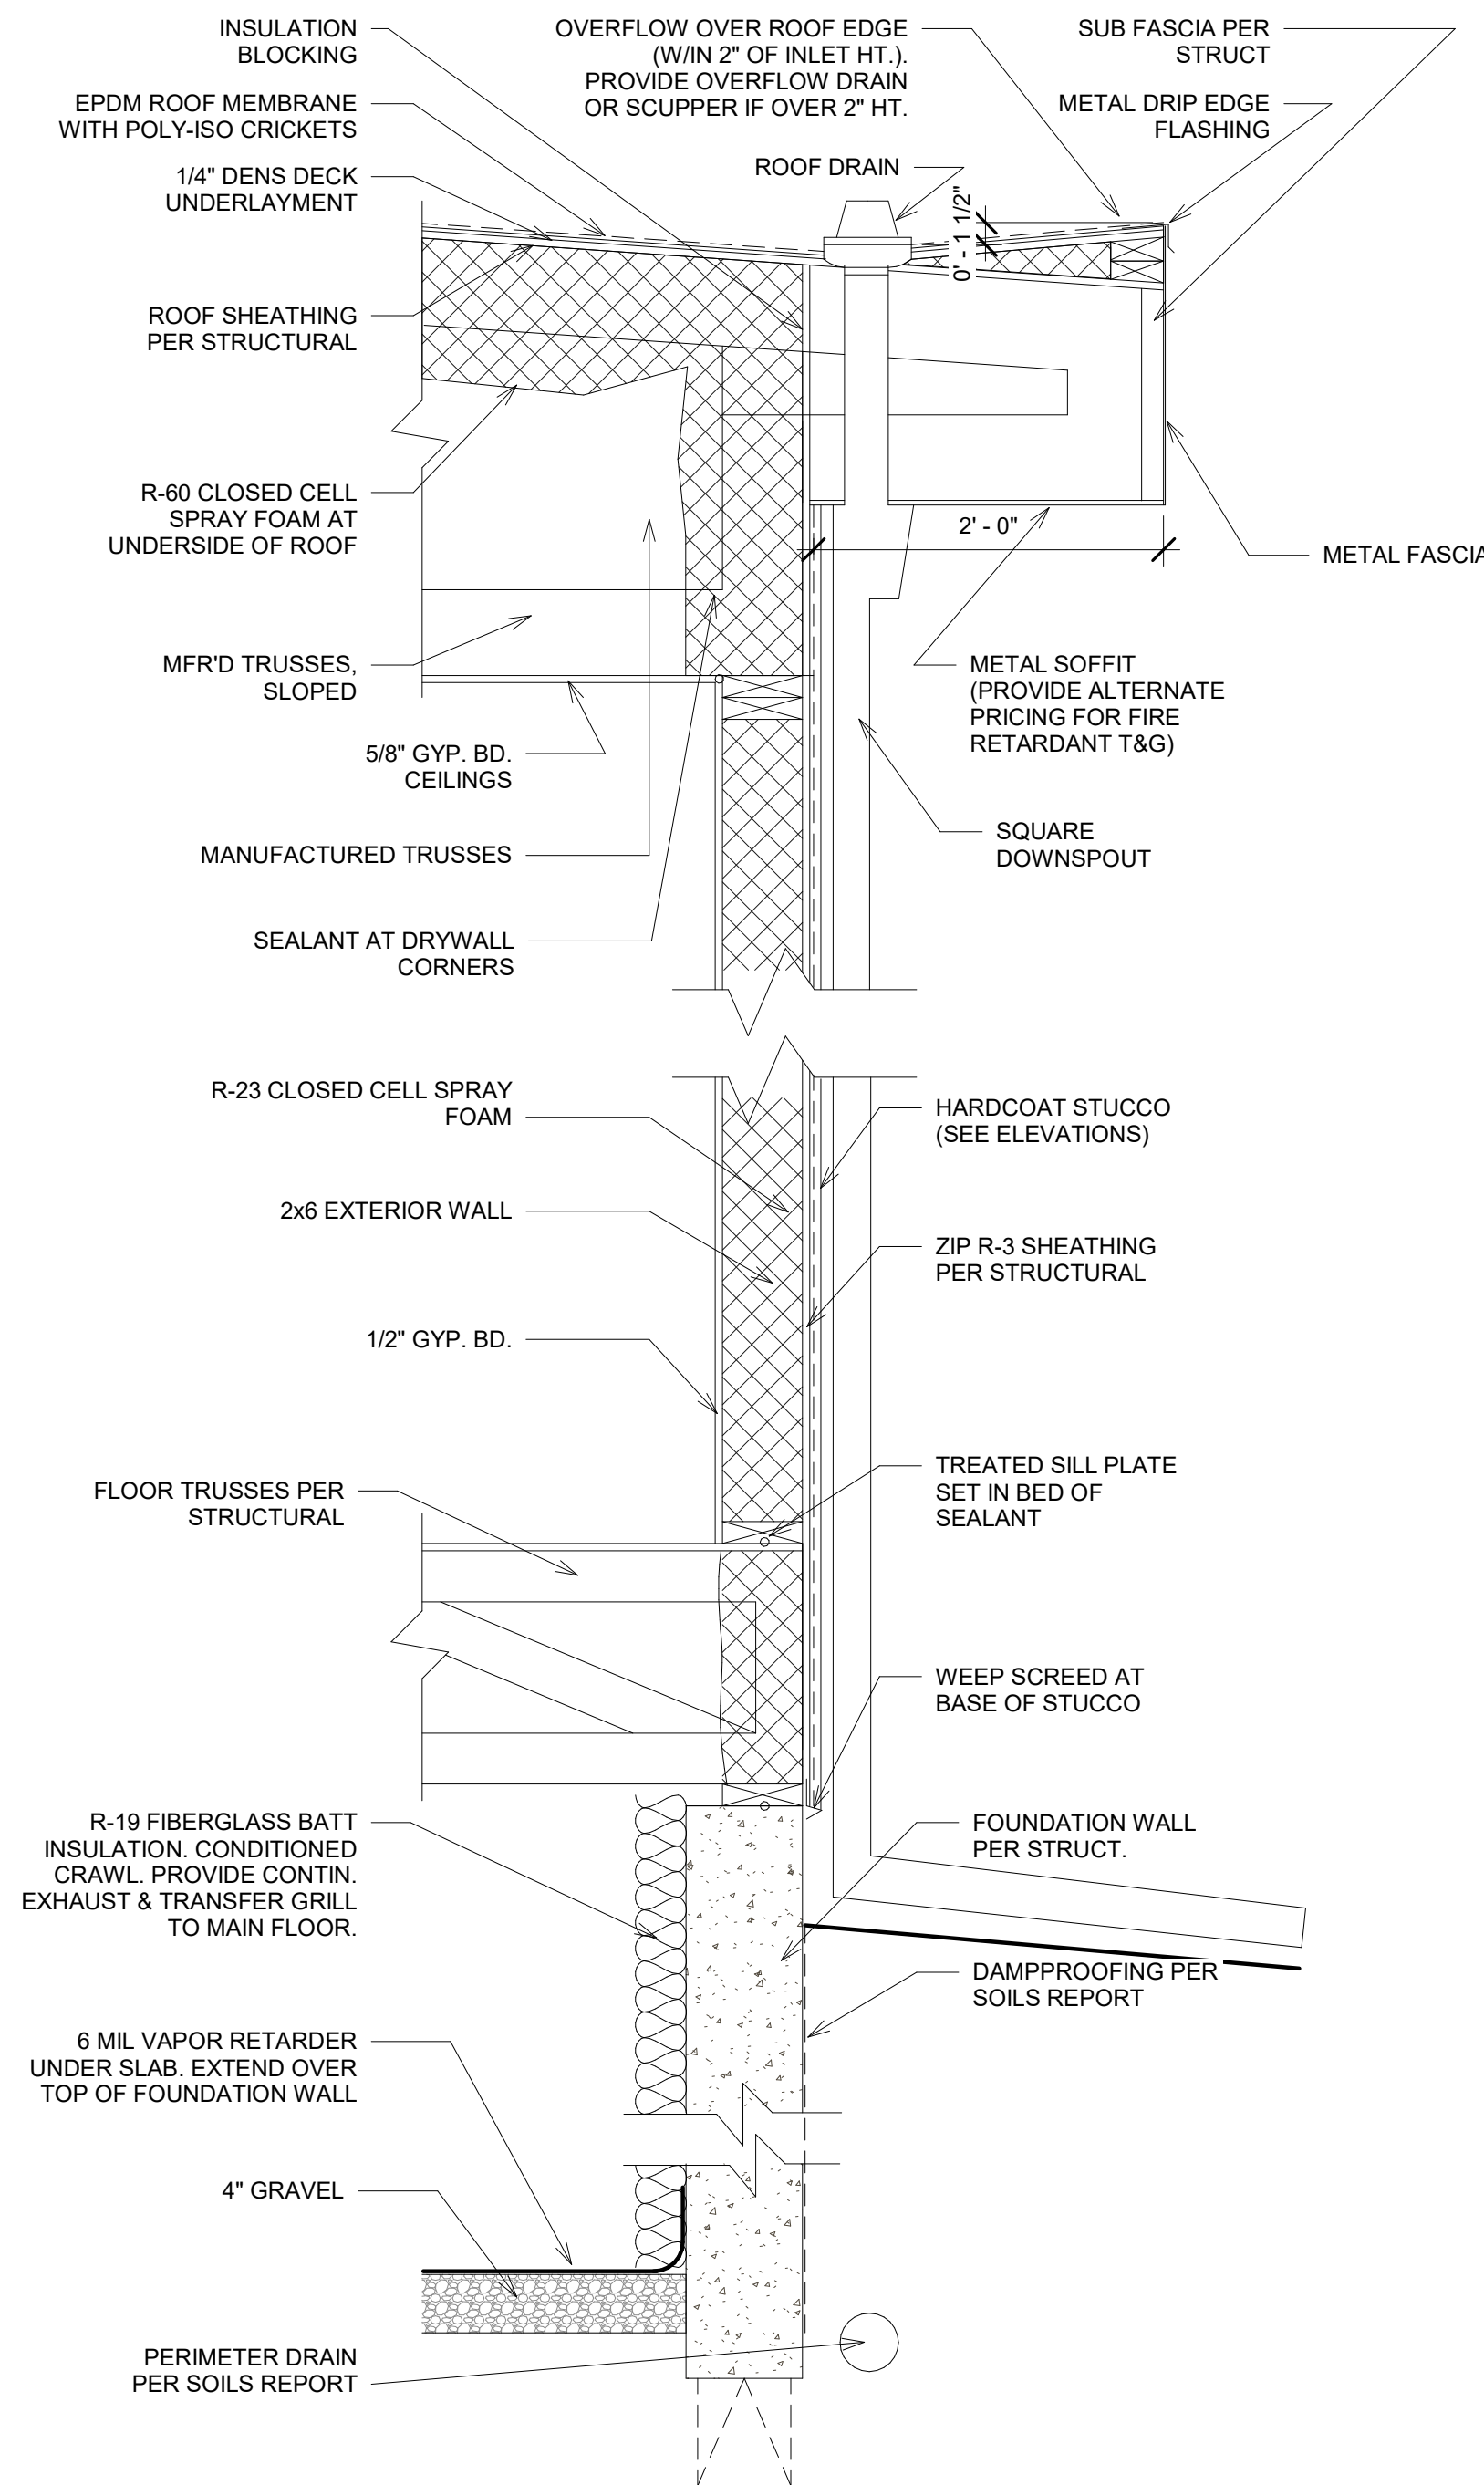


3 Typical Wall Section
1" = 1'-0"

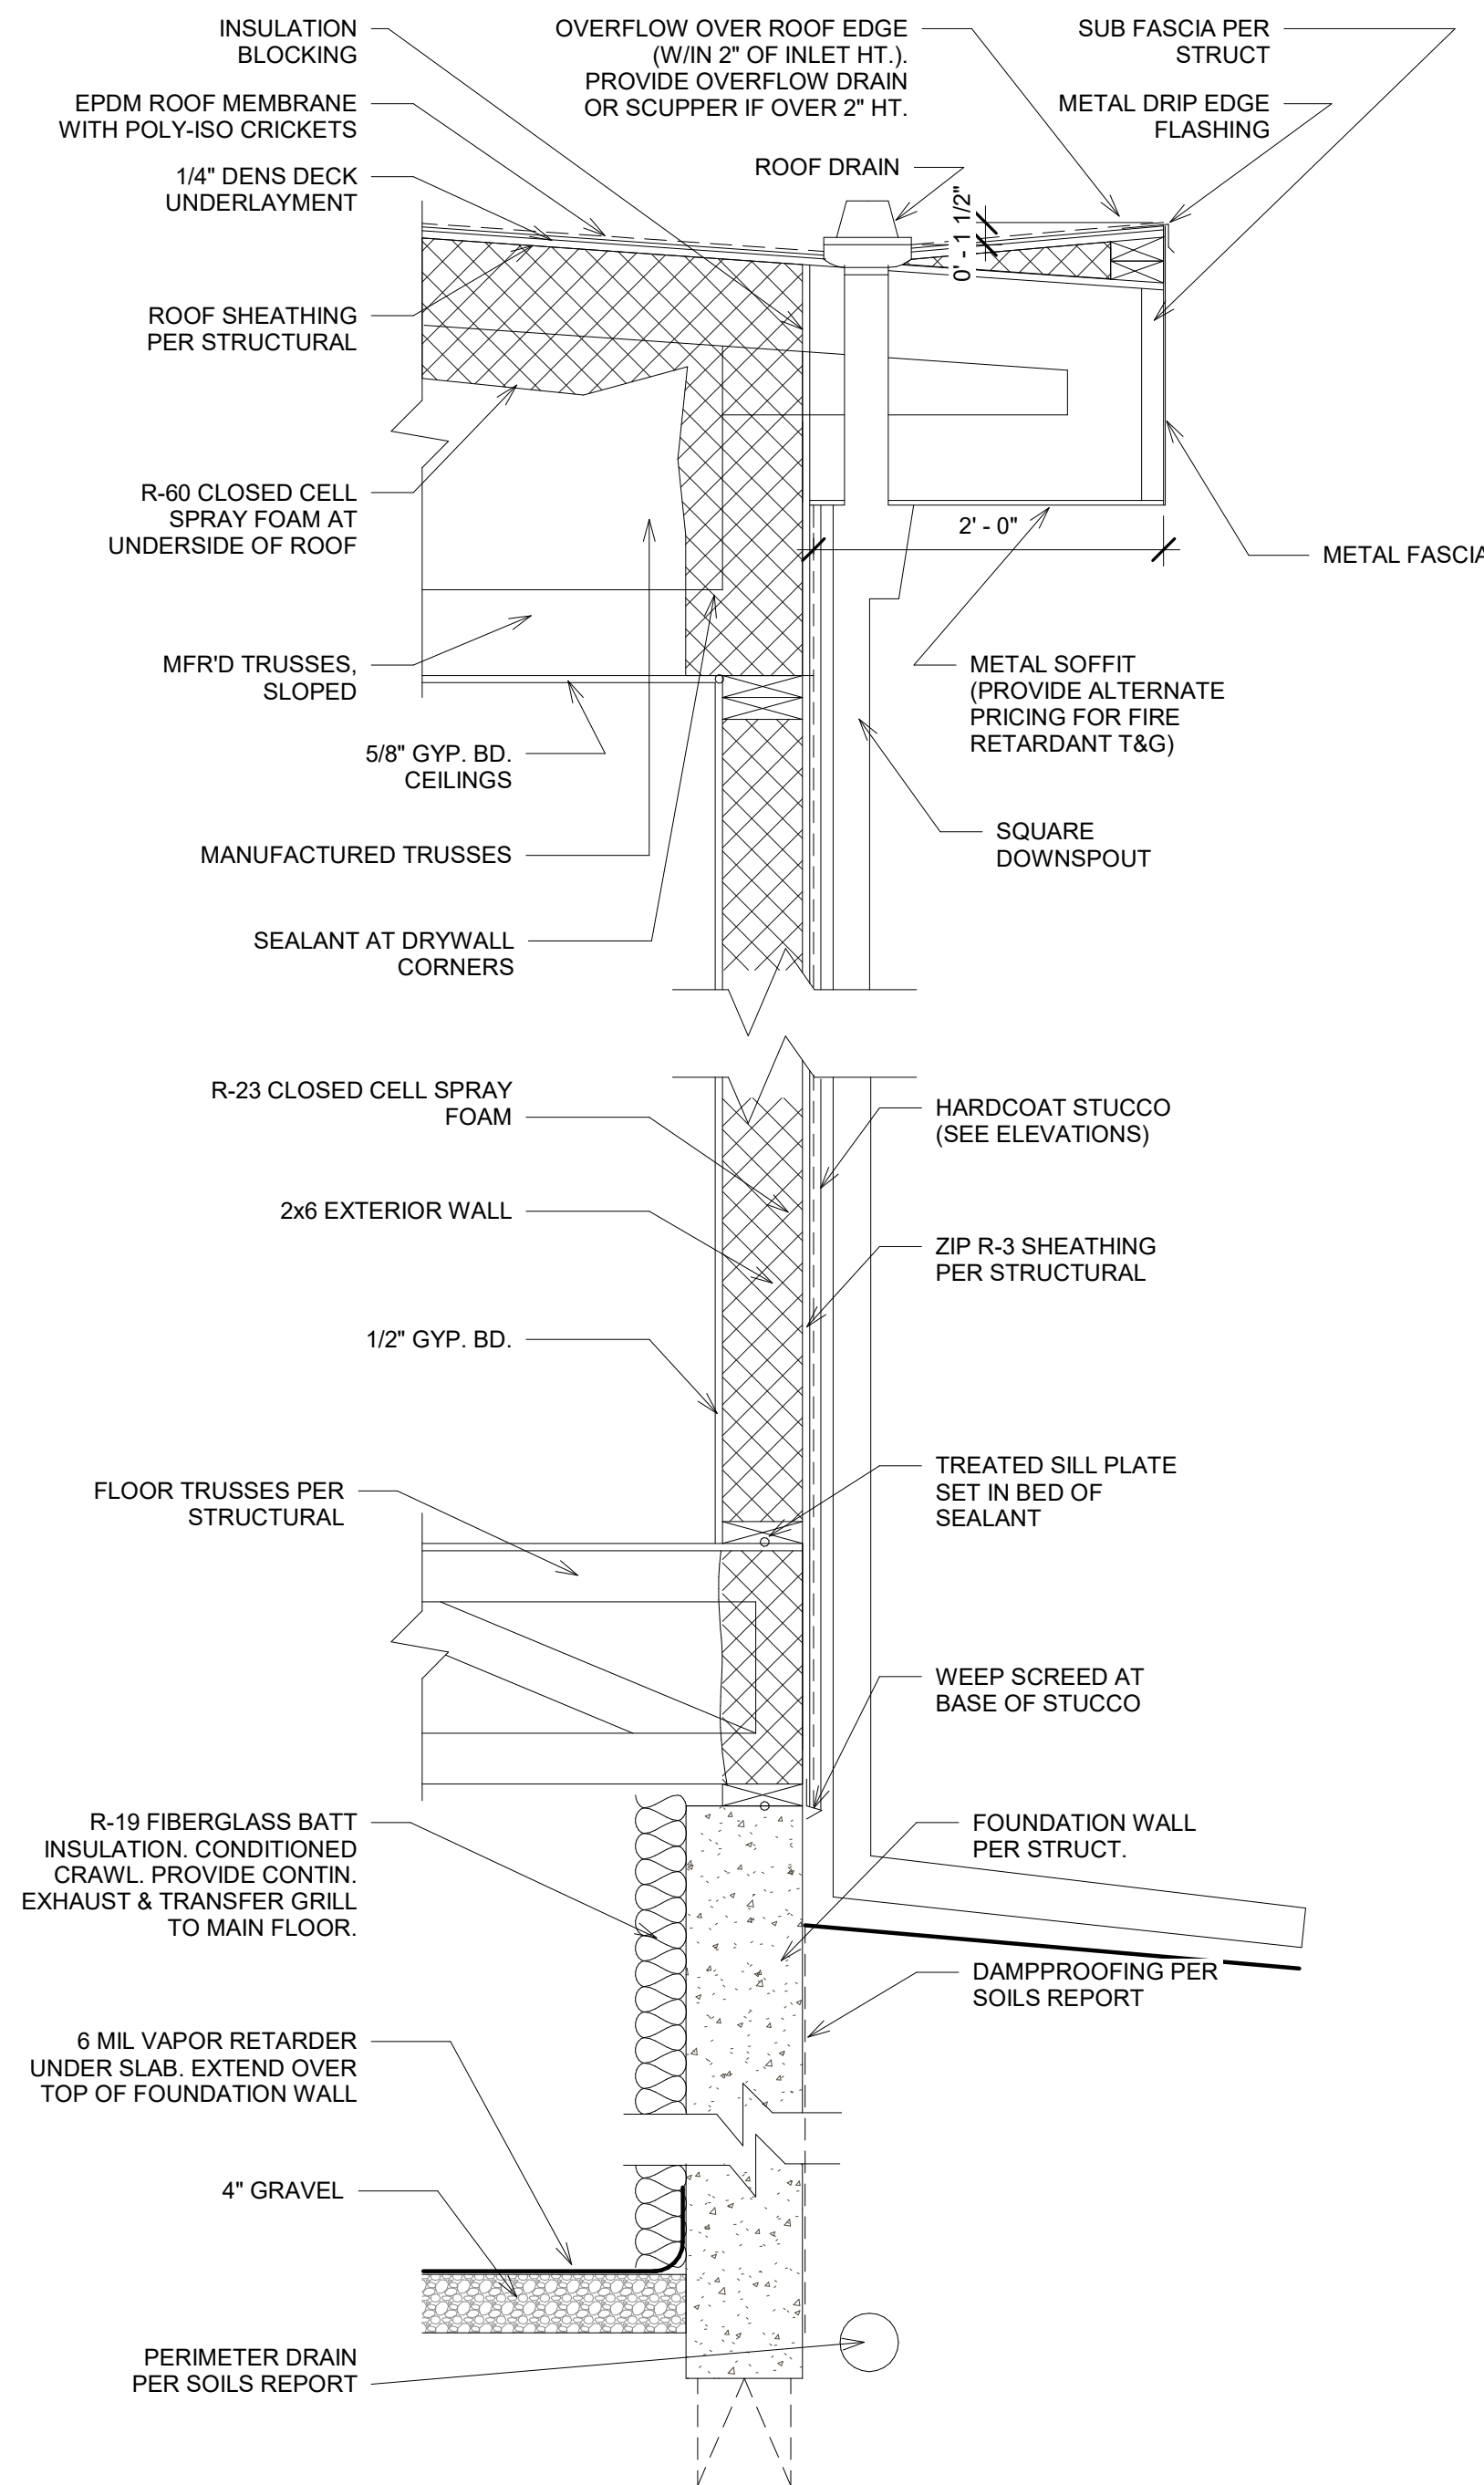


3 Typical Wall Section
1" = 1'-0"

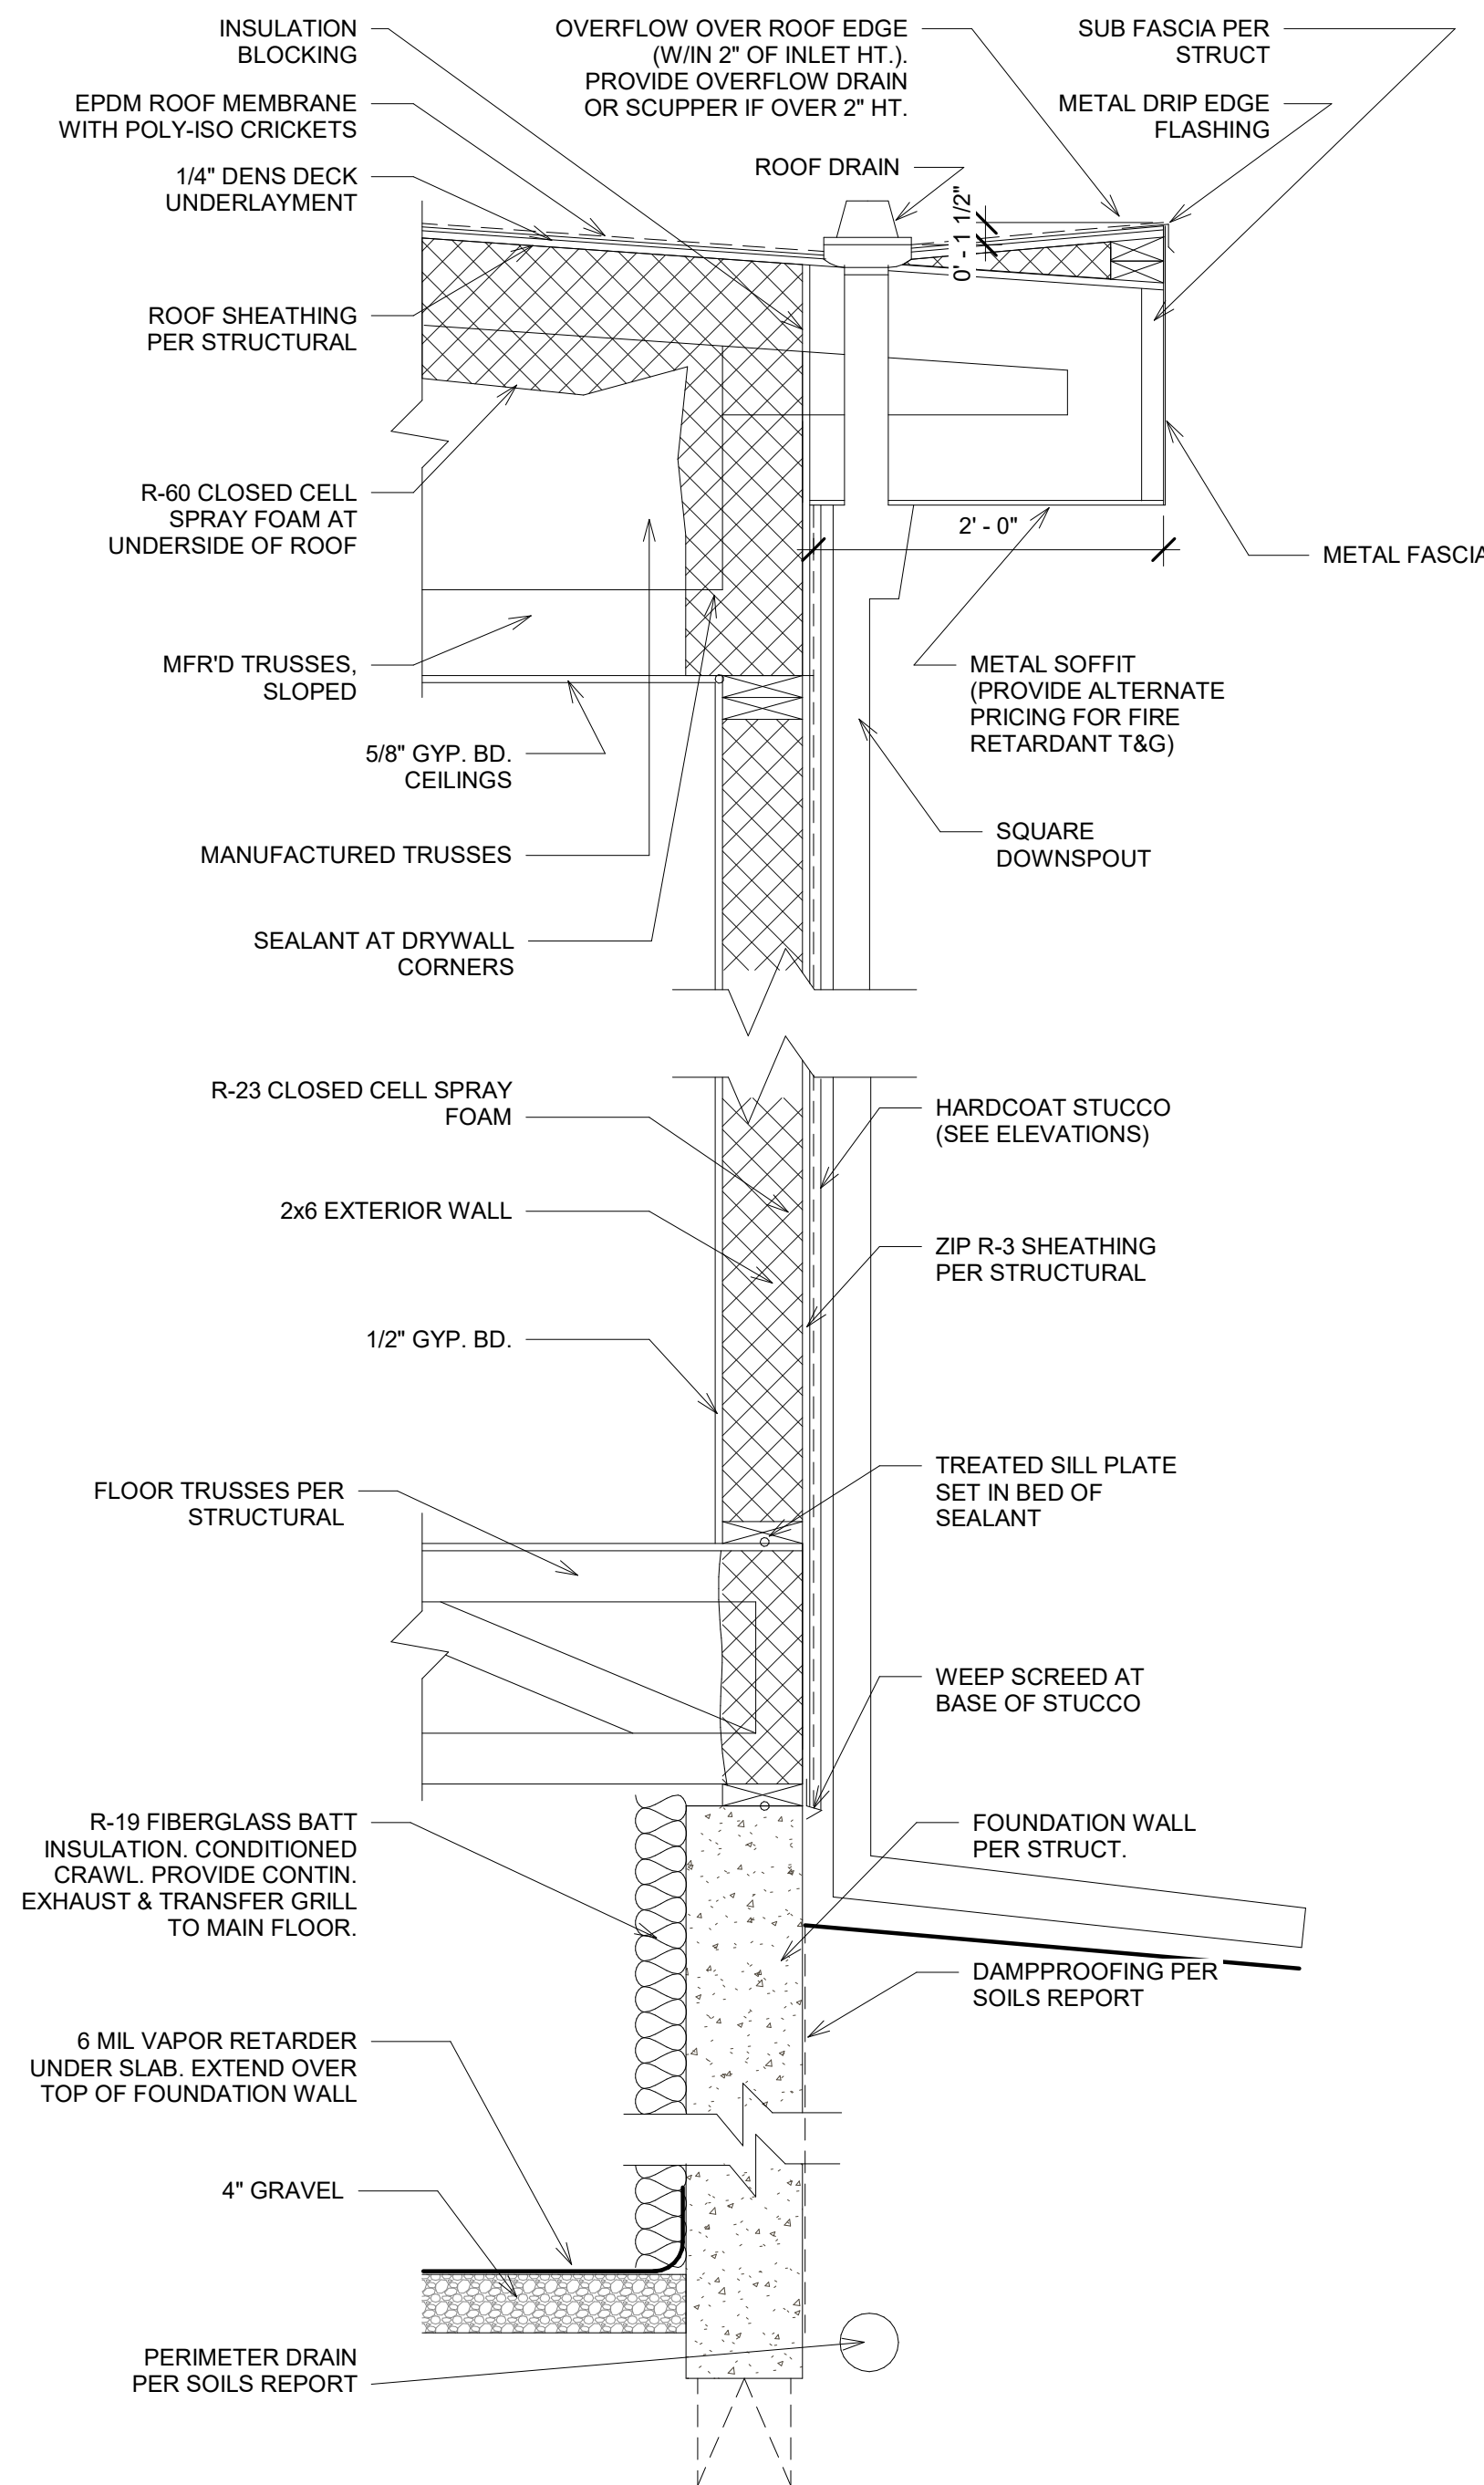


3 Typical Wall Section
1" = 1'-0"

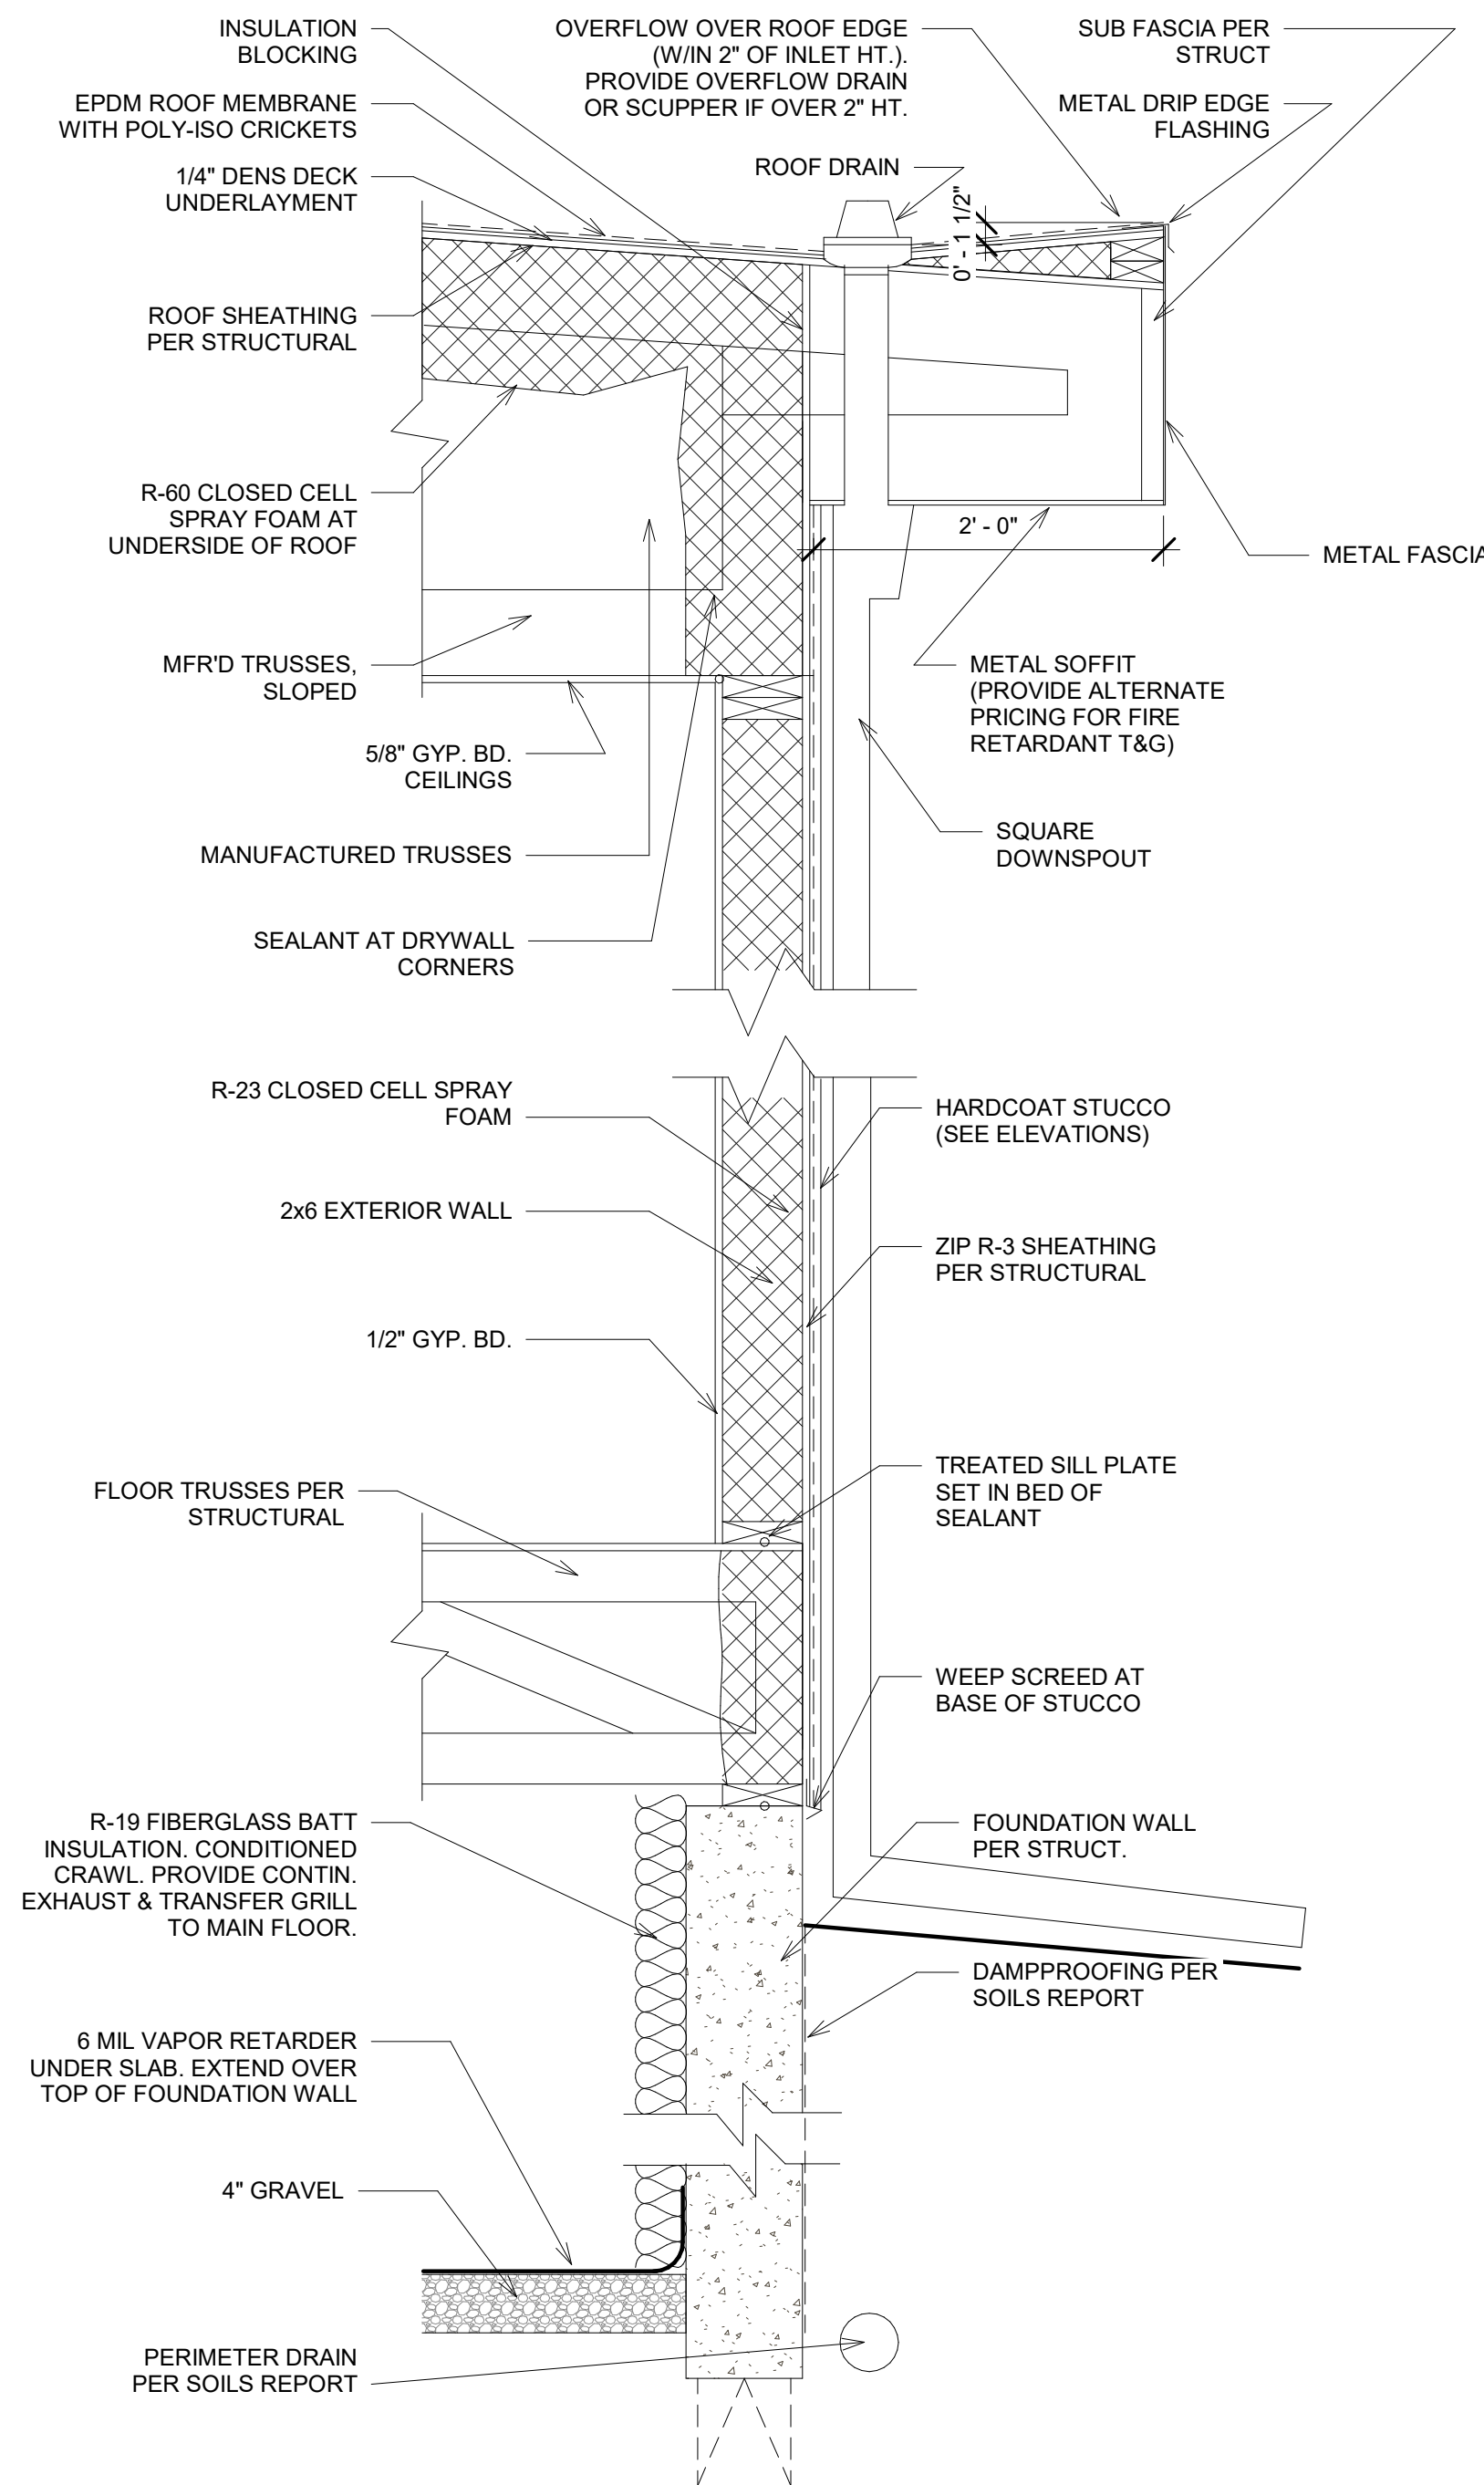


3 Typical Wall Section
1" = 1'-0"

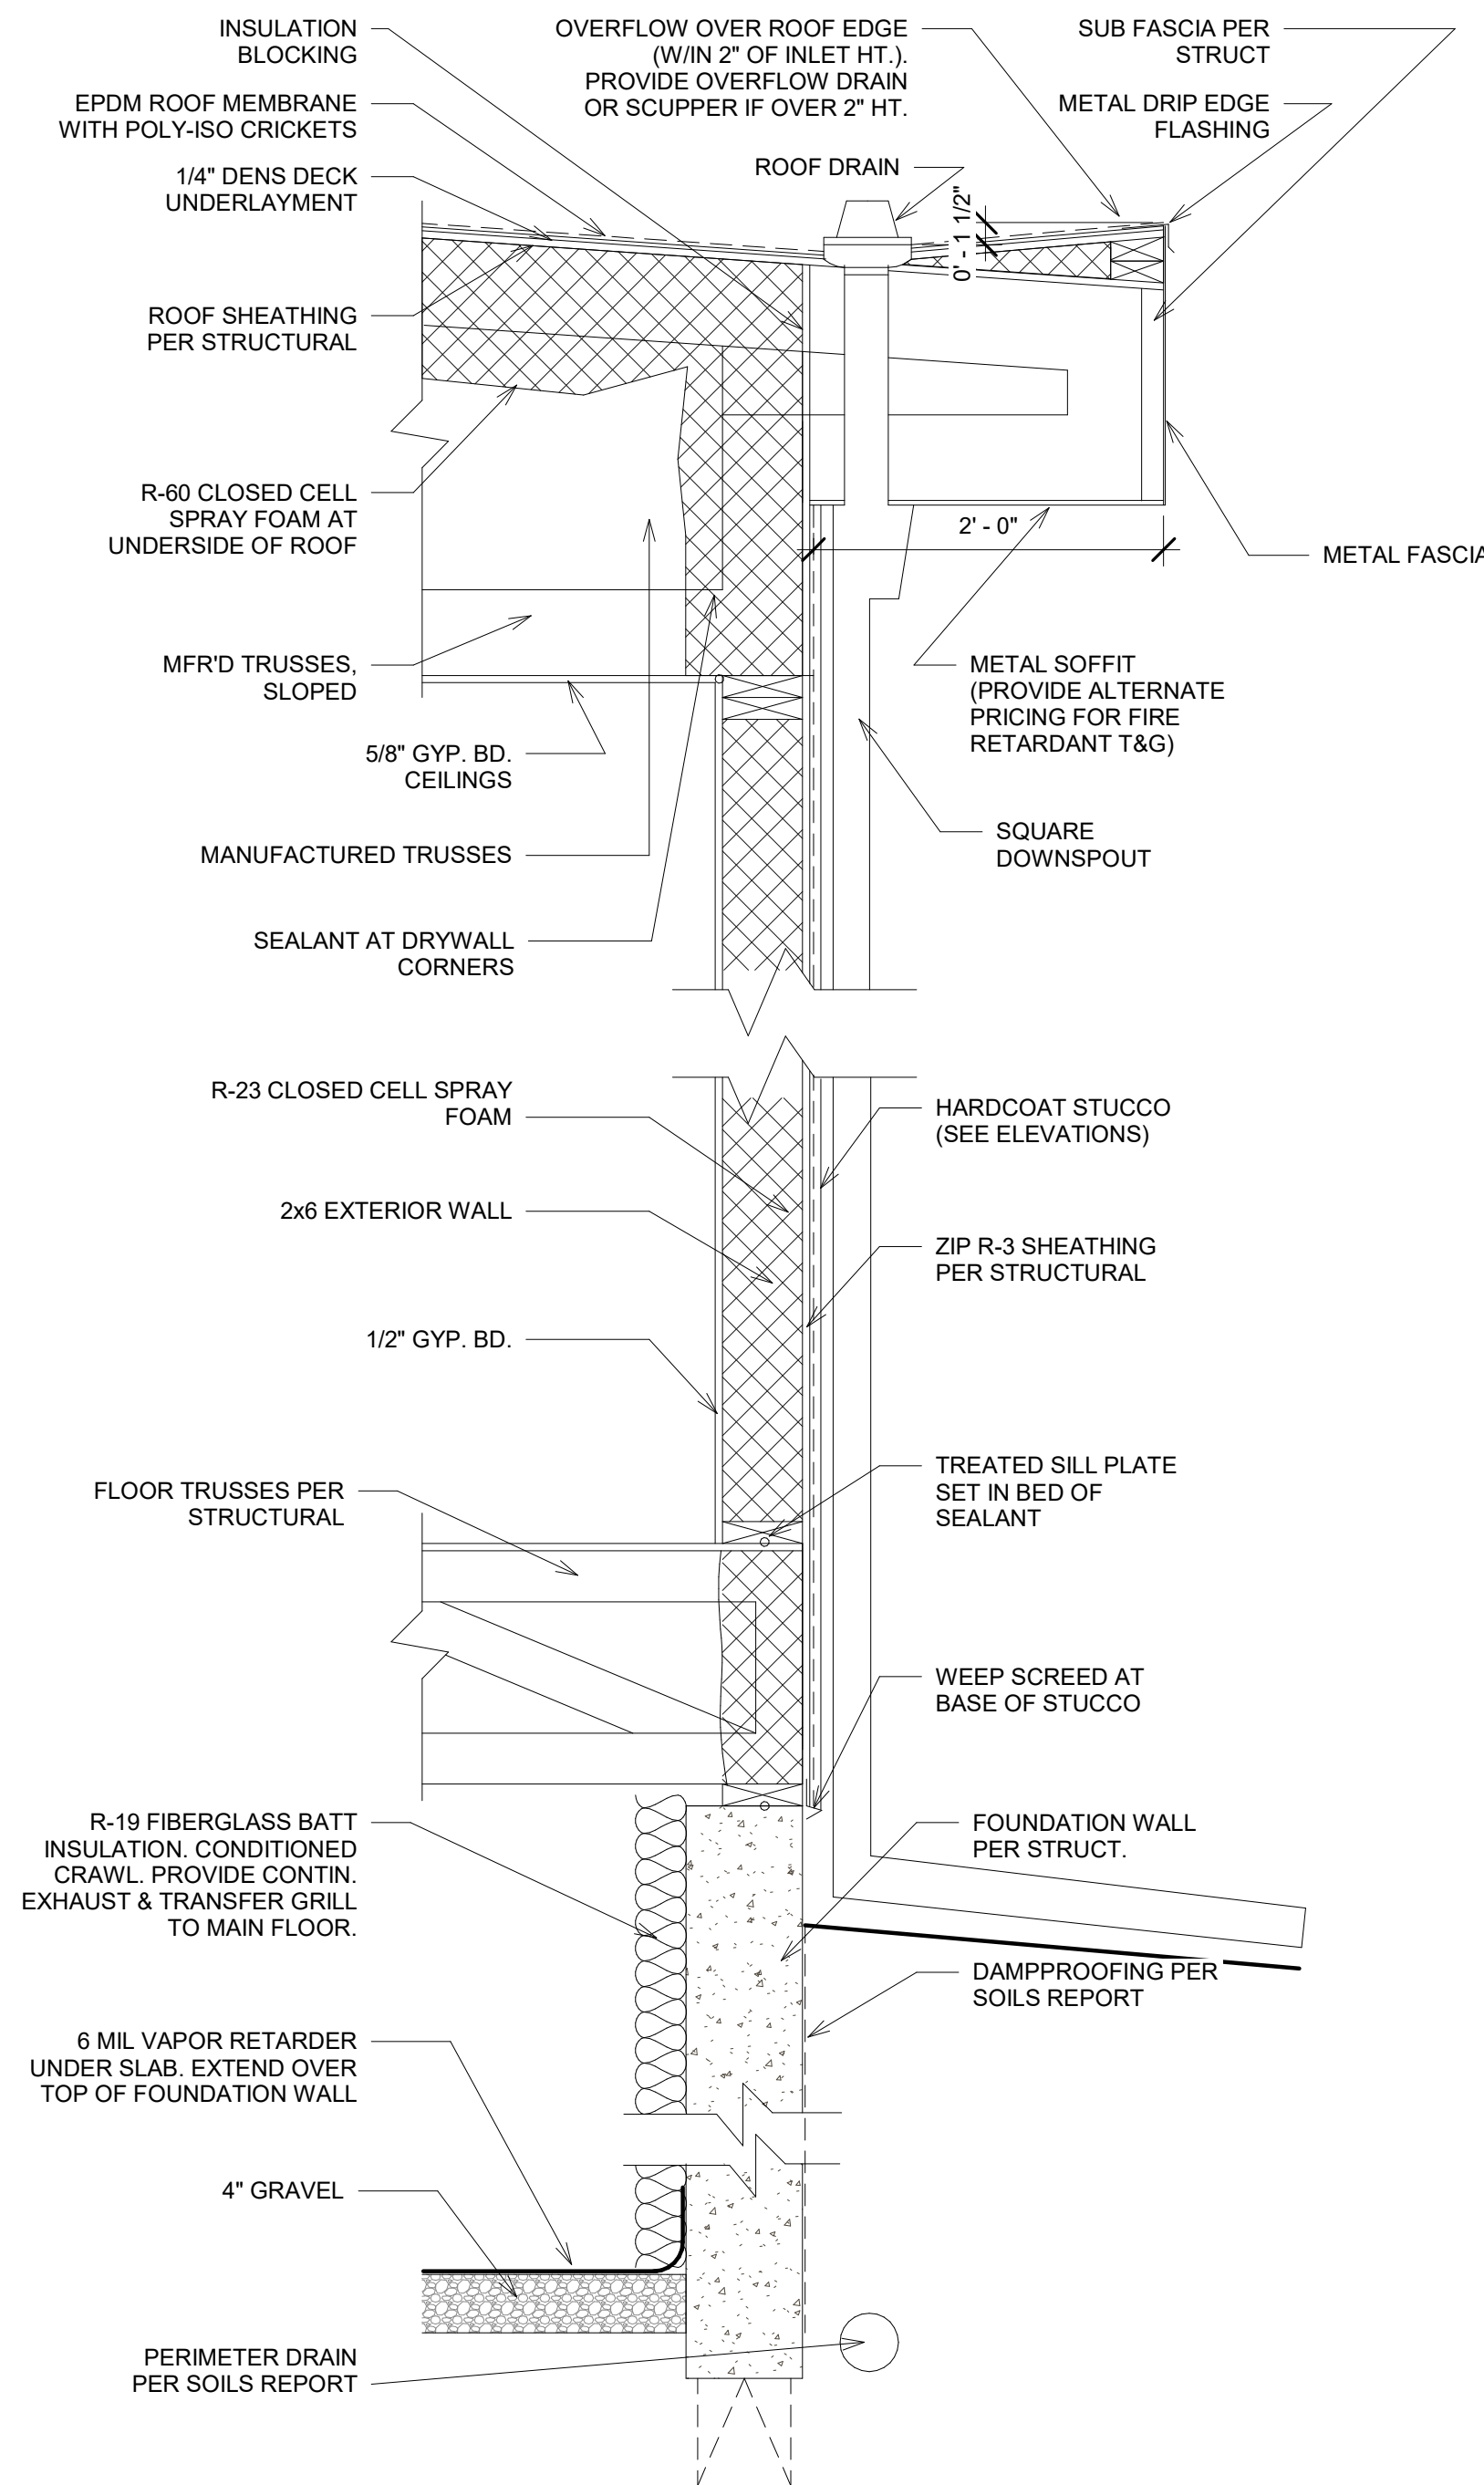


3 Typical Wall Section
1" = 1'-0"

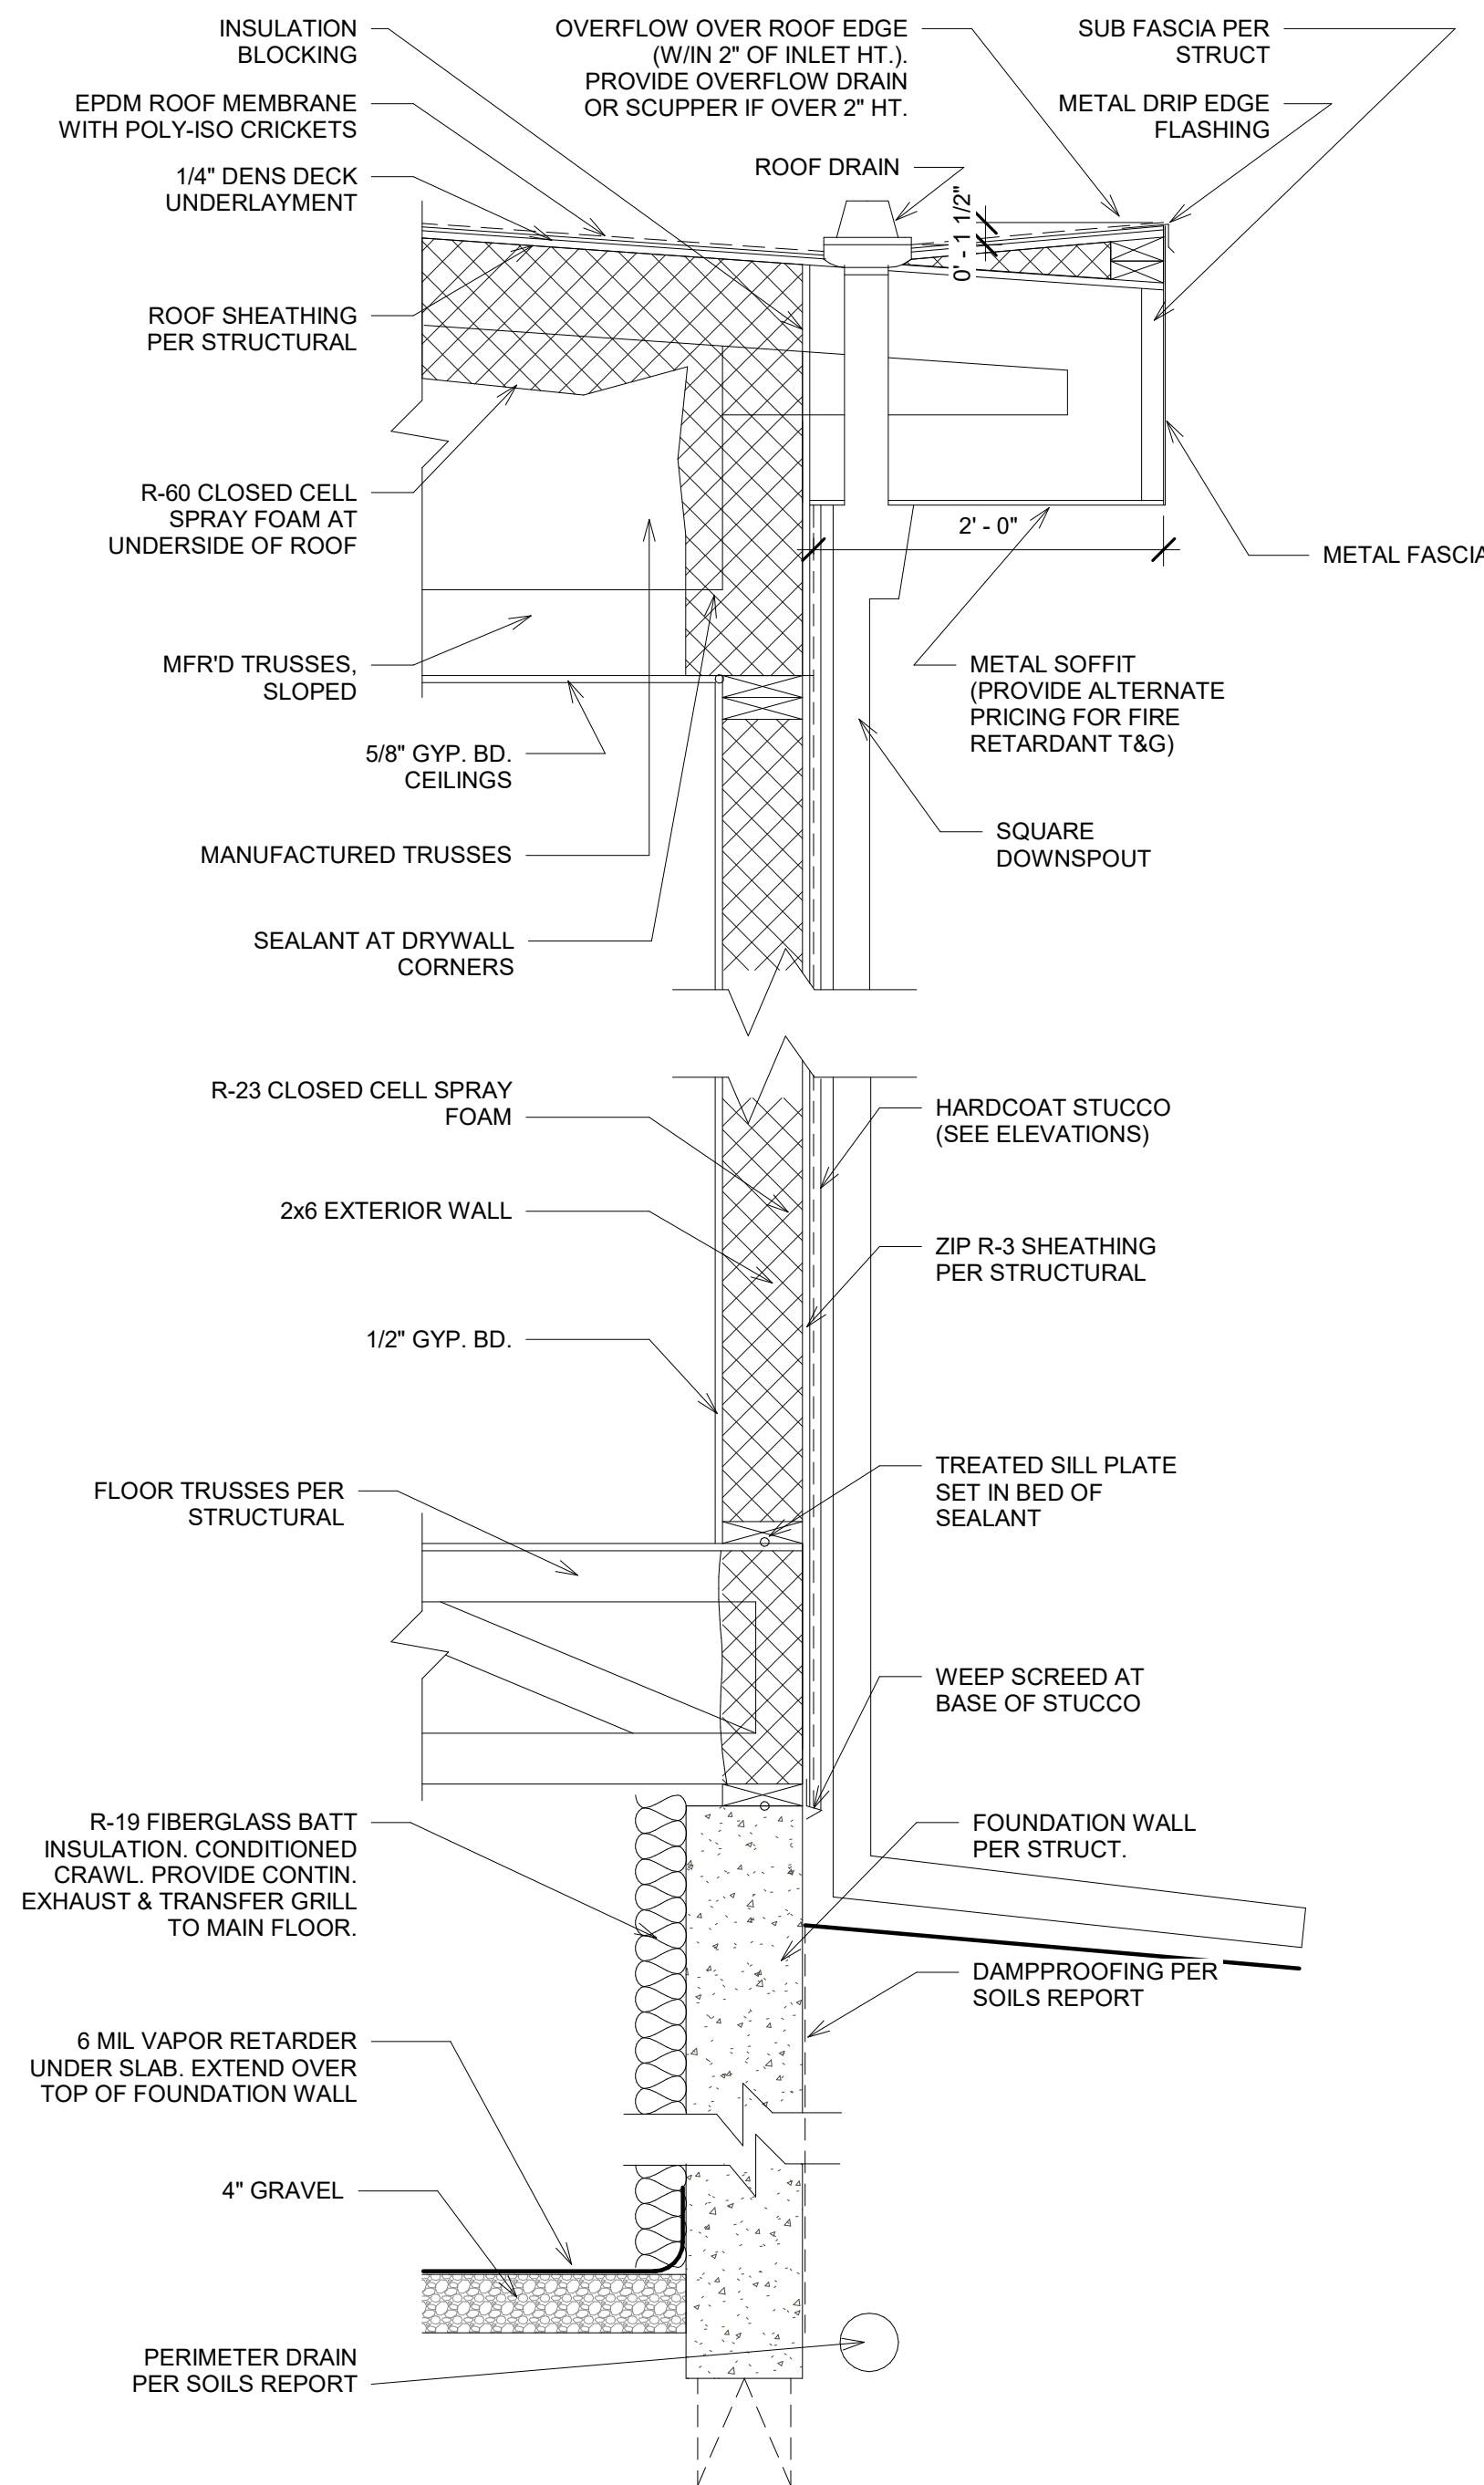


3 Typical Wall Section
1" = 1'-0"

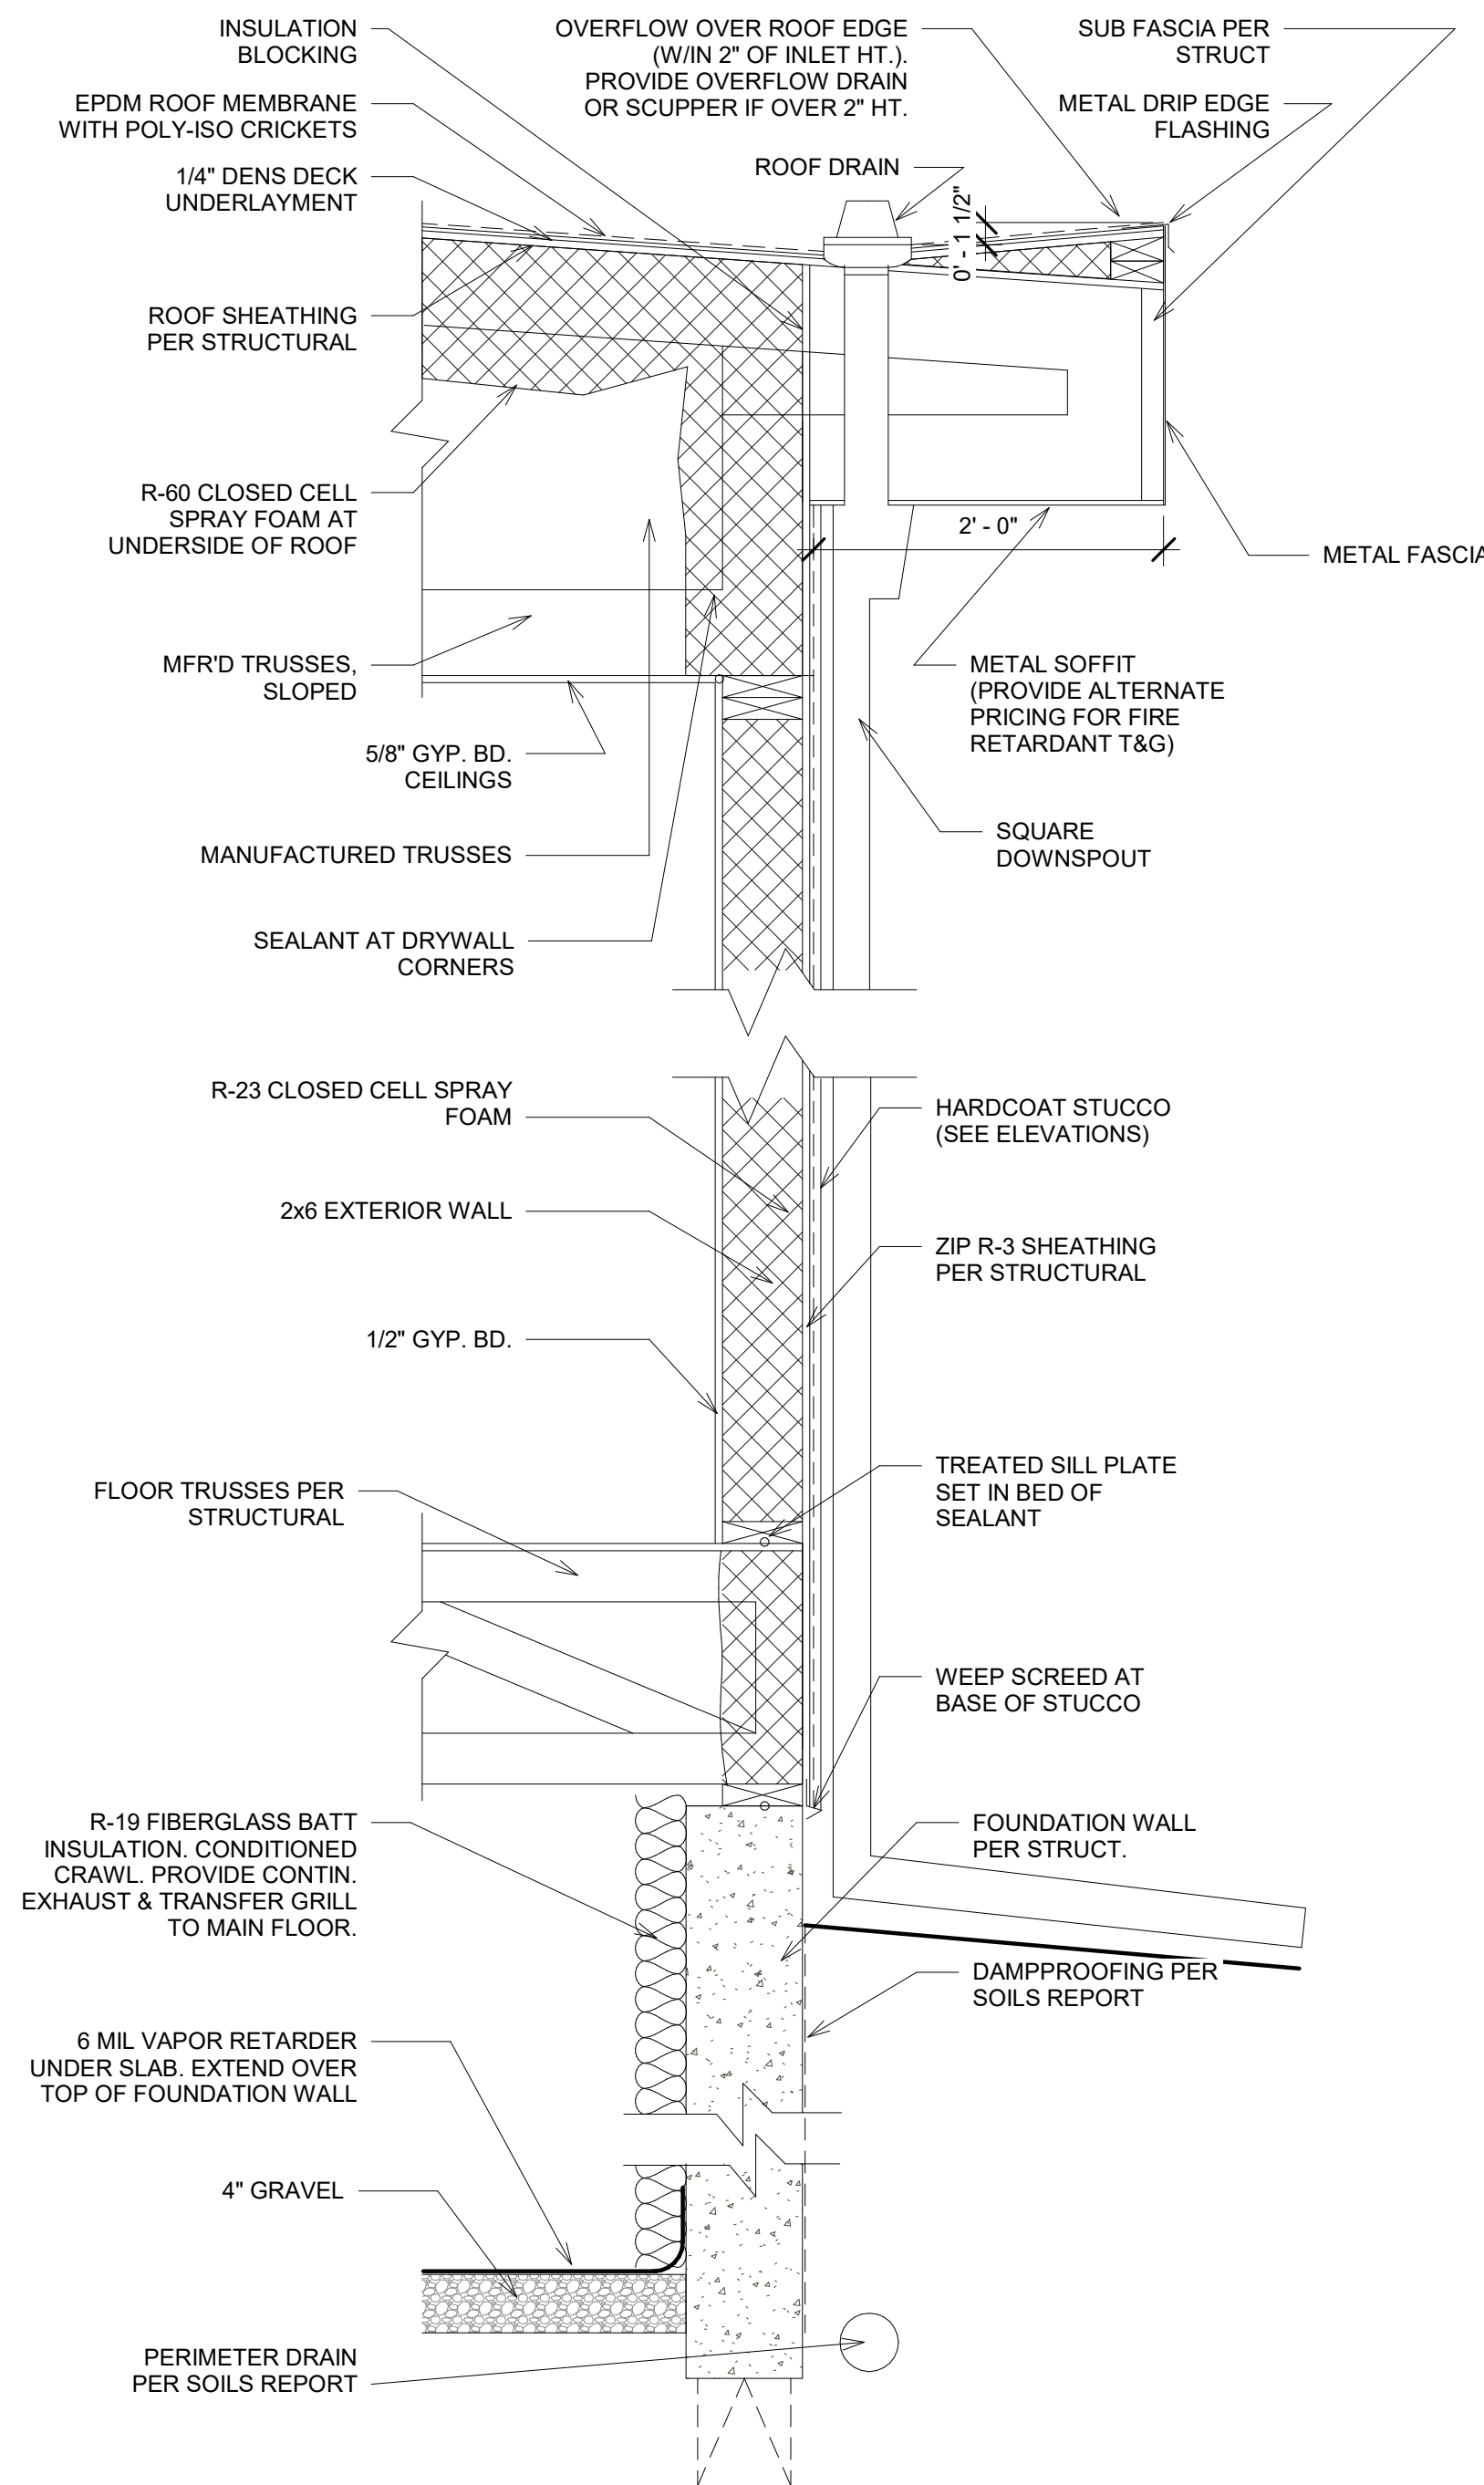


3 Typical Wall Section
1" = 1'-0"

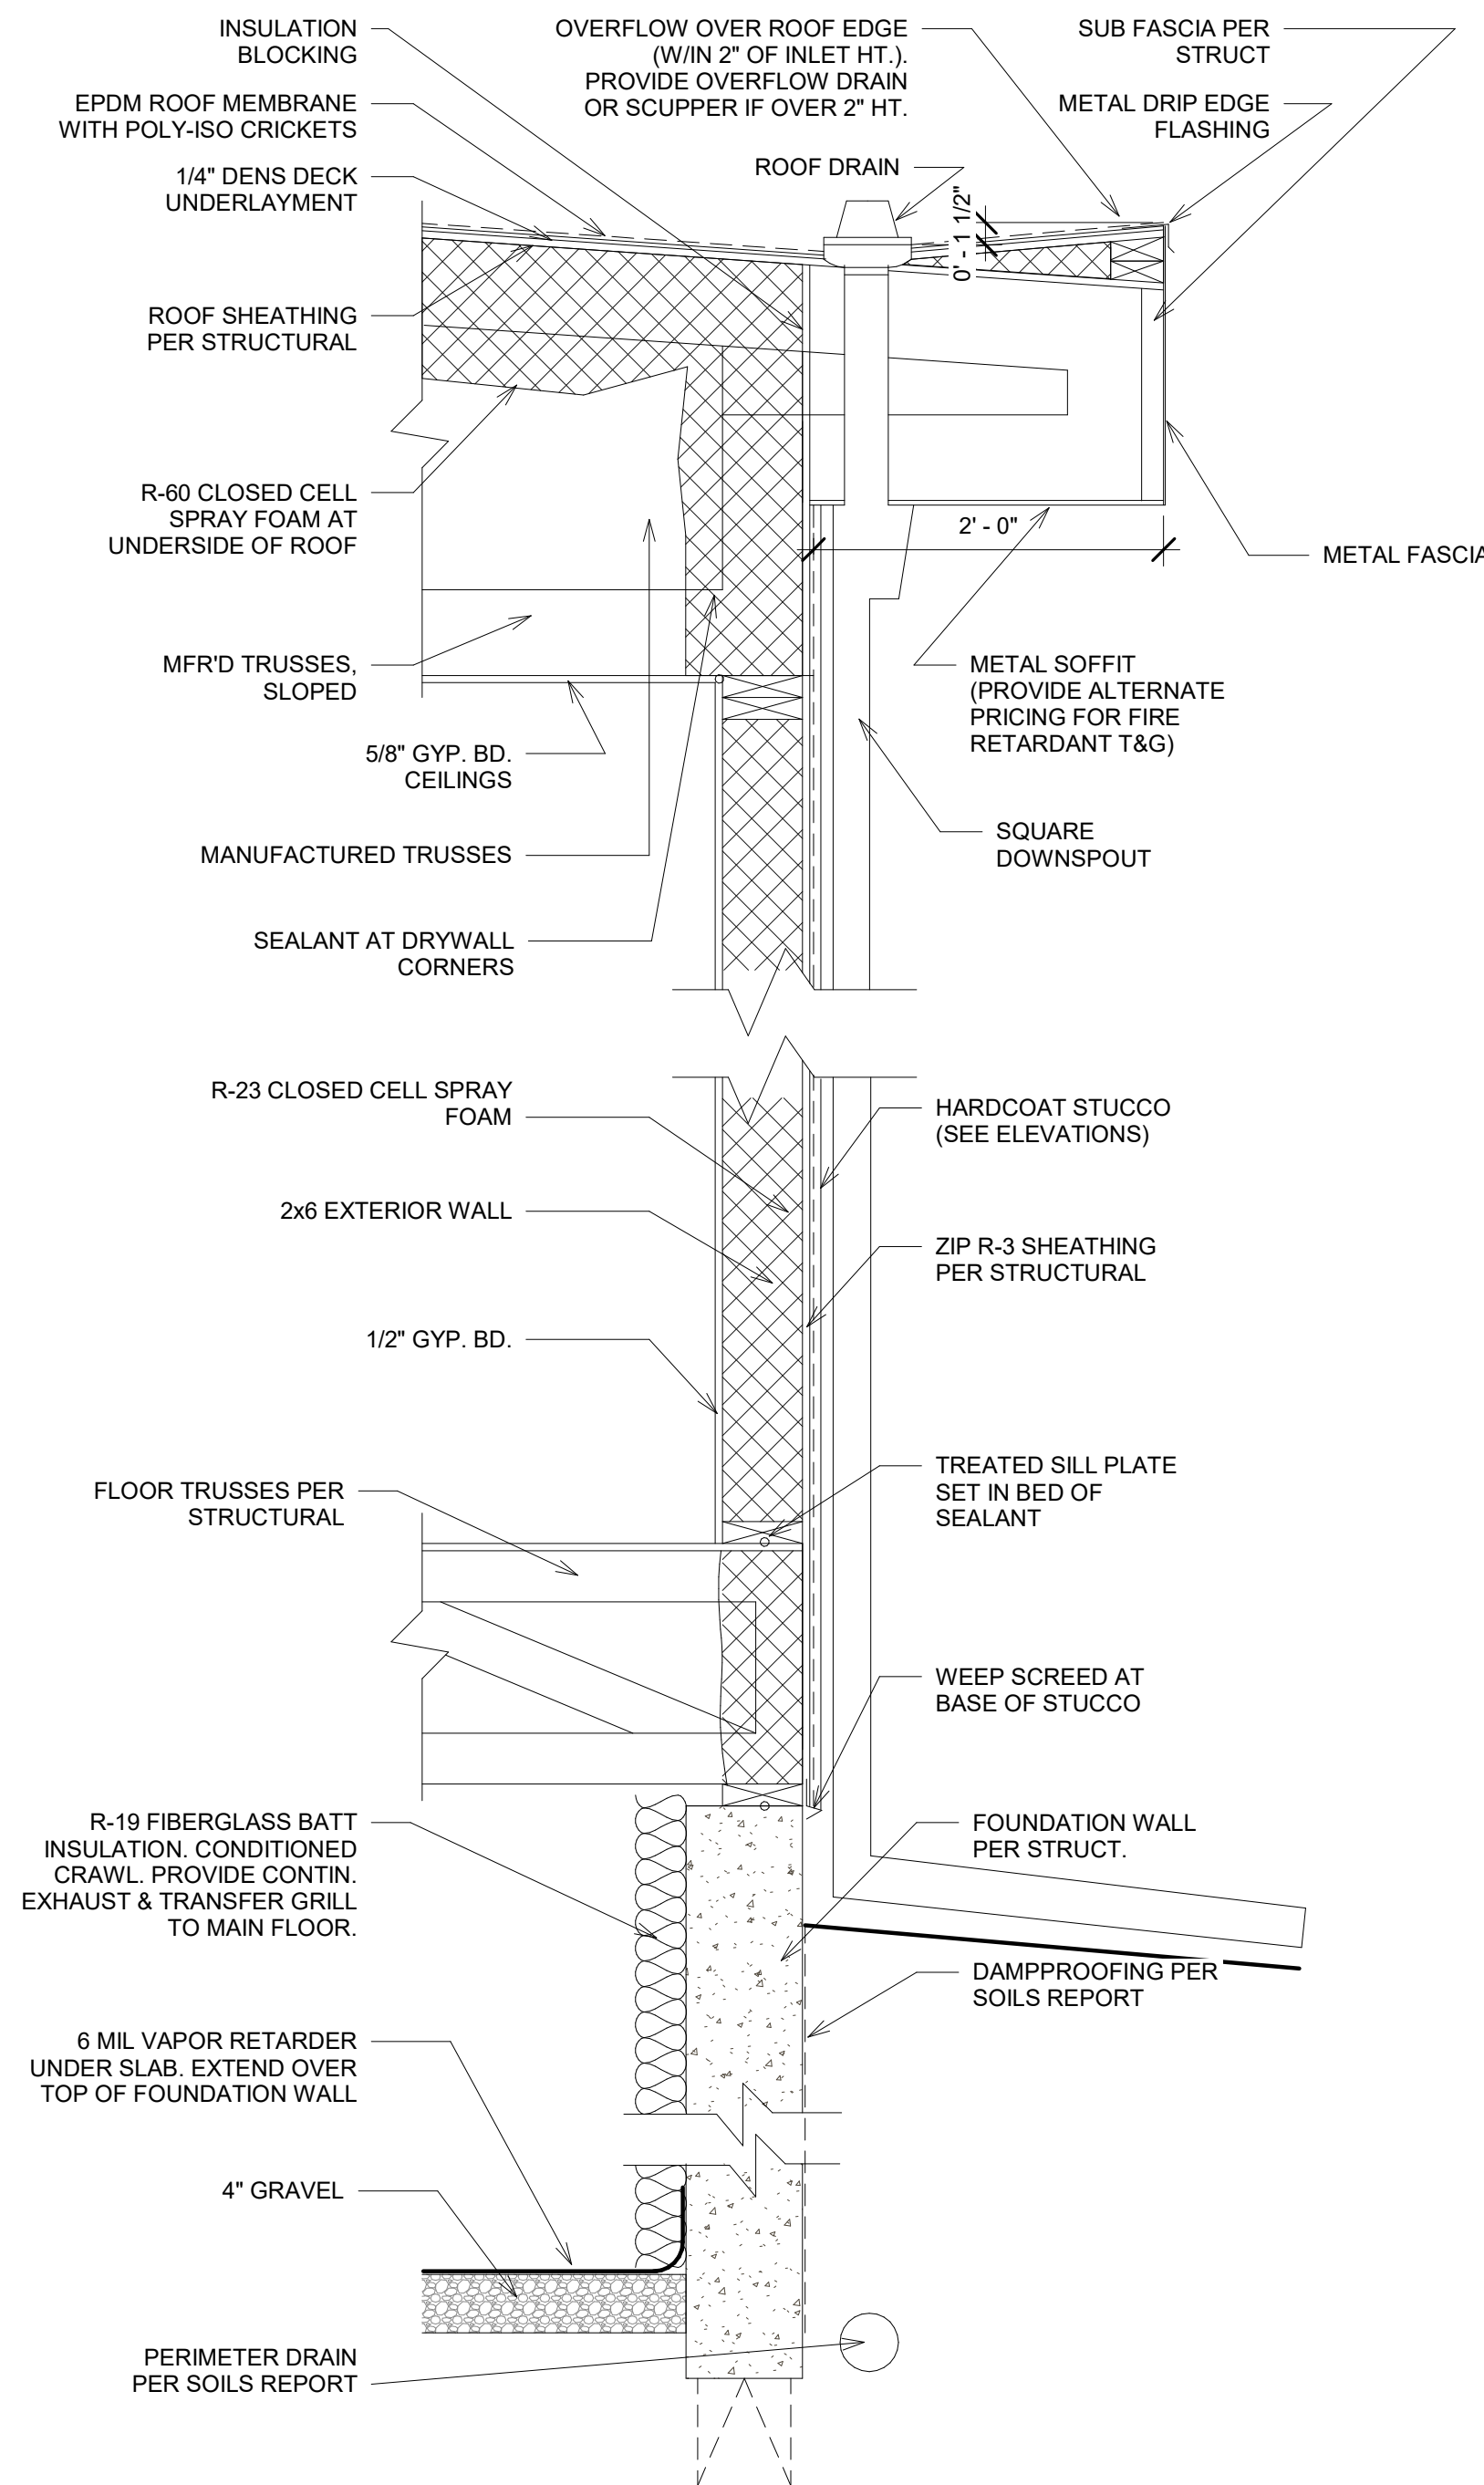


3 Typical Wall Section
1" = 1'-0"

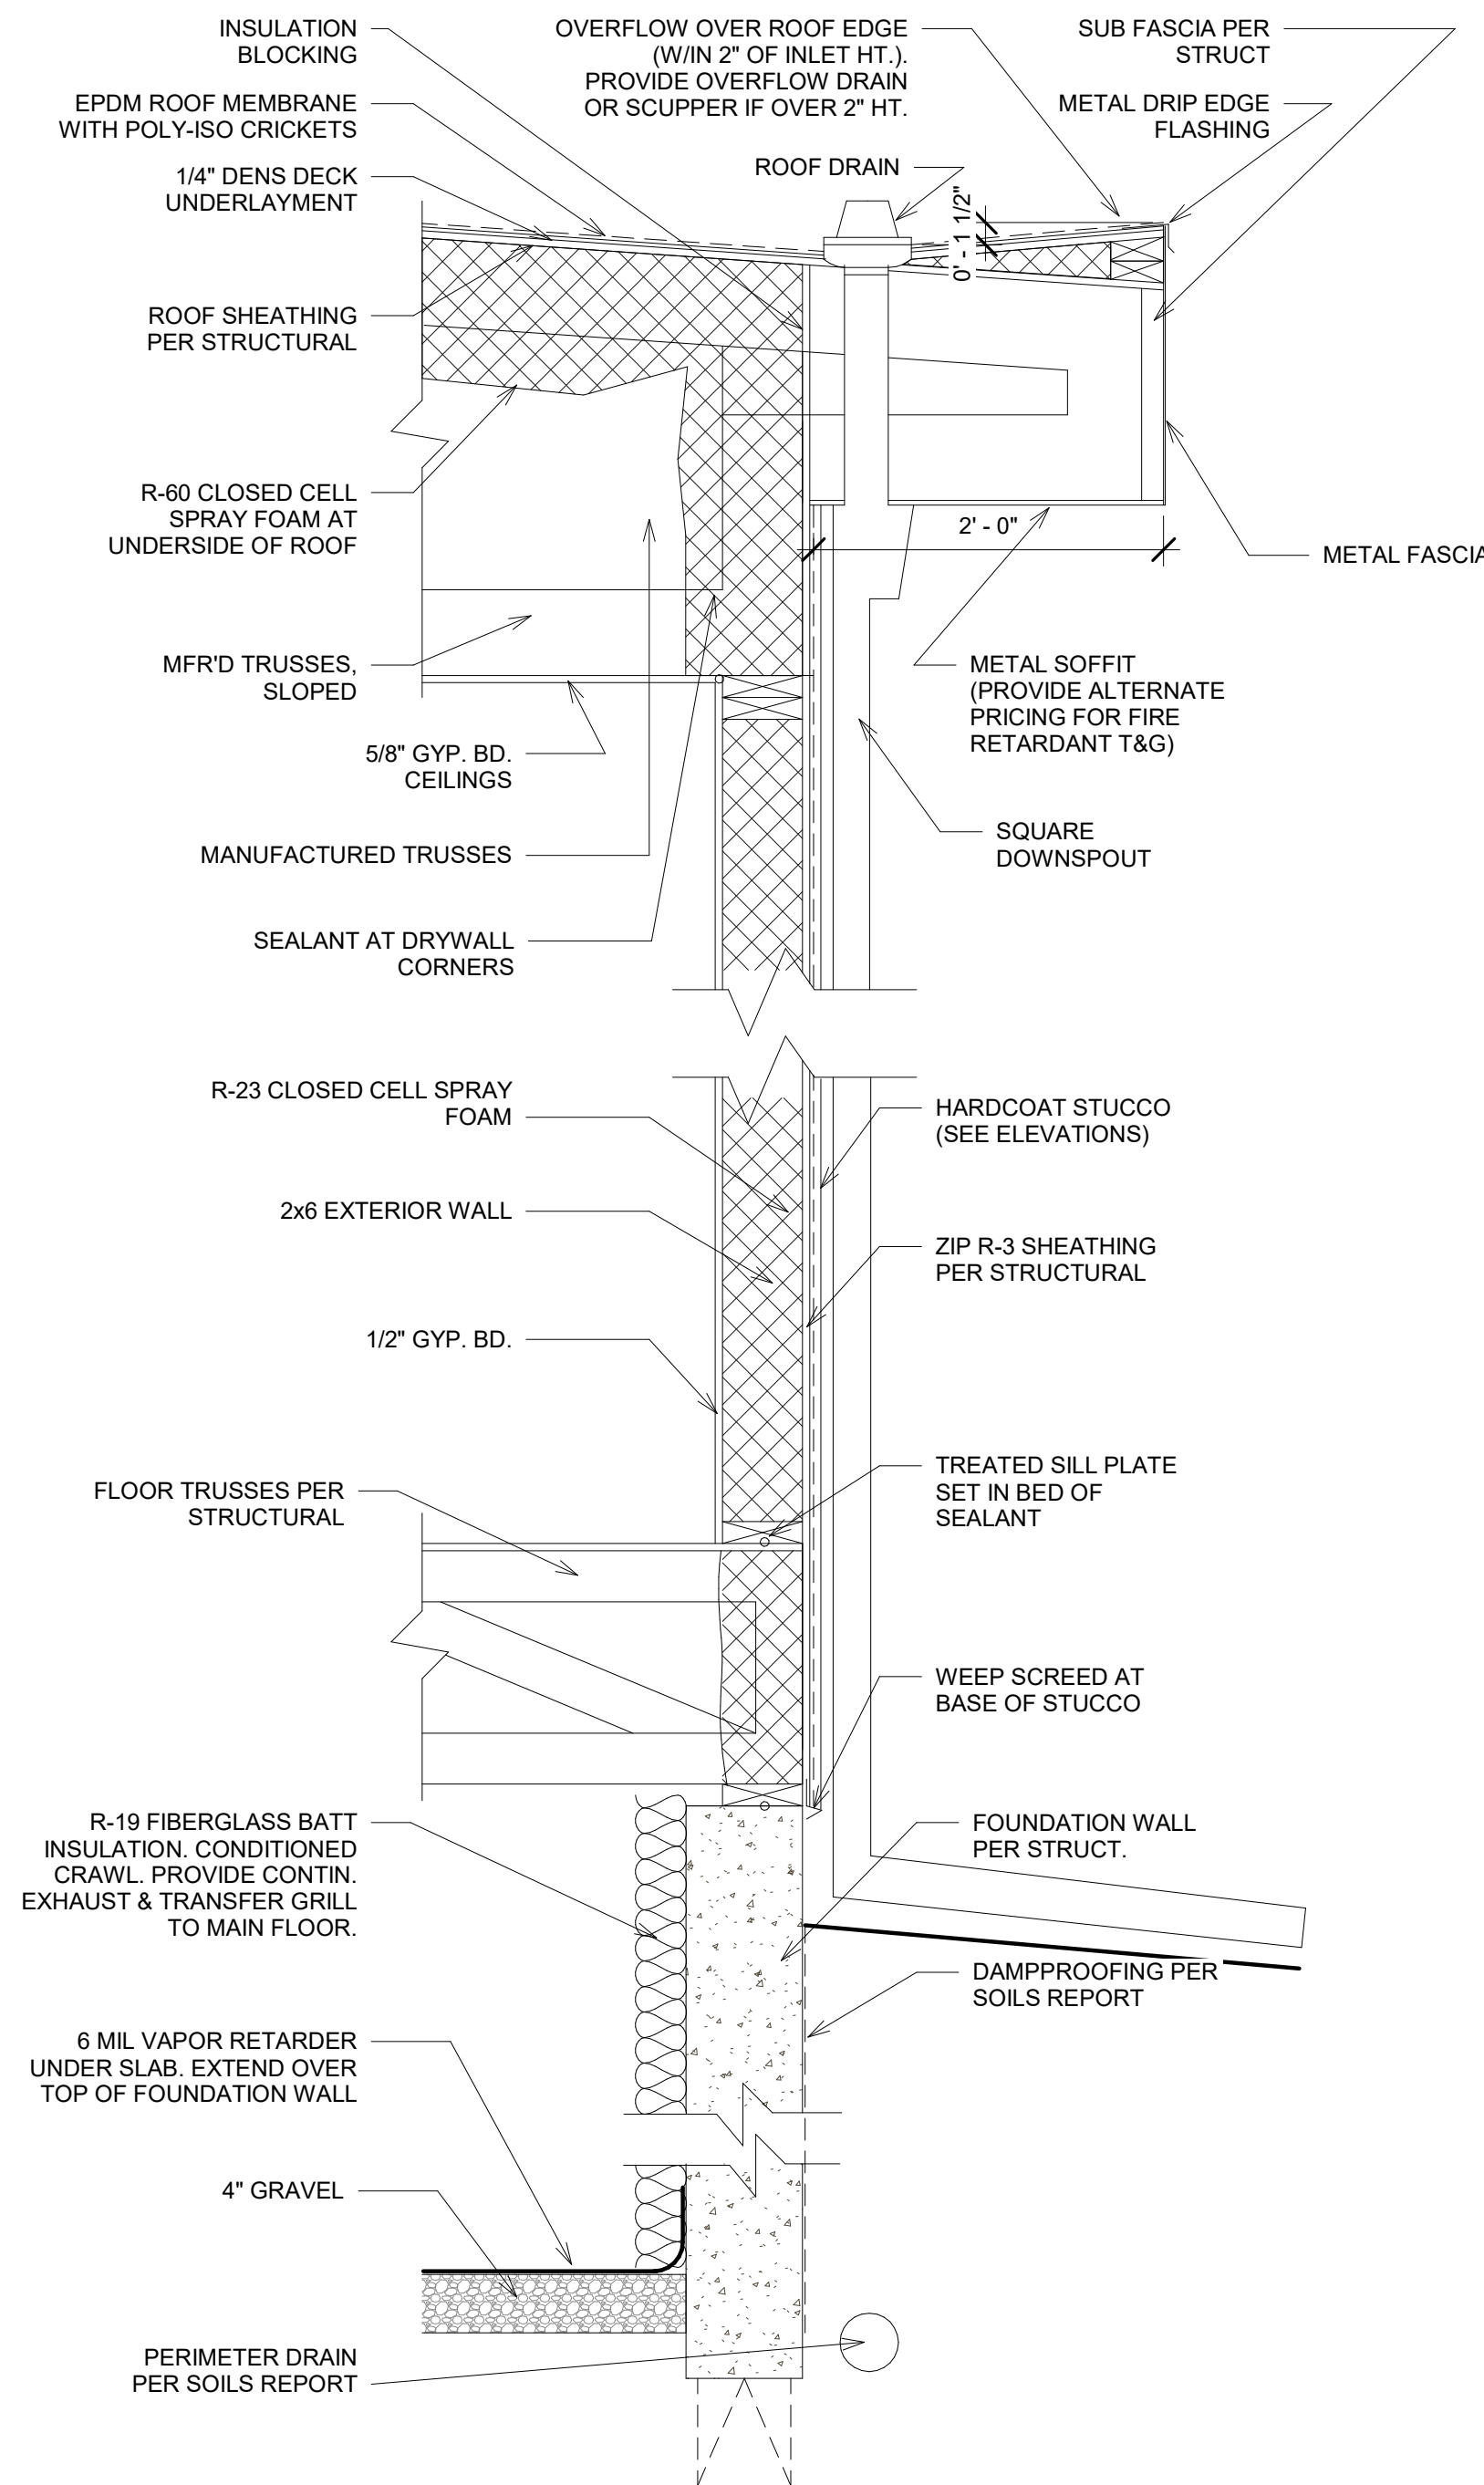


3 Typical Wall Section
1" = 1'-0"

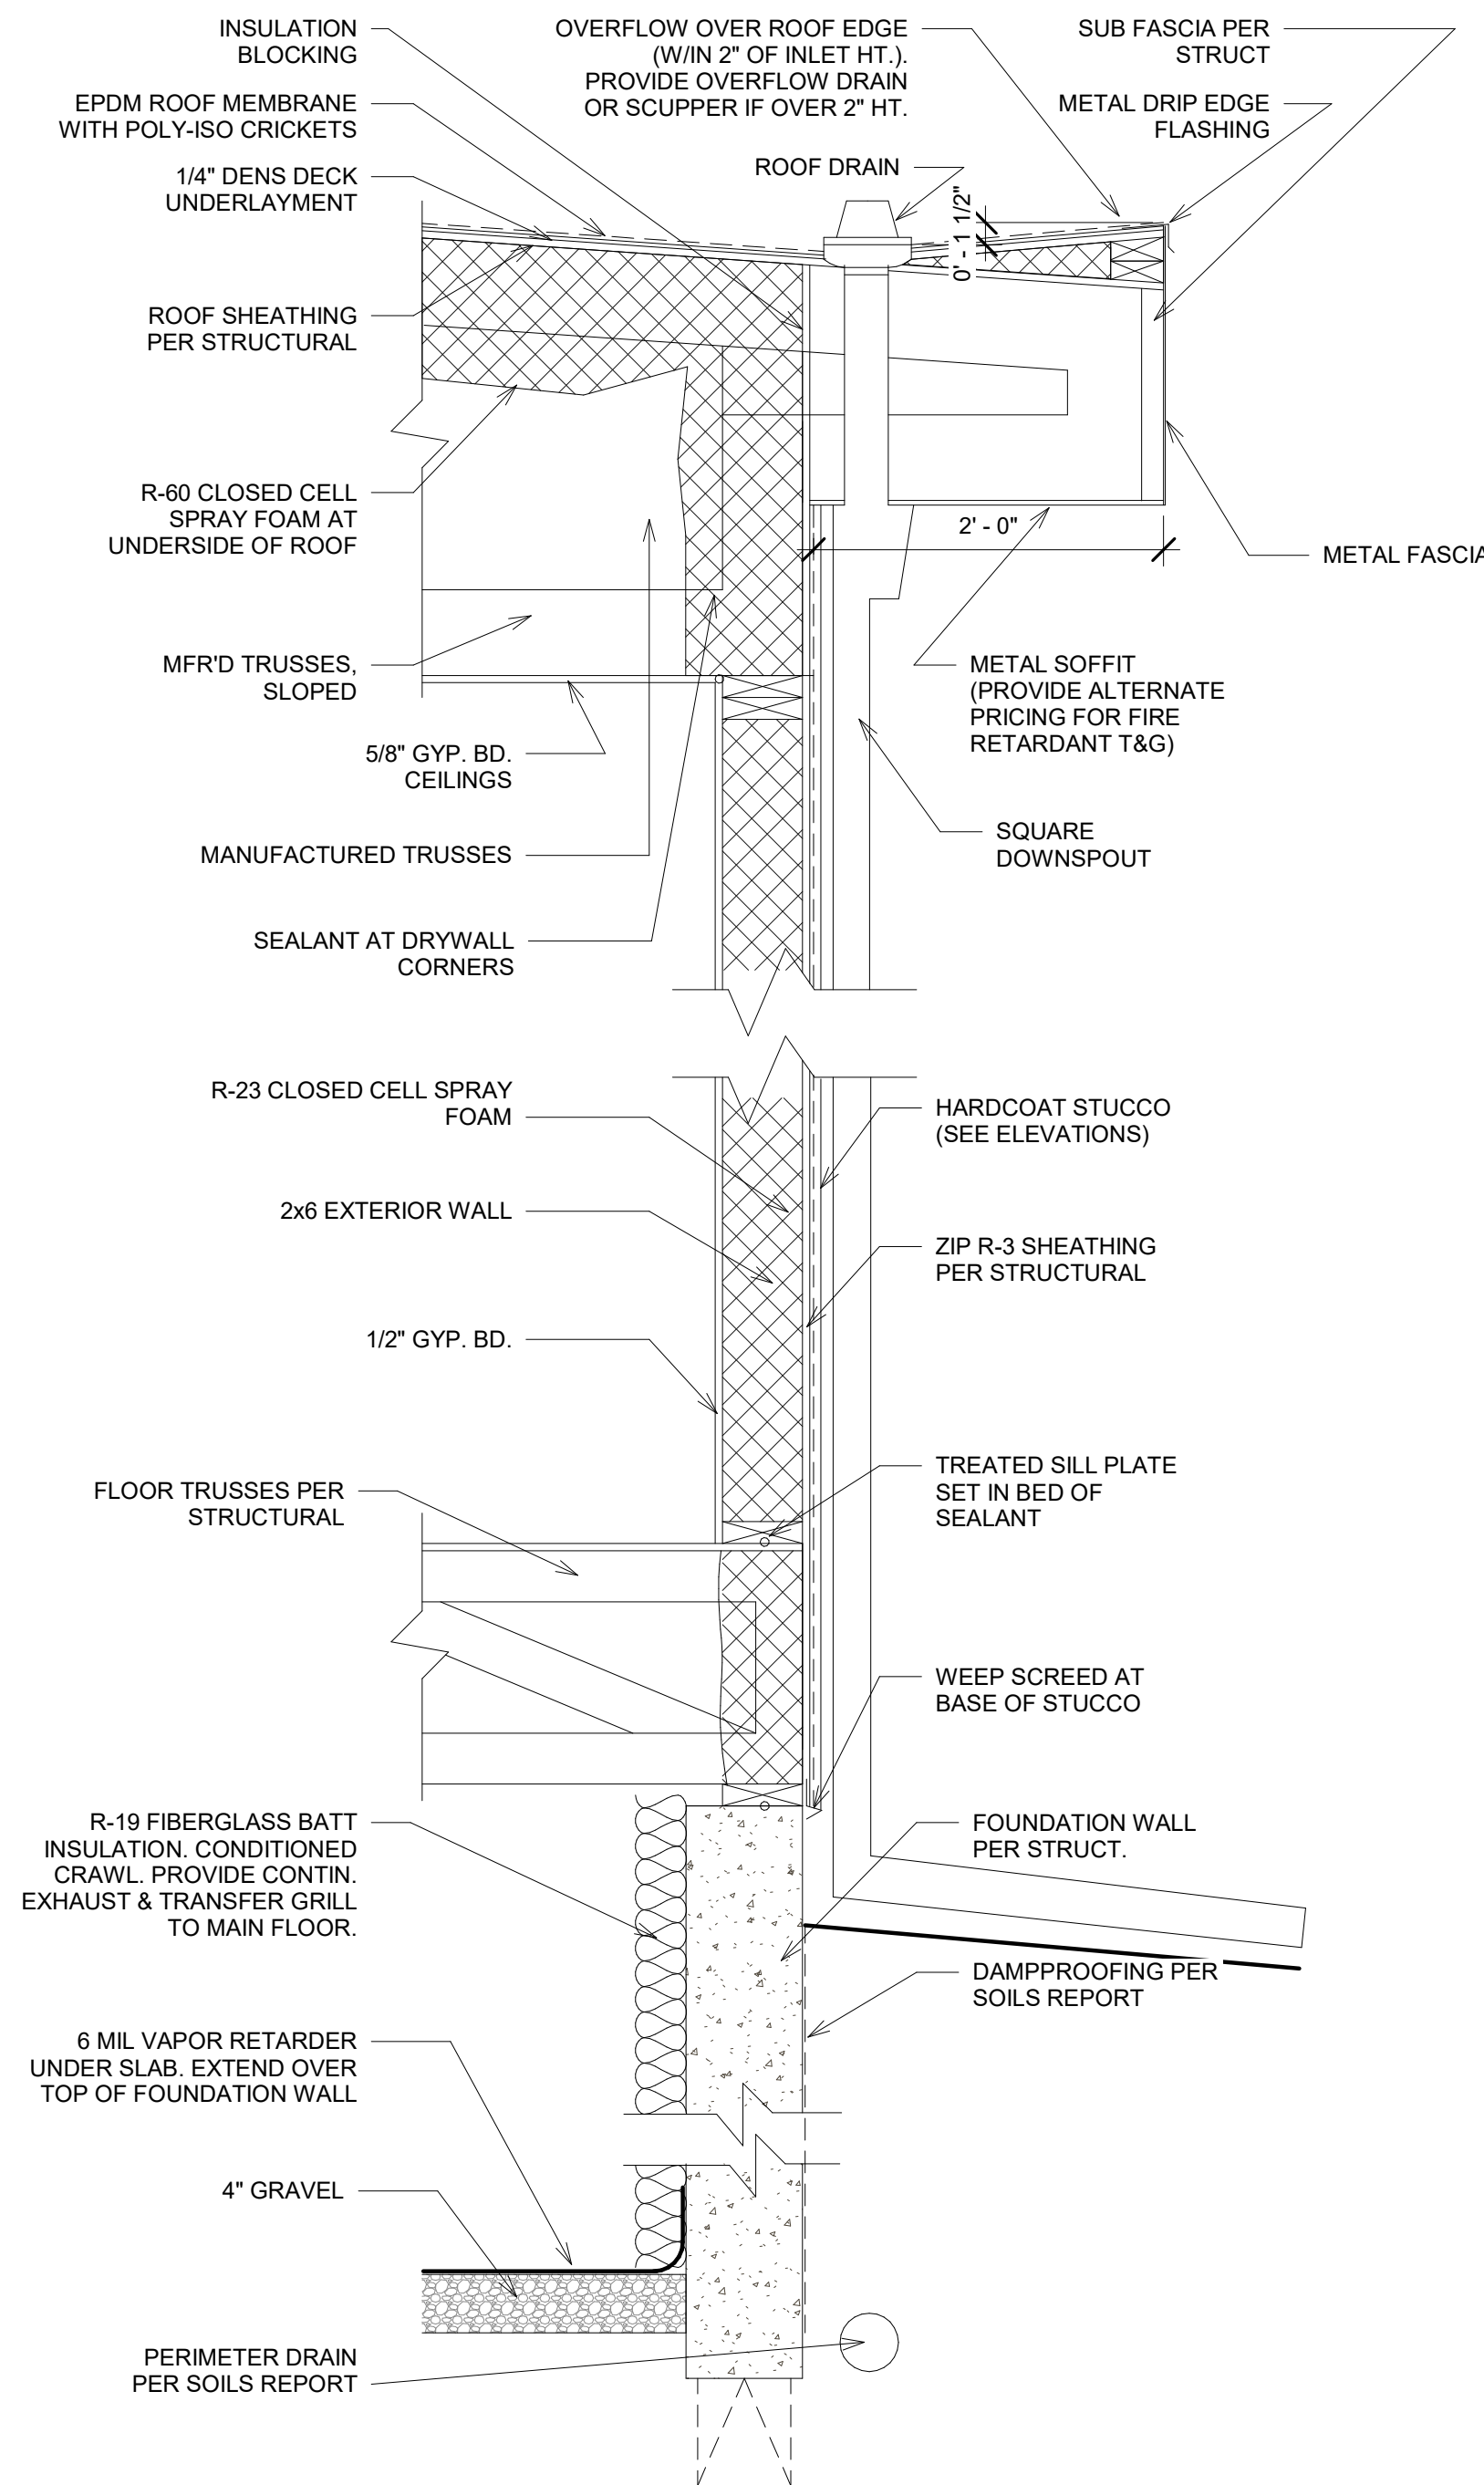


3 Typical Wall Section
1" = 1'-0"

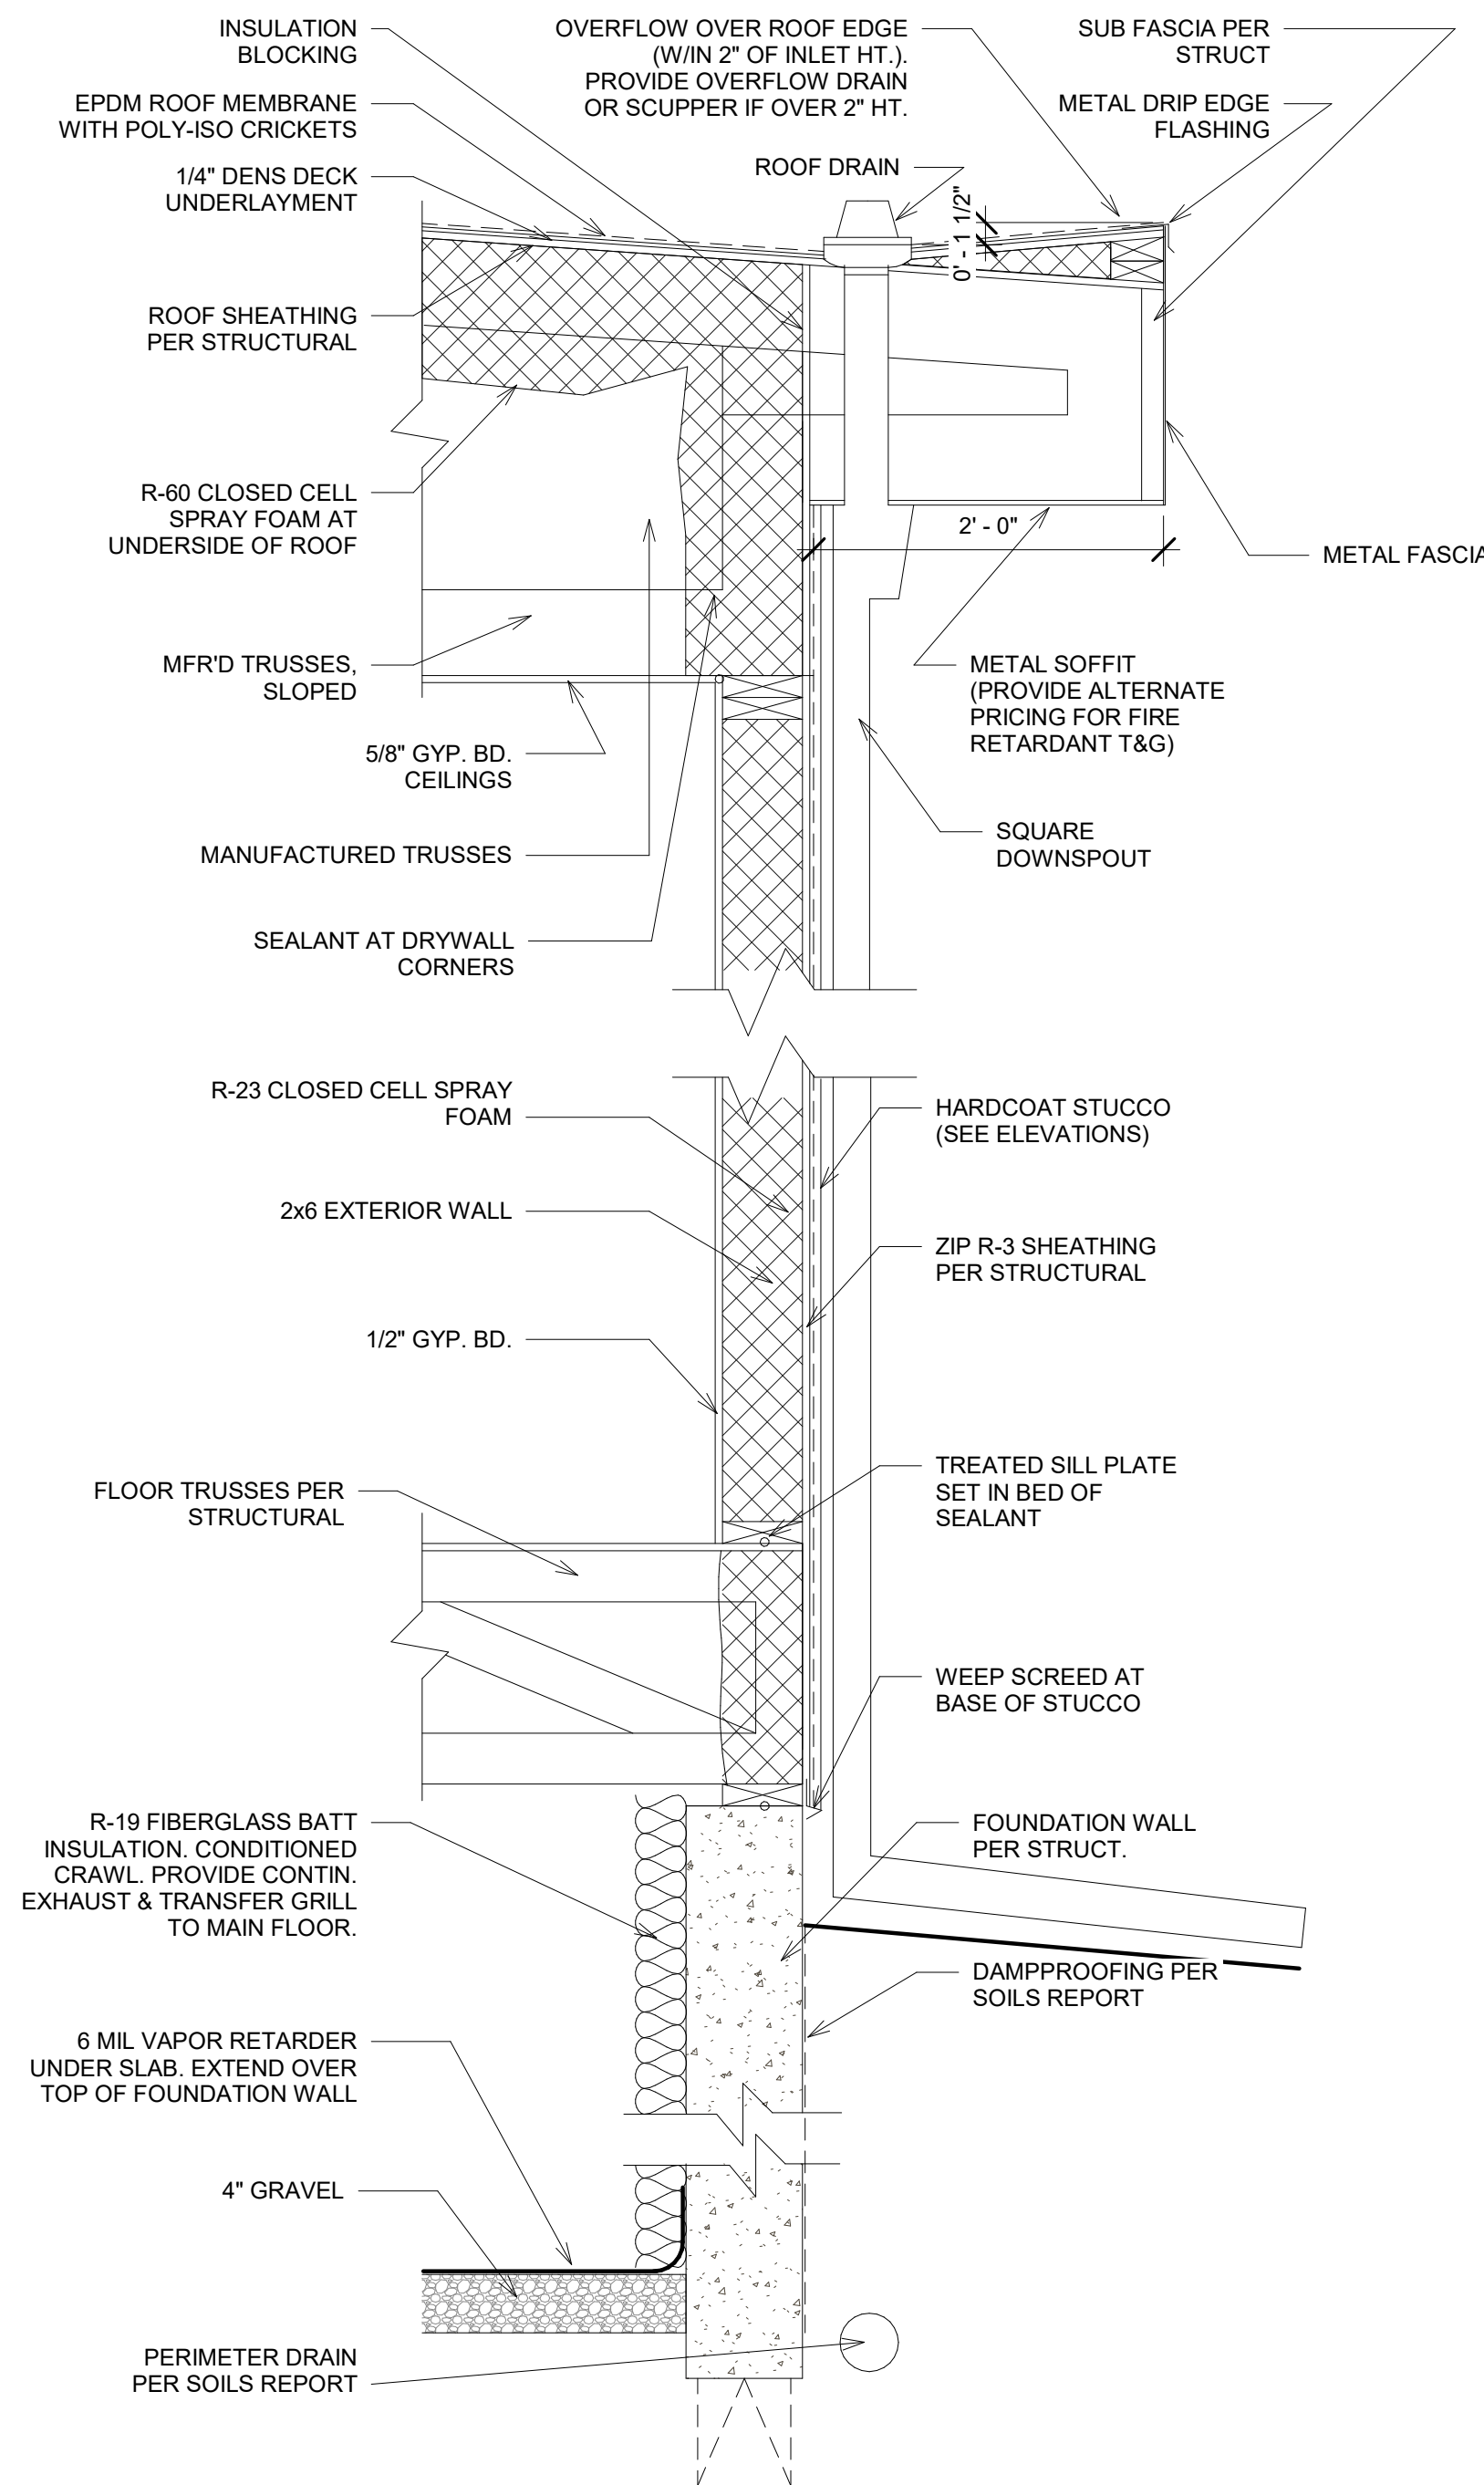


3 Typical Wall Section
1" = 1'-0"

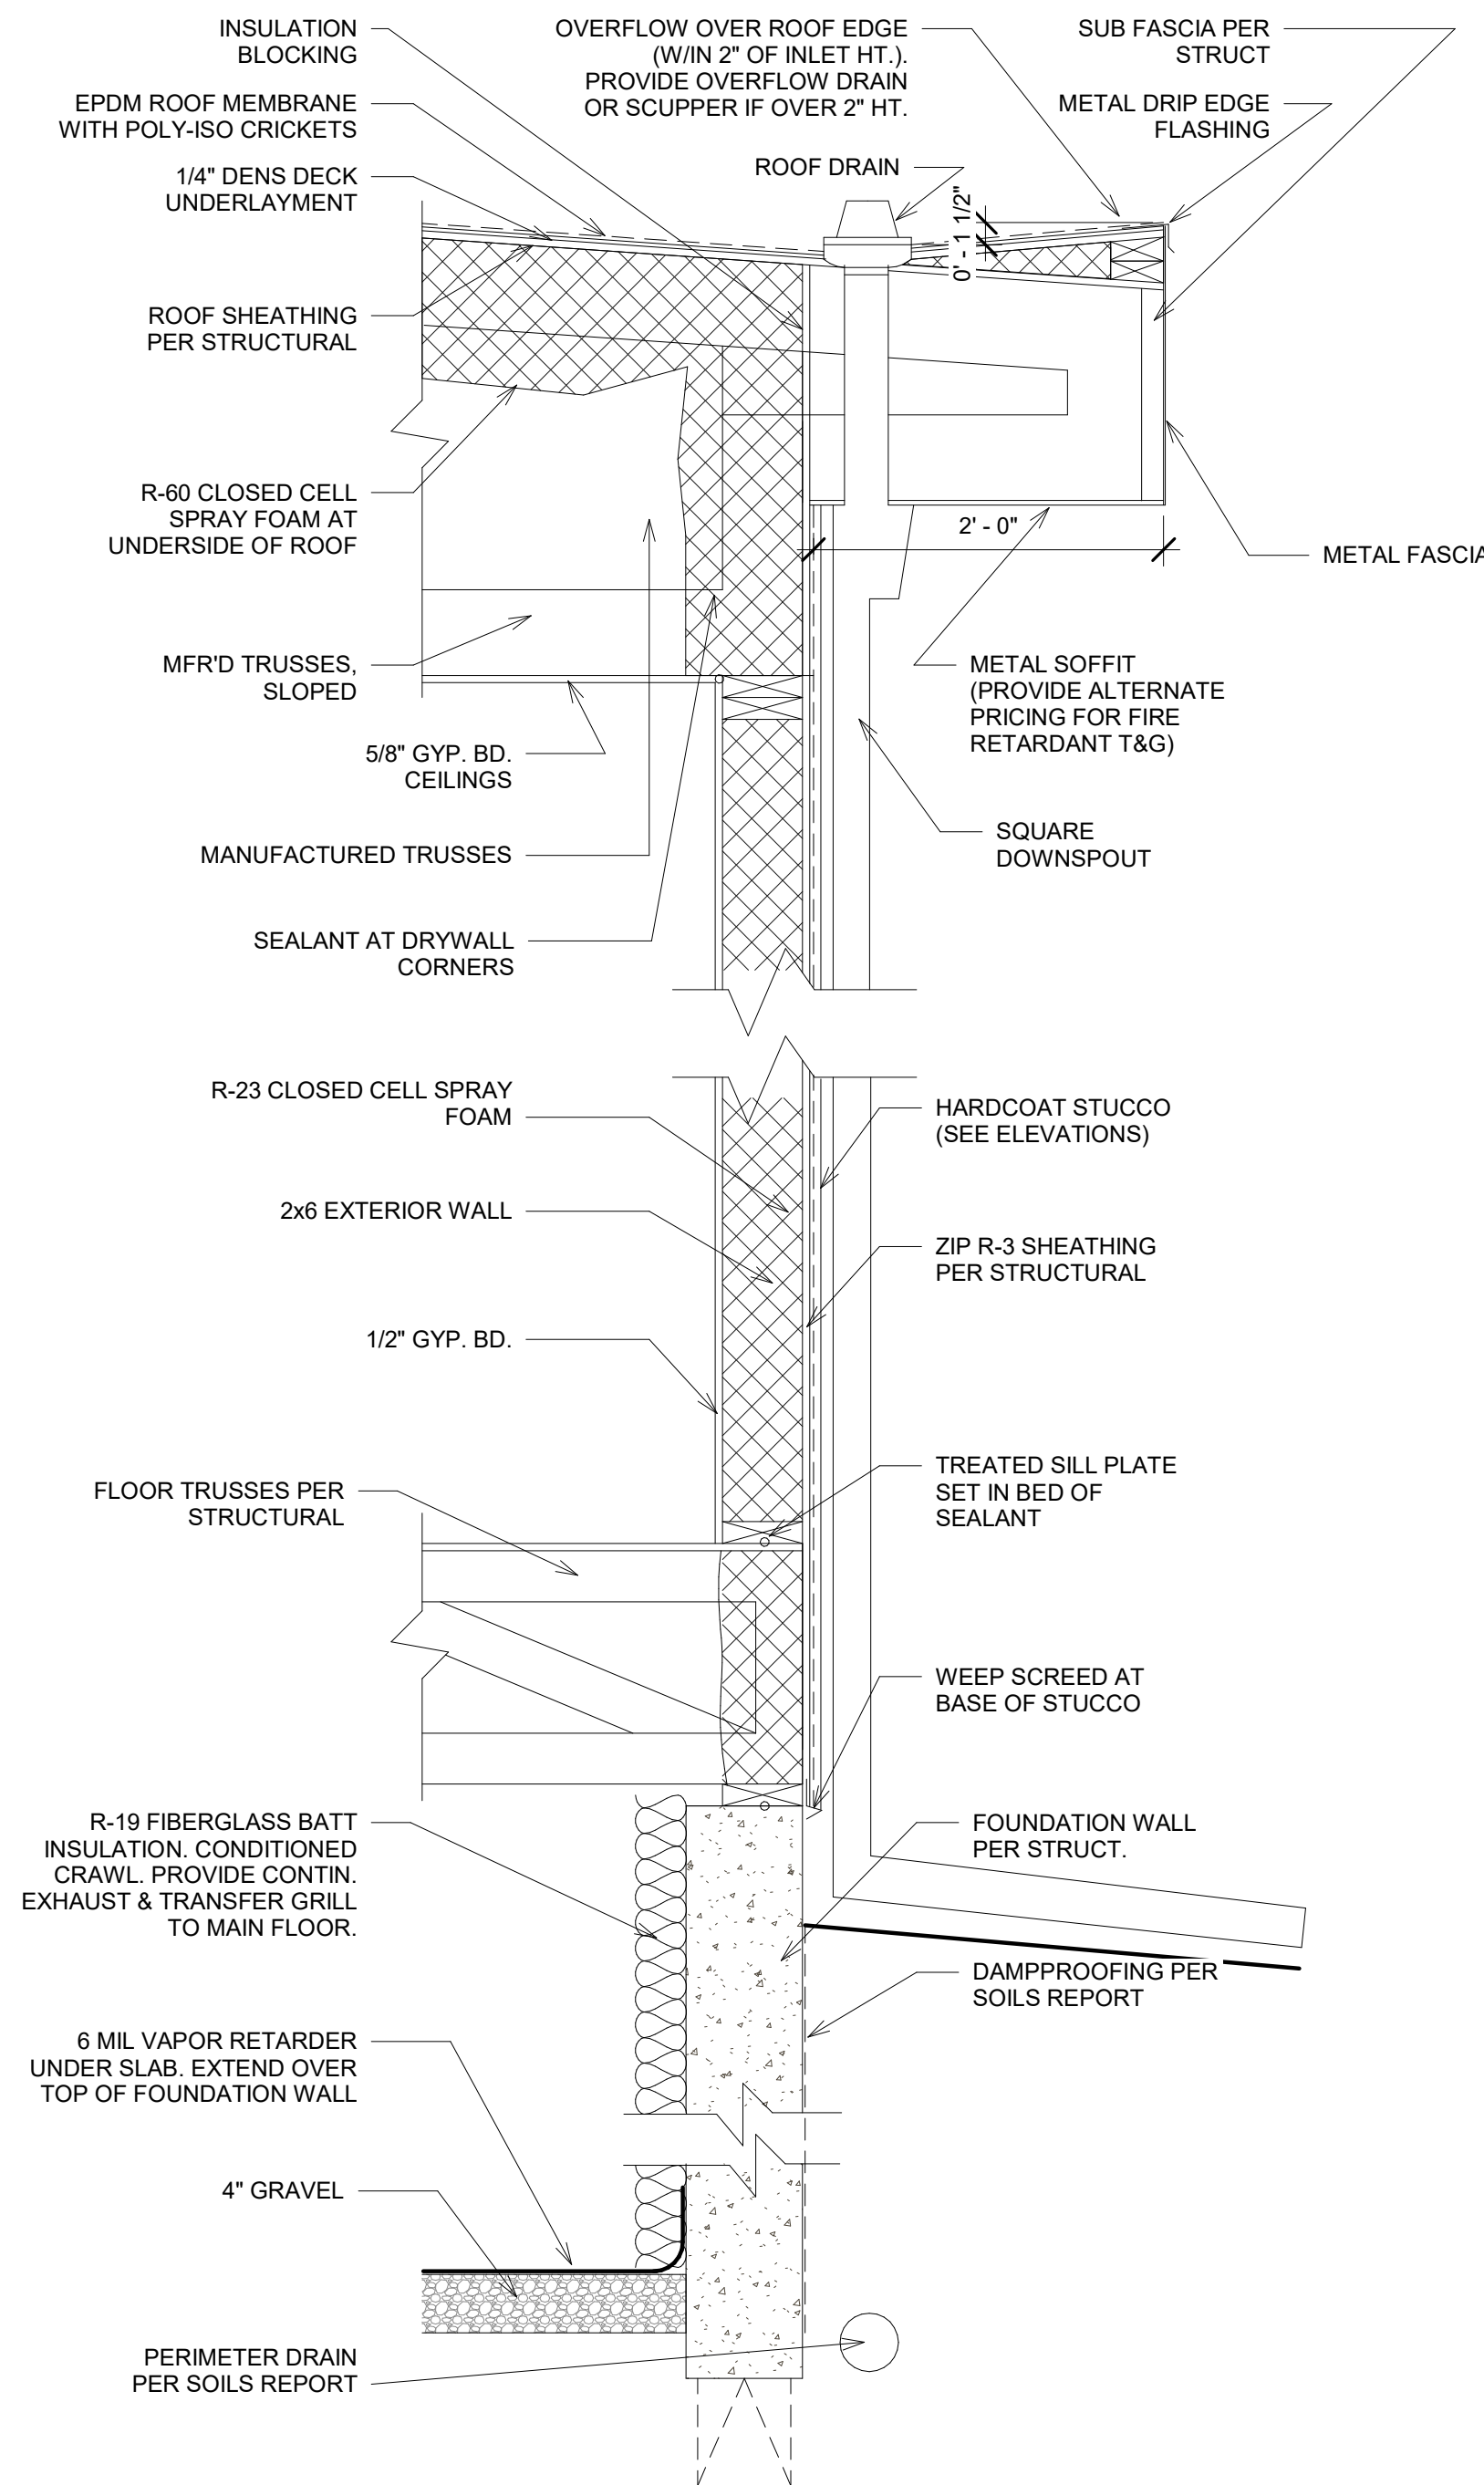


3 Typical Wall Section
1" = 1'-0"

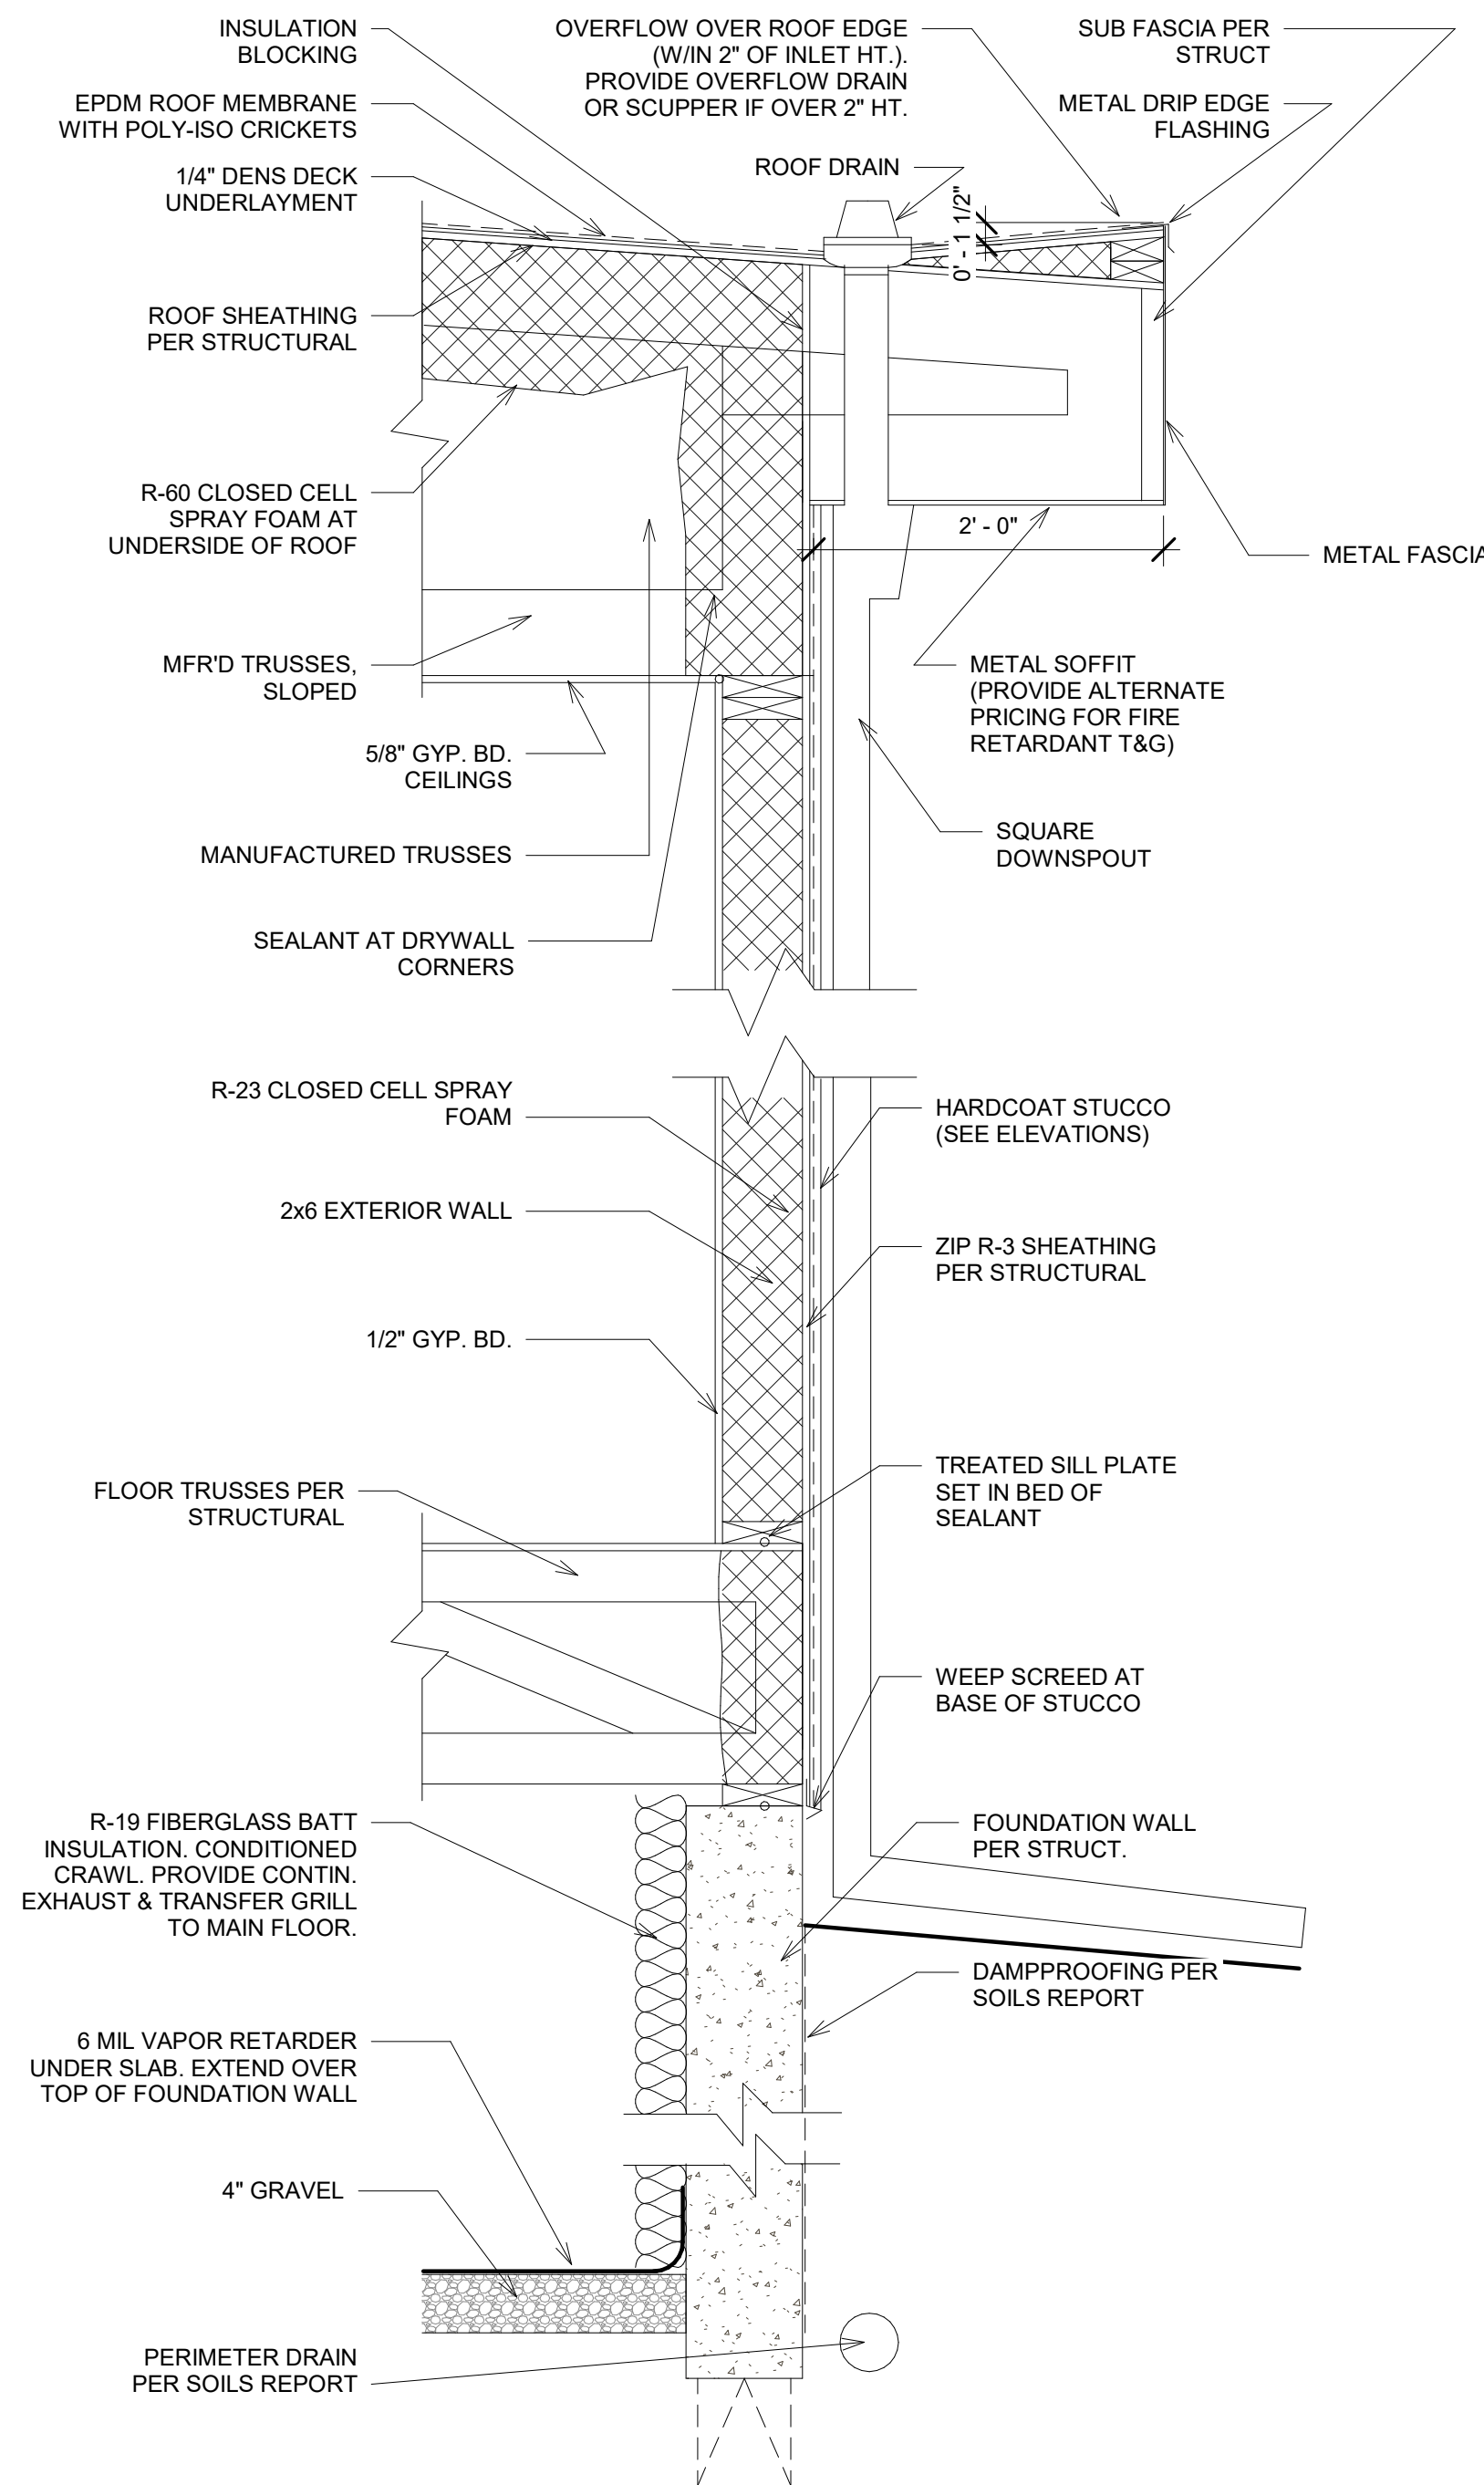


3 Typical Wall Section
1" = 1'-0"

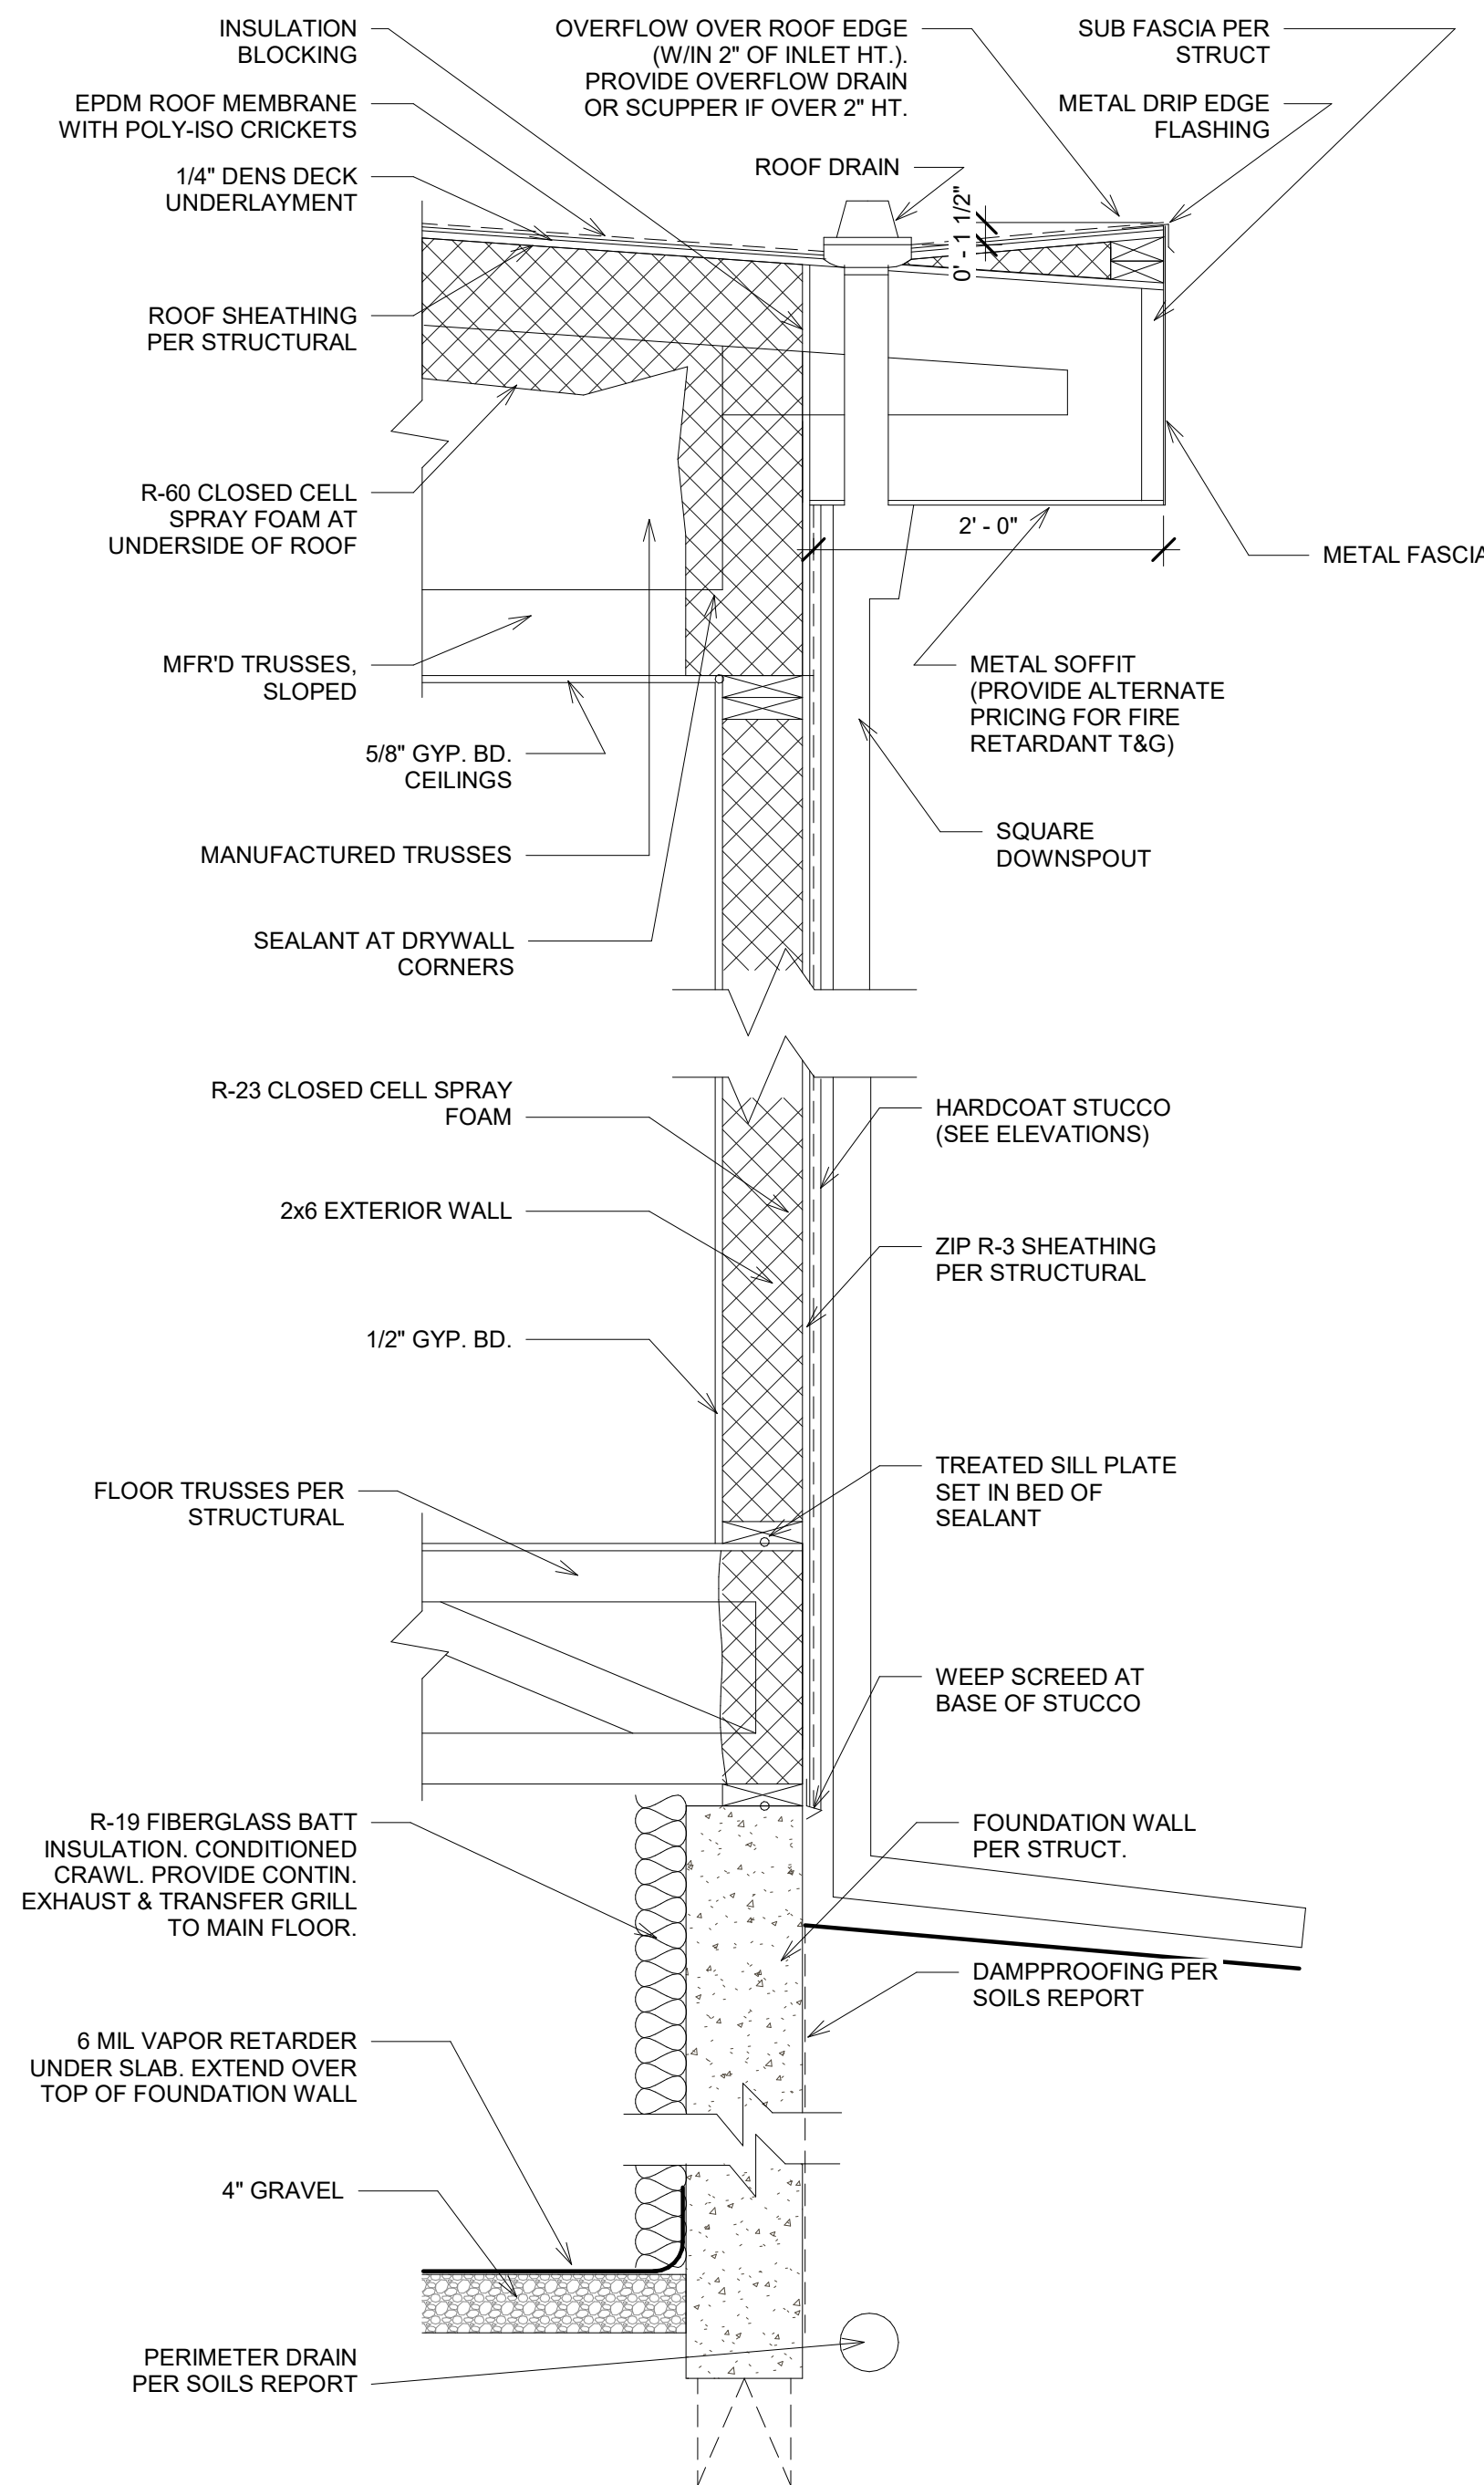


3 Typical Wall Section
1" = 1'-0"

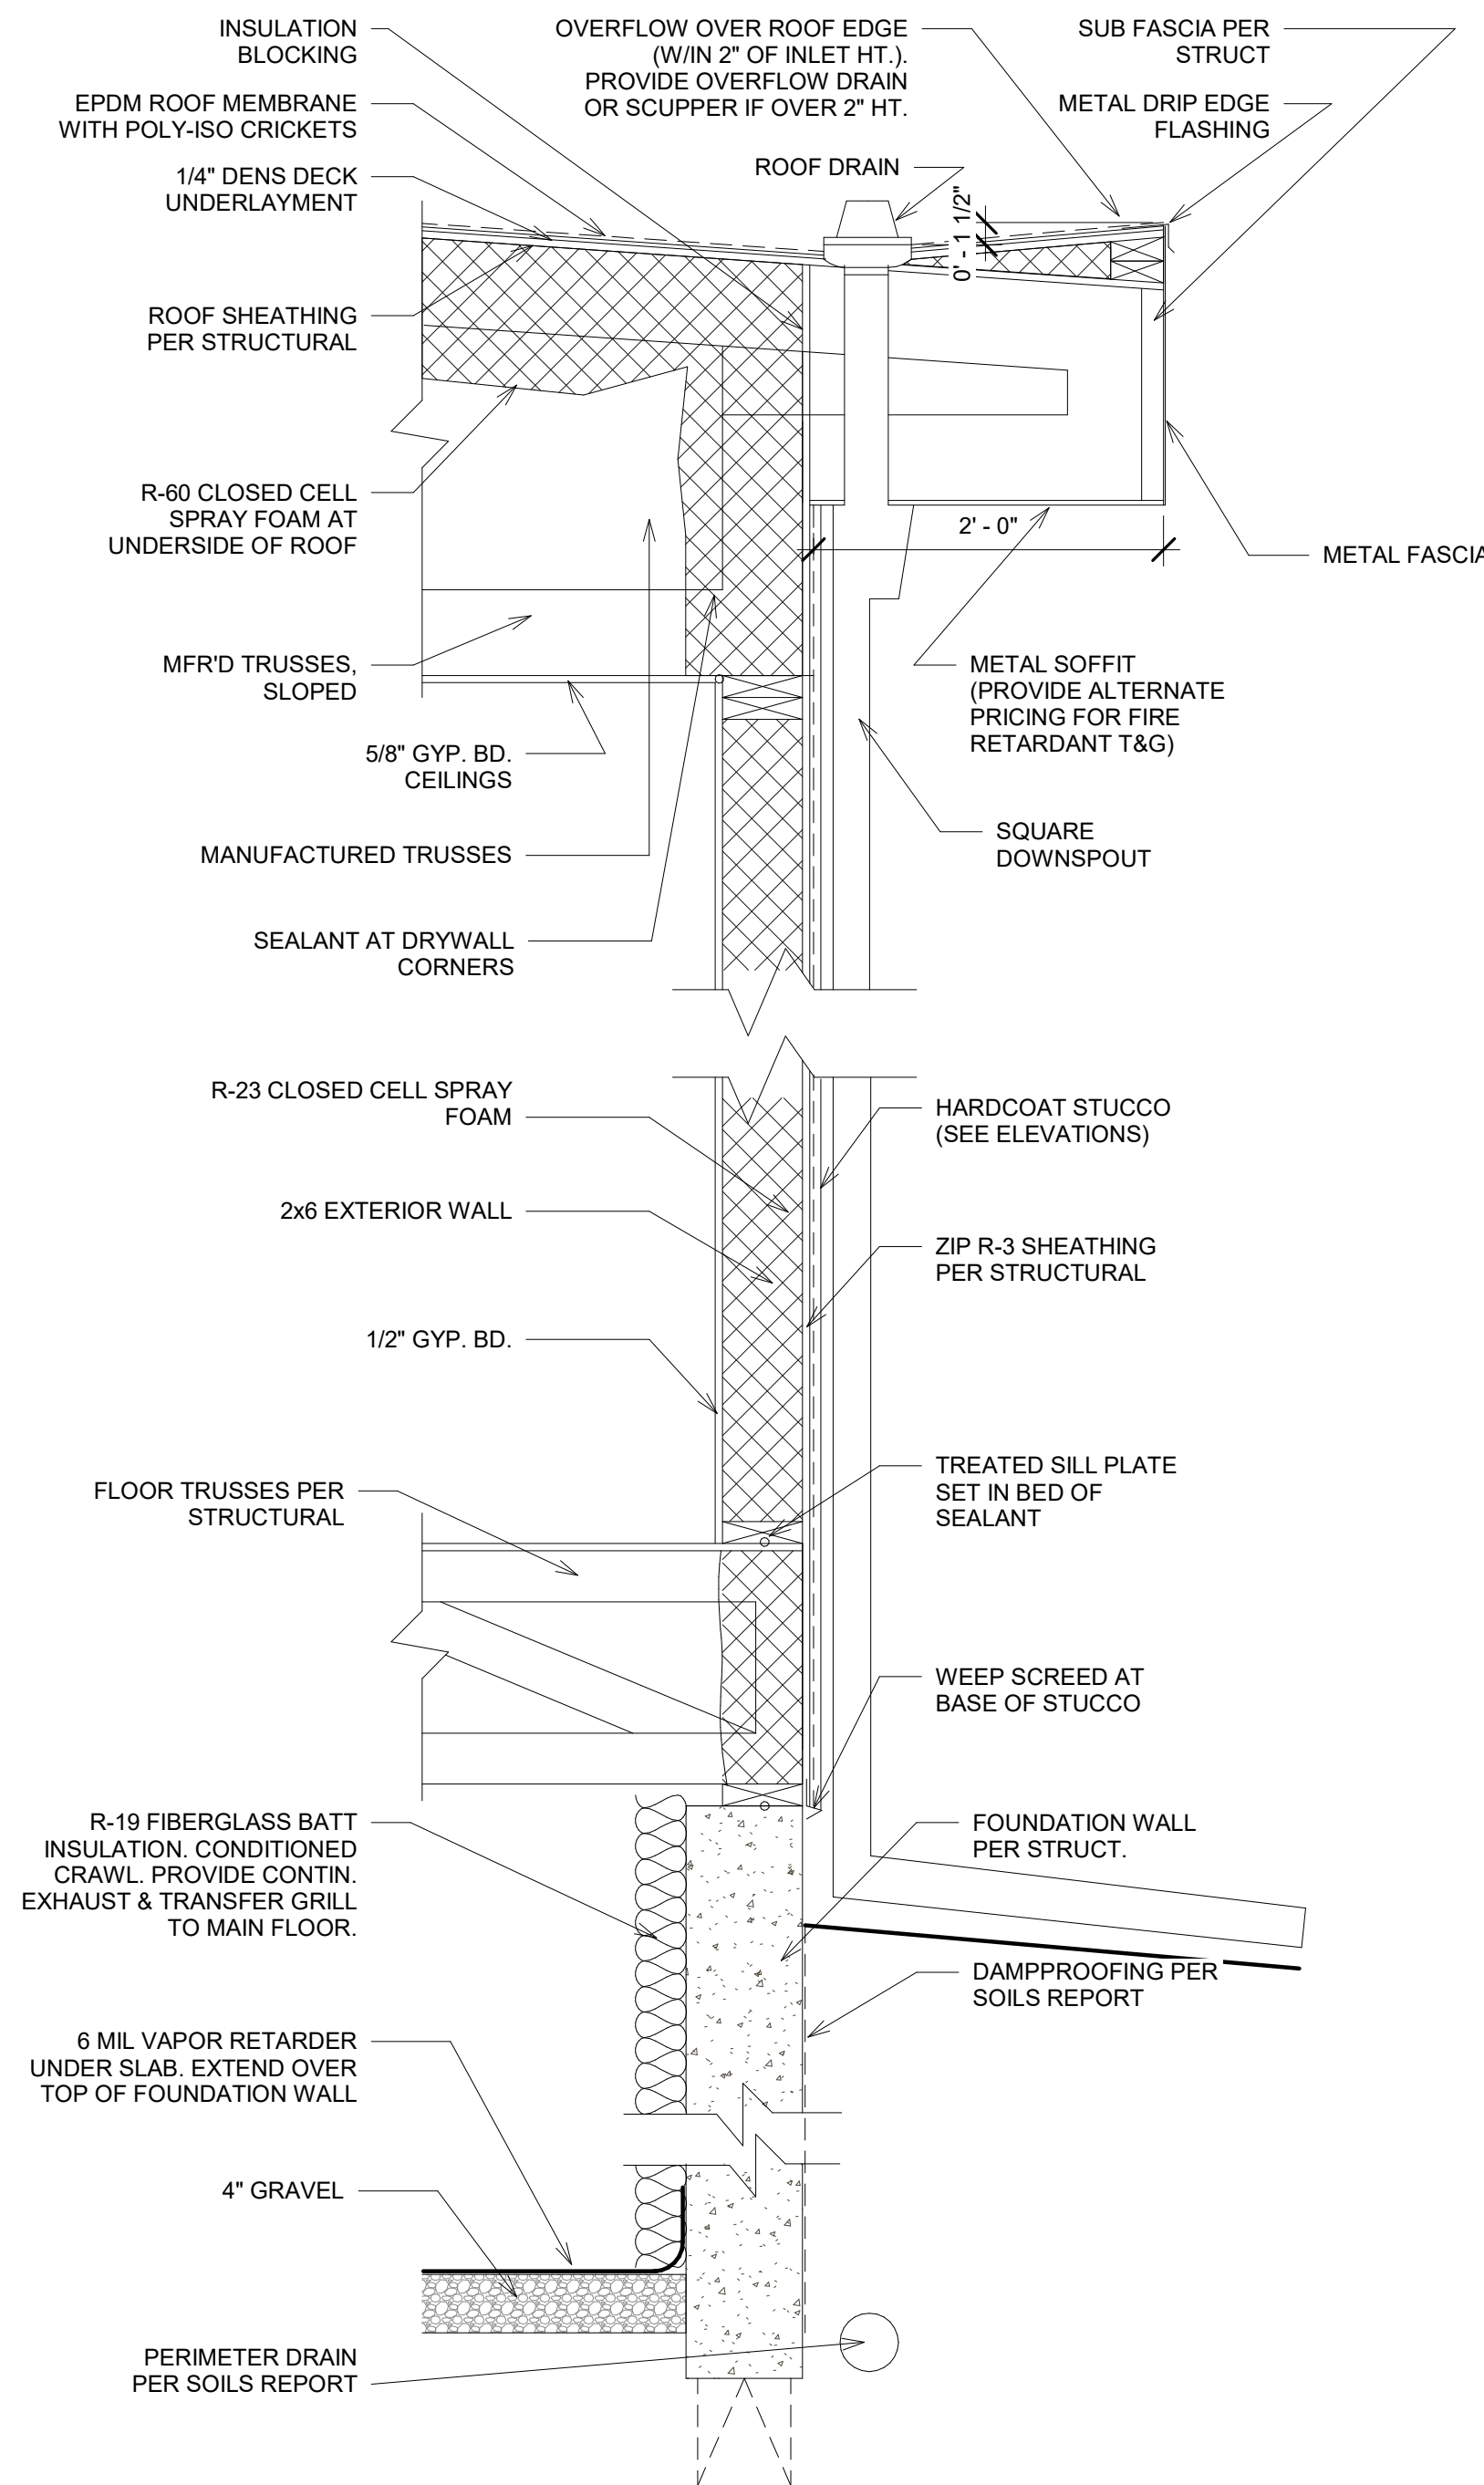


3 Typical Wall Section
1" = 1'-0"

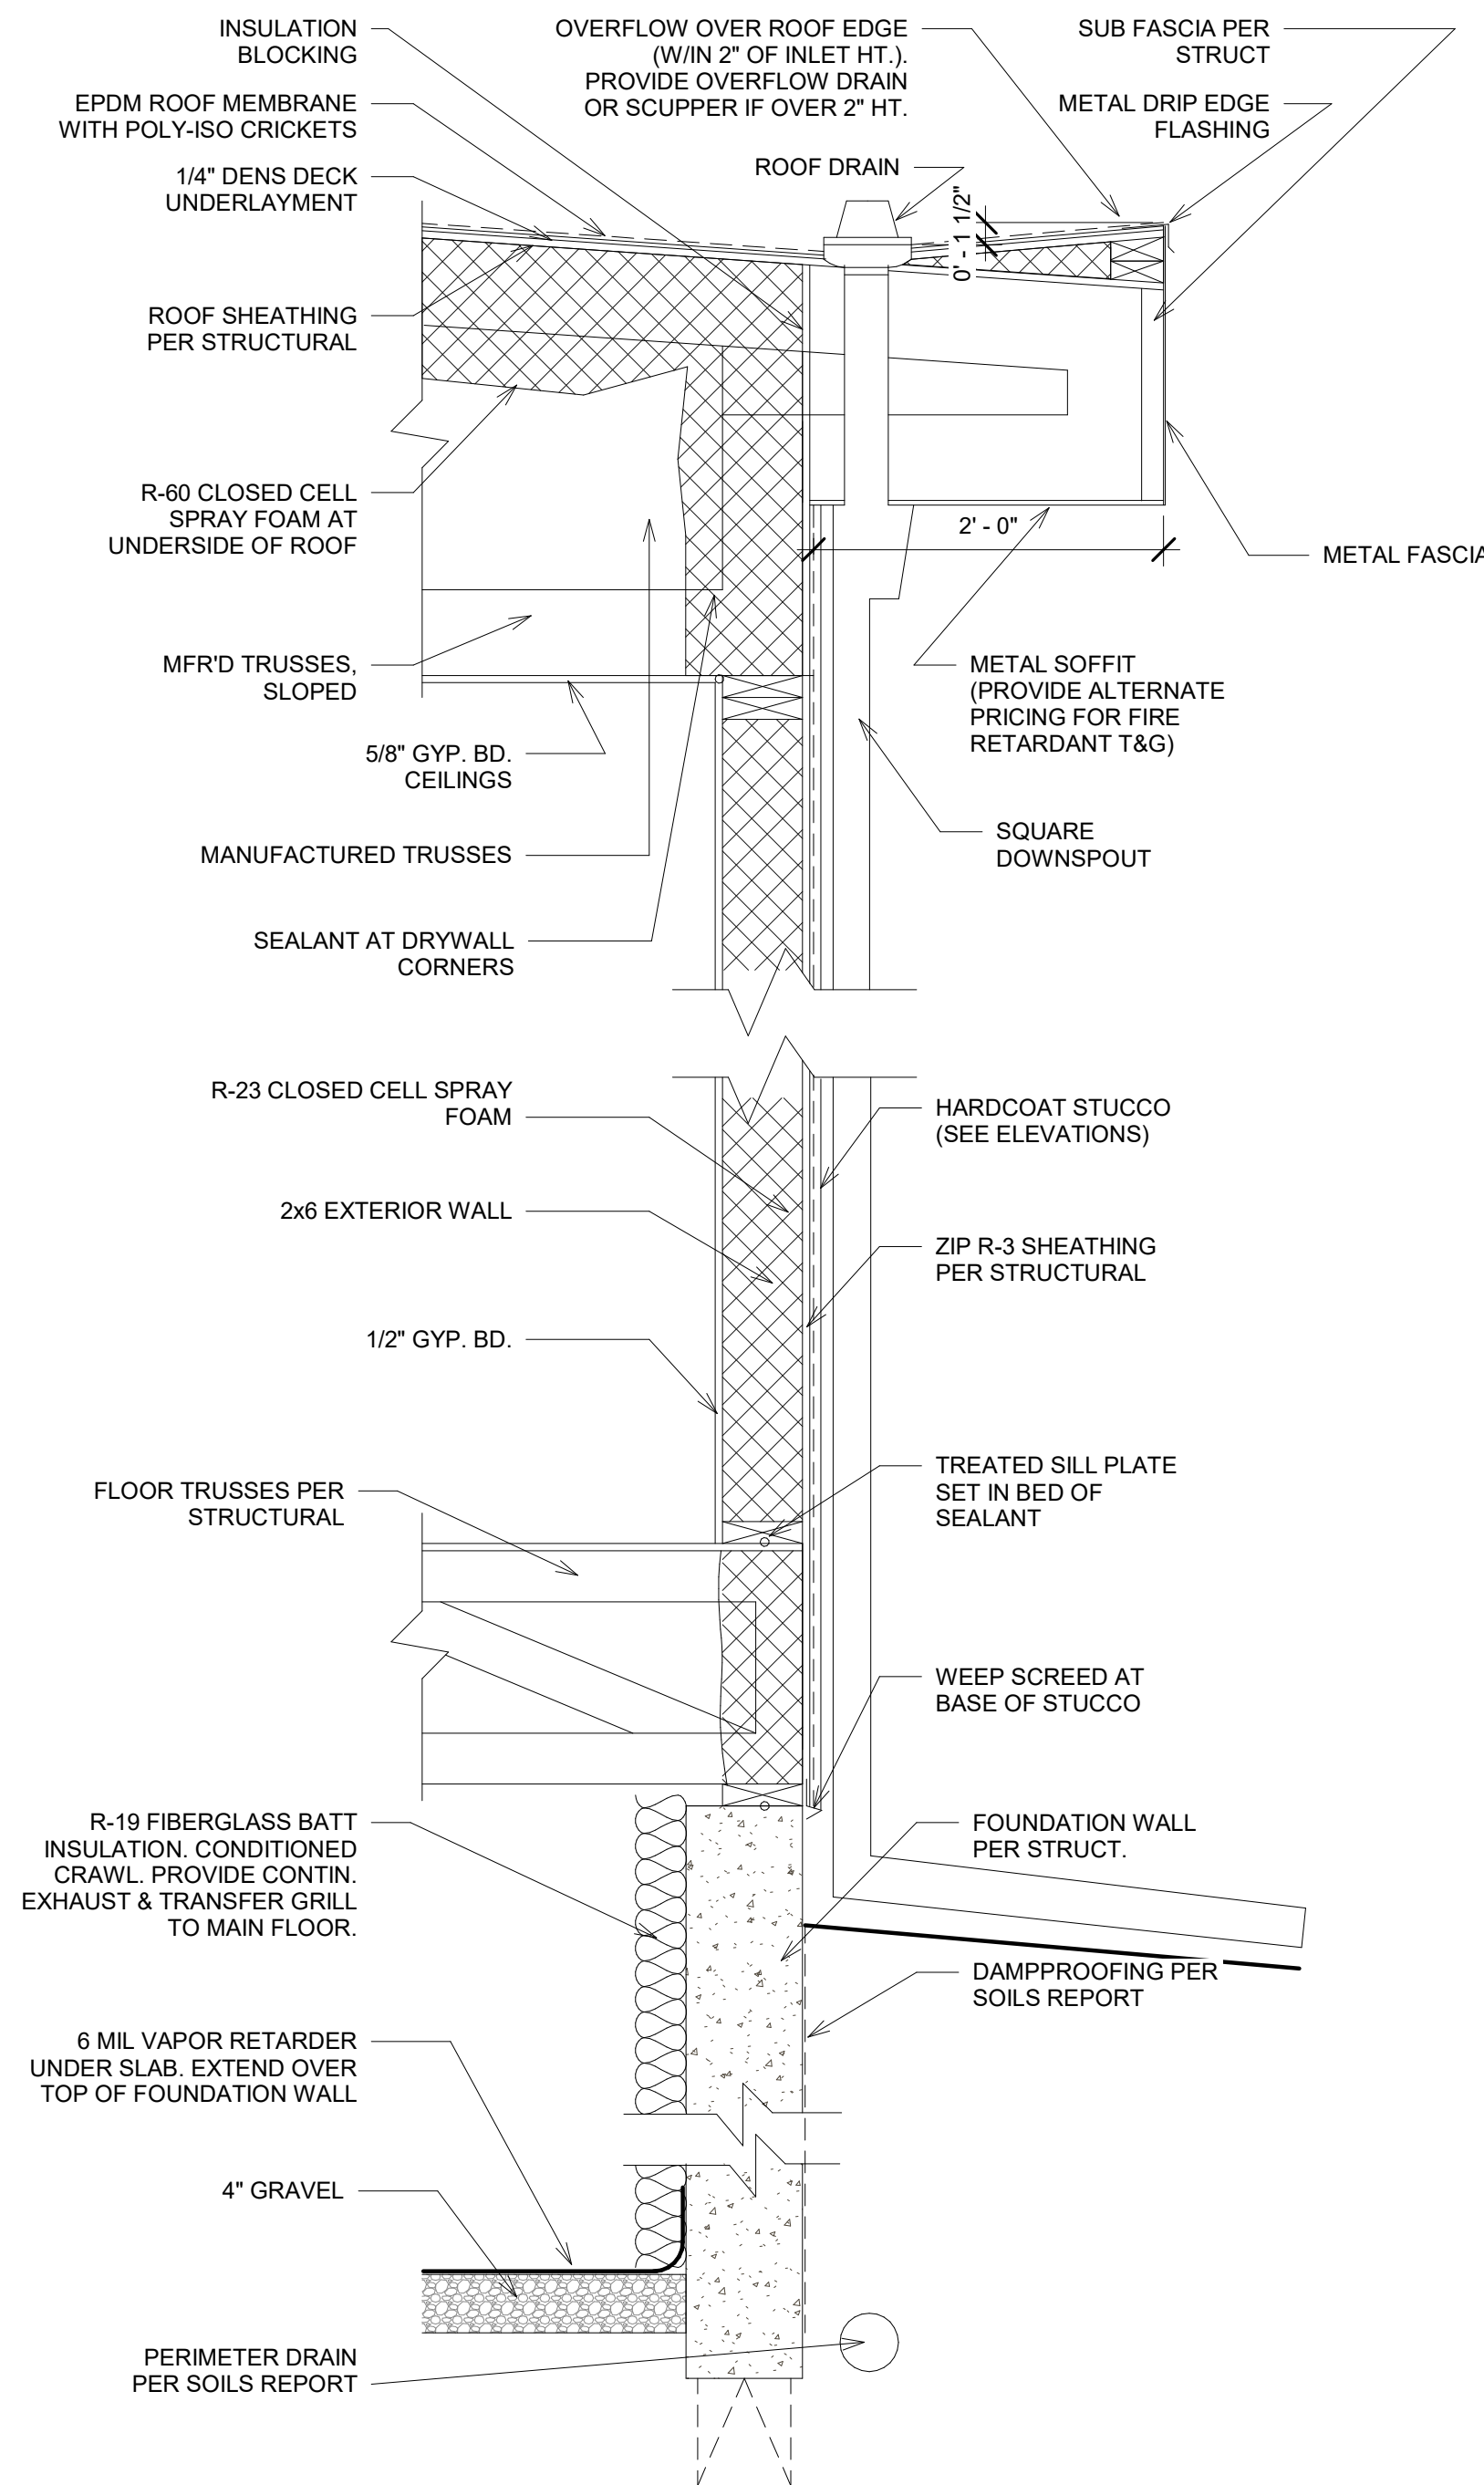


3 Typical Wall Section
1" = 1'-0"

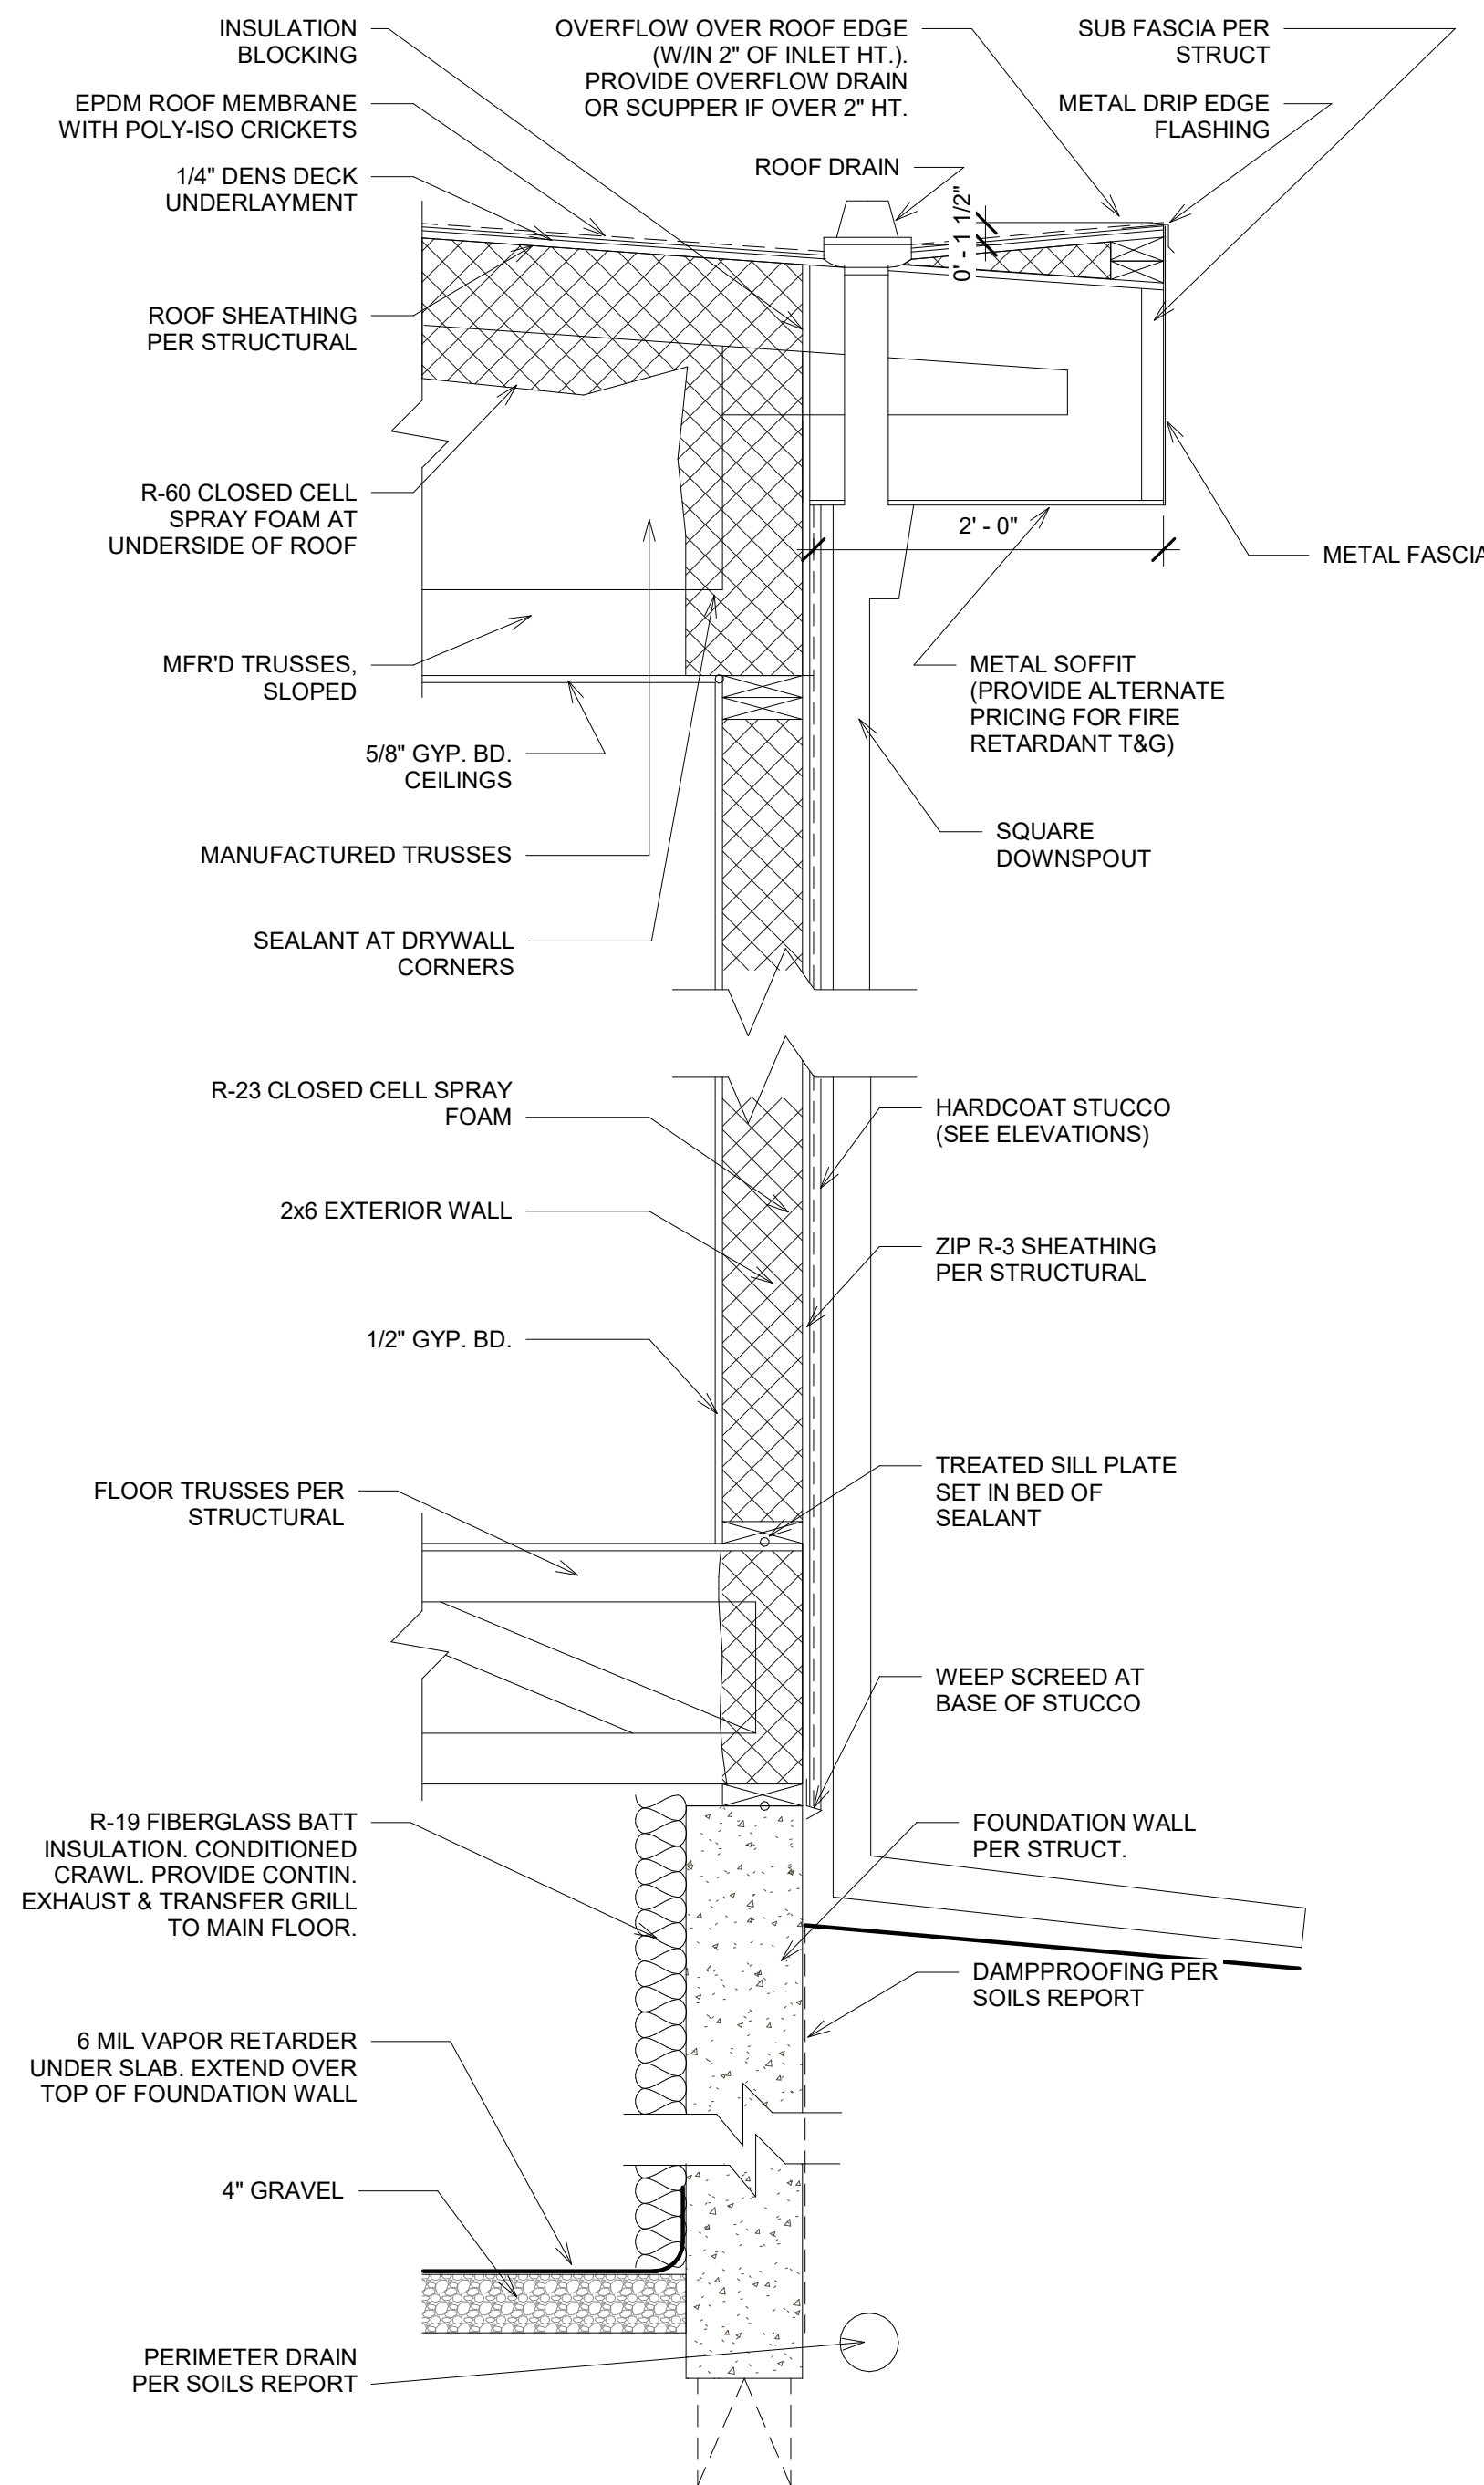


3 Typical Wall Section
1" = 1'-0"

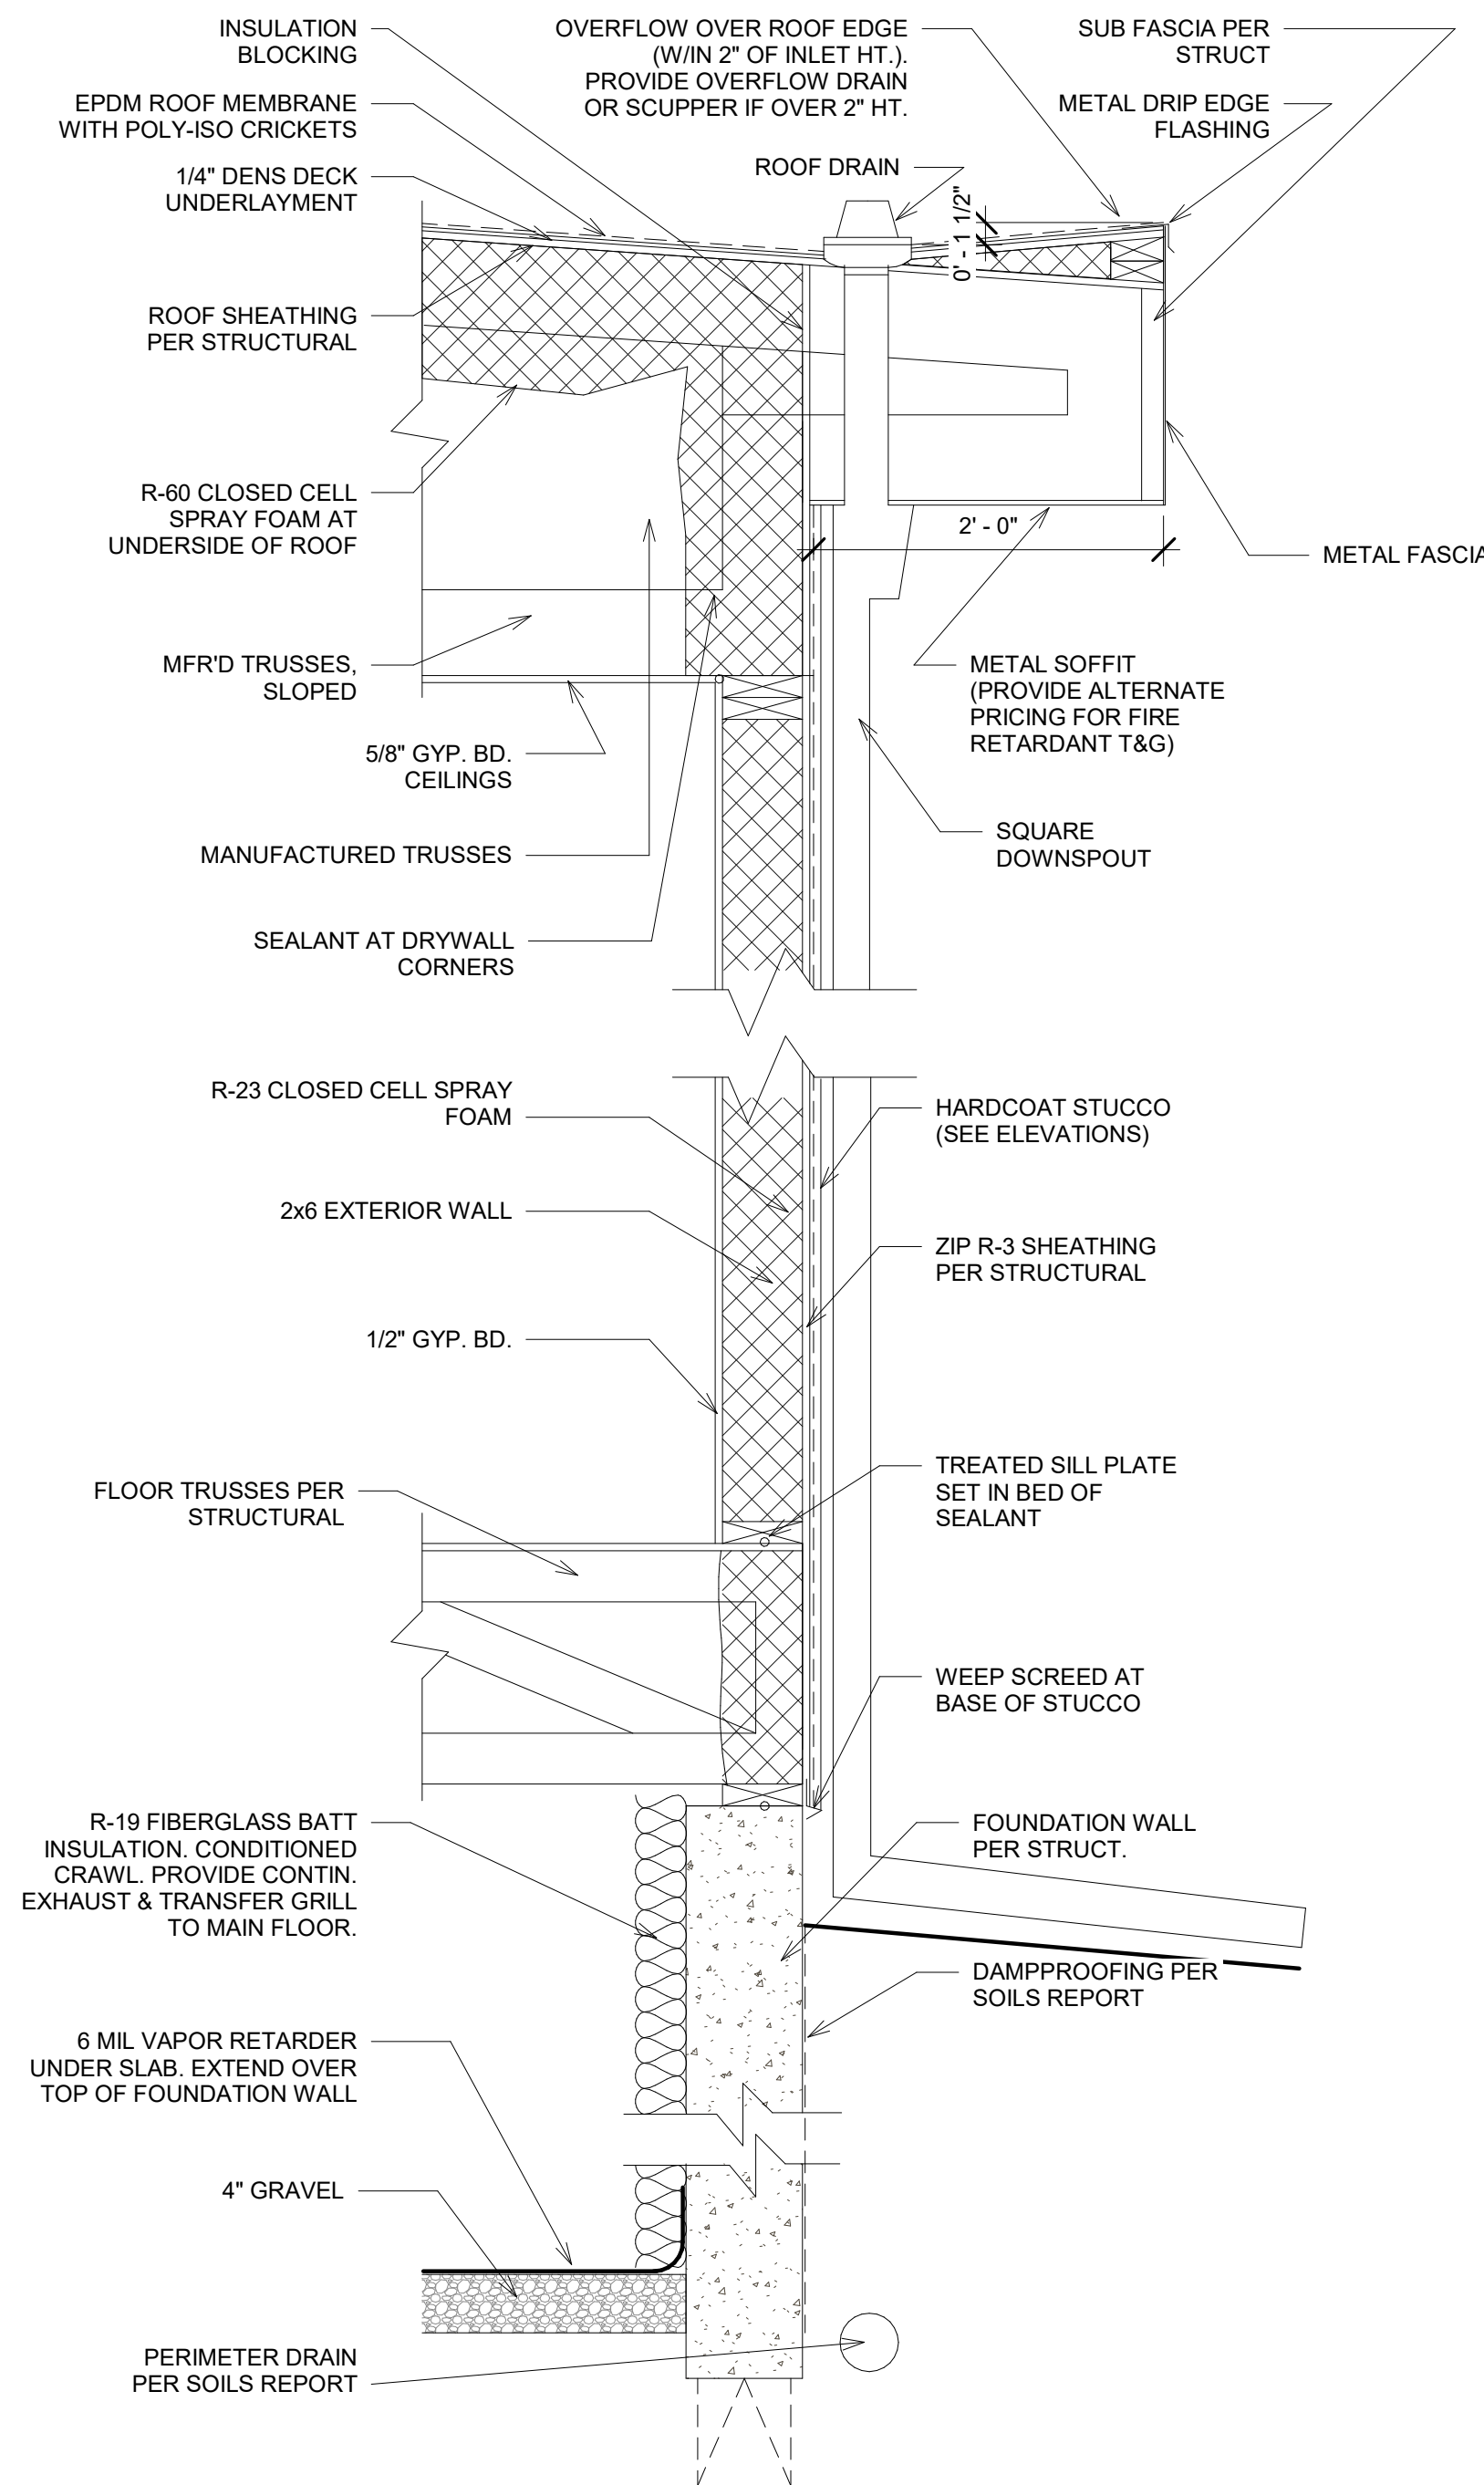


3 Typical Wall Section
1" = 1'-0"

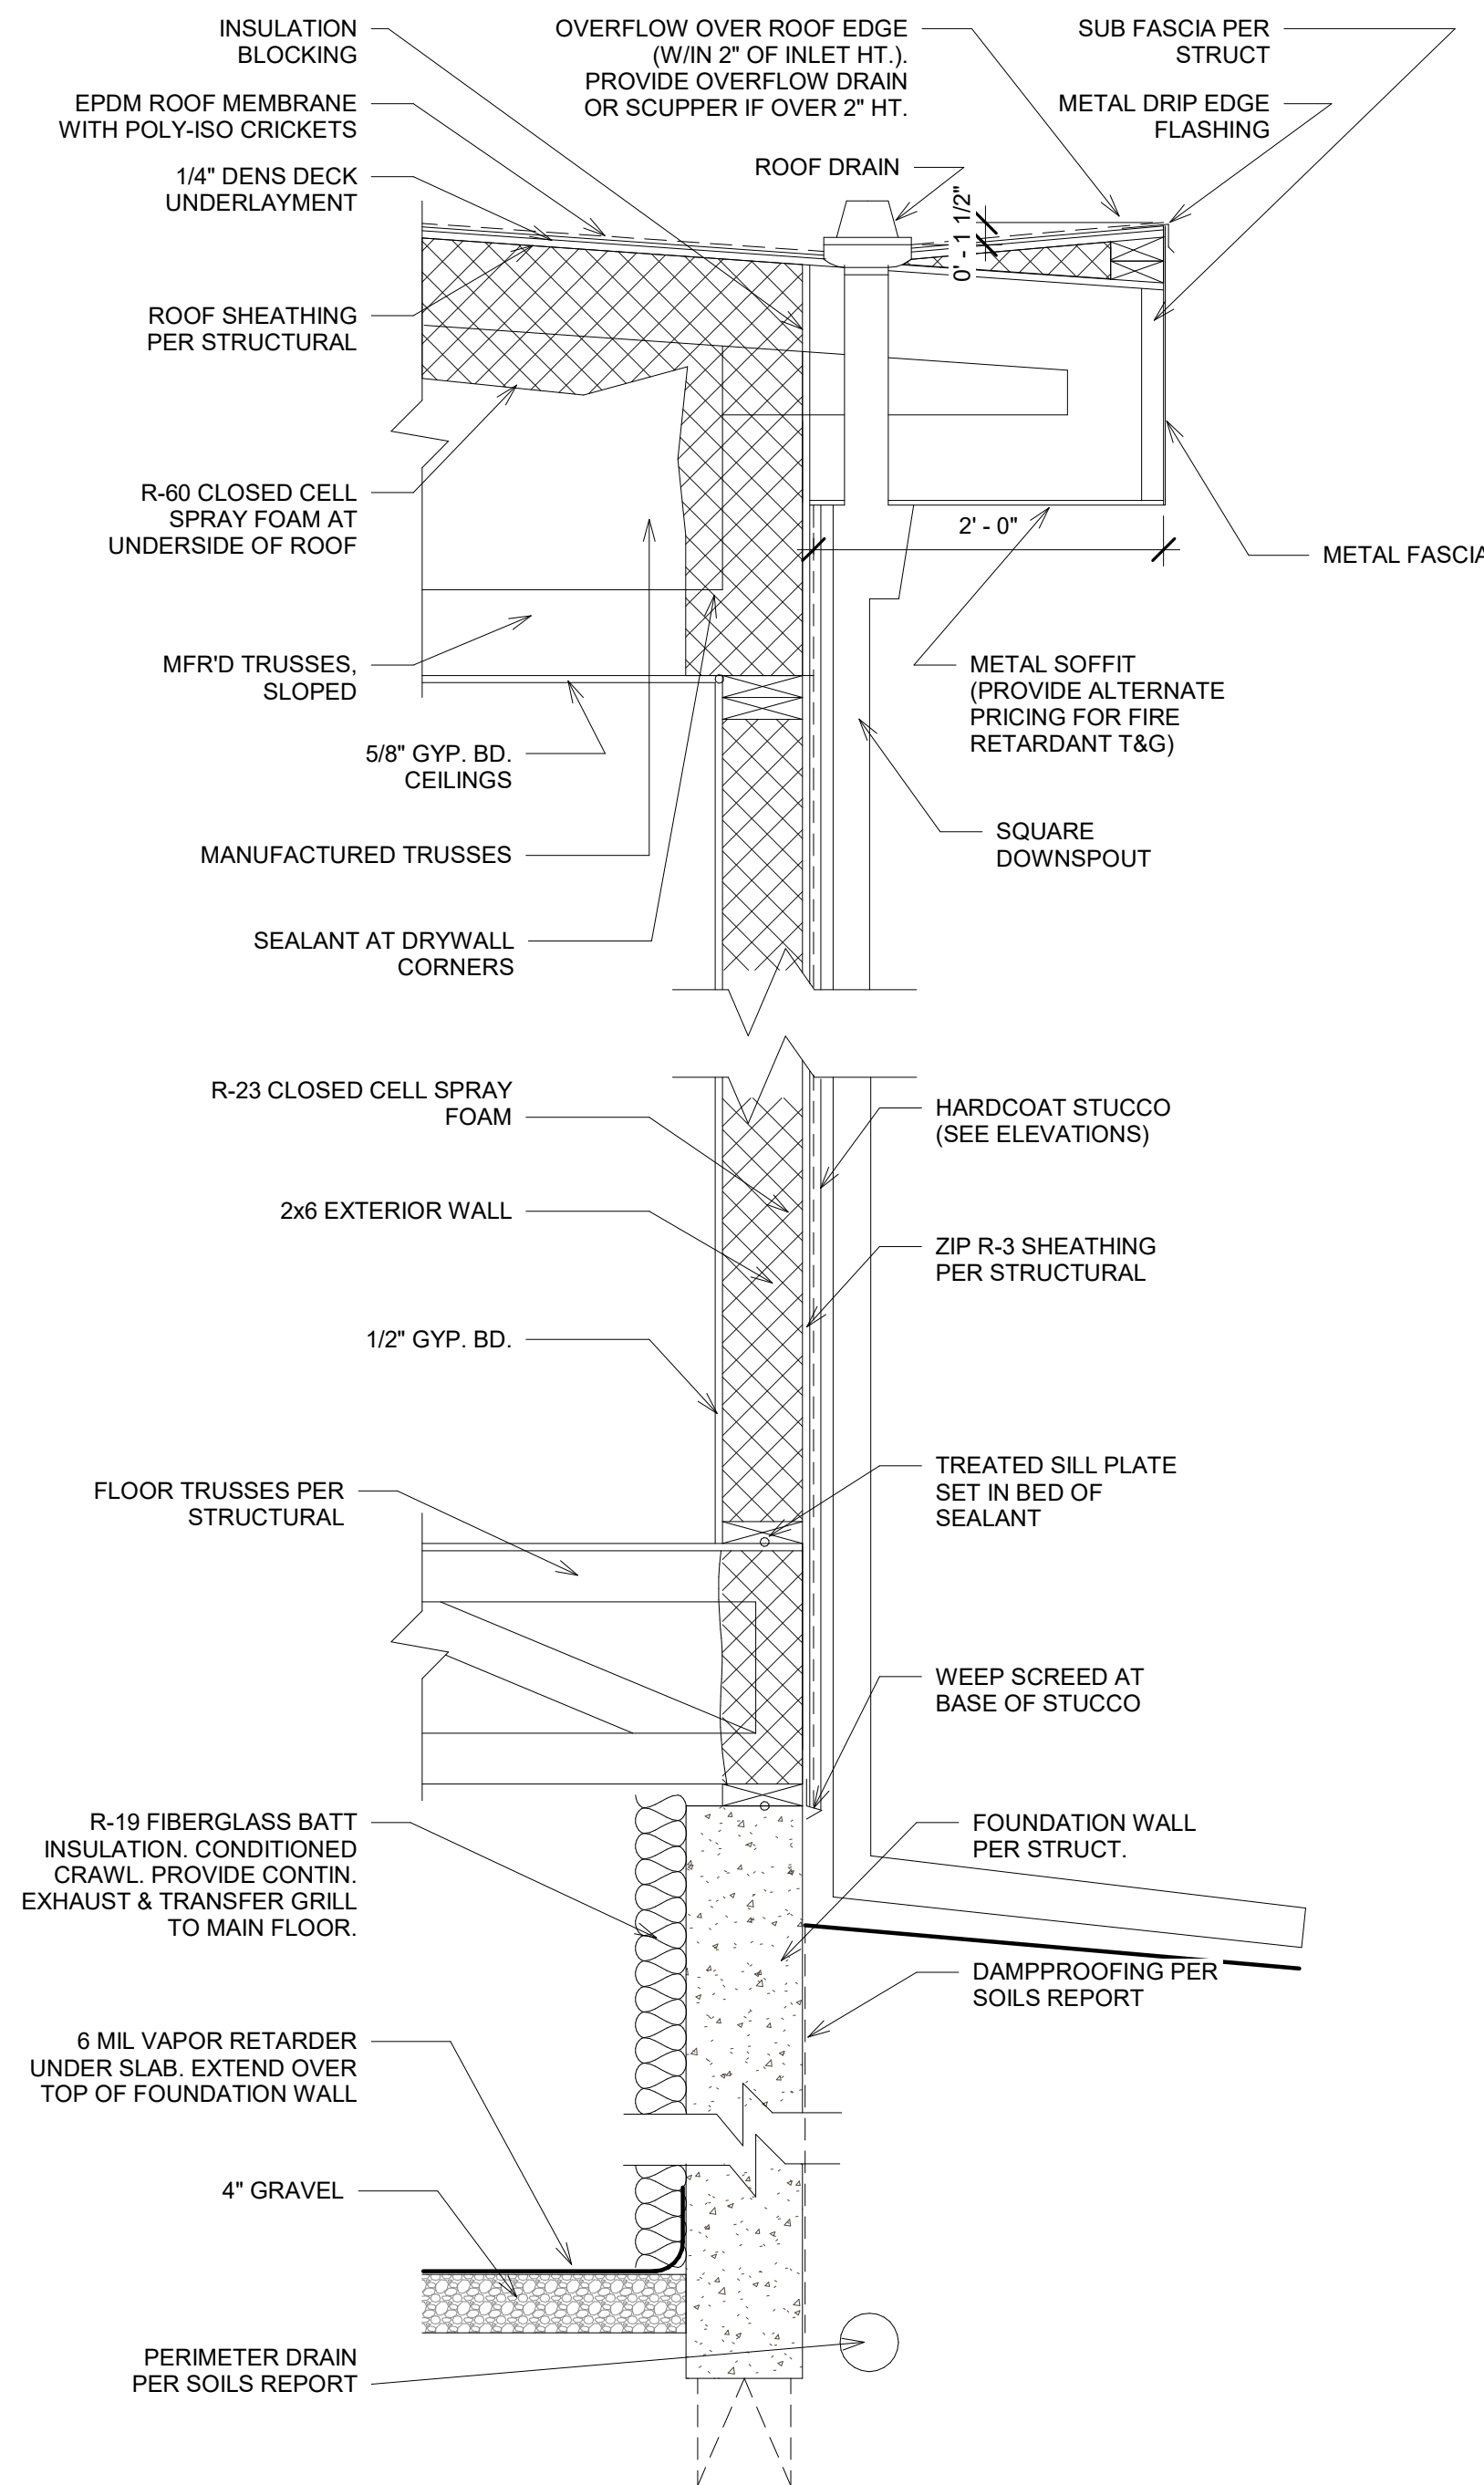


3 Typical Wall Section
1" = 1'-0"

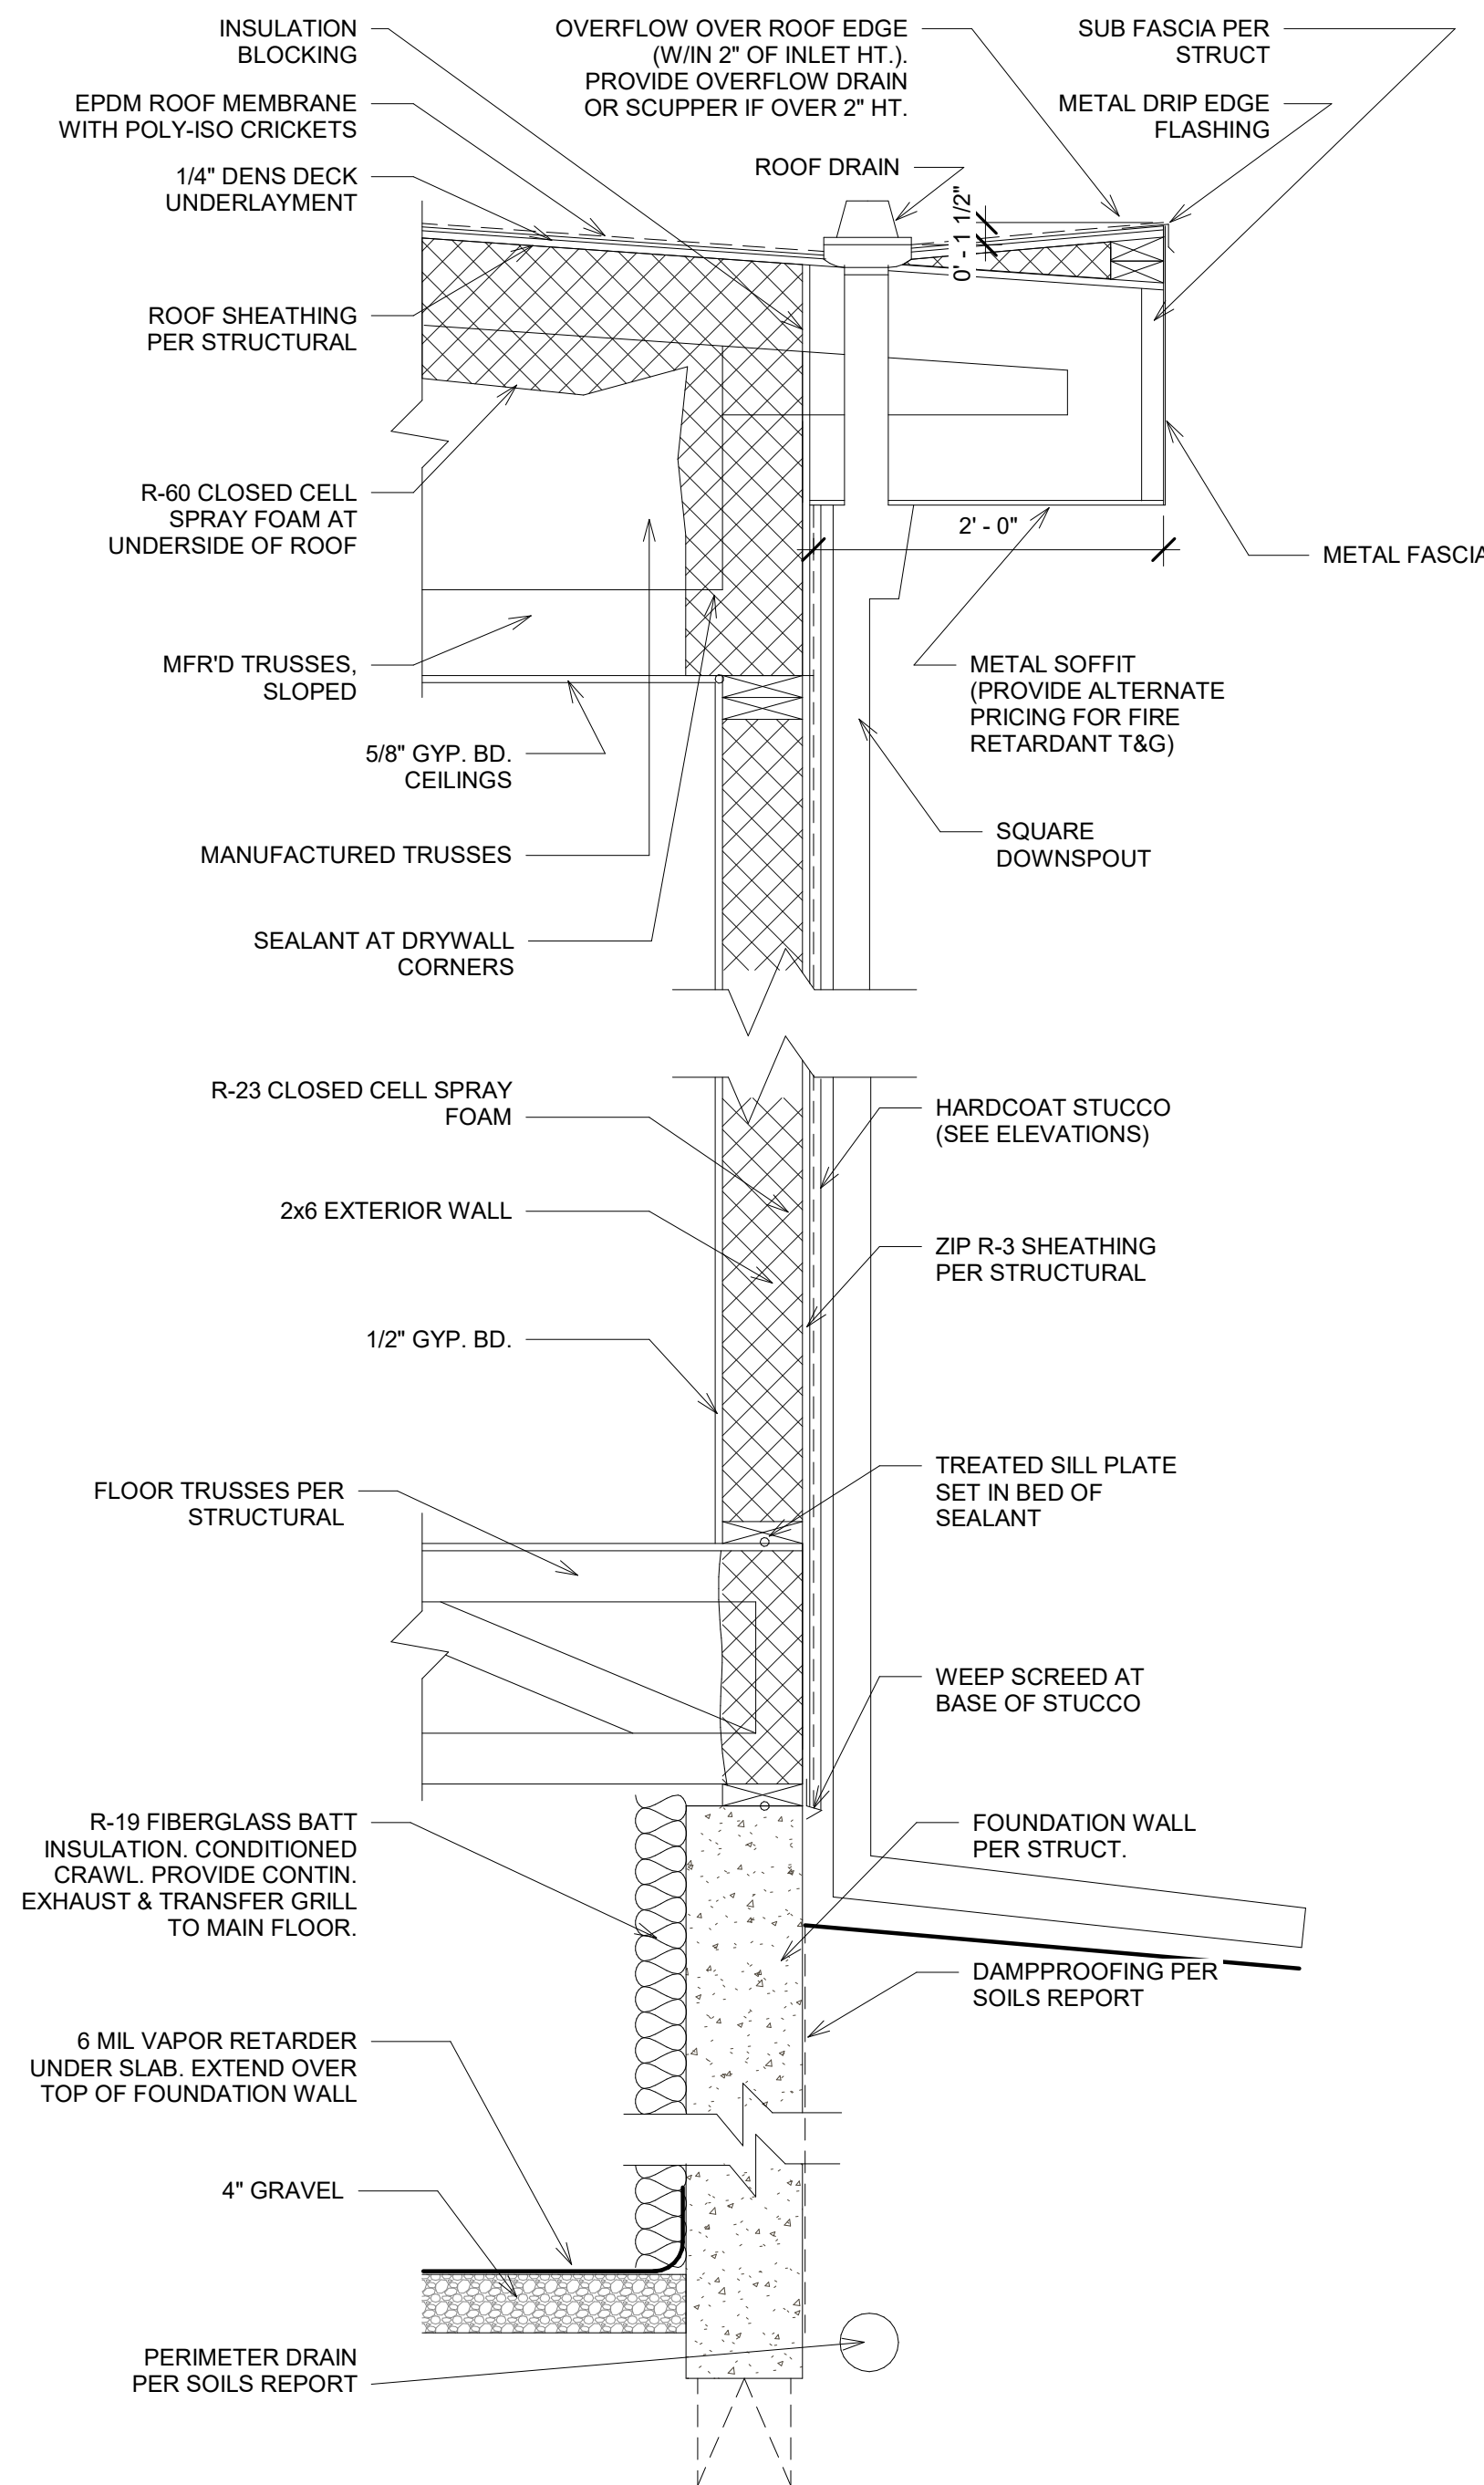


3 Typical Wall Section
1" = 1'-0"

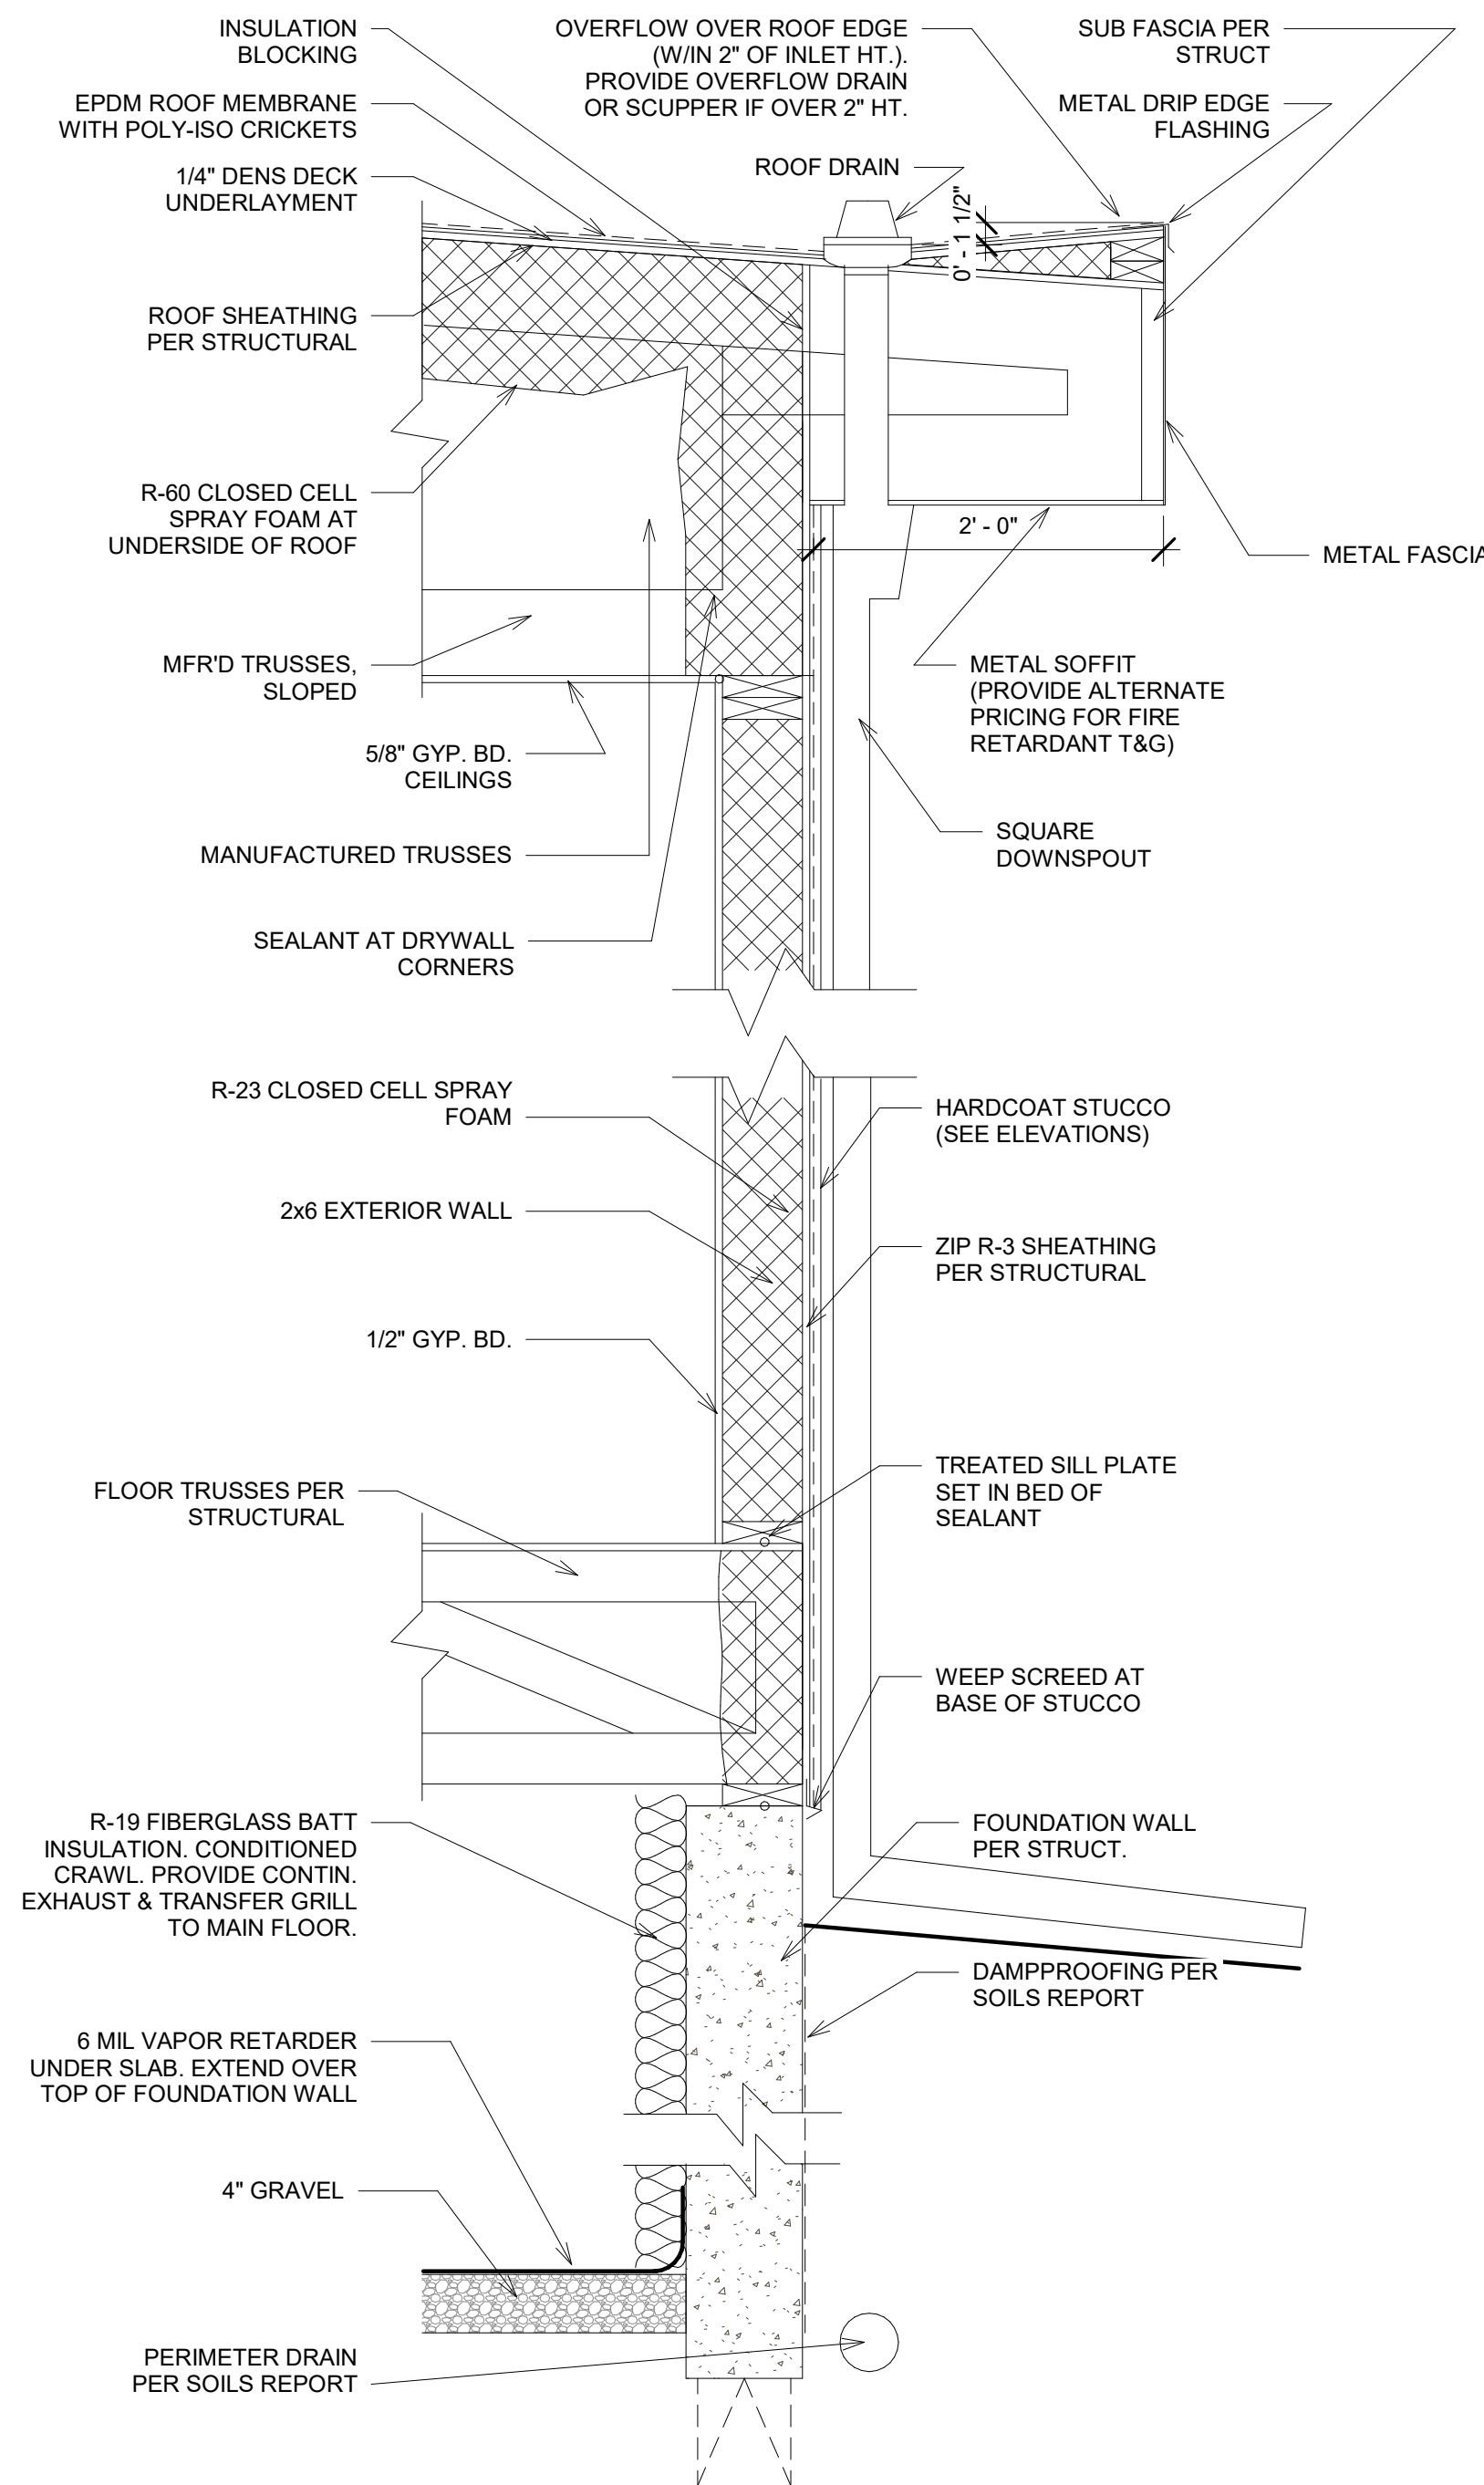


3 Typical Wall Section
1" = 1'-0"

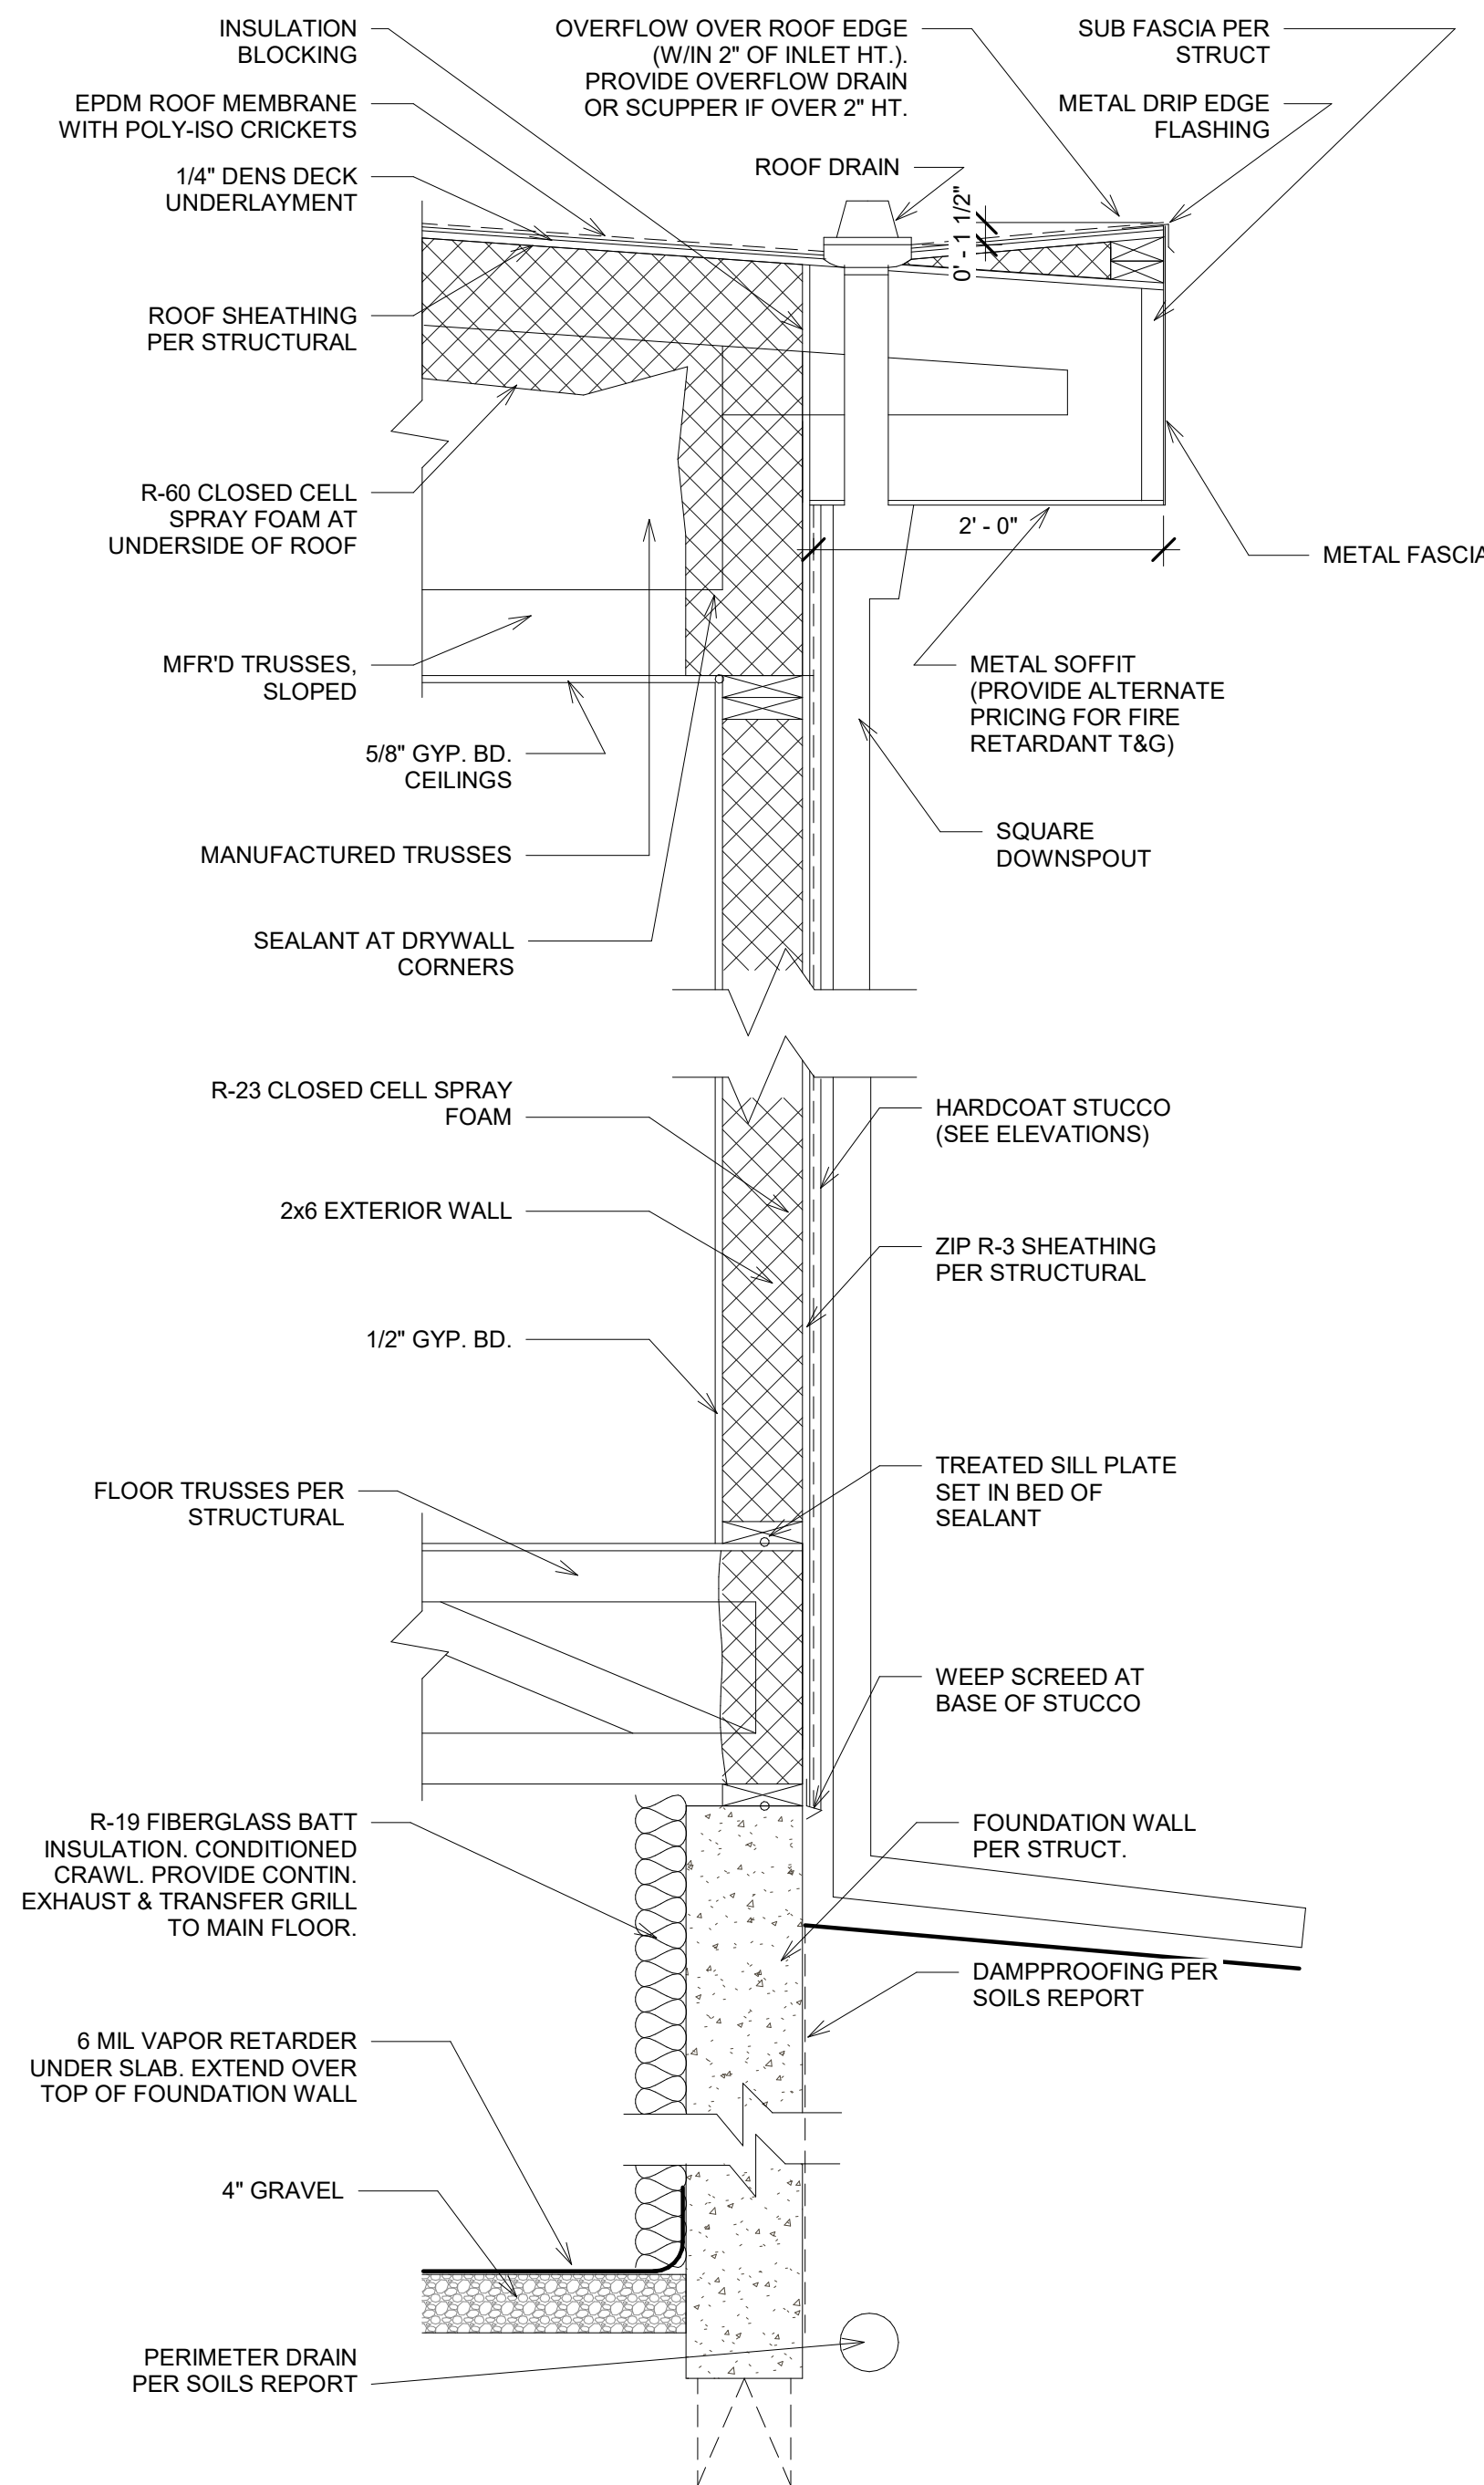


3 Typical Wall Section
1" = 1'-0"

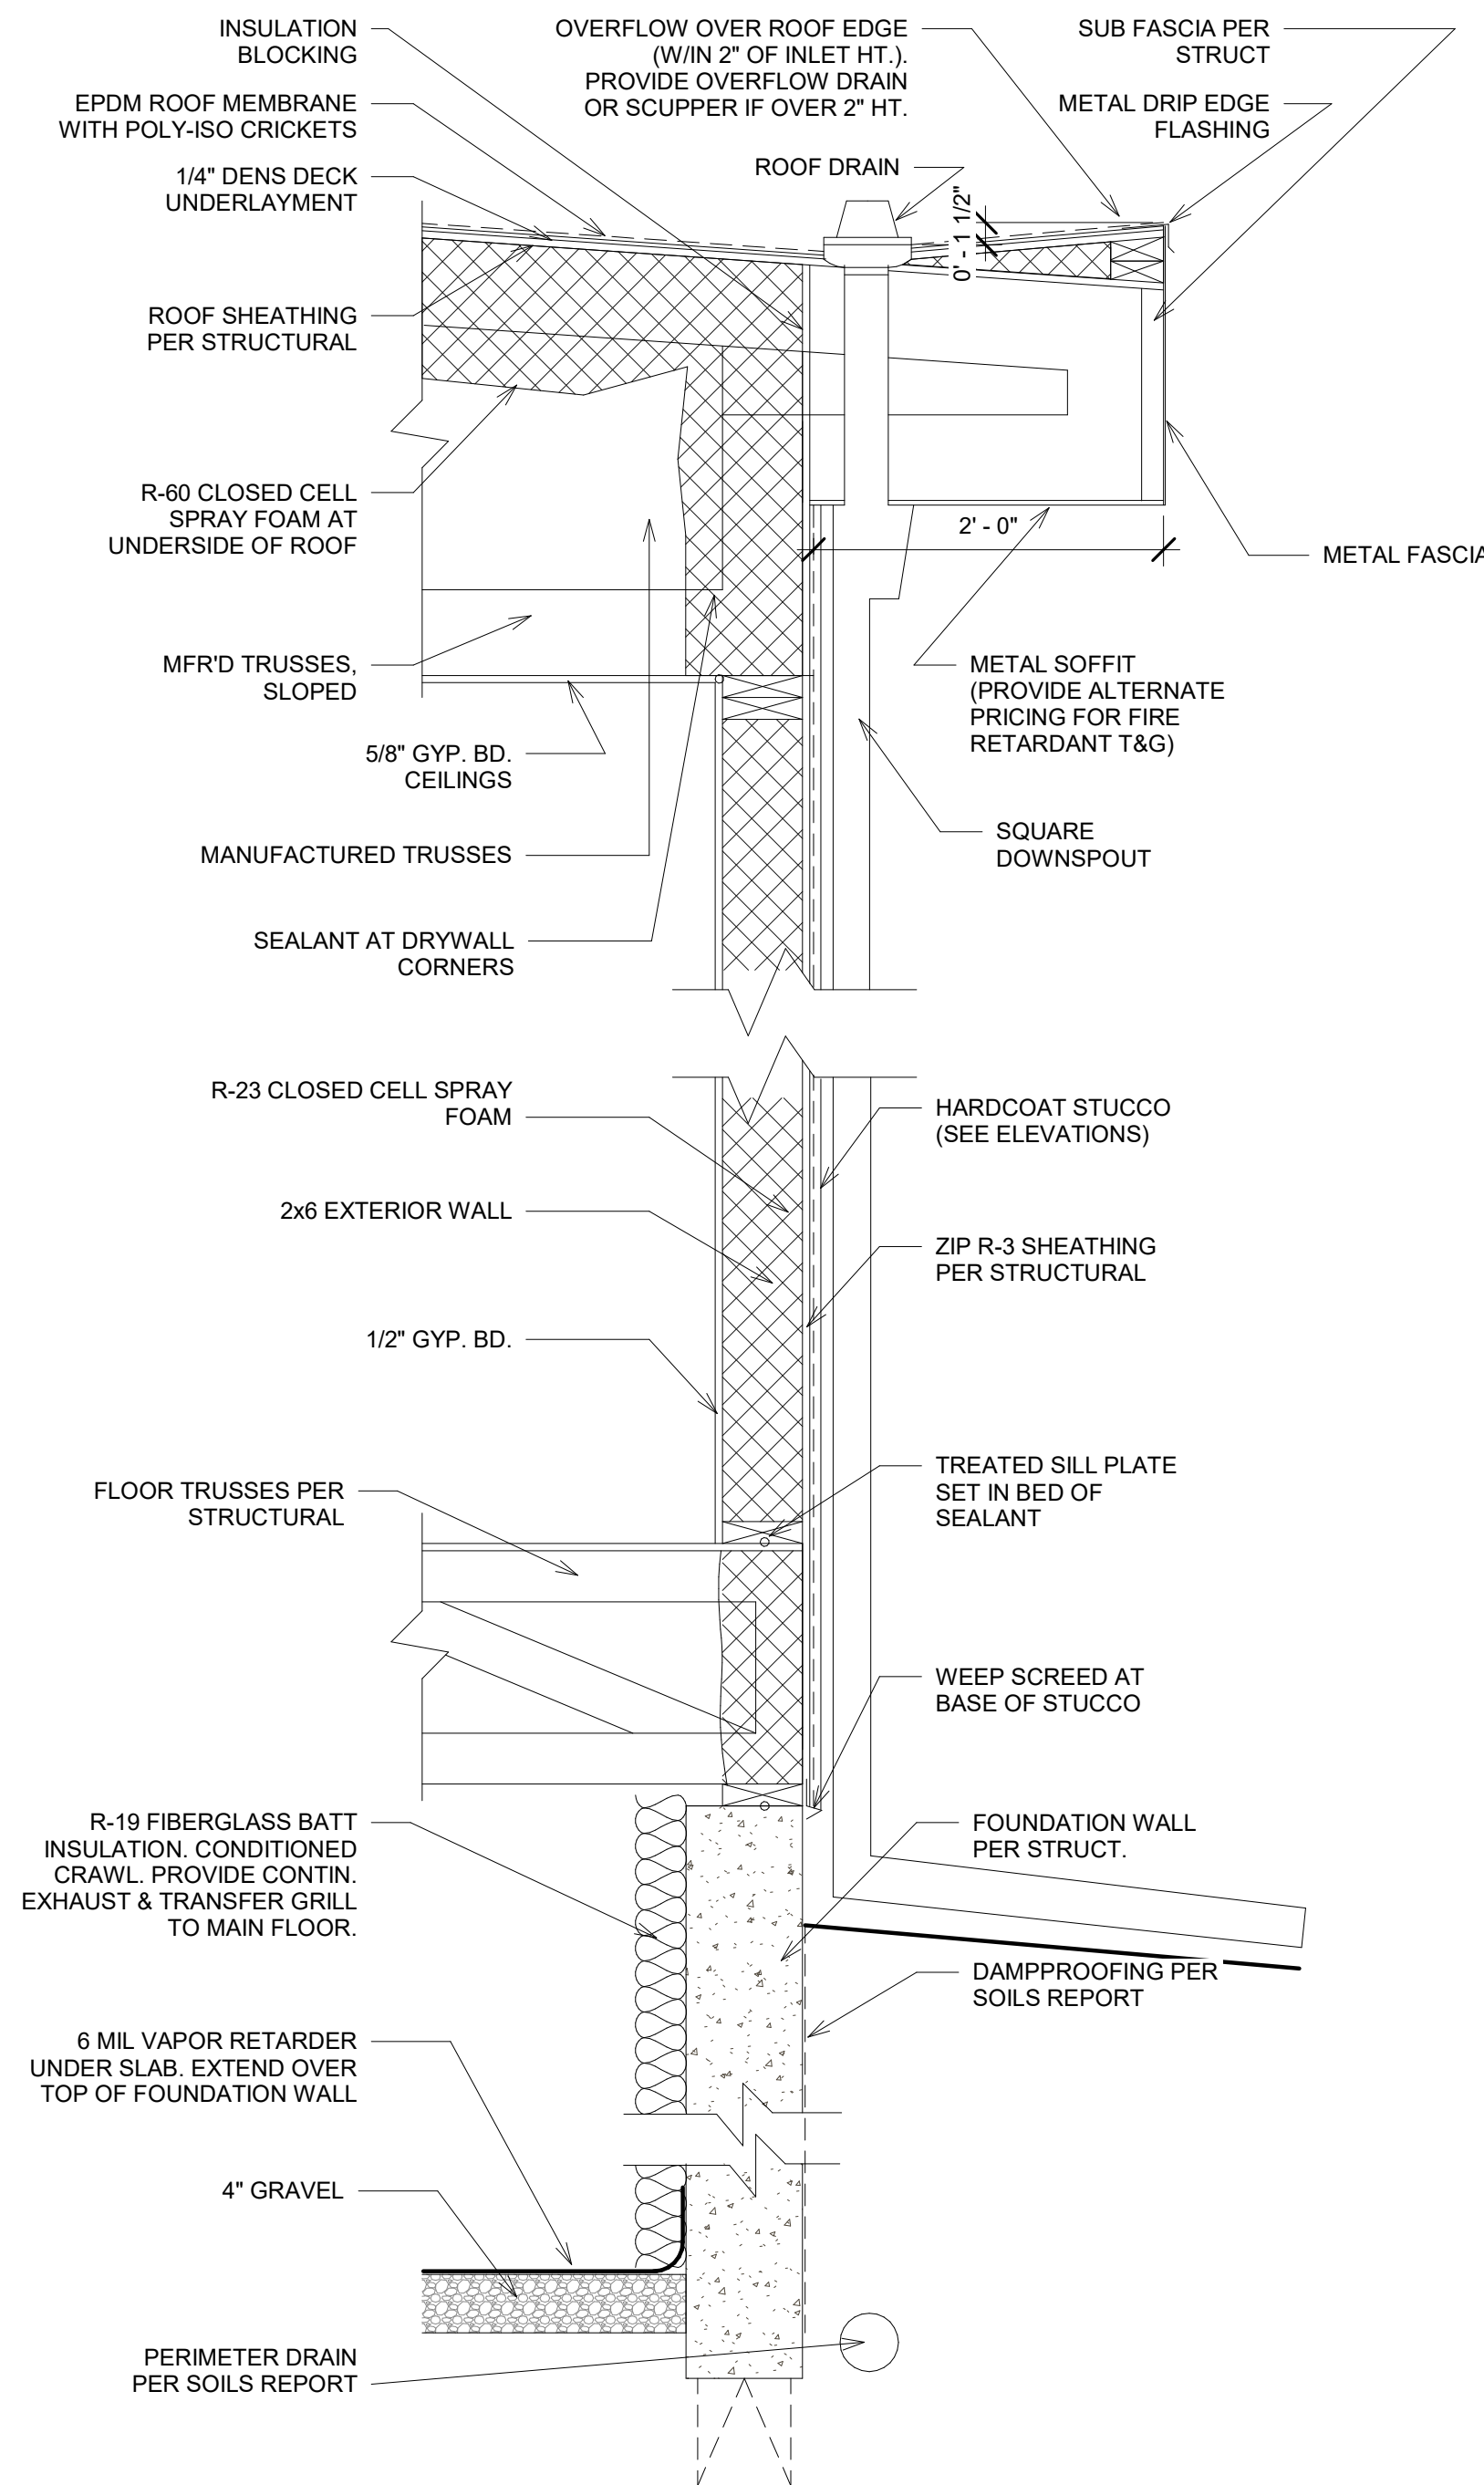


3 Typical Wall Section
1" = 1'-0"

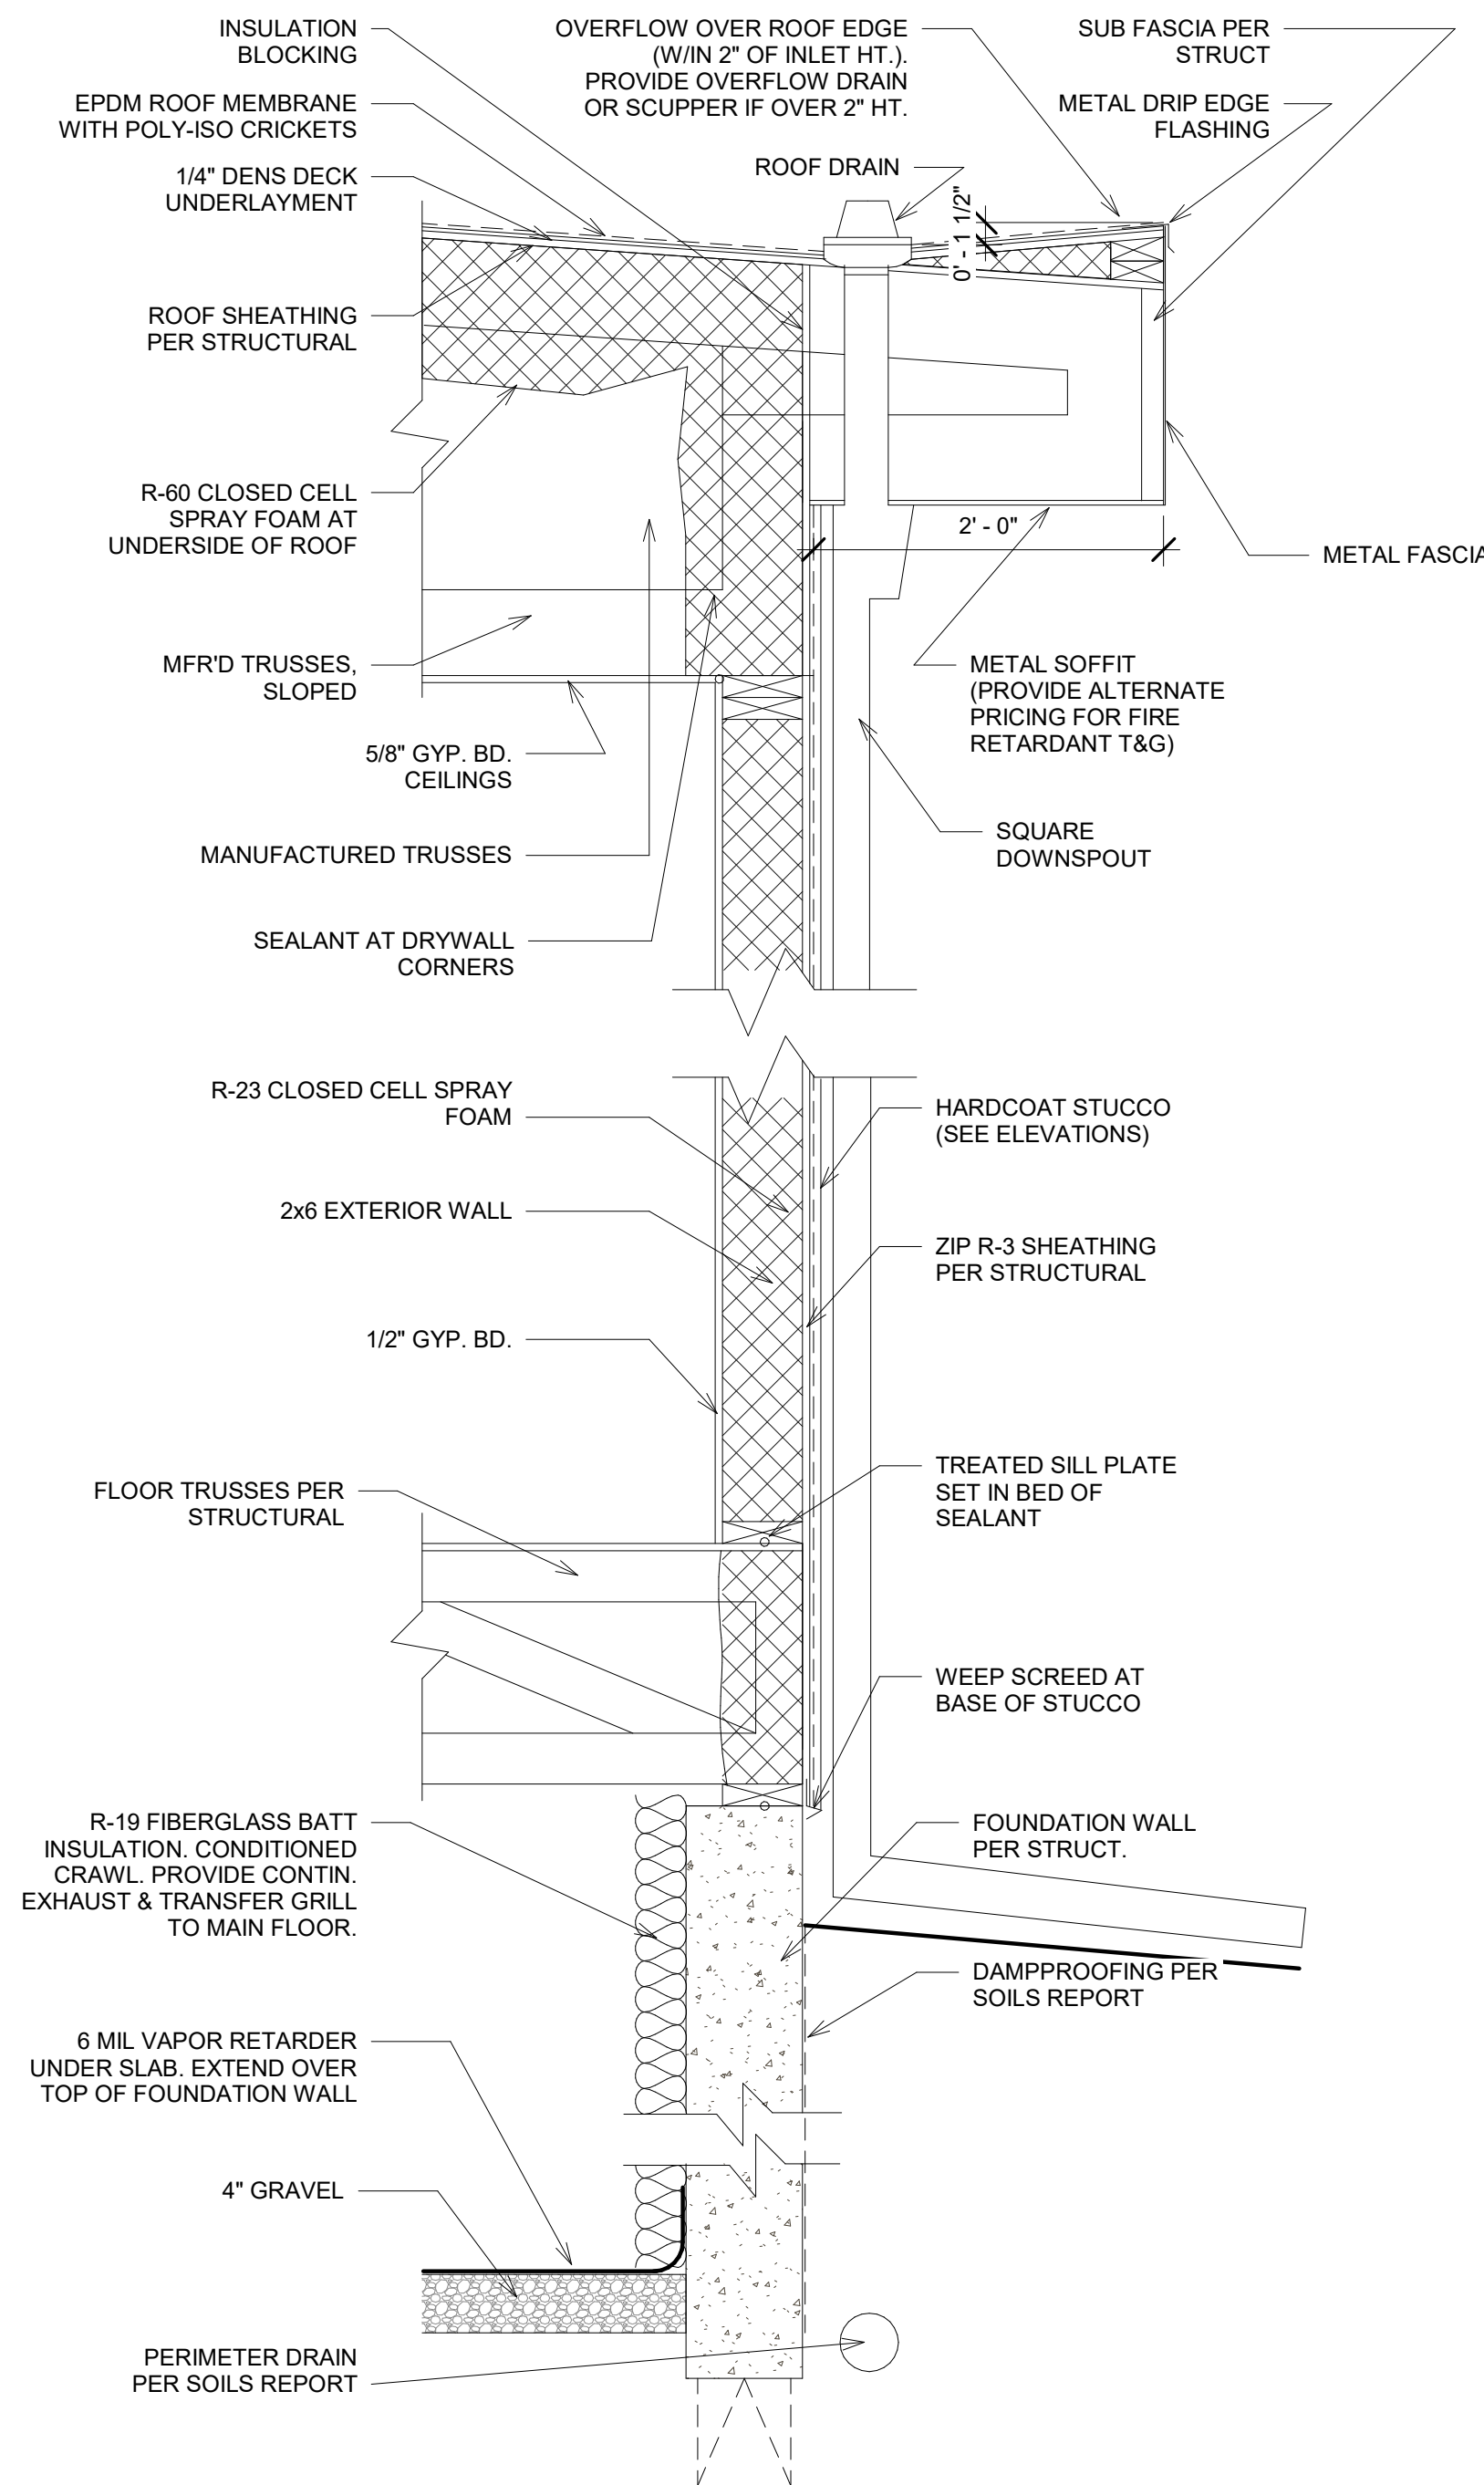


3 Typical Wall Section
1" = 1'-0"

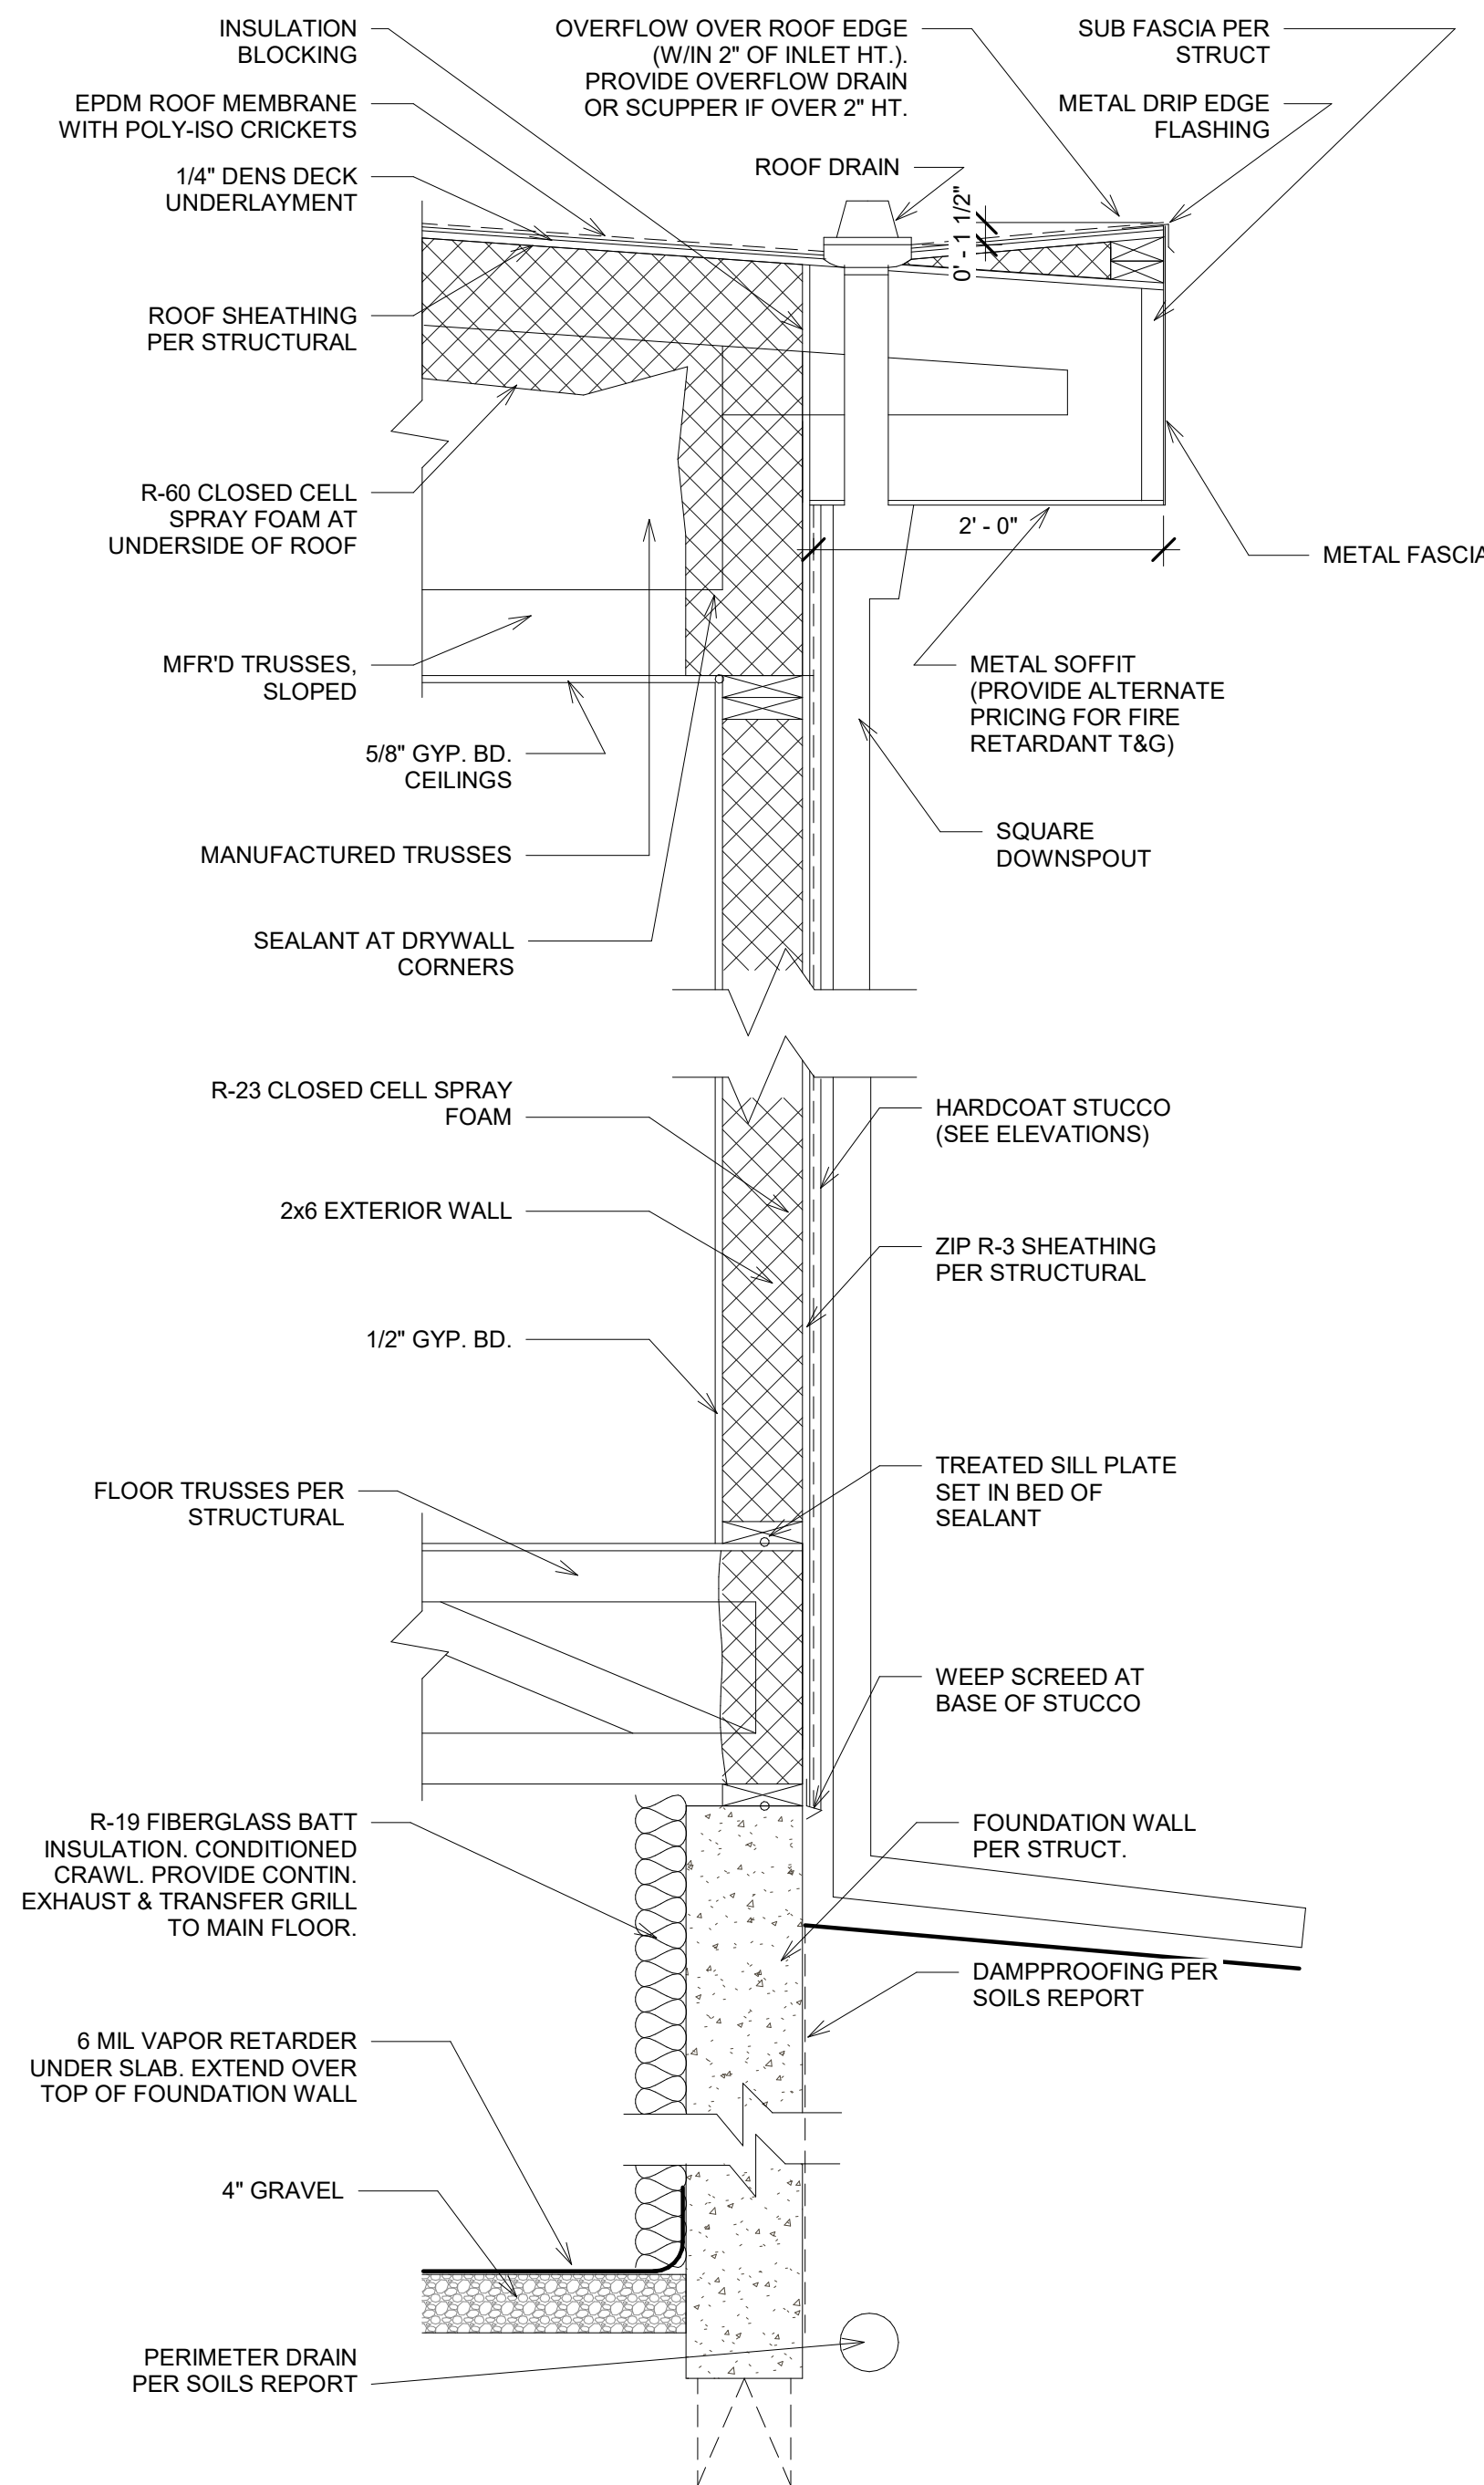


3 Typical Wall Section
1" = 1'-0"

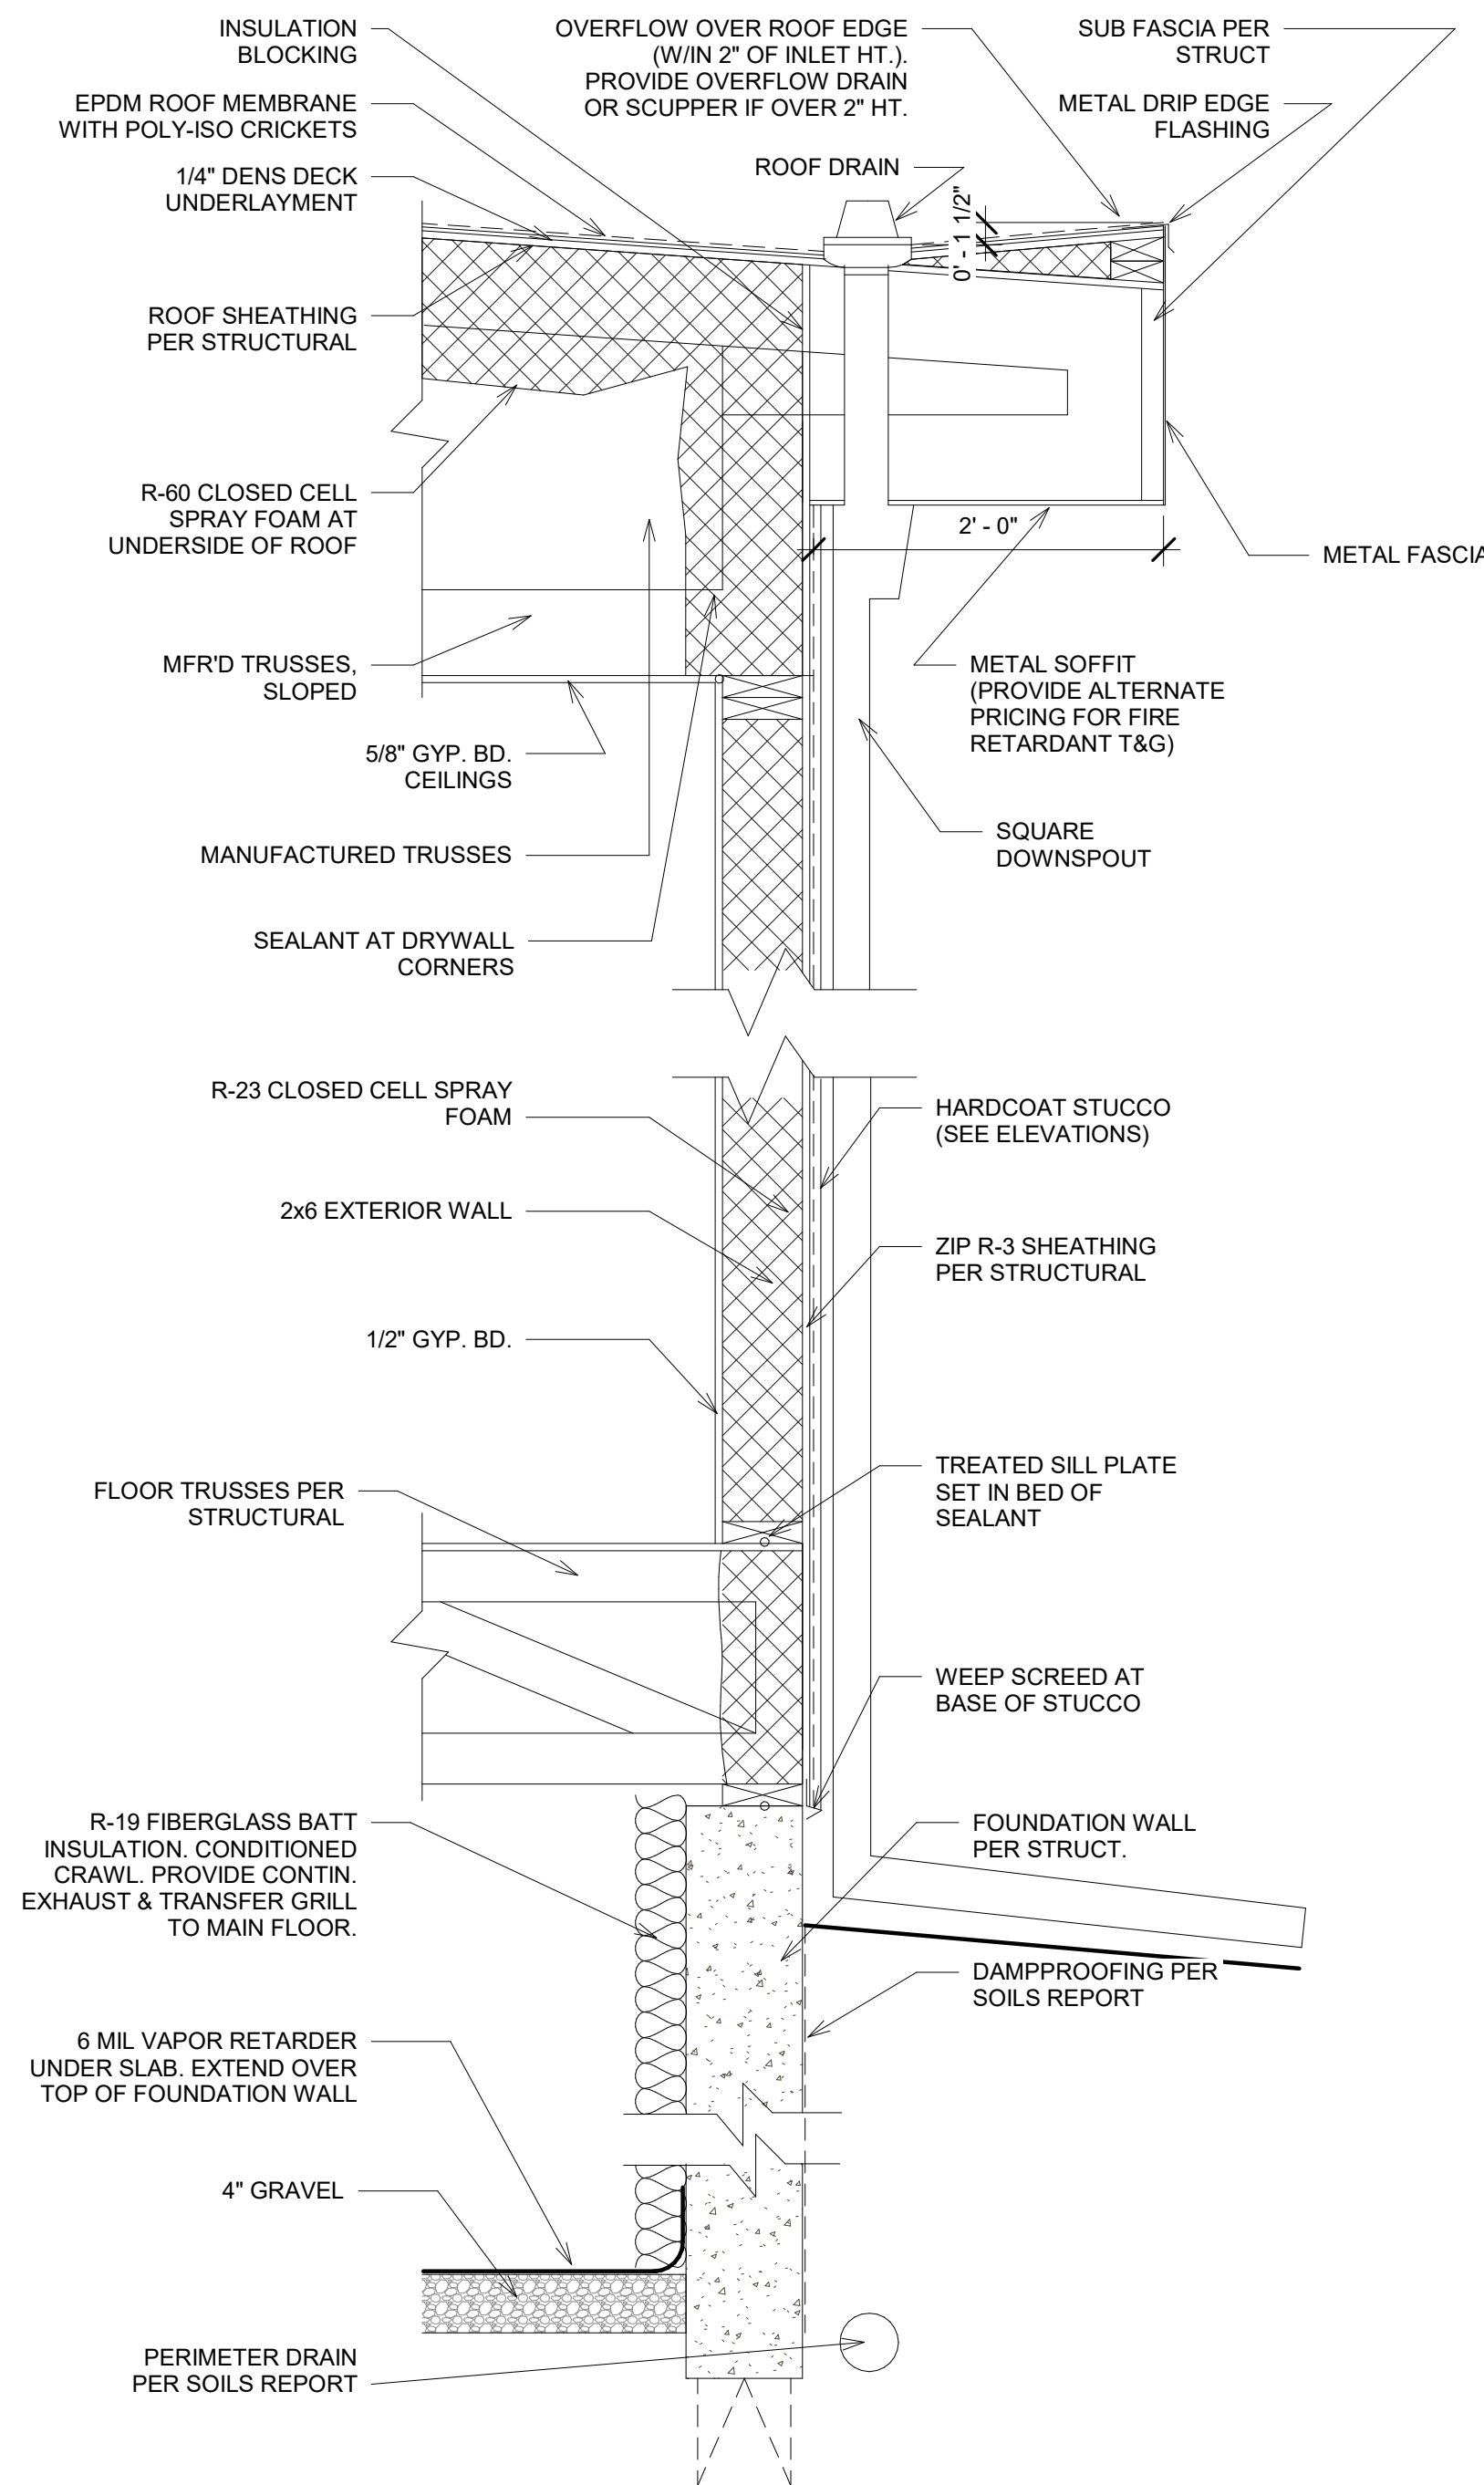

3 Typical Wall Section
1" = 1'-0"

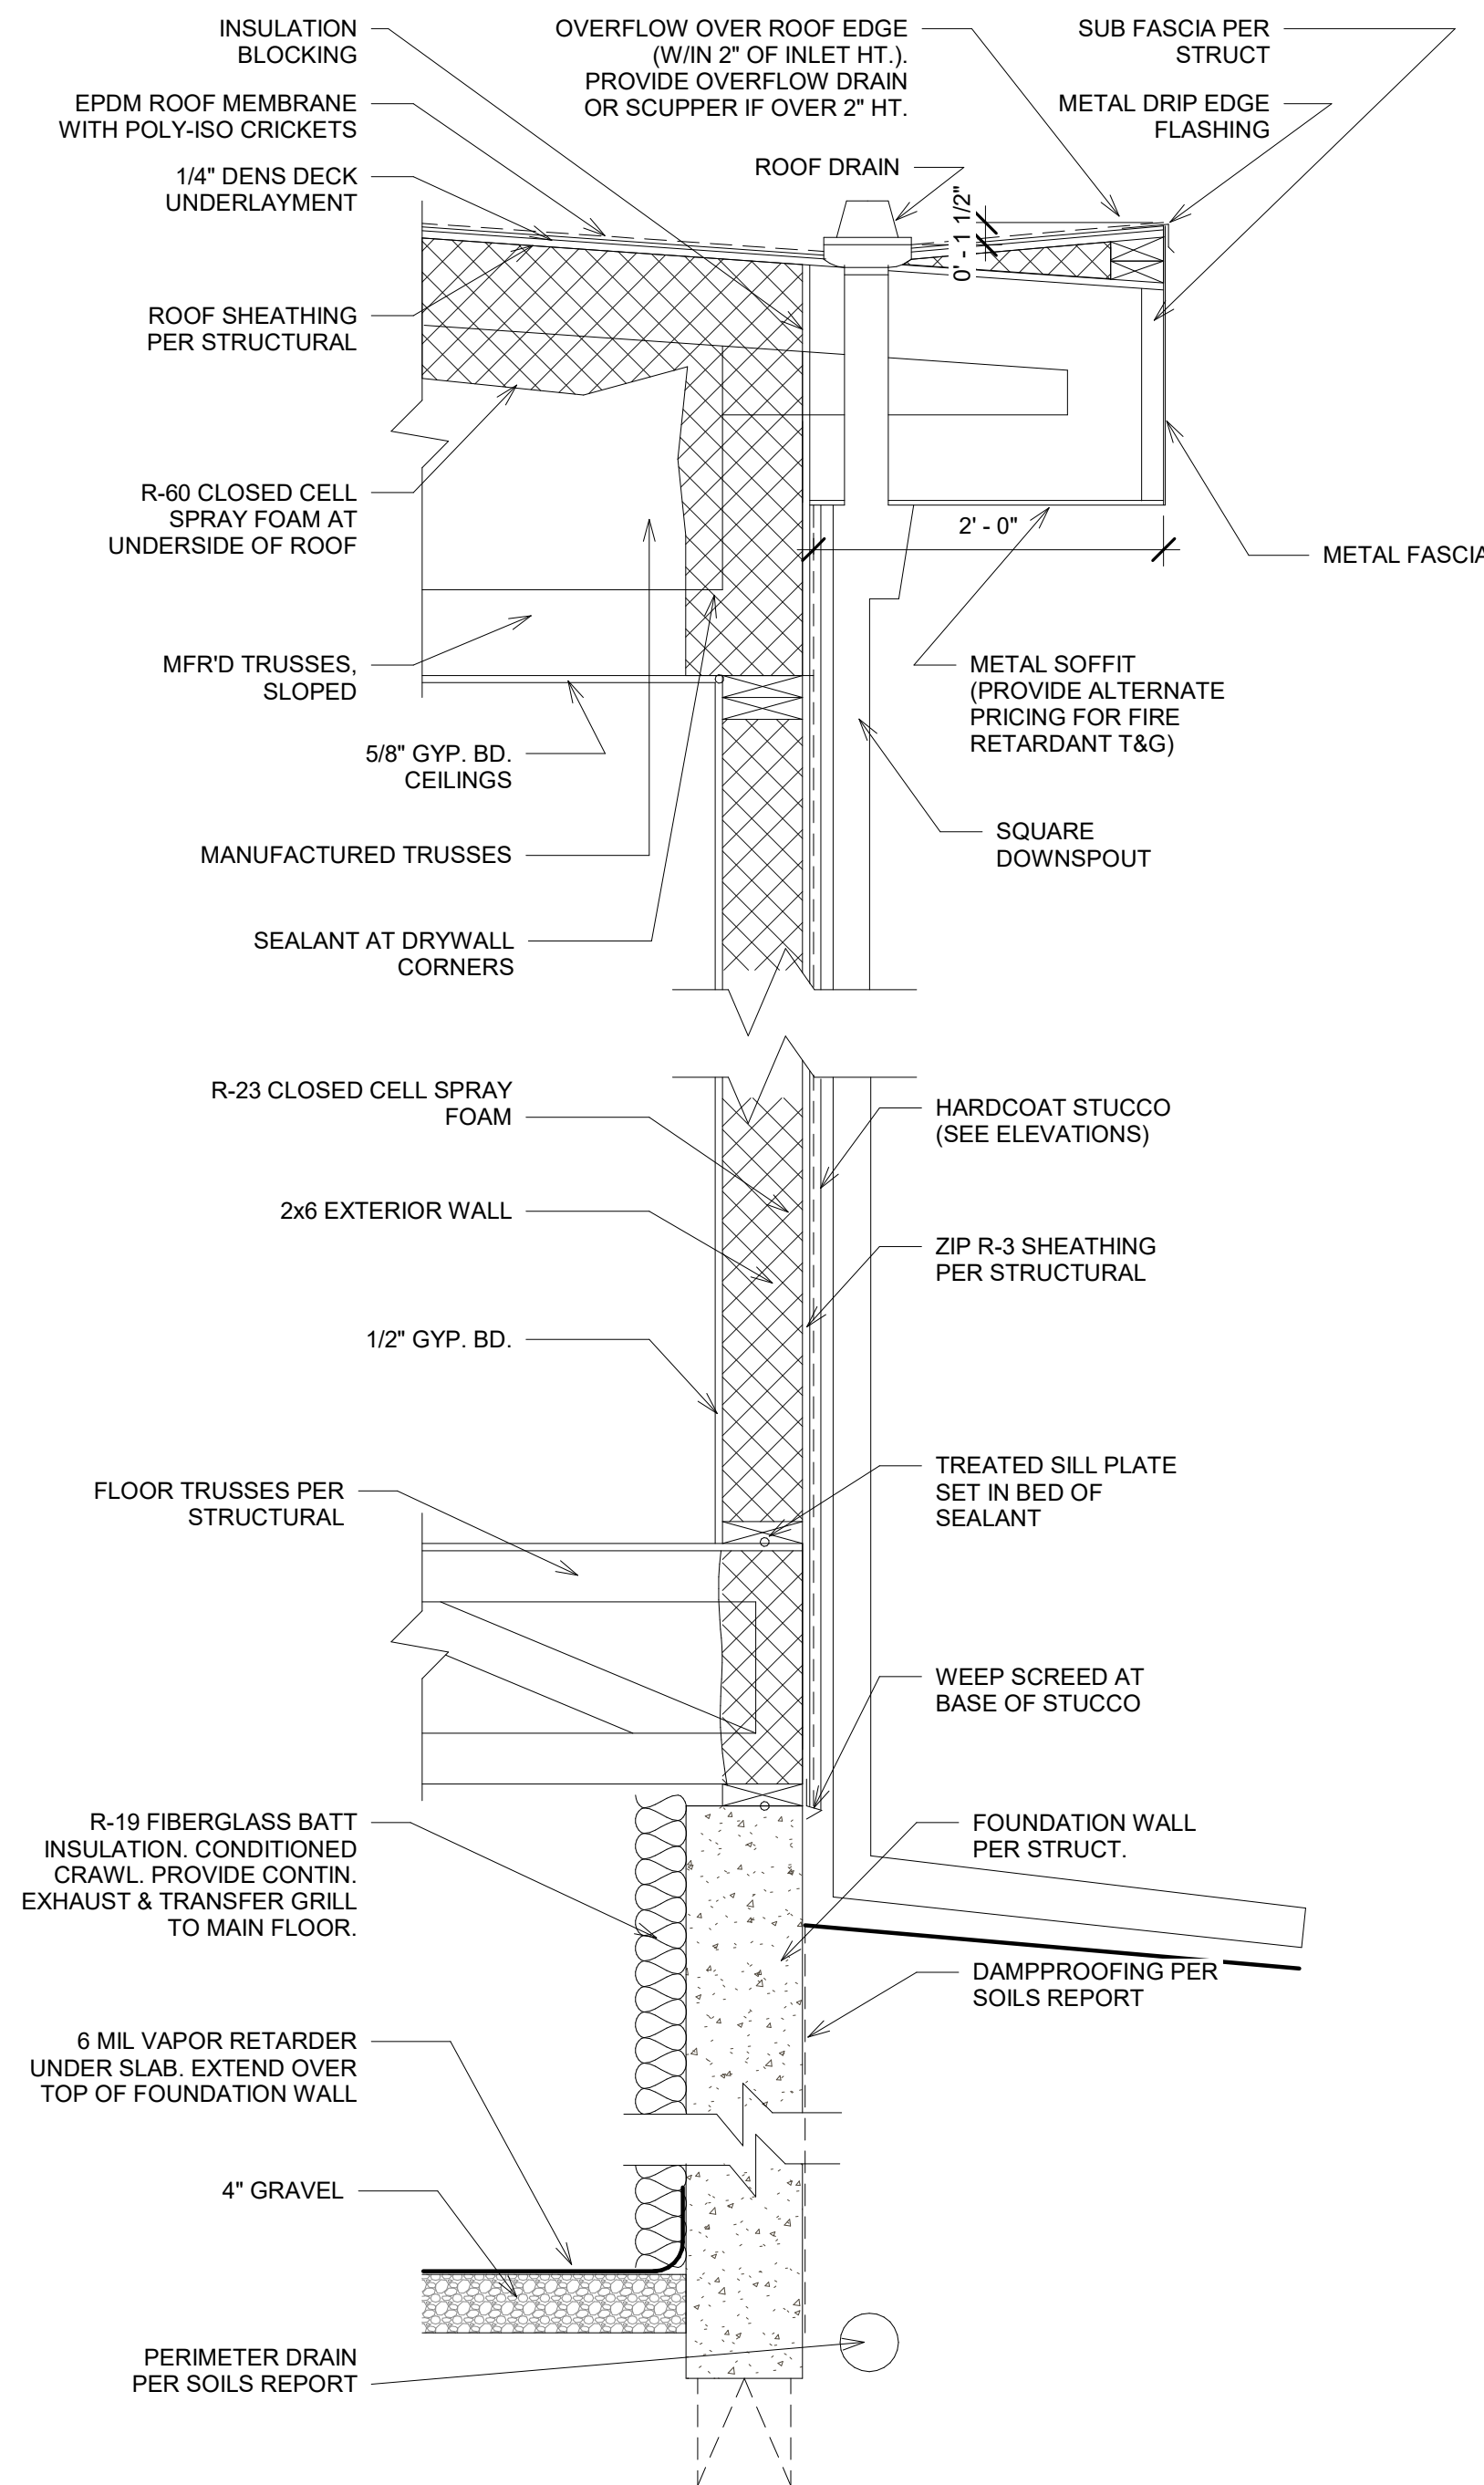

3 Typical Wall Section
1" = 1'-0"

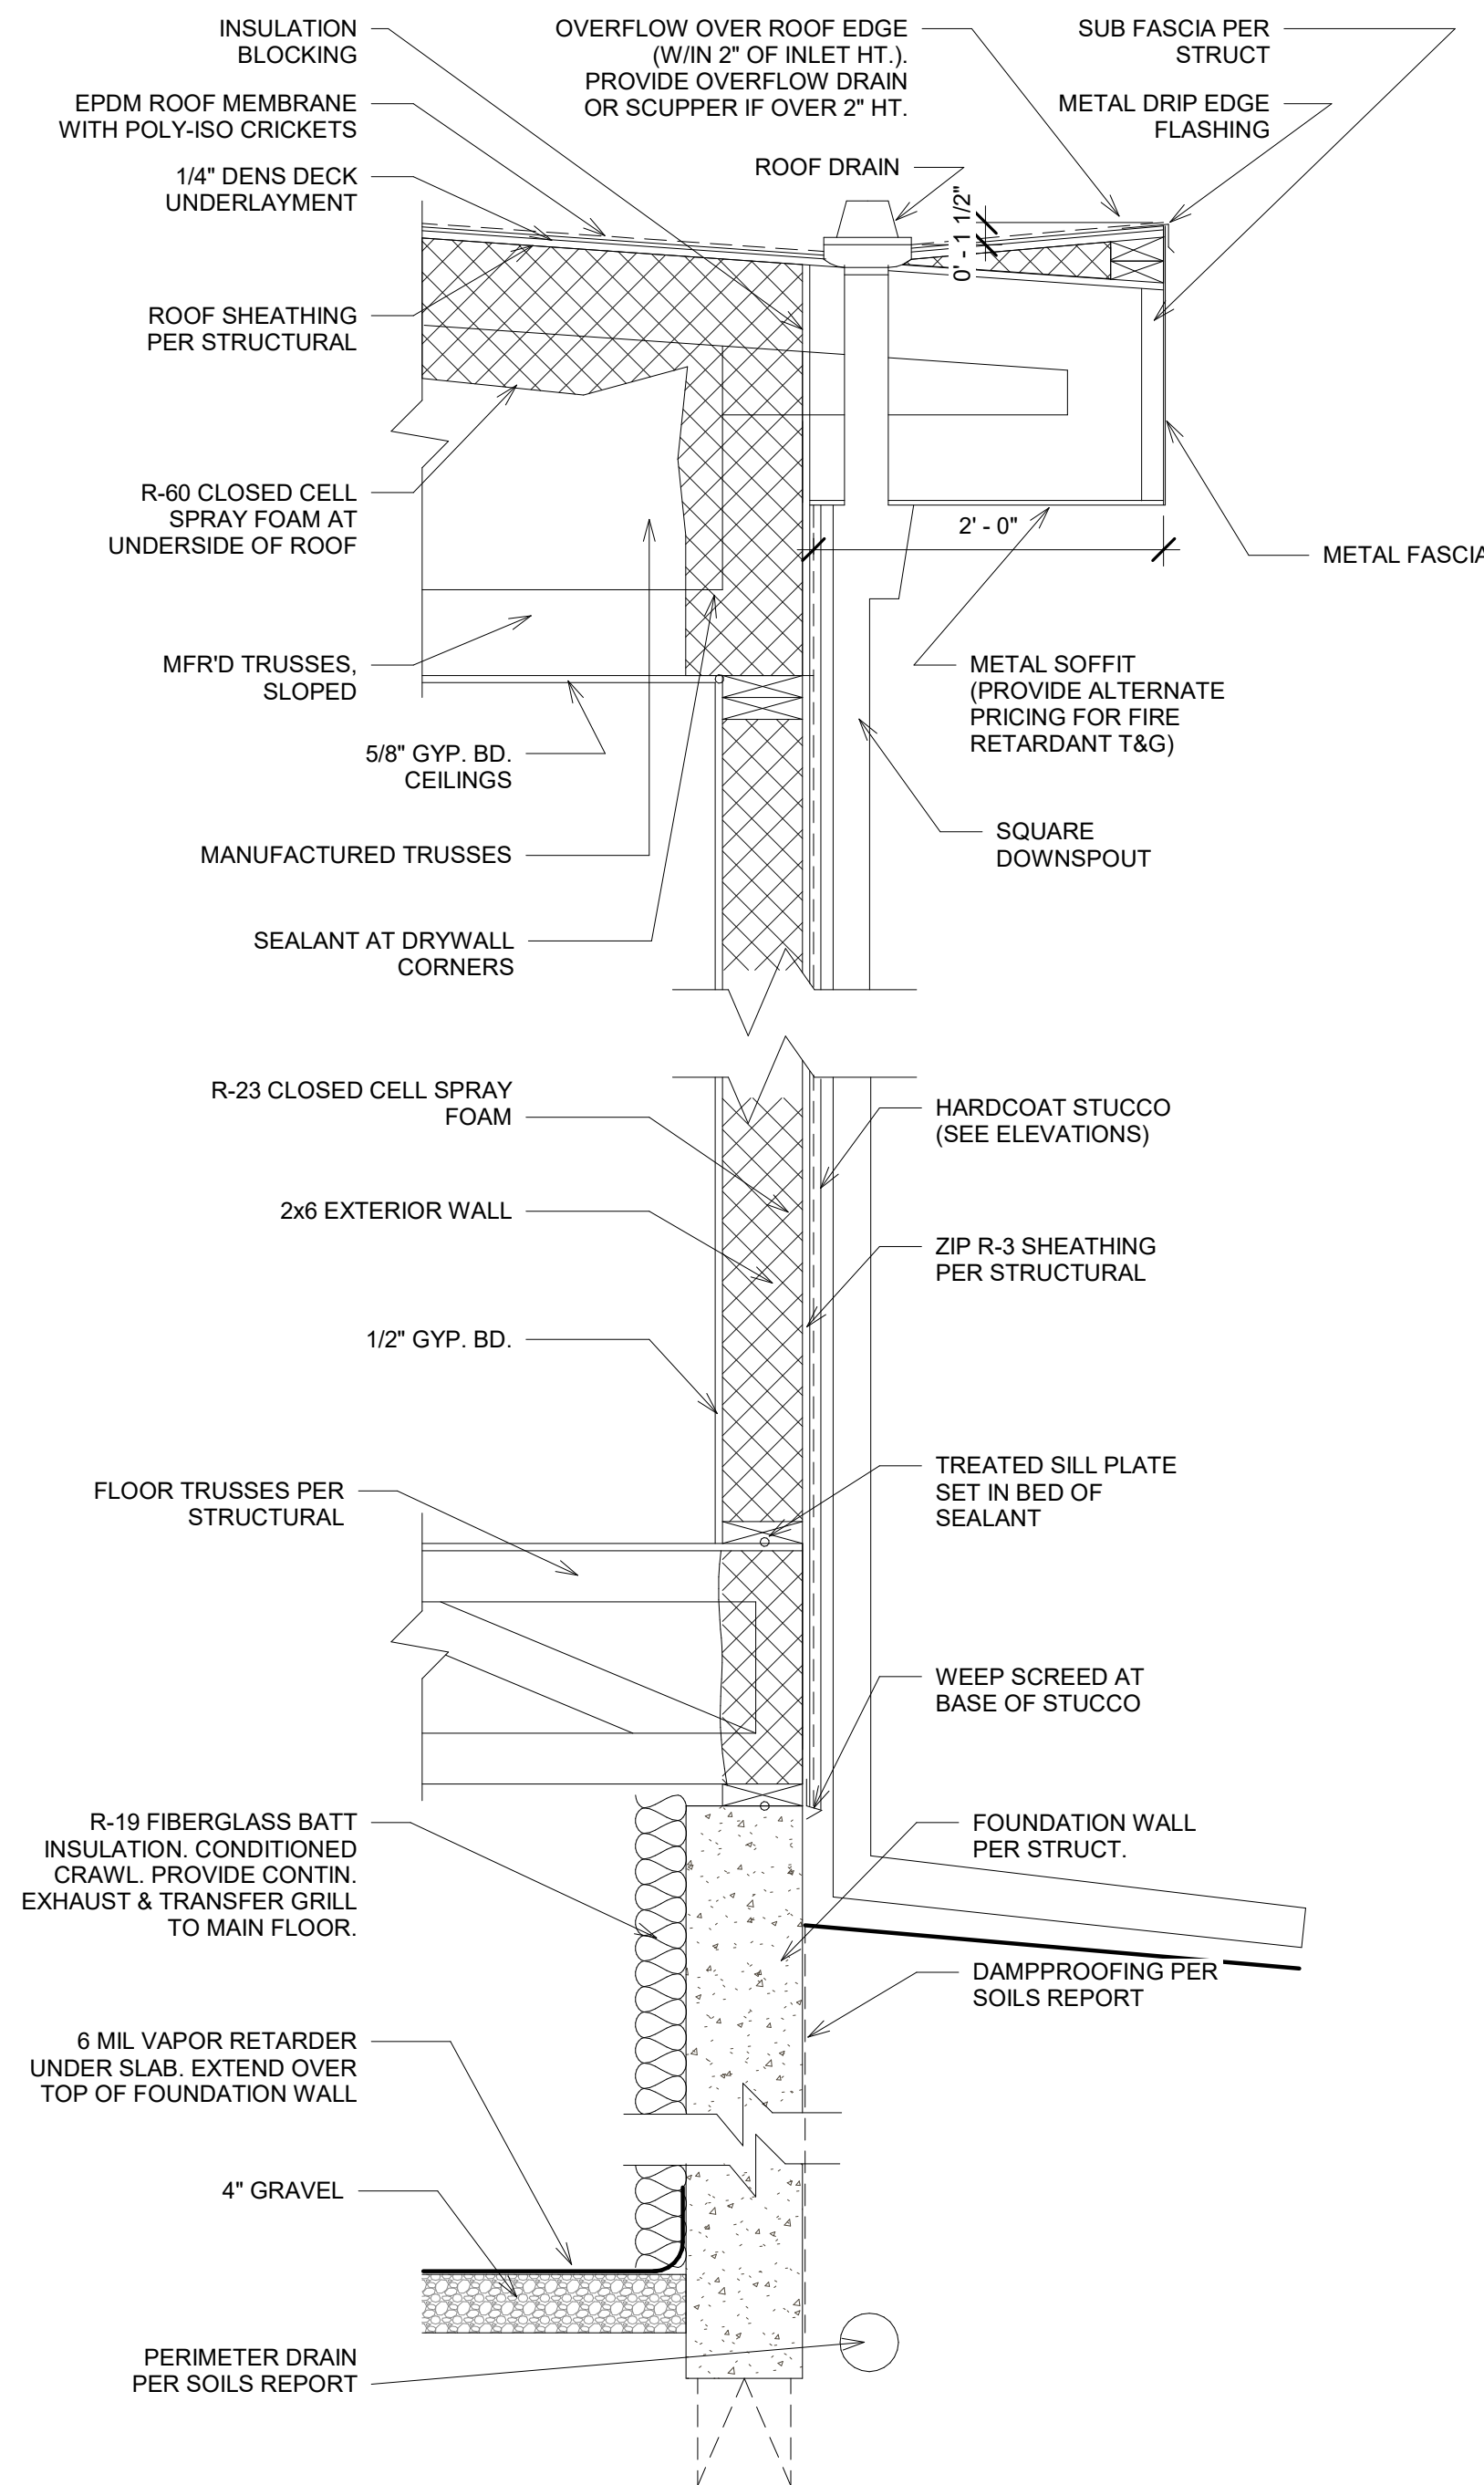

7855 SPRING DRIVE
BOULDER, CO 80303
NEW RESIDENCE


CONSTRUCTION SET -
REV 2
1/16/26

SHEET
No.
A401
Schedules & Details


Door Schedule						
Mark	Width	Rough Width	Height	Rough Height	Description	Comments
0-A	2' - 6"	2' - 8 1/2"	6' - 8"	6' - 10 1/2"	FULL LITE PATIO DOOR	
0-B	2' - 6"		6' - 8"			Frosted Glass
0-G	2' - 6"	2' - 8"	6' - 8"	6' - 10 1/2"	SINGLE	
0-H	3' - 0"	3' - 2"	6' - 8"	6' - 10 1/2"	SINGLE	INSULATED
0-J	3' - 0"	3' - 2"	6' - 8"	6' - 10 1/2"	SINGLE	INSULATED
1-A	3' - 0"	4' - 9 1/2"	6' - 8"	6' - 10 1/2"	ENTRY + SIDELITE	55.5x80 w/ Sidelite: Manhattan_MAN-SL_1-1
1-AA	3' - 0"		4' - 0"			
1-B	55.5" W/LITE	6' - 1"	6' - 8"	7' - 0 1/2"	POCKET DOOR	MAPLE
1-C	2' - 6"	2' - 8"	6' - 8"	6' - 10 1/2"	SINGLE	
1-D	2' - 6"	5' - 1"	6' - 8"	7' - 0 1/2"	POCKET DOOR	
1-E	2' - 6"	5' - 1"	6' - 8"	7' - 0 1/2"	POCKET DOOR	
1-F	2' - 6"	2' - 8"	6' - 8"	6' - 10 1/2"	SINGLE	MAPLE
1-G	2' - 0"	4' - 1"	6' - 8"	7' - 0 1/2"	POCKET DOOR	
1-H	2' - 4"	0' - 0"	6' - 8"	7' - 0 1/2"	POCKET DOOR	
1-I	4' - 0"	4' - 2"	6' - 8"	6' - 10 1/2"	DOUBLE	MAPLE
1-J	4' - 0"	4' - 2"	6' - 8"	6' - 10 1/2"	DOUBLE	MAPLE
1-K	2' - 6"	2' - 8"	6' - 8"	6' - 10 1/2"	SINGLE	MAPLE
1-L	3' - 0"	3' - 2"	6' - 8"	6' - 10 1/2"	SINGLE	20 MIN. SELF CLOSING GARAGE ENTRY
1-M	2' - 8"	5' - 5"	6' - 8"	7' - 0 1/2"	POCKET DOOR	MAPLE
1-N	2' - 8"	5' - 5"	6' - 8"	7' - 0 1/2"	POCKET DOOR	
1-O	2' - 6"	2' - 8"	6' - 8"	6' - 10 1/2"	SINGLE	MAPLE
1-P	2' - 6"	2' - 8"	6' - 8"	6' - 10 1/2"	SINGLE	
1-Q	8' - 0"	8' - 1 5/8"	8' - 0"	8' - 2 1/2"	SLIDING PATIO DOOR	
1-R	2' - 6"	2' - 8"	6' - 8"	6' - 10 1/2"	SINGLE	
1-S	2' - 6"	5' - 1"	6' - 8"	7' - 0 1/2"	POCKET DOOR	
1-T	2' - 6"	2' - 8"	6' - 8"	6' - 10 1/2"	SINGLE - GARAGE EXIT	FLUSH, INSULATED FIBERGLASS W/ WEATHERSTRIP
1-U	12' - 0"	12' - 3"	8' - 0"	8' - 1 1/2"	OVERHEAD GARAGE	
1-V	12' - 0"	12' - 3"	8' - 0"	8' - 1 1/2"	OVERHEAD GARAGE	OVERHEAD DOOR. PROVIDE OPENER
1-Y	3' - 0"	3' - 2"	6' - 8"	6' - 10 1/2"	SINGLE - GARAGE EXIT	FLUSH, INSULATED FIBERGLASS W/ WEATHERSTRIP
1-Z	18' - 0"	18' - 3"	8' - 0"	8' - 1 1/2"	OVERHEAD GARAGE	
2-A	3' - 0"	3' - 2 1/2"	6' - 8"	6' - 10 1/2"	FULL LITE PATIO DOOR	
2-B	5' - 0"	10' - 1"	6' - 8"	7' - 0 1/2"	POCKET DOOR	RE-USE EXISTING - VERIFY SIZE
2-D	2' - 6"	2' - 8"	6' - 8"	6' - 10 1/2"	SINGLE	
2-E	2' - 6"	2' - 8"	6' - 8"	6' - 10 1/2"	SINGLE	

GENERAL NOTES:

1. **CONTRACTOR TO VERIFY ALL ROUGH OPENINGS PRIOR TO FRAMING.**
2. Glazing to meet U-values listed in HERS rating
3. Provide air sealing around all doors

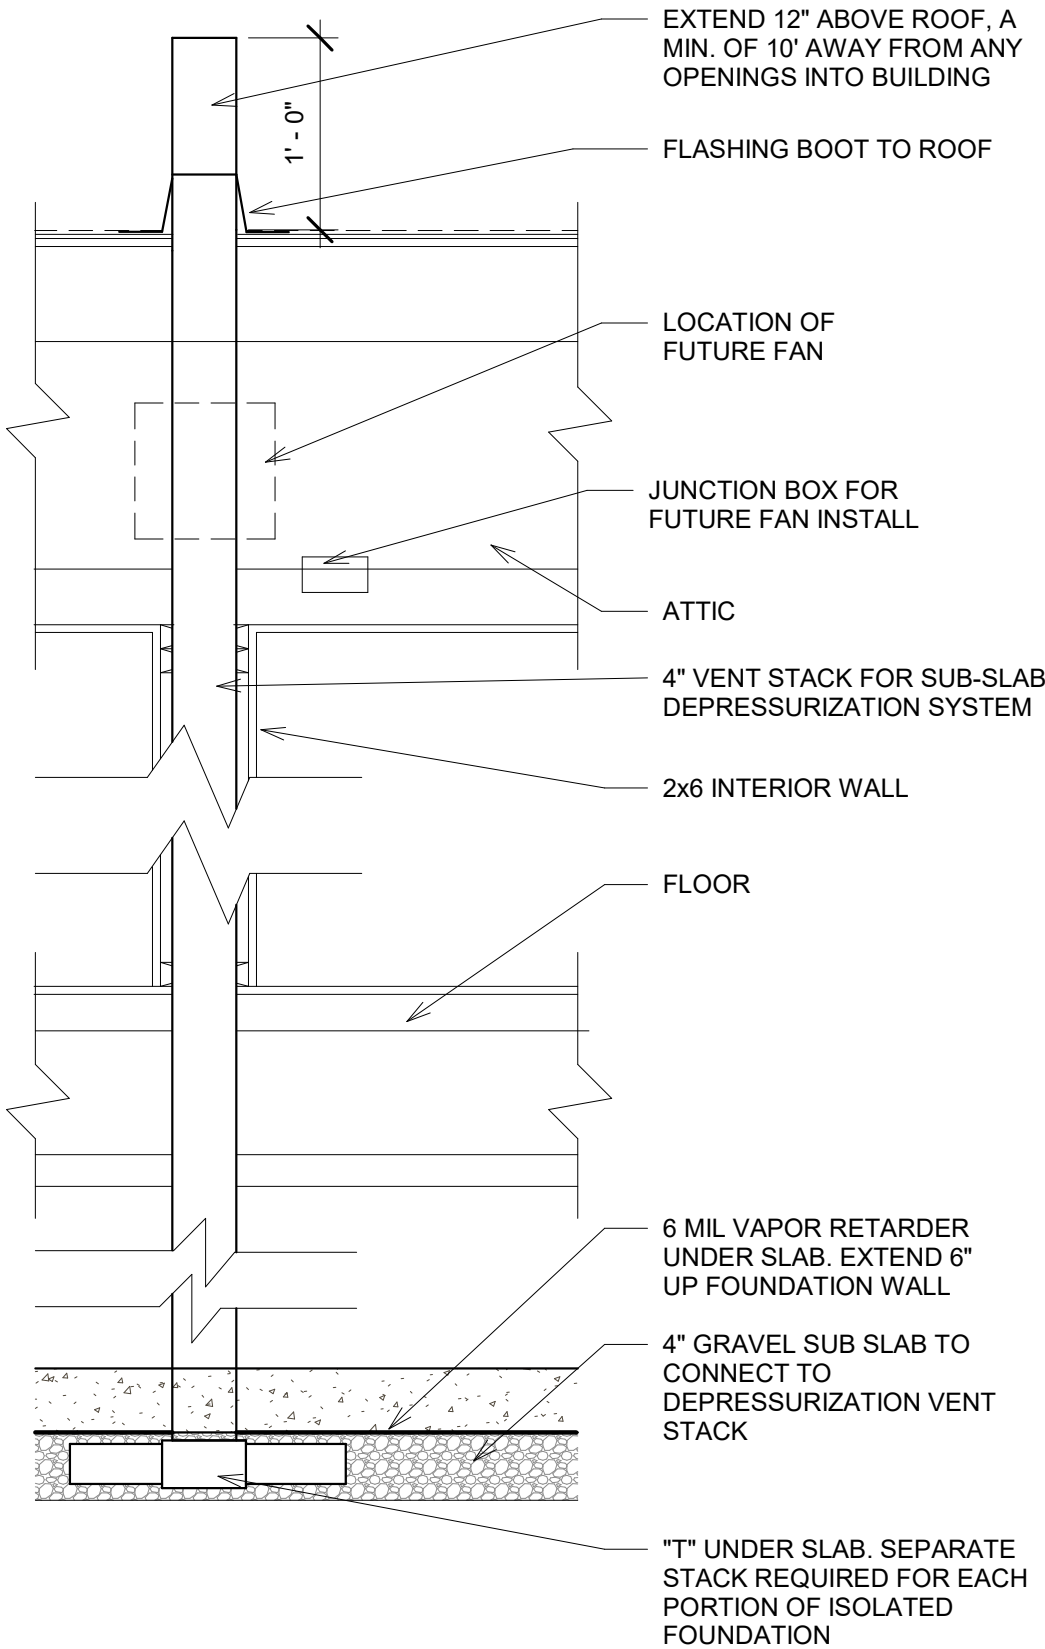


3 Radon
1" = 1'-0"

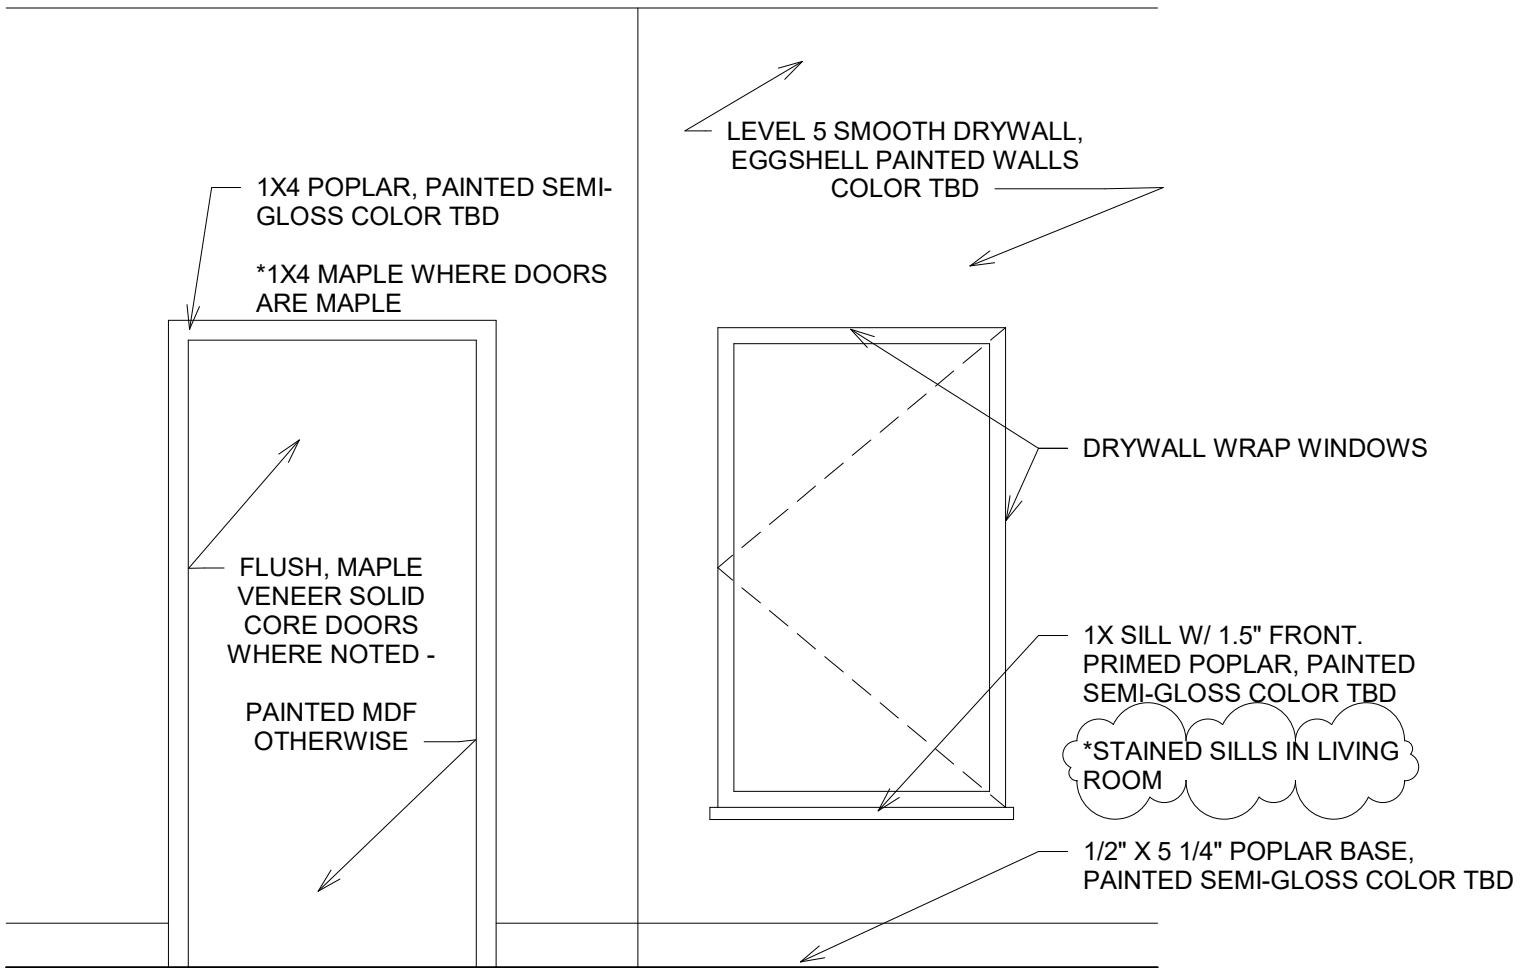

*NOT ACTUAL CONDITION, REPRESENTS INTERIOR TRIM DETAILS ONLY

4 Interior Trim Details
1/2" = 1'-0"

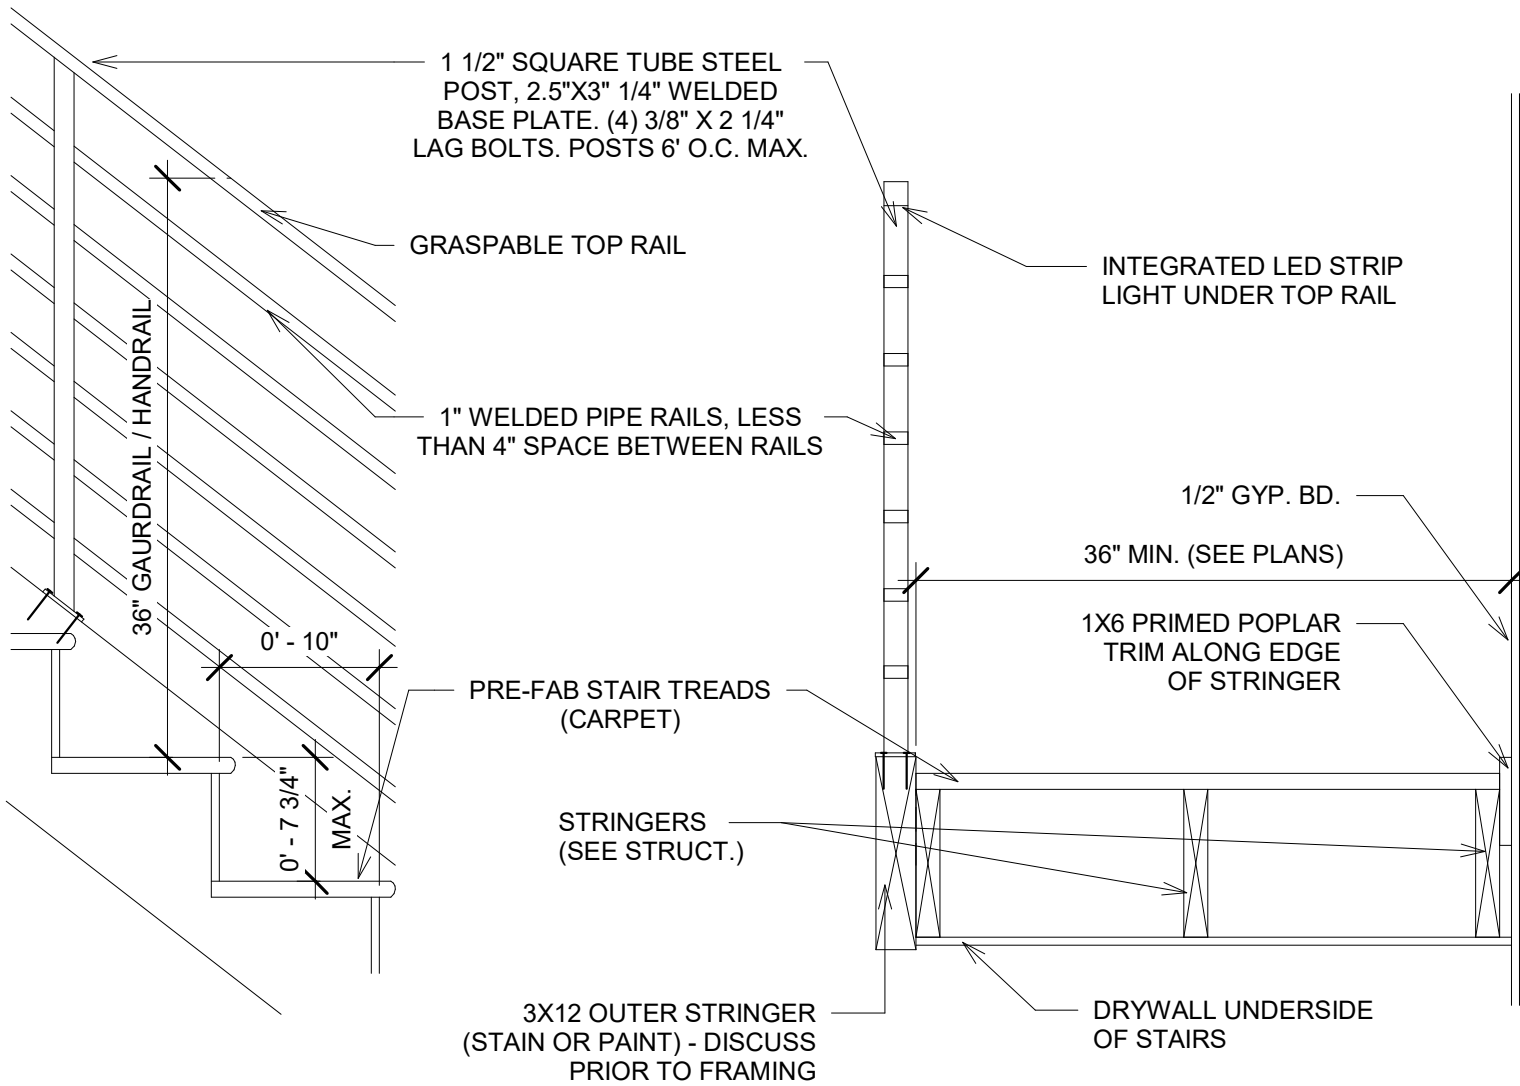

2 Interior Stair Details
1" = 1'-0"


Window Schedule									
Mark	Frame Width	Rough Width	Frame Height	Rough Height	Head Height	Sill Height	Description	Comments	
01	3' - 4"	3' - 5"	3' - 11 1/8"	3' - 11 5/8"	7' - 0 5/8"	3' - 1 1/2"	Casement	EGRESS	
02	3' - 4"	3' - 5"	3' - 11 1/8"	3' - 11 5/8"	7' - 0 5/8"	3' - 1 1/2"	Fixed		
03	3' - 4"	3' - 5"	3' - 11 1/8"	3' - 11 5/8"	7' - 0 5/8"	3' - 1 1/2"	Casement		
04	2' - 6"	2' - 7"	3' - 11 1/8"	3' - 11 5/8"	7' - 0 5/8"	3' - 1 1/2"	Casement		
05	5' - 11 1/2"	6' - 0 1/2"	3' - 11 1/8"	3' - 11 5/8"	7' - 0 5/8"	3' - 1 1/2"	Slider		
07	2' - 11 1/4"	3' - 0 1/4"	4' - 11 1/2"	5' - 0"	7' - 0 5/8"	2' - 1 1/8"	Double Hung		
08	2' - 11 1/4"	3' - 0 1/4"	4' - 11 1/2"	5' - 0"	7' - 0 5/8"	2' - 1 1/8"	Double Hung		
09	2' - 11 1/4"	3' - 0 1/4"	4' - 11 1/2"	5' - 0"	7' - 0 5/8"	2' - 1 1/8"	Double Hung	TEMPER	
11	4' - 7 1/2"	4' - 8 1/2"	4' - 7 1/2"	4' - 8"	7' - 6"	2' - 10 1/2"	Fixed	TEMPER. EXTEND COUNTER THROUGH SILL.	
12	1' - 6"	1' - 7"	4' - 11 1/8"	4' - 11 5/8"	7' - 6"	2' - 6 7/8"	Fixed		
14	9' - 0"	9' - 1"	4' - 11 1/8"	4' - 11 5/8"	7' - 6"	2' - 6 7/8"	Mulled	MULLED, EGRESS	
16	4' - 7 1/2"	4' - 8 1/2"	4' - 7 1/2"	4' - 8"	7' - 6"	2' - 10 1/2"	Fixed	TEMPER. EXTEND COUNTER THROUGH SILL.	
17	1' - 6"	1' - 7"	4' - 11 1/8"	4' - 11 5/8"	7' - 6"	2' - 6 7/8"	Fixed		
19	9' - 0"	9' - 1"	4' - 11 1/8"	4' - 11 5/8"	7' - 6"	2' - 6 7/8"	Mulled	MULLED, EGRESS	
21	2' - 0"	2' - 1"	6' - 11 1/8"	6' - 11 5/8"	8' - 11 1/2"	2' - 0 3/8"	Casement	TEMPER	
22	14' - 0"	14' - 1"	8' - 11 1/2"	9' - 0"	8' - 11 1/2"	0' - 0"	Folding Door	FOLDING PATIO DOOR. PROVIDE SCREEN.	
23	8' - 0"	8' - 1"	4' - 5 1/8"	4' - 5 5/8"	8' - 0 7/8"	3' - 7 3/4"	Folding Window	FOLDING WINDOW. FLUSH SILL. BAR HEIGHT	
24	3' - 6"	3' - 7"	4' - 5 1/8"	4' - 5 5/8"	8' - 0"	3' - 6 7/8"	Awning		
25	6' - 0"	6' - 1"	4' - 5 1/8"	4' - 5 5/8"	8' - 0"	3' - 6 7/8"	Fixed		
26	3' - 6"	3' - 7"	4' - 5 1/8"	4' - 5 5/8"	8' - 0"	3' - 6 7/8"	Awning		
27	5' - 0"	5' - 1"	1' - 11 1/8"	1' - 11 5/8"	8' - 0"	6' - 0 7/8"	Fixed		
28	1' - 6"	1' - 7"	4' - 11 1/8"	4' - 11 5/8"	8' - 2"	3' - 2 7/8"	Fixed	MATCH HEIGHT OF PATIO DOOR	
29	4' - 0"	4' - 1"	4' - 11 1/8"	4' - 11 5/8"	8' - 2"	3' - 2 7/8"	Fixed	MATCH HEIGHT OF PATIO DOOR	
30	3' - 4"	3' - 5"	4' - 11 1/8"	4' - 11 5/8"	8' - 2"	3' - 2 7/8"	Casement	MATCH HEIGHT OF PATIO DOOR	
31	3' - 4"	3' - 5"	4' - 11 1/8"	4' - 11 5/8"	8' - 0"	3' - 0 7/8"	Casement	TEMPER	
32	6' - 5"	6' - 6"	5' - 1 1/2"	5' - 2"	8' - 0"	2' - 10 1/2"	Fixed	TEMPER. EXTEND COUNTER THROUGH SILL.	
33	3' - 8"	3' - 9"	6' - 11 1/8"	6' - 11 5/8"	8' - 11 1/2"	2' - 0 3/8"	Casement		
34	2' - 0"	2' - 1"	6' - 11 1/8"	6' - 11 5/8"	8' - 11 1/2"	2' - 0 3/8"	Casement	TEMPER	
35	4' - 11 1/2"	5' - 0 1/2"	1' - 11 1/2"	2' - 0"	8' - 0"	6' - 0 1/2"	Slider	MATCH HEIGHT OF GARAGE DOOR	
36	4' - 11 1/2"	5' - 0 1/2"	1' - 11 1/2"	2' - 0"	8' - 0"	6' - 0 1/2"	Slider	MATCH HEIGHT OF GARAGE DOOR	
38	5' - 0"	5' - 1"	1' - 11 1/8"	1' - 11 5/8"	9' - 0"	7' - 0 7/8"	Fixed		
39	5' - 0"	5' - 1"	1' - 11 1/8"	1' - 11 5/8"	9' - 0"	7' - 0 7/8"	Fixed		
40	1' - 6"	1' - 7"	7' - 6"	7' - 6 1/2"	9' - 0"	1' - 6"	Fixed	TEMPER	
41	2' - 0"	2' - 1"	3' - 11 1/8"	3' - 11 5/8"	13' - 1"	9' - 1 7/8"	Fixed	TEMPER. HEAD HEIGHT ABOVE BASEMENT. SEE 6/A300)	
42	2' - 0"	2' - 1"	6' - 5 1/8"	6' - 5 5/8"	12' - 3 3/4"	5' - 10 5/8"	Fixed	TEMPER. FIELD MULL TO WINDOW 43	
43	2' - 0"	2' - 1"	6' - 5 1/8"	6' - 5 5/8"	7' - 3"	0' - 9 7/8"	Fixed	HEAD HEIGHT ABOVE LEVEL 2 (SEE 6/A300)	
44	6' - 0"	6' - 1"	3' - 11 1/8"	3' - 11 5/8"	7' - 0"	3' - 0 7/8"	Fixed	TEMPER	
45	3' - 8"	3' - 9"	3' - 11 1/8"	3' - 11 5/8"	7' - 0"	3' - 0 7/8"	Casement	EGRESS	
46	8' - 2"	8' - 1"	3' - 11 1/8"	3' - 11 5/8"	7' - 0"	3' - 0 7/8"	Mulled	MULLED	
48	8' - 2"	8' - 1"	3' - 11 1/8"	3' - 11 5/8"	7' - 0"	3' - 0 7/8"	Mulled	MULLED	
50	4' - 1 1/2"	4' - 2 1/2"	4' - 1 1/2"	4' - 2"	7' - 0"	2' - 10 1/2"	Fixed	TEMPER. EXTEND COUNTER THROUGH SILL.	
51	2' - 0"	2' - 1"	3' - 11 1/8"	3' - 11 5/8"	7' - 0"	3' - 0 7/8"	Fixed		
52	2' - 0"	2' - 1"	3' - 11 1/8"	3' - 11 5/8"	7' - 0"	3' - 0 7/8"	Fixed		
53	2' - 0"	2' - 1"	3' - 11 1/8"	3' - 11 5/8"	7' - 0"	3' - 0 7/8"	Casement		
54	3' - 8"	3' - 9"	3' - 11 1/8"	3' - 11 5/8"	7' - 0"	3' - 0 7/8"	Fixed		
65	4' - 7 1/2"	4' - 8 1/2"	1' - 11 1/8"	1' - 11 5/8"	9' - 0"	7' - 0 7/8"	Fixed	TRANSOM. COORD. W/ DOOR WIDTH	

GENERAL NOTES:

1. Glazing to meet U-values per code values listed in HERS rating
2. Windows tempered per code as noted
3. Windows to meet Egress as noted
4. See Elevations for Window and Door operation, and for mulled units
5. Provide tempered glazing where required by code
6. Provide air sealing around all windows
7. **CONTRACTOR TO VERIFY ALL ROUGH OPENINGS PRIOR TO FRAMING.**

AIR SEALING NOTES:

1. SET ALL SILL PLATES IN BED OF SEALANT
2. SET ALL EXTERIOR DOORS IN BED OF SEALANT
3. BEAD OF SEALANT AT ALL WALL TO CEILING CONNECTIONS
4. SEAL ALL WALL AND CEILING PENETRATIONS TO DRYWALL
5. FOAM ALL WINDOW TO WALL GAPS
6. CONTINUOUS AIR BARRIER SHOULD BE INSTALLED IN THE THERMAL ENVELOPE. SEAL ALL PENETRATIONS.
7. RIM JOISTS SHALL BE INSULATED
8. INSULATION TO BE TRIMMED BEHIND ALL BOXES, WIRING & PLUMBING
9. INSULATE AND AIR SEAL BEHIND ANY SHOWER OR TUBS ON EXTERIOR WALLS
10. RECESSED GAPS TO BE IC RATED WITH MAX 2 CFM
11. DUCT SEALING AND AIR LEAKAGE TESTING TO BE PERFORMED
12. BLOWER DOOR TESTING TO BE 3ACH MIN. (UNLESS STATED DIFFERENTLY IN HERS RATING, IF APPLICABLE
13. INSULATION VALUES TO FOLLOW HERS OR PRESCRIPTIVE PATH
14. SEE MANUAL JDS FOR HVAC SPECIFICS & DUCT INSULATION

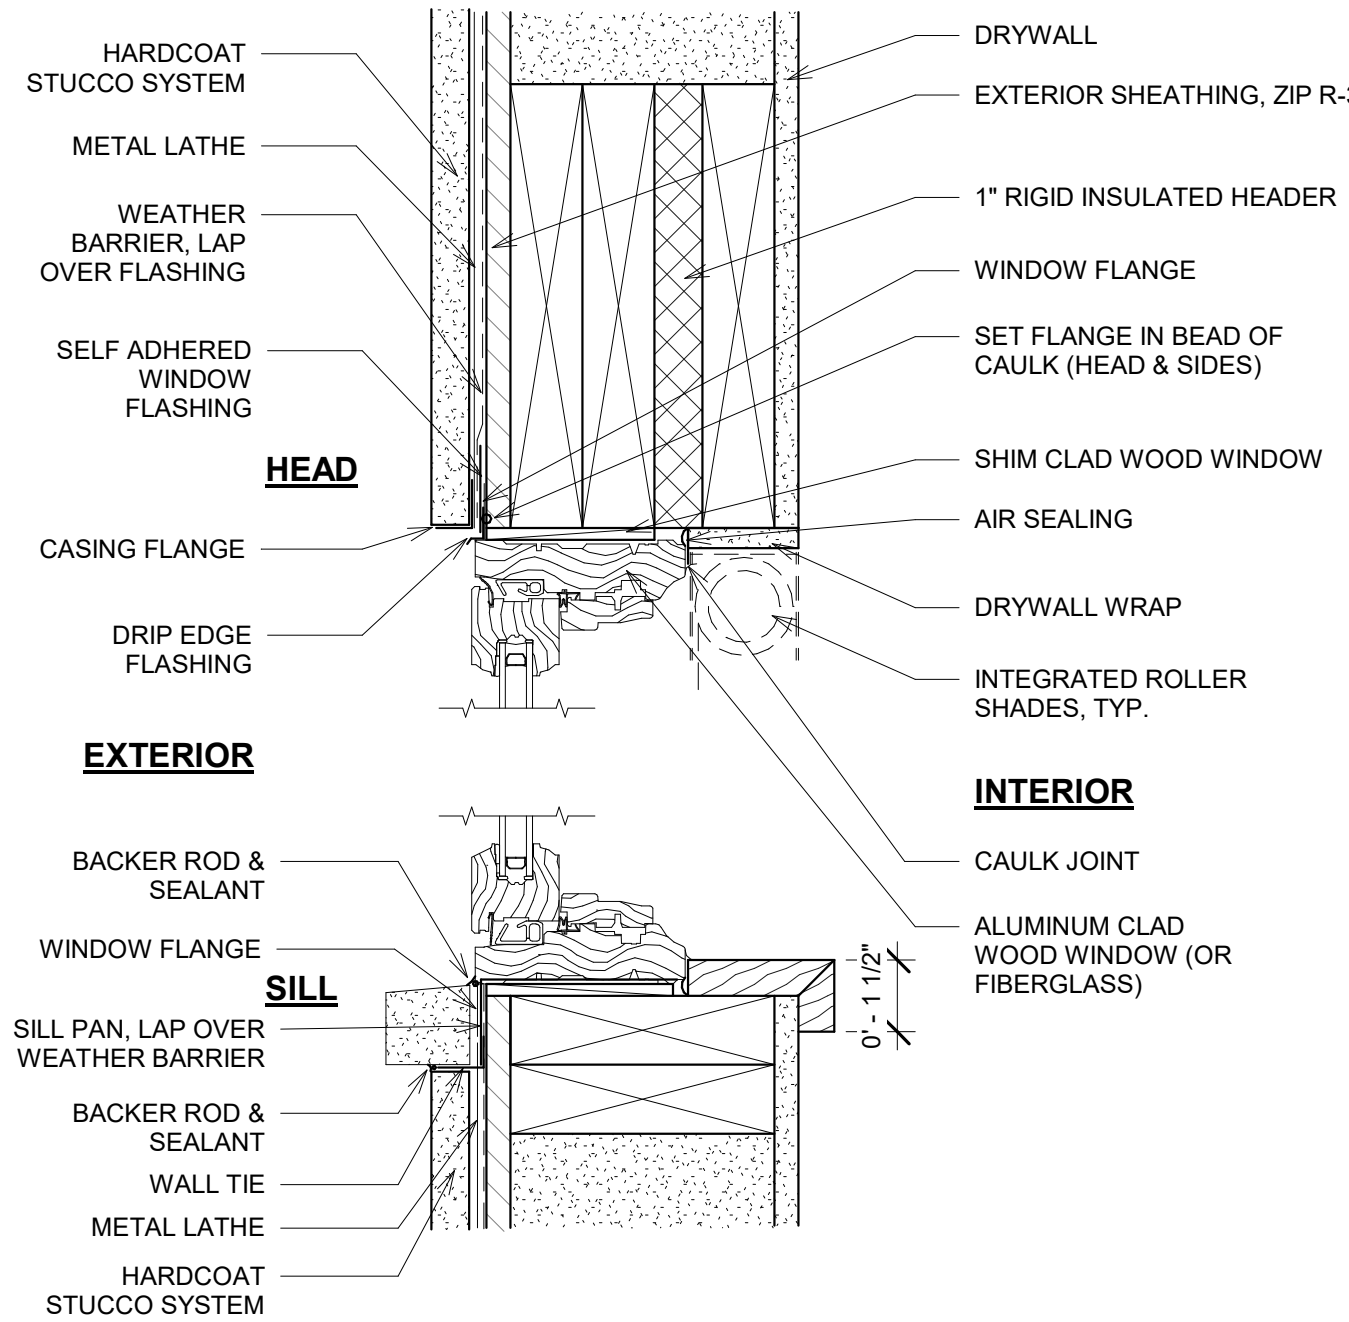



1 Window @ Stucco
3" = 1'-0"

City Series CP50E Gas Fireplace

MODEL	CP50E-NG	CP50E-LP
Fuel Type	Natural Gas	Propane
Minimum Supply Pressure	5" W.C. (1.25 kPa)	11" W.C. (2.73 kPa)
Manifold Pressure - High	3.8" W.C. (0.94 kPa)	10.5" W.C. (2.62 kPa)
Manifold Pressure - Low	1.1" W.C. (0.27 kPa)	2.9" W.C. (0.72 kPa)
Orifice Size -Altitude 0-4500 ft	# 36 DHS	# 52 DHS
Minimum Input Altitude 0-4500 ft. (0-1372m)	19,000 Btu/h (5.56 kW)	17,000 Btu/h (4.98 kW)
Maximum Input Altitude 0-4500 ft. (0-1372m)	35,000 Btu/h (10.25 kW)	33,000 Btu/h (9.66 kW)
Vent Sizing (non Power Vent)	5" Inner /8" Outer	5" Inner /8" Outer
CSA P.4.1.	57.49%	60.55%

Note: This unit comes with a 5" (127 mm) inner and 8" (203 mm) outer collar which must be reduced to 4" x 6-5/8" (102 mm x 168 mm) in all applications when installed as a power vent.

CP50E Dimensions

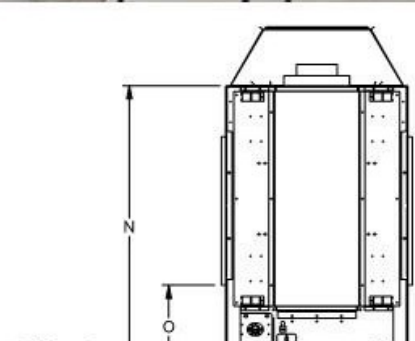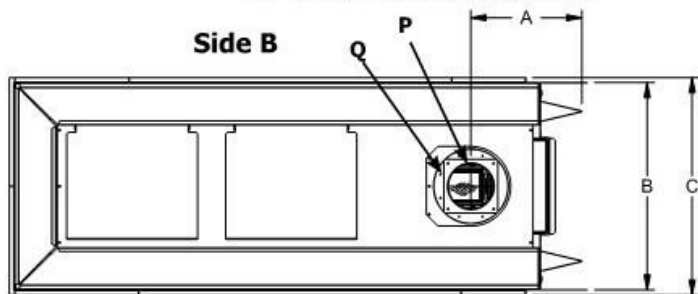

Item	Description	Measurement
A	Exhaust Center to Standoff	11-7/8" (301 mm)
B	Unit Body Depth	22-3/16" (564 mm)
C	Width (Lip to Lip)	23-3/16" (590 mm)
D	Nailing Strip	61-3/4" (1568 mm)
E	Glass Center to Lip	28-1/8" (714 mm)
F	Glass Center to Standoff	33" (839 mm)
G	Gas Connection	N/A
H	Aeration Adjustment	N/A

Item	Description	Measurement
I	Electrical	N/A
J	Viewing Opening Width	53-1/4" (1352 mm)
K	Unit Body Width	56-3/16" (1427 mm)
L	Viewing Opening Height	18" (457 mm)
M	Unit Height	41-9/16" (1055 mm)
N	Unit Body Height	34-3/8" (874 mm)
O	Unit Base to Bottom Opening	10-1/8" (257 mm)
P	Inner Flue Collar	5" (126 mm)
Q	Outer Flue Collar	8" (202 mm)

City Series® CP50E | 1

- Height dimension is taken with leveling legs fully inserted and may vary depending on the height of the leveling legs when unscrewed or extended.
- All pictures/diagrams shown throughout this manual are for illustration purposes only. Actual product may vary due to enhancements.
- Dimensions will appear as (inches) " (metric) mm throughout this manual. The inches are rounded to the nearest 1/16" when converted.

CLEARANCES - BENCH INSTALLATION

The clearances listed below are minimum requirements for either side of this see-through fireplace, unless otherwise noted.

A major cause of chimney-related fires is failure to maintain required clearances (air space) to combustible materials. It is of the greatest importance that this fireplace and vent system are installed in accordance with the instructions in this manual.


NOTE: Bench installation is when the chase enclosure height is at a minimum of 52" (1321 mm) to a maximum of 81-1/4" (2064 mm). If the bench installation is completed at the minimum height, a shelf, counter top, or other finish can be installed.

Clearance	Dimension	Measured From:
A: Mantel height (min.)	**	Top of fireplace opening
B: Sidelwall (on one side) min.	6" (154 mm)	Side of fireplace opening
C: Enclosure inside cavity width (min.)	60-5/8" (1540 mm)	Side wall
D: Mantel depth (max.)	**	
E: Convection air outlet (min.)	175 sq. in.	Top, front of enclosure
F: Framing depth (min.)	22-1/4" (565 mm)	From back wall to chase front
G: Opening height	18" (457 mm)	Bottom/top of fireplace opening
H: Chase enclosure (min.)	52" (1321 mm) to 81-1/4" (2064 mm) max.	From base of unit/floor to underside of enclosure top
I: Ceiling height (min.)	81-1/4" (2064 mm)	Measured from base of appliance
J: Convection air outlet opening offset (max.)	2" (51 mm)	Max offset from top of chase enclosure
K: Convection air outlet opening width (min.)	10" (254 mm)	
L: Convection air outlet opening height (min.)	1-3/4" (44 mm)	
M: Ceiling clearance (min.)	3" (76 mm)	Top convection air outlet only
N: Clearance to sprinkler head	36" (914 mm)	Perpendicular from chase grill
Hearth	0"	No hearth required

** See mantel clearances chart in the manual.
* For clearances greater than 81-1/4" (2064 mm), see flush installation clearances in this manual. The size of the ventilation opening is reduced from 175 sq. in. to 120 sq. in.

*A minimum of 175 sq. in. of open area, not lower than 0-2" (51 mm) from top of enclosure, is required for all installations.

CAUTION: EXTREME RISK OF FIRE if these clearances (air space) to combustible materials are not adhered to. It is of greatest importance that this fireplace and vent system are installed in accordance with the instructions in this manual. The top, back, and sides of the fireplace are defined by standoffs. The metal ends of the standoff may NOT be recessed into combustible construction.

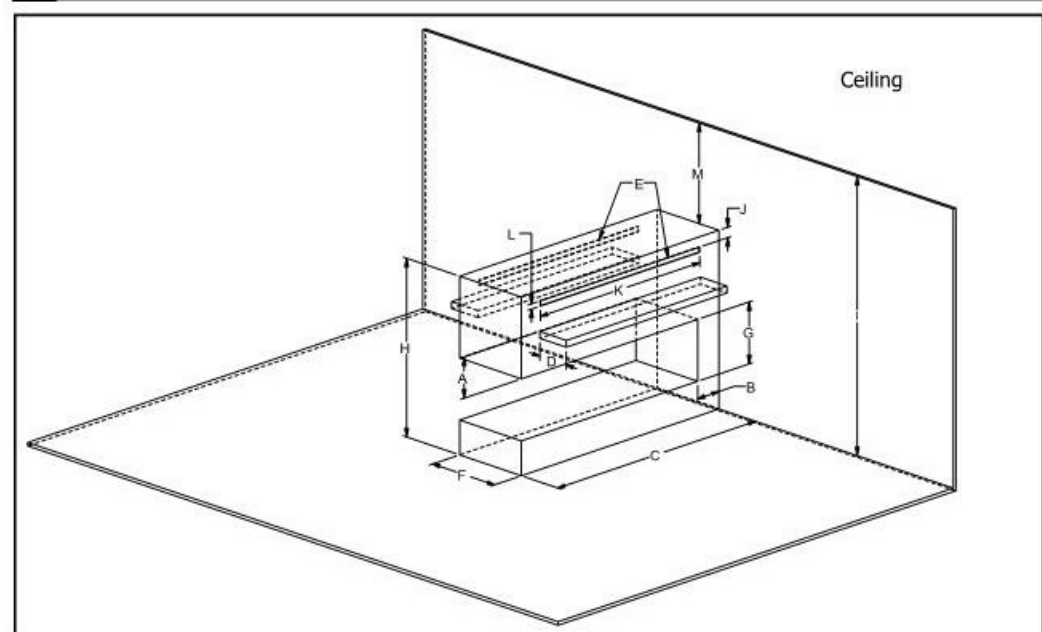

City Series® CP50E | 7


FRAMING DIMENSIONS

NOTE: Framing may be constructed of combustible material (i.e. 2 x 4 or 2 x 6) and does not require steel studs.

Framing Dimensions	Description	CP50E
A	Framing height	For 2" x 4": 45-1/8" (1146 mm) For 2" x 6": 52" (1321 mm)
B	Framing width	60-5/8" (1540 mm)
C	Finished floor or hearth	
D	Framing depth	22-1/4" (565 mm)
E	Minimum height to combustibles	BENCH: 52" (1321 mm) FLUSH: 81-1/4" (2064 mm)
F	Minimum height to flue centerline measured from base of appliance	45-3/4" (1162 mm)
G	Centerline of appliance to lip	28-1/8" (714 mm)
H	Centerline of appliance to stand off (Vent side)	33" (839 mm)

Ensure that the wood base for the appliance is strong enough to support its shipping weight of 455 pounds (206 kg).

- Framing may be constructed of combustible material (i.e. 2 x 4 or 2 x 6) and does not require steel studs.
- This appliance must be installed on a solid surface such as a plywood floor which must be the full width and depth of the appliance.
- A combined minimum of 175 sq. in. of open area for the bench installation and 120 square inches for the flush installation is required for the convection air outlet to cool the enclosure. Ensure clearances for convection air outlets are met.
- See clearances in this manual for different ways to achieve this.

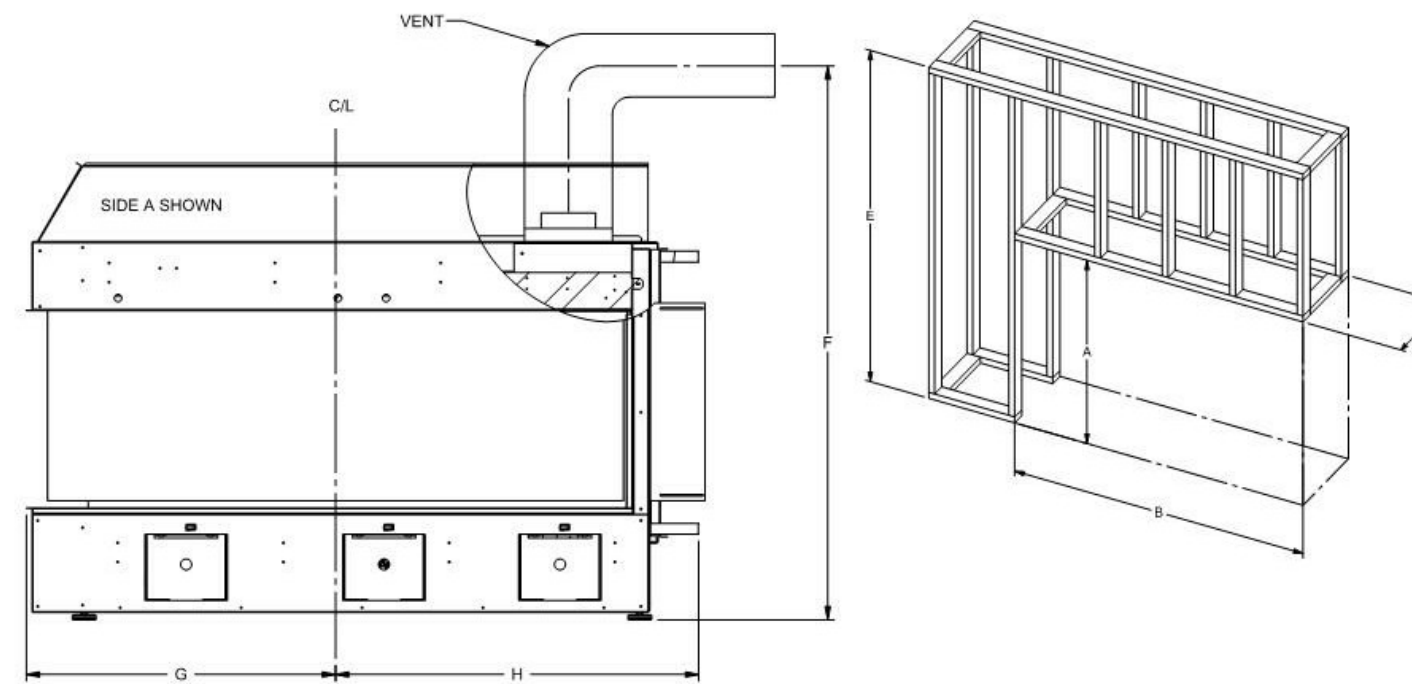

City Series® CP50E | 13

VENTING ARRANGEMENT FOR VERTICAL TERMINATIONS

Inline Power Vent Rigid/Flex
In line Power Vent Kit # 666-945

Vertical venting with straight vertical venting and/or with a max. of six (6) 90° Elbows (1 - 90° = 2 - 45°)


- Rigid pipe is approved for up to 72 feet (22 m).
- Flex pipe is approved for up to 40 feet (12.2 m) using one 20 foot (6.1m) 20 foot Vertical Flex kit (part # 946-755) & one 20 foot (6.1 m) extension flex kit (part # 946-756).

- Two 45° elbows equal to one 90° elbow.
- Vent must be supported at offsets.
- Minimum distance between elbows is 1 ft. (0.3 m).
- Maintain clearances to combustibles as listed in the "Clearances" section.
- Horizontal vent must be supported every 3 feet (0.91 m).
- Firestops are required at each floor level and whenever passing through a wall.



Restrictor set on 0 (fully open) regardless of vent run.

- Inline power vent location restrictions:
- Minimum 4 ft (1.2 m) from the unit.
- Minimum 1 ft (0.3 m) prior to an elbow.
- Minimum 1 ft (0.3 m) following an elbow.
- Minimum 2 ft (0.6 m) prior to a termination cap.
- Minimum 2 ft. from inline PV to termination cap.
- Minimum 4" from top of unit to inline PV.
- Max. of 72' (22 m), using up to six 90° elbows (Example shows two 90° elbows).
- No negative runs.

NOTE: The inline power vent must be installed within the confines of the home/structure.

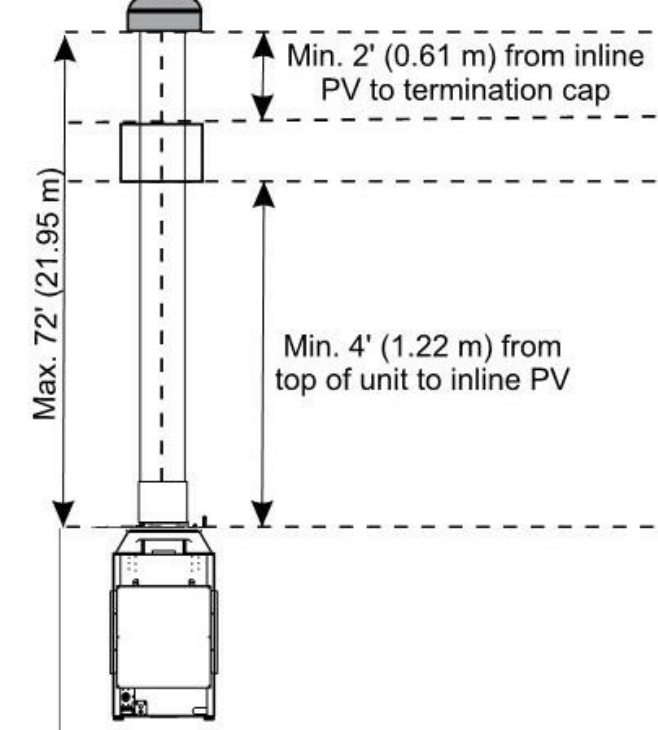


Max. of 72' (21.95 m), using up to six 90° elbows (Note: two 90° elbows shown.)

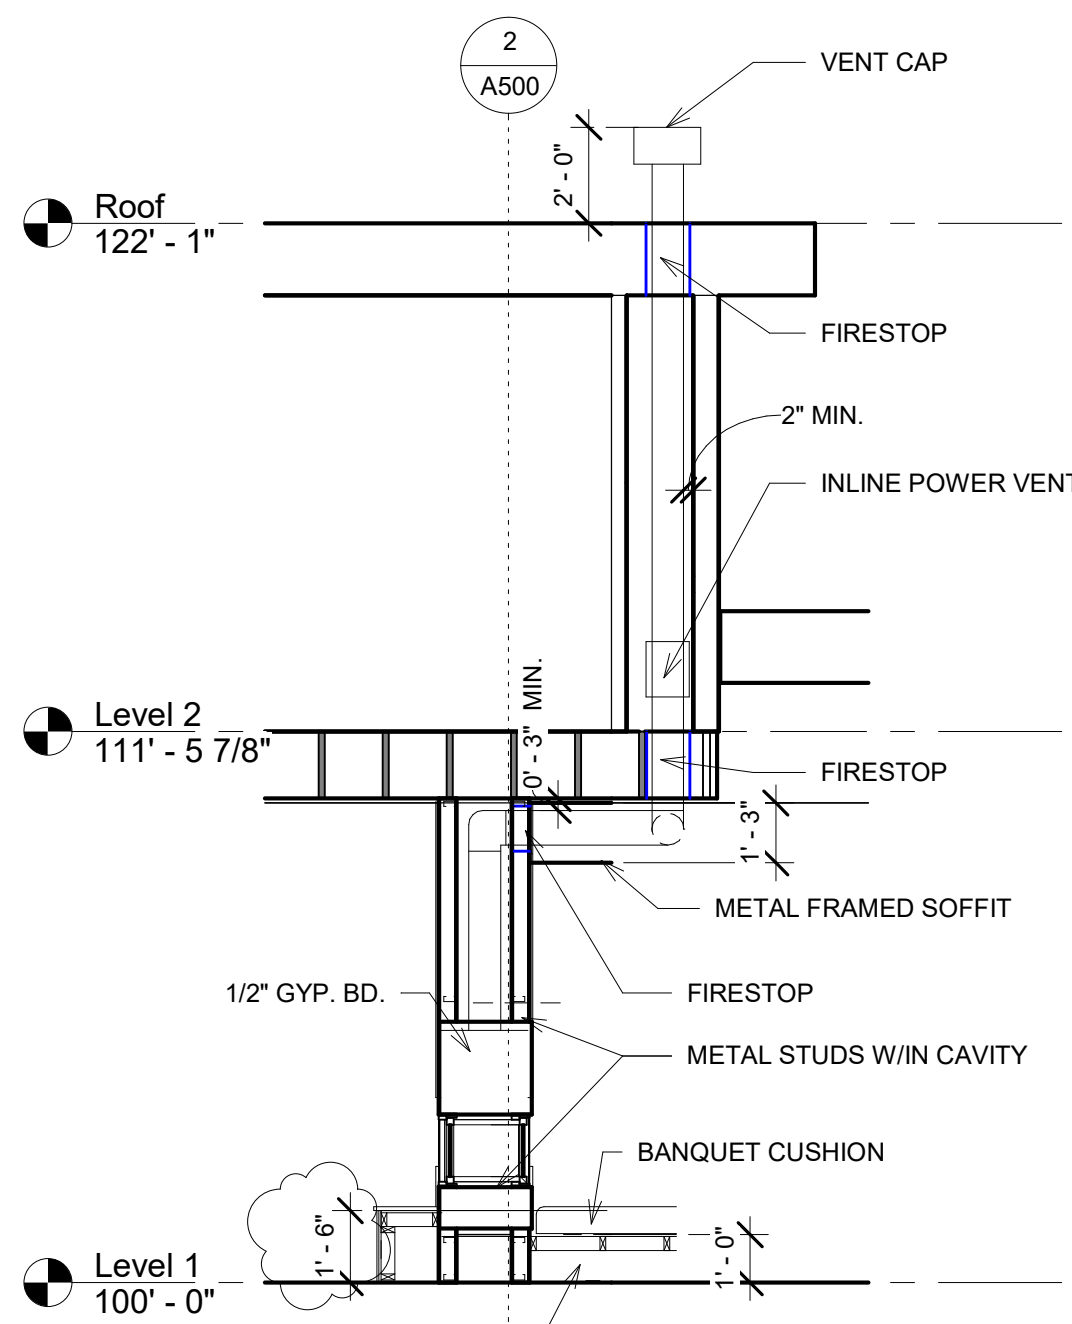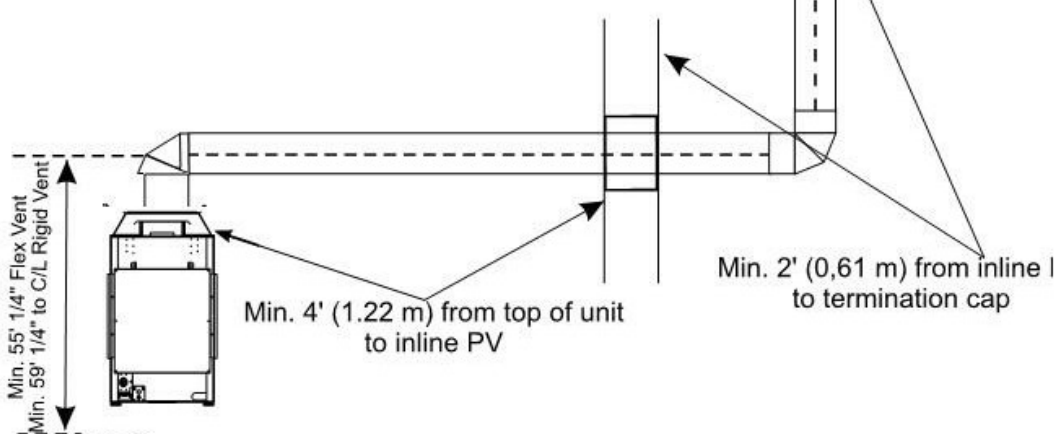


1 Detail 0
1/4" = 1'-0"

** CONFIRM ALL CLEARANCES TO BENCH W/ INSTALLER PRIOR TO FRAMING FIREPLACE UNIT **

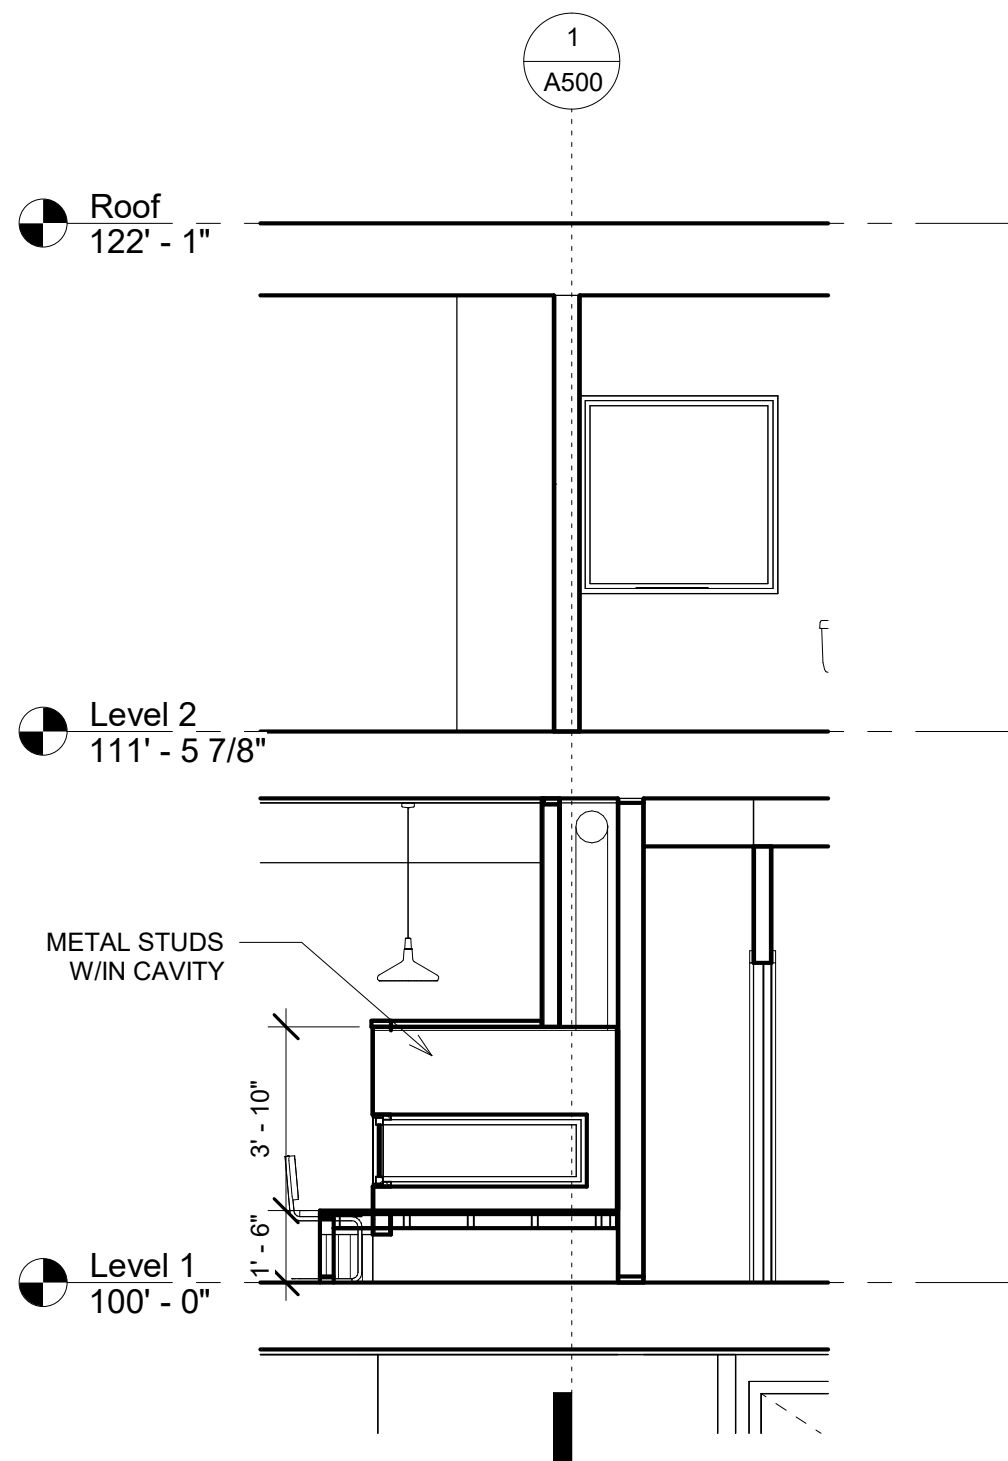

2 Detail 1
1/4" = 1'-0"

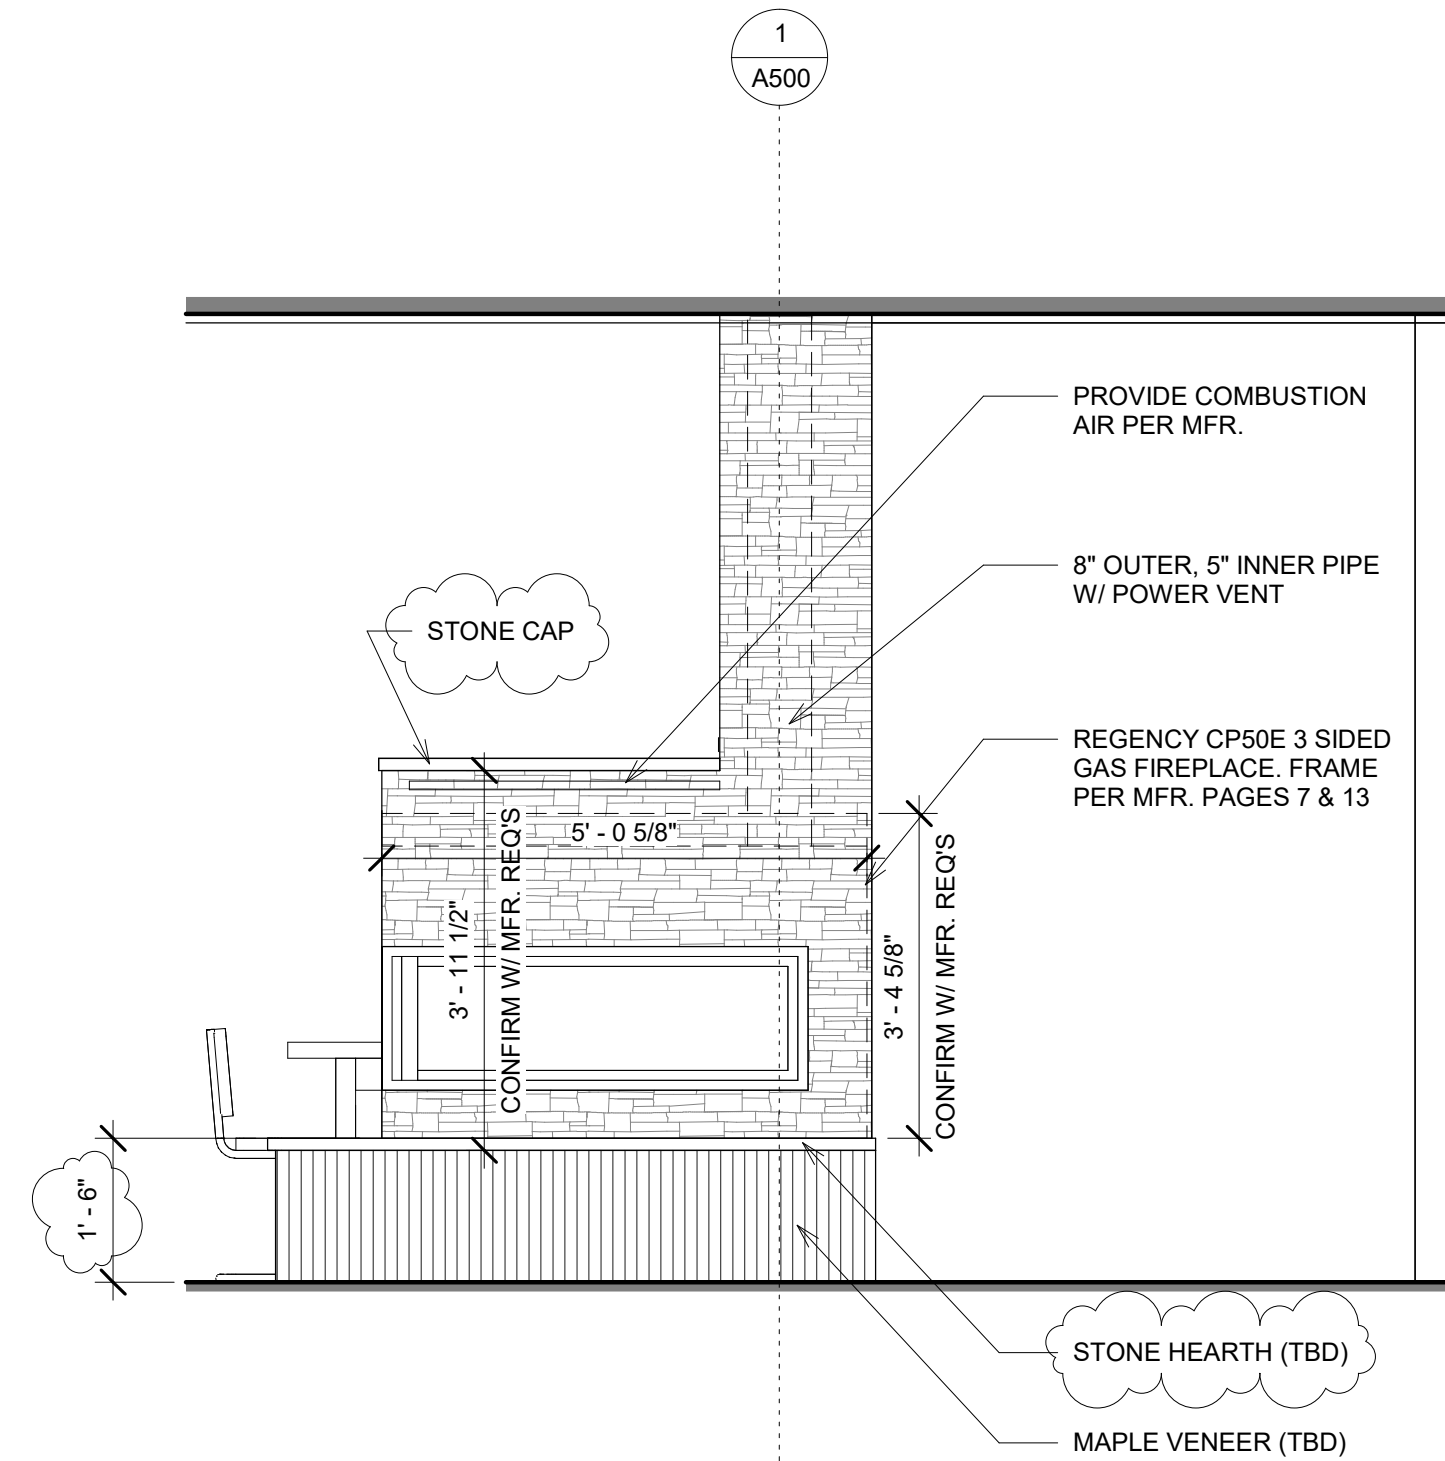

3 Fireplace Elevation
1/2" = 1'-0"

FIREPLACE NOTES:


- CONTRACTOR TO ENSURE COMPLIANCE W/ ALL MFR. INSTALL REQ'S
- PROVIDE CLEARANCE TO COMBUSTIBLES AS REQ'D. 3" TO TOP, 2" TO SIDE, 2" TO BOTTOM. 1.5" W/ FIRESTOP.
- PROVIDE FIRESTOPS AT ALL WALL, FLOOR, AND ROOF PENETRATIONS
- POWER VENT ALLOWS UP TO 72 FT. OF RIGID PIPE, OR 40 FT. OF FLEX VENT.
- UP TO (6) ELBOWS ALLOWED
- PROVIDE COMBUSTION AIR PER MFR.

THESE DOCUMENTS ARE PROVIDED FOR THE DESIGN INTENT OF THIS SPECIFIC PROJECT AND ONLY THIS PROJECT. THE CONTRACTOR SHALL BE RESPONSIBLE FOR ALL CONSTRUCTION COORDINATION METHODS FOR THE PROJECT. THE CONTRACTOR SHALL BE RESPONSIBLE FOR THE COMPLETION OF THE PROJECT. THIS INCLUDES BUT IS NOT LIMITED TO THE QUALITY OF WORKMANSHIP AND MATERIALS REQUIRED FOR EXECUTION OF THESE DOCUMENTS AND WORK OR MATERIALS SUPPLIED BY ANY SUBCONTRACTORS. ALL WORK SHALL COMPLY WITH GOVERNING CODES AND ORDINANCES. THE CONTRACTOR SHALL BE RESPONSIBLE FOR ALL DOCUMENTS AND SHALL NOTIFY THE ARCHITECT IMMEDIATELY OF ANY DISCREPANCIES IN THE DRAWINGS, FIELD CONDITIONS OR DIMENSIONS.

7855 SPRING DRIVE
BOULDER, CO 80303
NEW RESIDENCE

CONSTRUCTION SET -
REV 2
1/16/26

SHEET
No.
A500
Fireplace Details

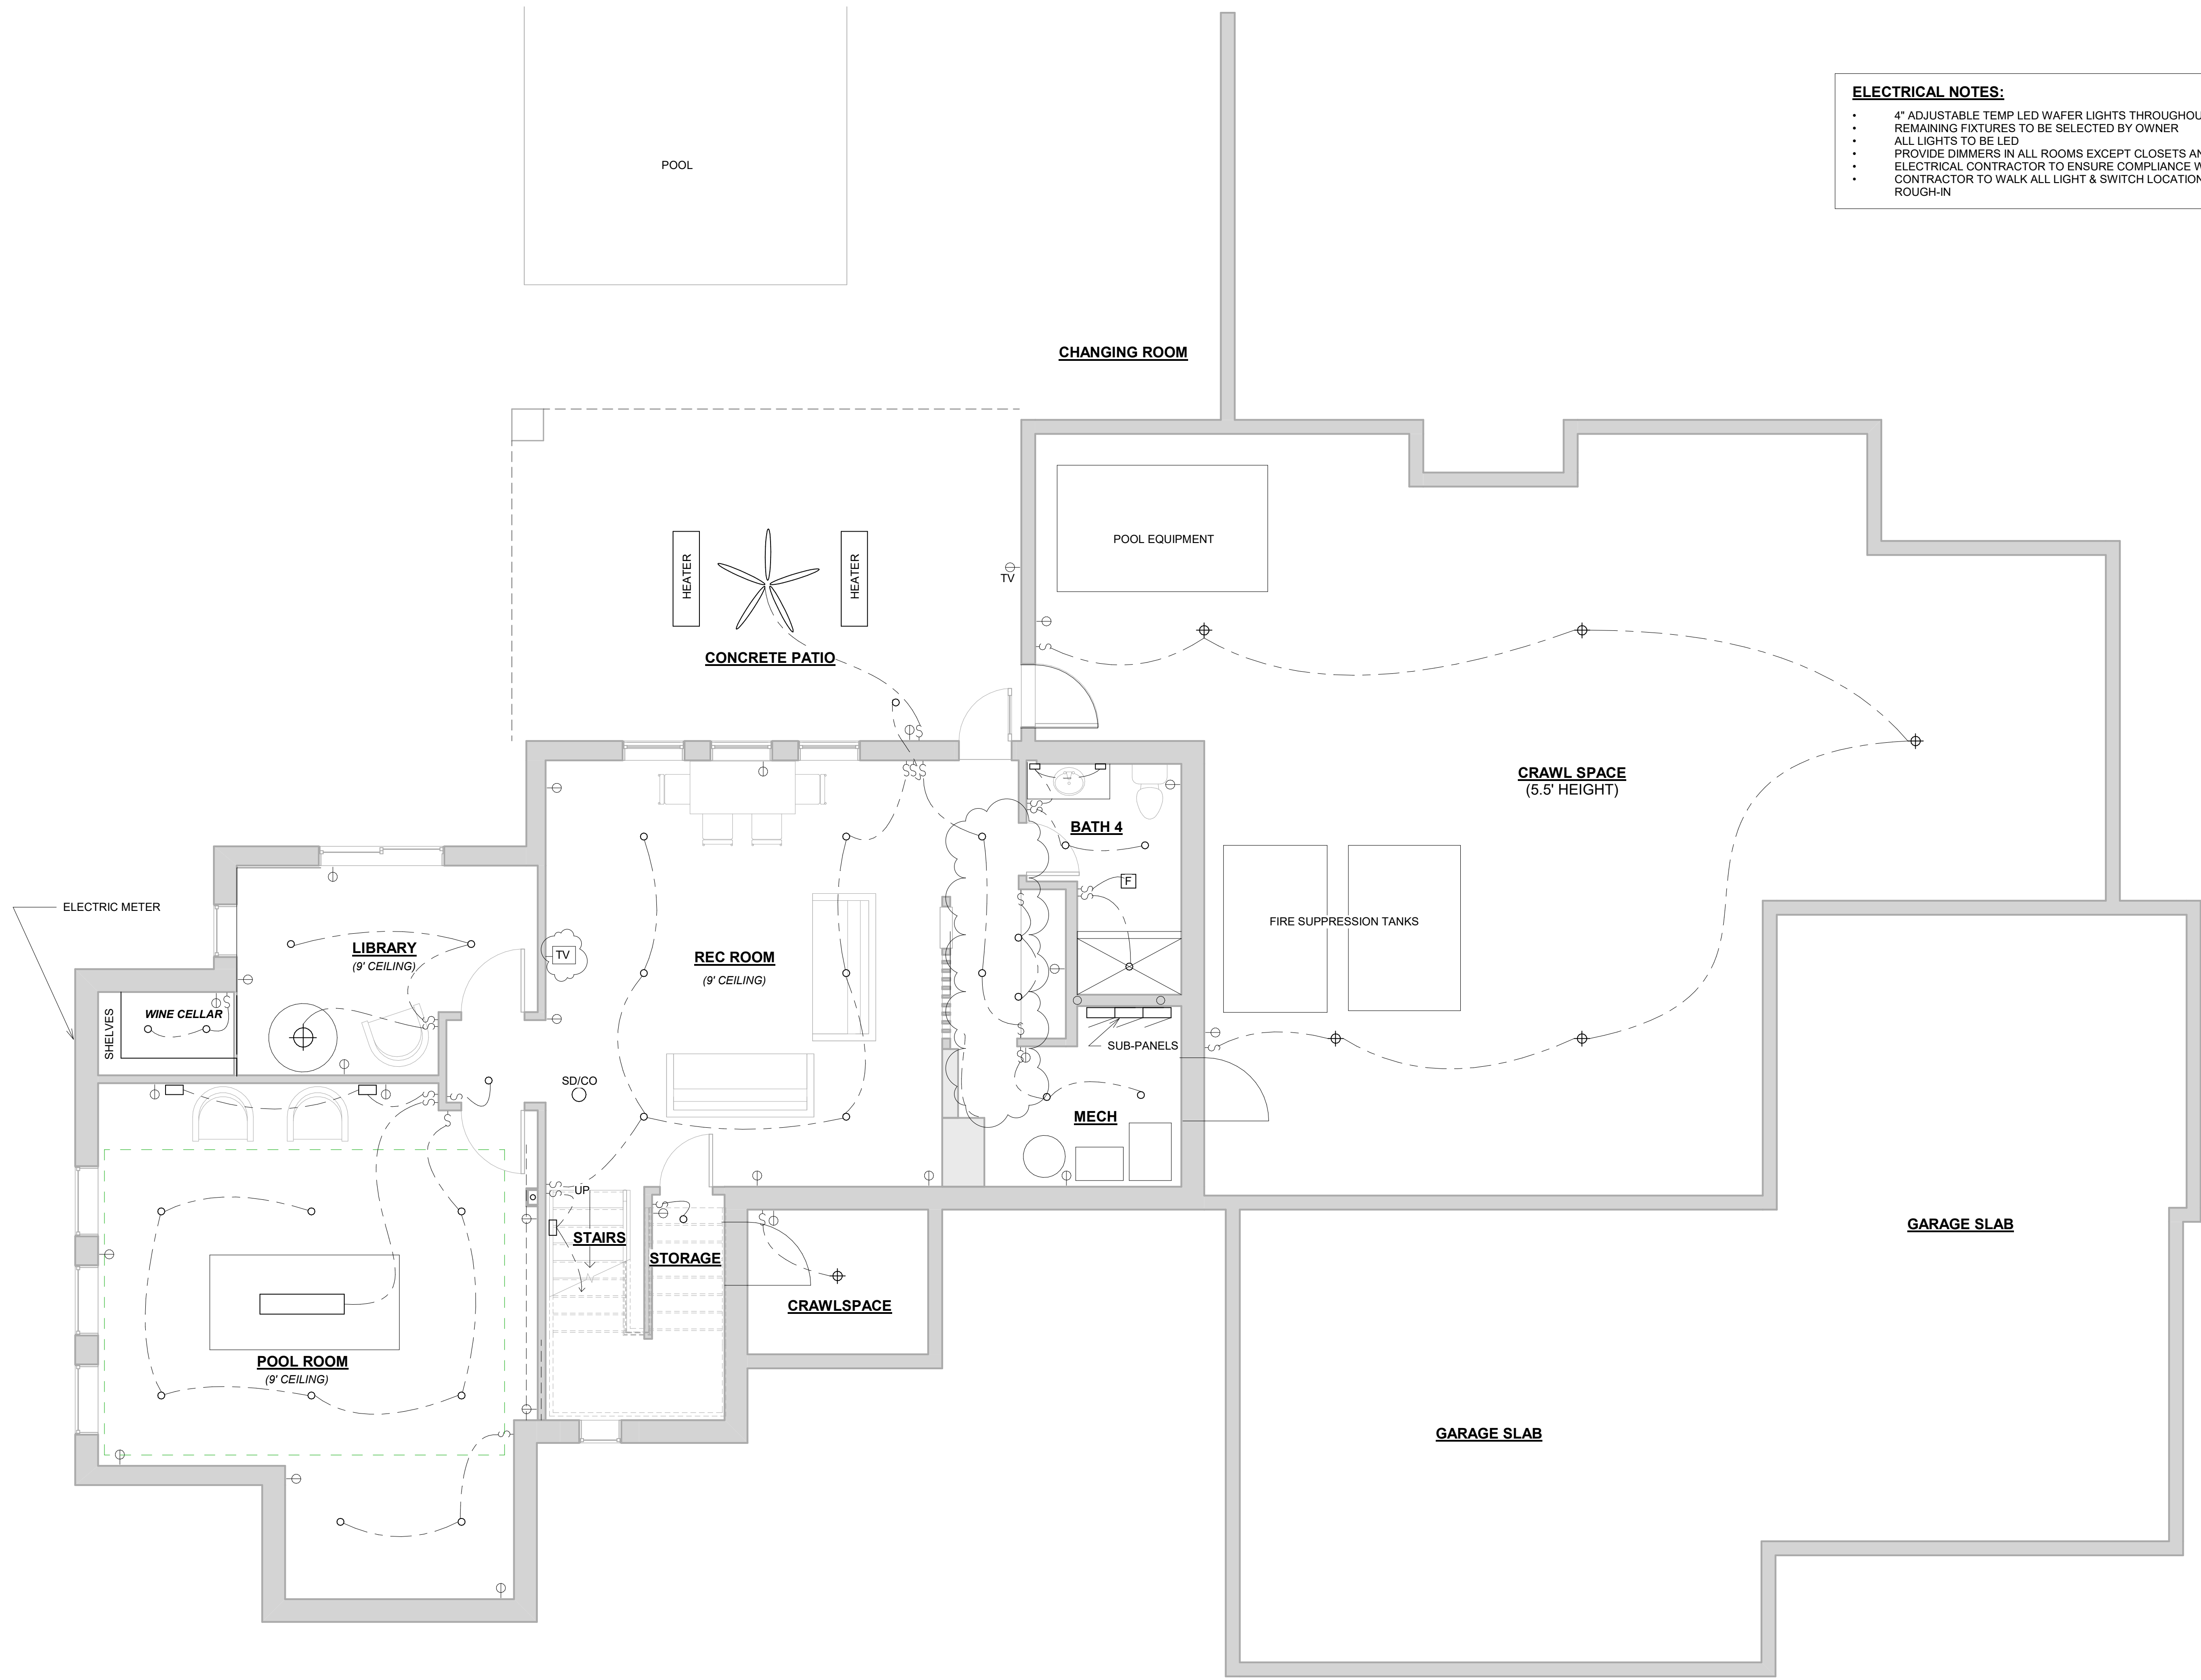

- ELECTRICAL NOTES:**
- 4" ADJUSTABLE TEMP LED WAFER LIGHTS THROUGHOUT
 - REMAINING FIXTURES TO BE SELECTED BY OWNER
 - ALL LIGHTS TO BE LED
 - PROVIDE DIMMERS IN ALL ROOMS EXCEPT CLOSETS AND BATHROOMS
 - ELECTRICAL CONTRACTOR TO ENSURE COMPLIANCE WITH 2023 NEC
 - CONTRACTOR TO WALK ALL LIGHT & SWITCH LOCATIONS PRIOR TO ROUGH-IN

1 Basement - Electrical
1/4" = 1'-0"

0'

1'

2'

4'

8'

SCALE: 1/4" = 1'-0"

N

1

THESE DOCUMENTS ARE PROVIDED FOR THE DESIGN INTENT OF THIS SPECIFIC PROJECT AND ONLY THIS PROJECT. THE CONTRACTOR SHALL BE RESPONSIBLE FOR ALL CONSTRUCTION COORDINATION, METHODS AND MATERIALS TO BE USED TO COMPLETE THE PROJECT. THIS INCLUDES BUT IS NOT LIMITED TO THE QUALITY OF WORKMANSHIP AND MATERIALS REQUIRED FOR EXECUTION OF THESE DOCUMENTS AND WORK OR MATERIALS SUPPLIED BY ANY SUBCONTRACTORS. ALL WORK SHALL COMPLY WITH ALL GOVERNING CODES AND ORDINANCES. THE CONTRACTOR SHALL NOTIFY THE ARCHITECT IMMEDIATELY OF ANY DISCREPANCIES IN THE DRAWINGS, FIELD CONDITIONS OR DIMENSIONS.


7855 SPRING DRIVE
BOULDER, CO 80303
NEW RESIDENCE

CONSTRUCTION SET -
REV 2
1/16/26

SHEET
No.
E0.2
Basement Electrical


enContext Architecture, llc
Integrate. Iterate. Generate.
www.Context-Architect.com



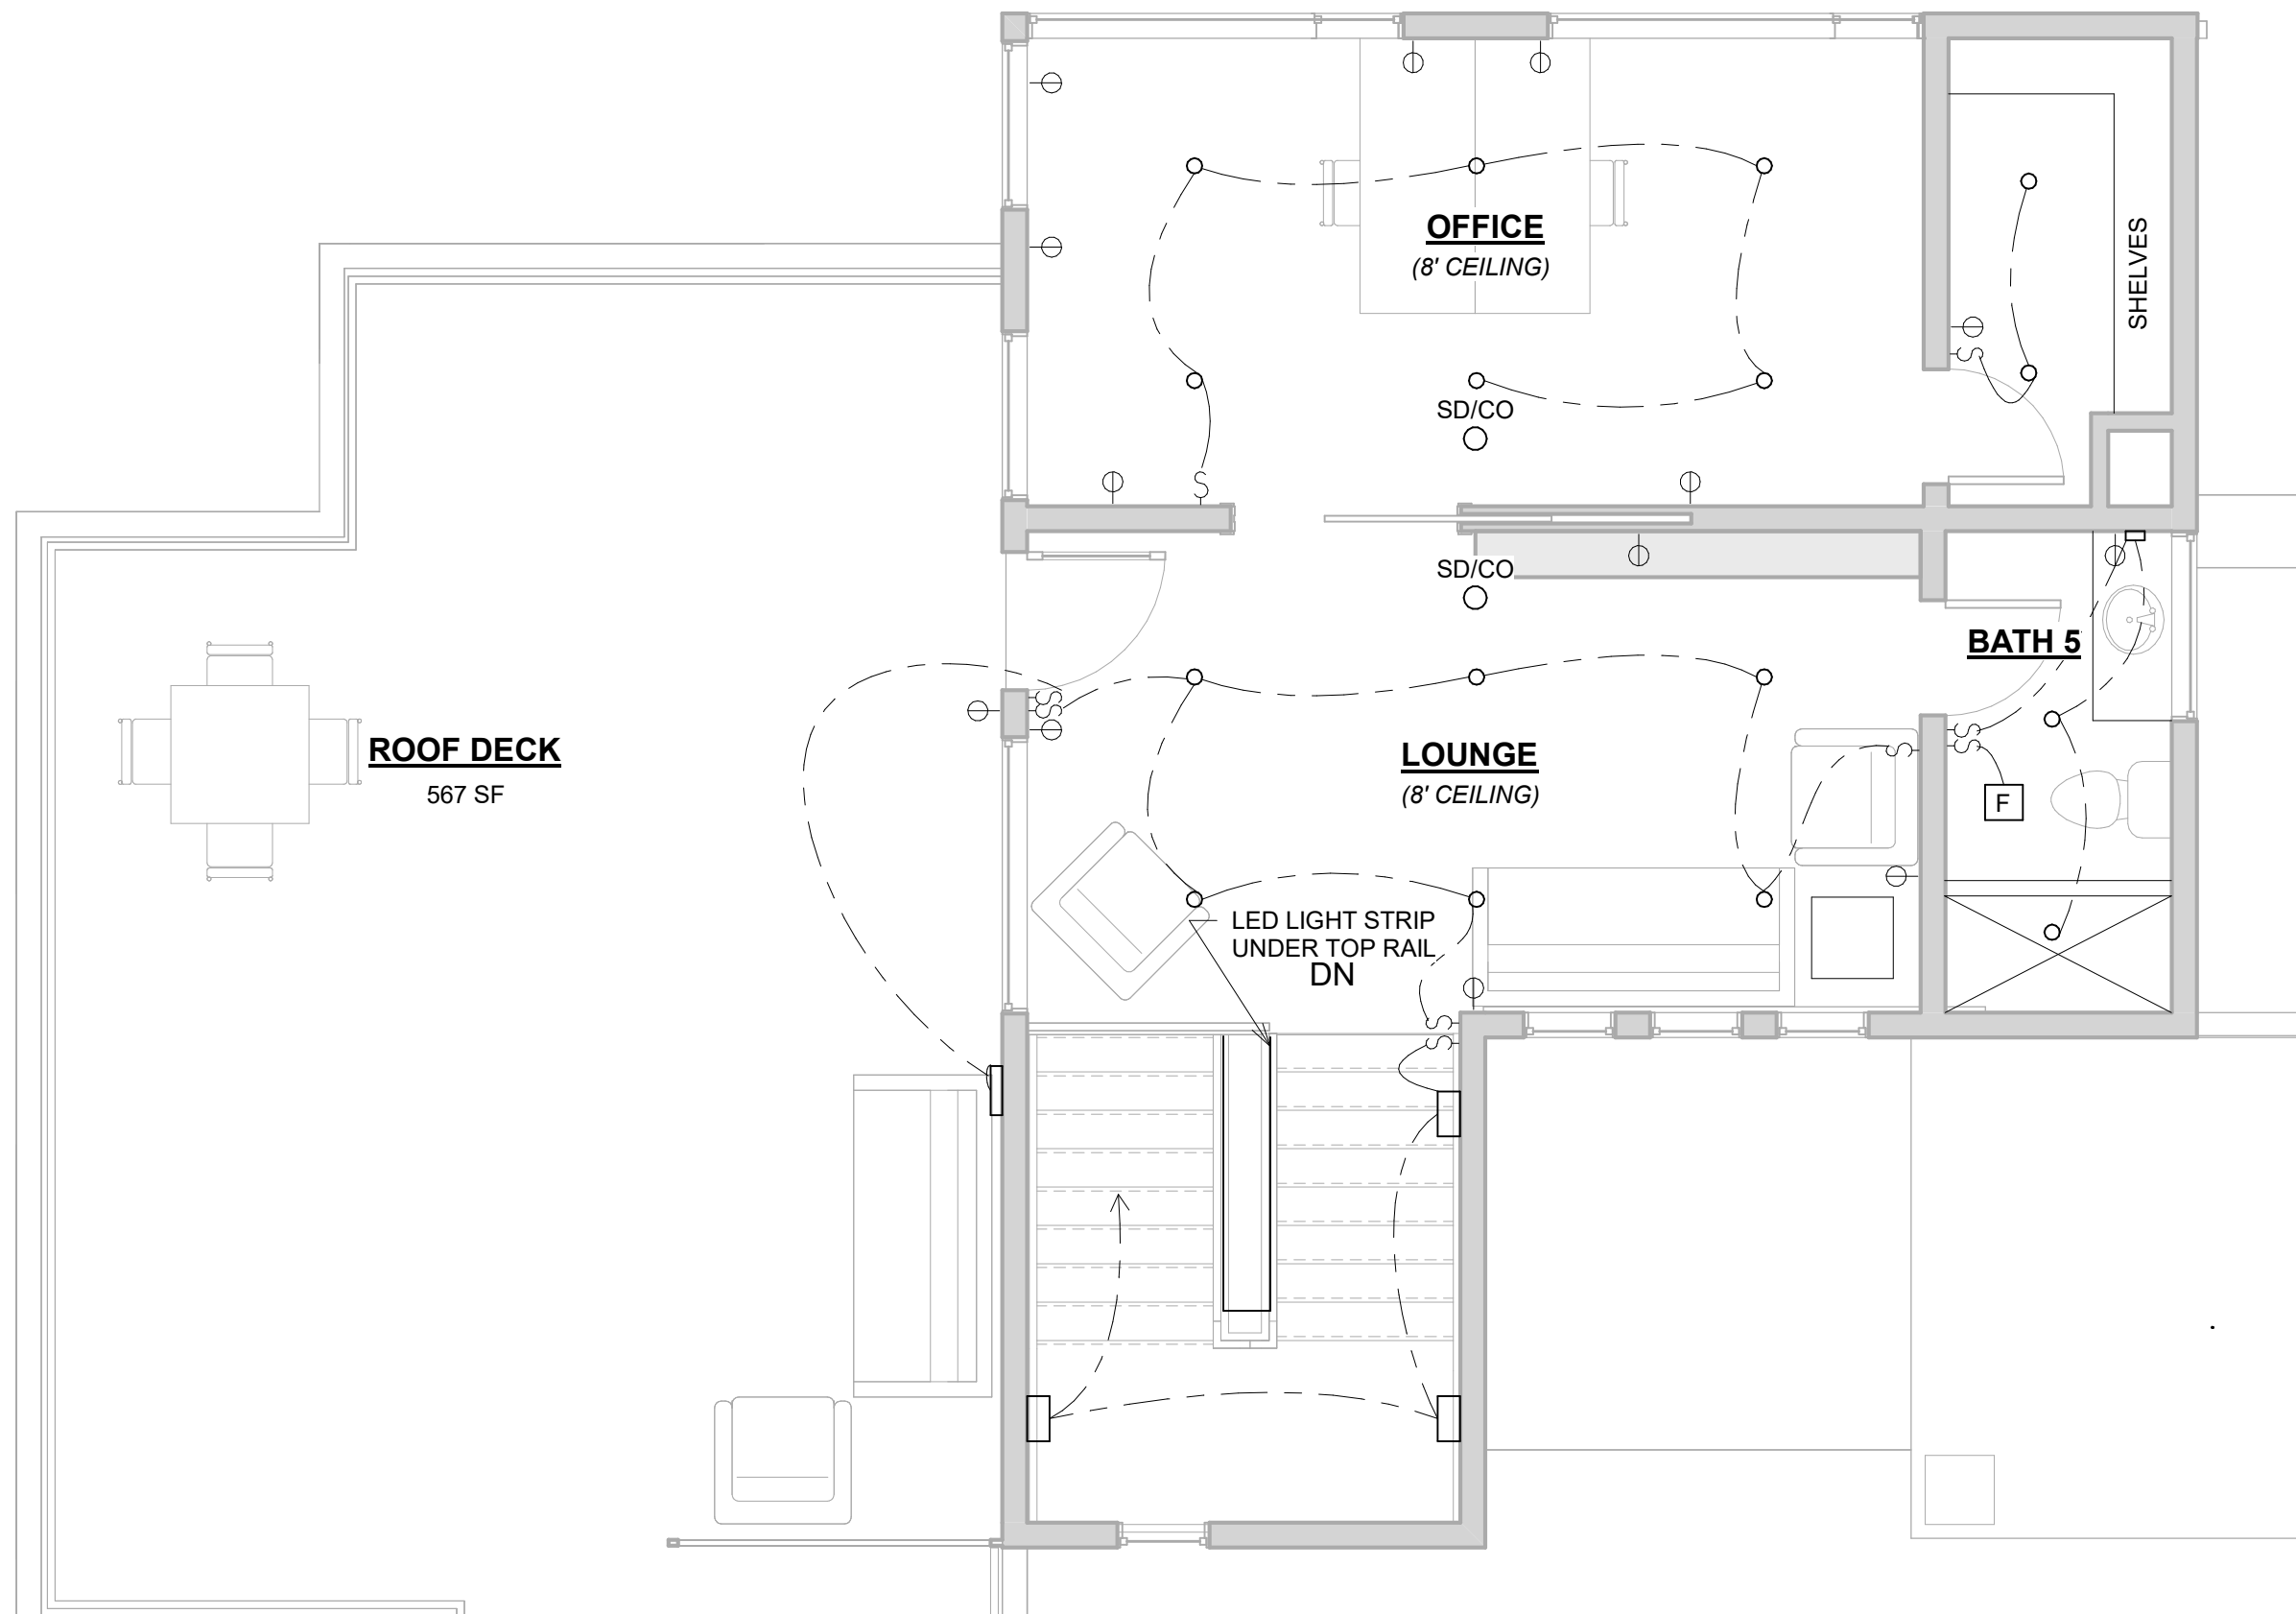

- ELECTRICAL NOTES:**
- 4" ADJUSTABLE TEMP LED WAFER LIGHTS THROUGHOUT
 - REMAINING FIXTURES TO BE SELECTED BY OWNER
 - ALL LIGHTS TO BE LED
 - PROVIDE DIMMERS IN ALL ROOMS EXCEPT CLOSETS AND BATHROOMS
 - ELECTRICAL CONTRACTOR TO ENSURE COMPLIANCE WITH 2023 NEC
 - CONTRACTOR TO WALK ALL LIGHT & SWITCH LOCATIONS PRIOR TO ROUGH-IN

① Level 2 - Electrical
1/4" = 1'-0"

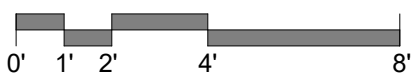

7855 SPRING DRIVE
BOULDER, CO 80303
NEW RESIDENCE

CONSTRUCTION SET -
REV 2
1/16/26

SHEET
No.


E2

Level 2 Electrical

THESE DOCUMENTS ARE PROVIDED FOR THE DESIGN INTENT OF THIS SPECIFIC PROJECT AND ONLY THIS PROJECT. THE CONTRACTOR SHALL BE RESPONSIBLE FOR ALL CONSTRUCTION COORDINATION, METHODS AND SEQUENCING. THE CONTRACTOR SHALL BE RESPONSIBLE FOR THE PROTECTION OF ALL EXISTING UTILITIES AND STRUCTURES. THE CONTRACTOR SHALL BE RESPONSIBLE FOR THE PROTECTION OF ALL EXISTING UTILITIES AND STRUCTURES. THE CONTRACTOR SHALL BE RESPONSIBLE FOR THE PROTECTION OF ALL EXISTING UTILITIES AND STRUCTURES.


enContext Architecture, llc
Integrate. Iterate. Generate.
www.Context-Architect.com

DATE:	03/28/2019
JOB #:	2508
DRAWN BY:	MM
CHECKED BY:	YK
REVISED:	
1	05/15/2019
2	05/15/2019
3	05/24/2019

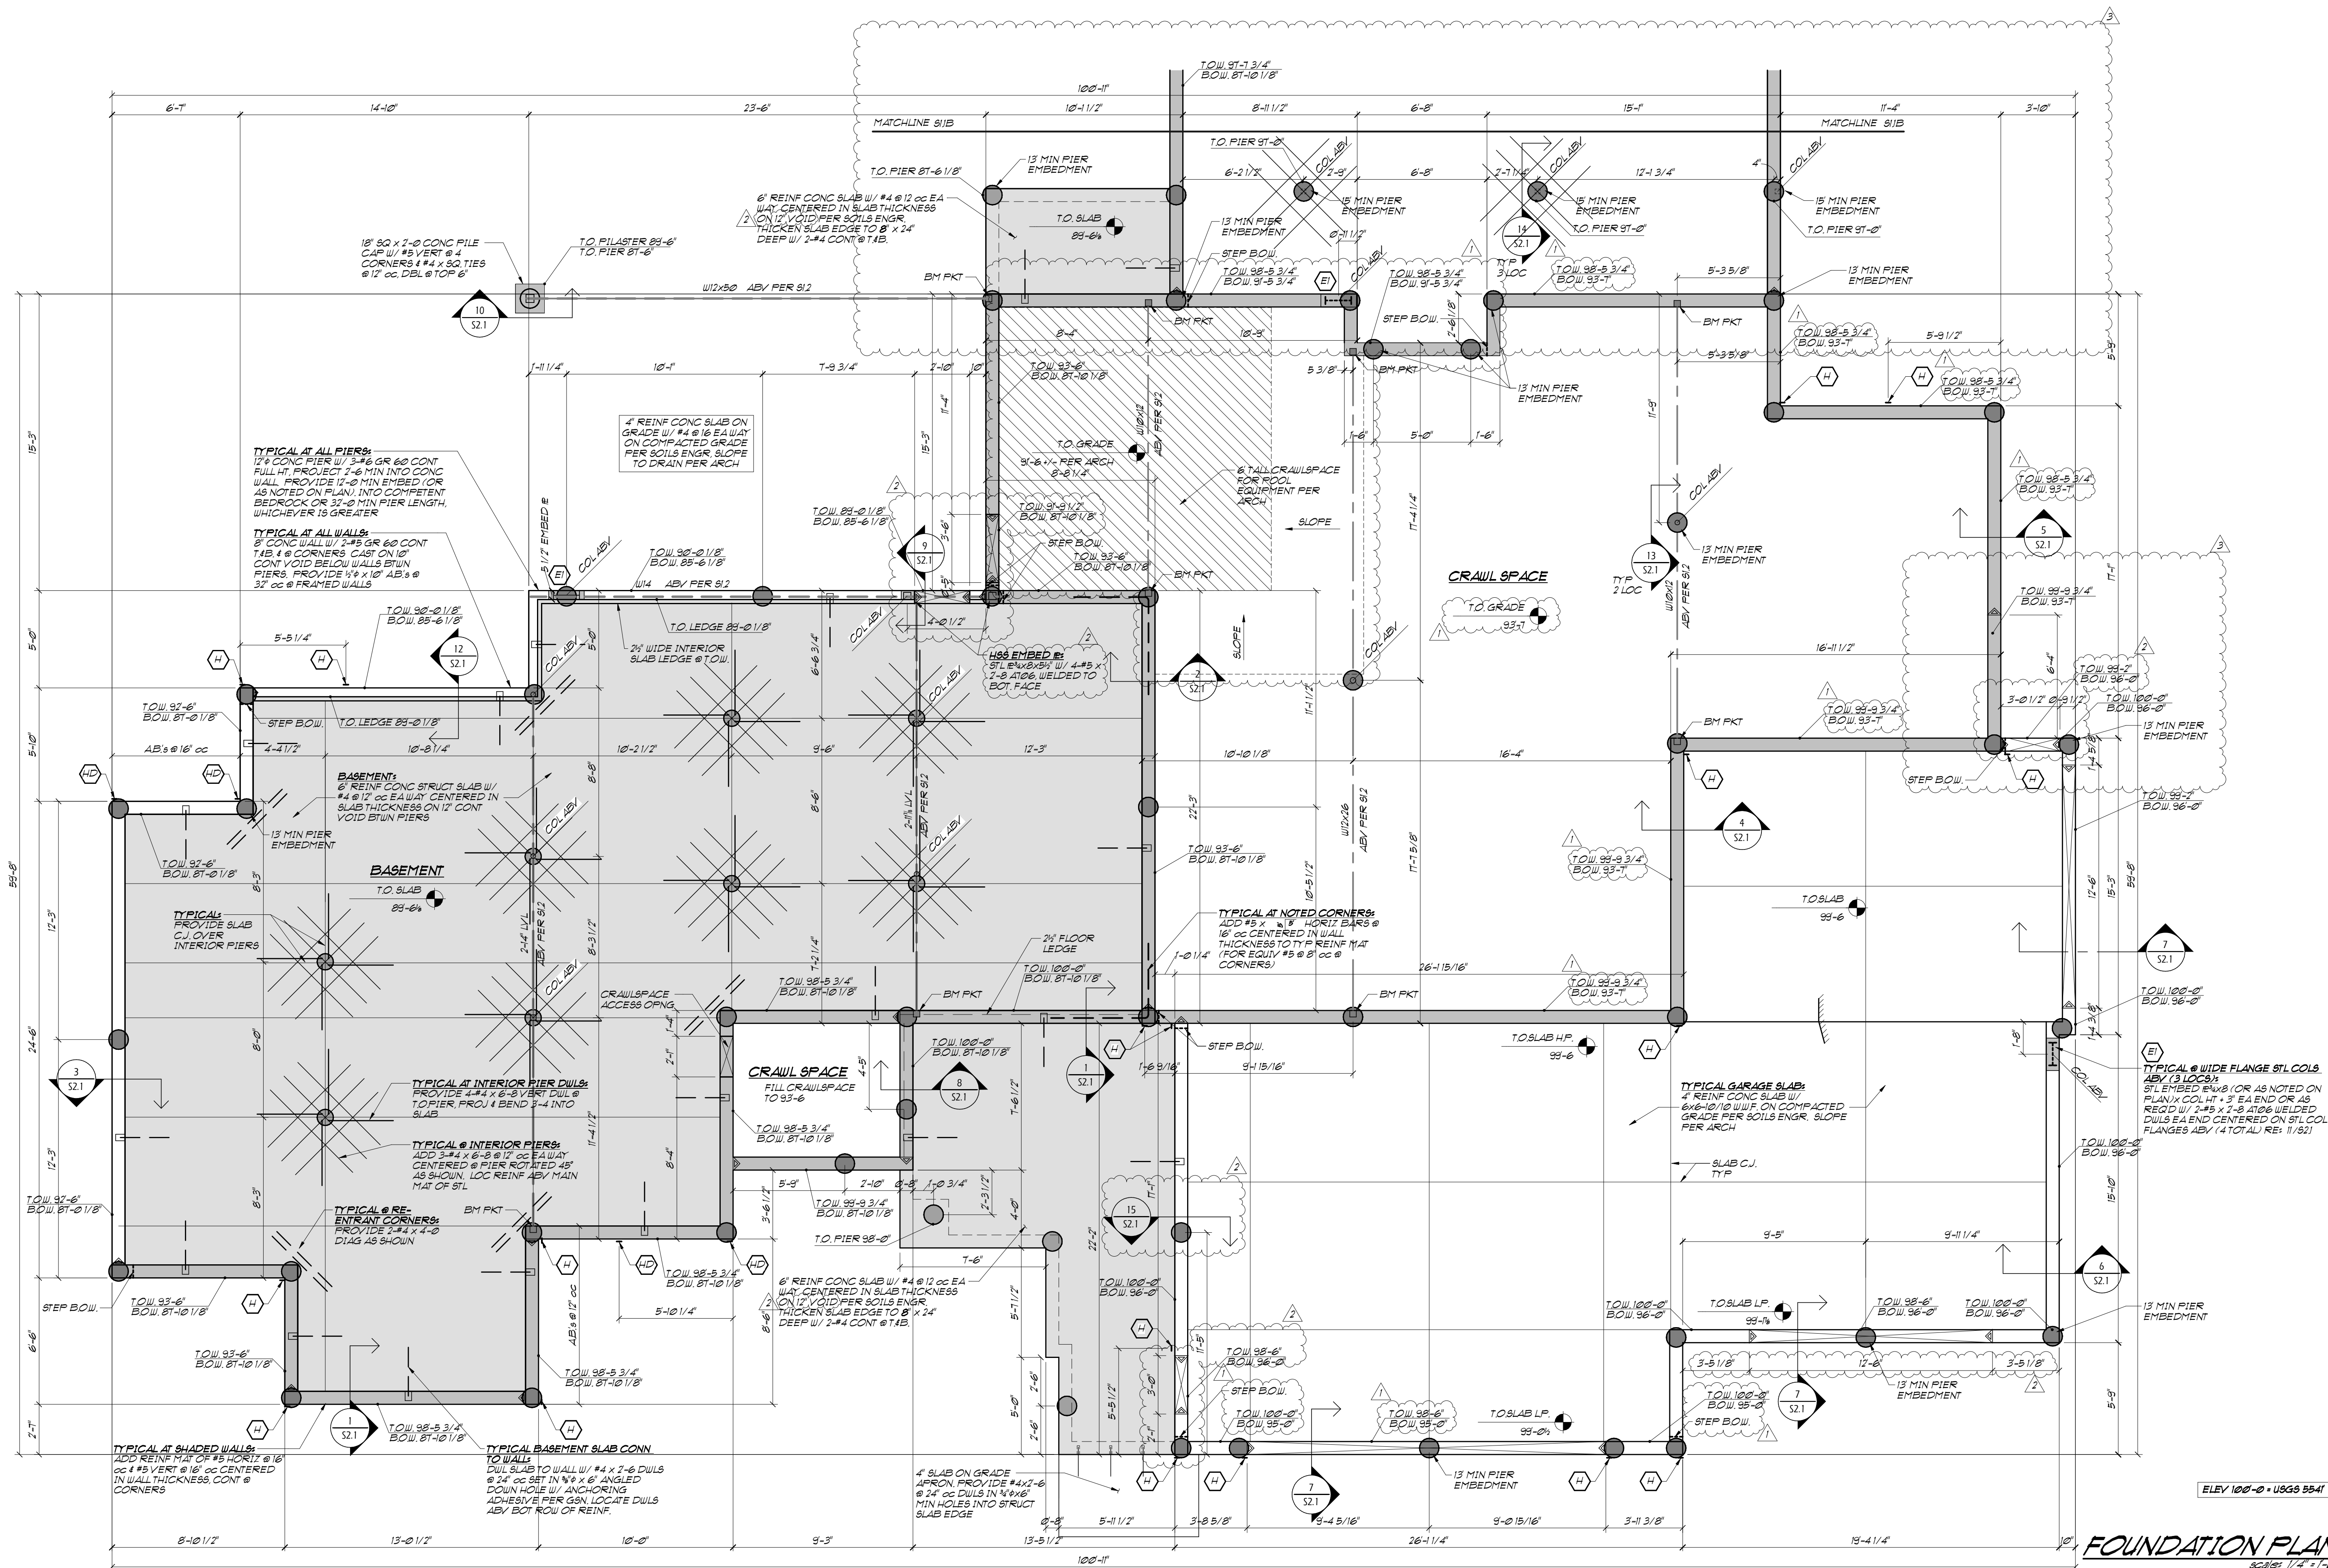


GRAPHIC SCALE: 1\"/>

- DO NOT BACKFILL WALLS PRIOR TO BASEMENT SLAB INSTALLATION
- CONTRACTOR TO VERIFY ALL PIER LOCATIONS PRIOR TO SLAB INSTALLATION
- TOP OF STEEL BEAMS NOTED THIS ELEVATION
- INDICATES STEEP TOP OF WALL (T.O.W.)
- PROVIDE STUD/HUR HOLD DOWNS AT ENDS OF SHEAR WALLS ABOVE CONTRACTOR TO VERIFY ROUGH OPENINGS W/ ARCHITECT. INSTALL DIRECTLY TO FRAMING BEFORE INSTALLATION OF ZIP R-SHEATHING
- PROVIDE HDUB-808/5 W/ 1/2\"/>
- SHORE EXCAVATION AS REQUIRED, SHORING DESIGN & IMPLEMENTATION BY OTHERS
- SUBSLAB PUMPING SUPPORT, SUSPENSION, OR ISOLATION SYSTEM DESIGN & CONSTRUCTION PER SOILS ENGINEER
- BOTTOM OF WALL (B.O.W.) • BOTTOM OF VOID • TOP OF PIER (T.O.P.)
- SEE SHEET S21 FOR GENERAL STRUCTURAL NOTES & TYPICAL FOUNDATION DETAILS

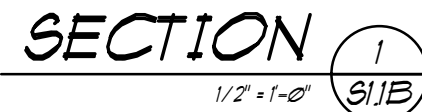

- S1.1B*

COPYRIGHT 2025, GIEBAU, INC.




















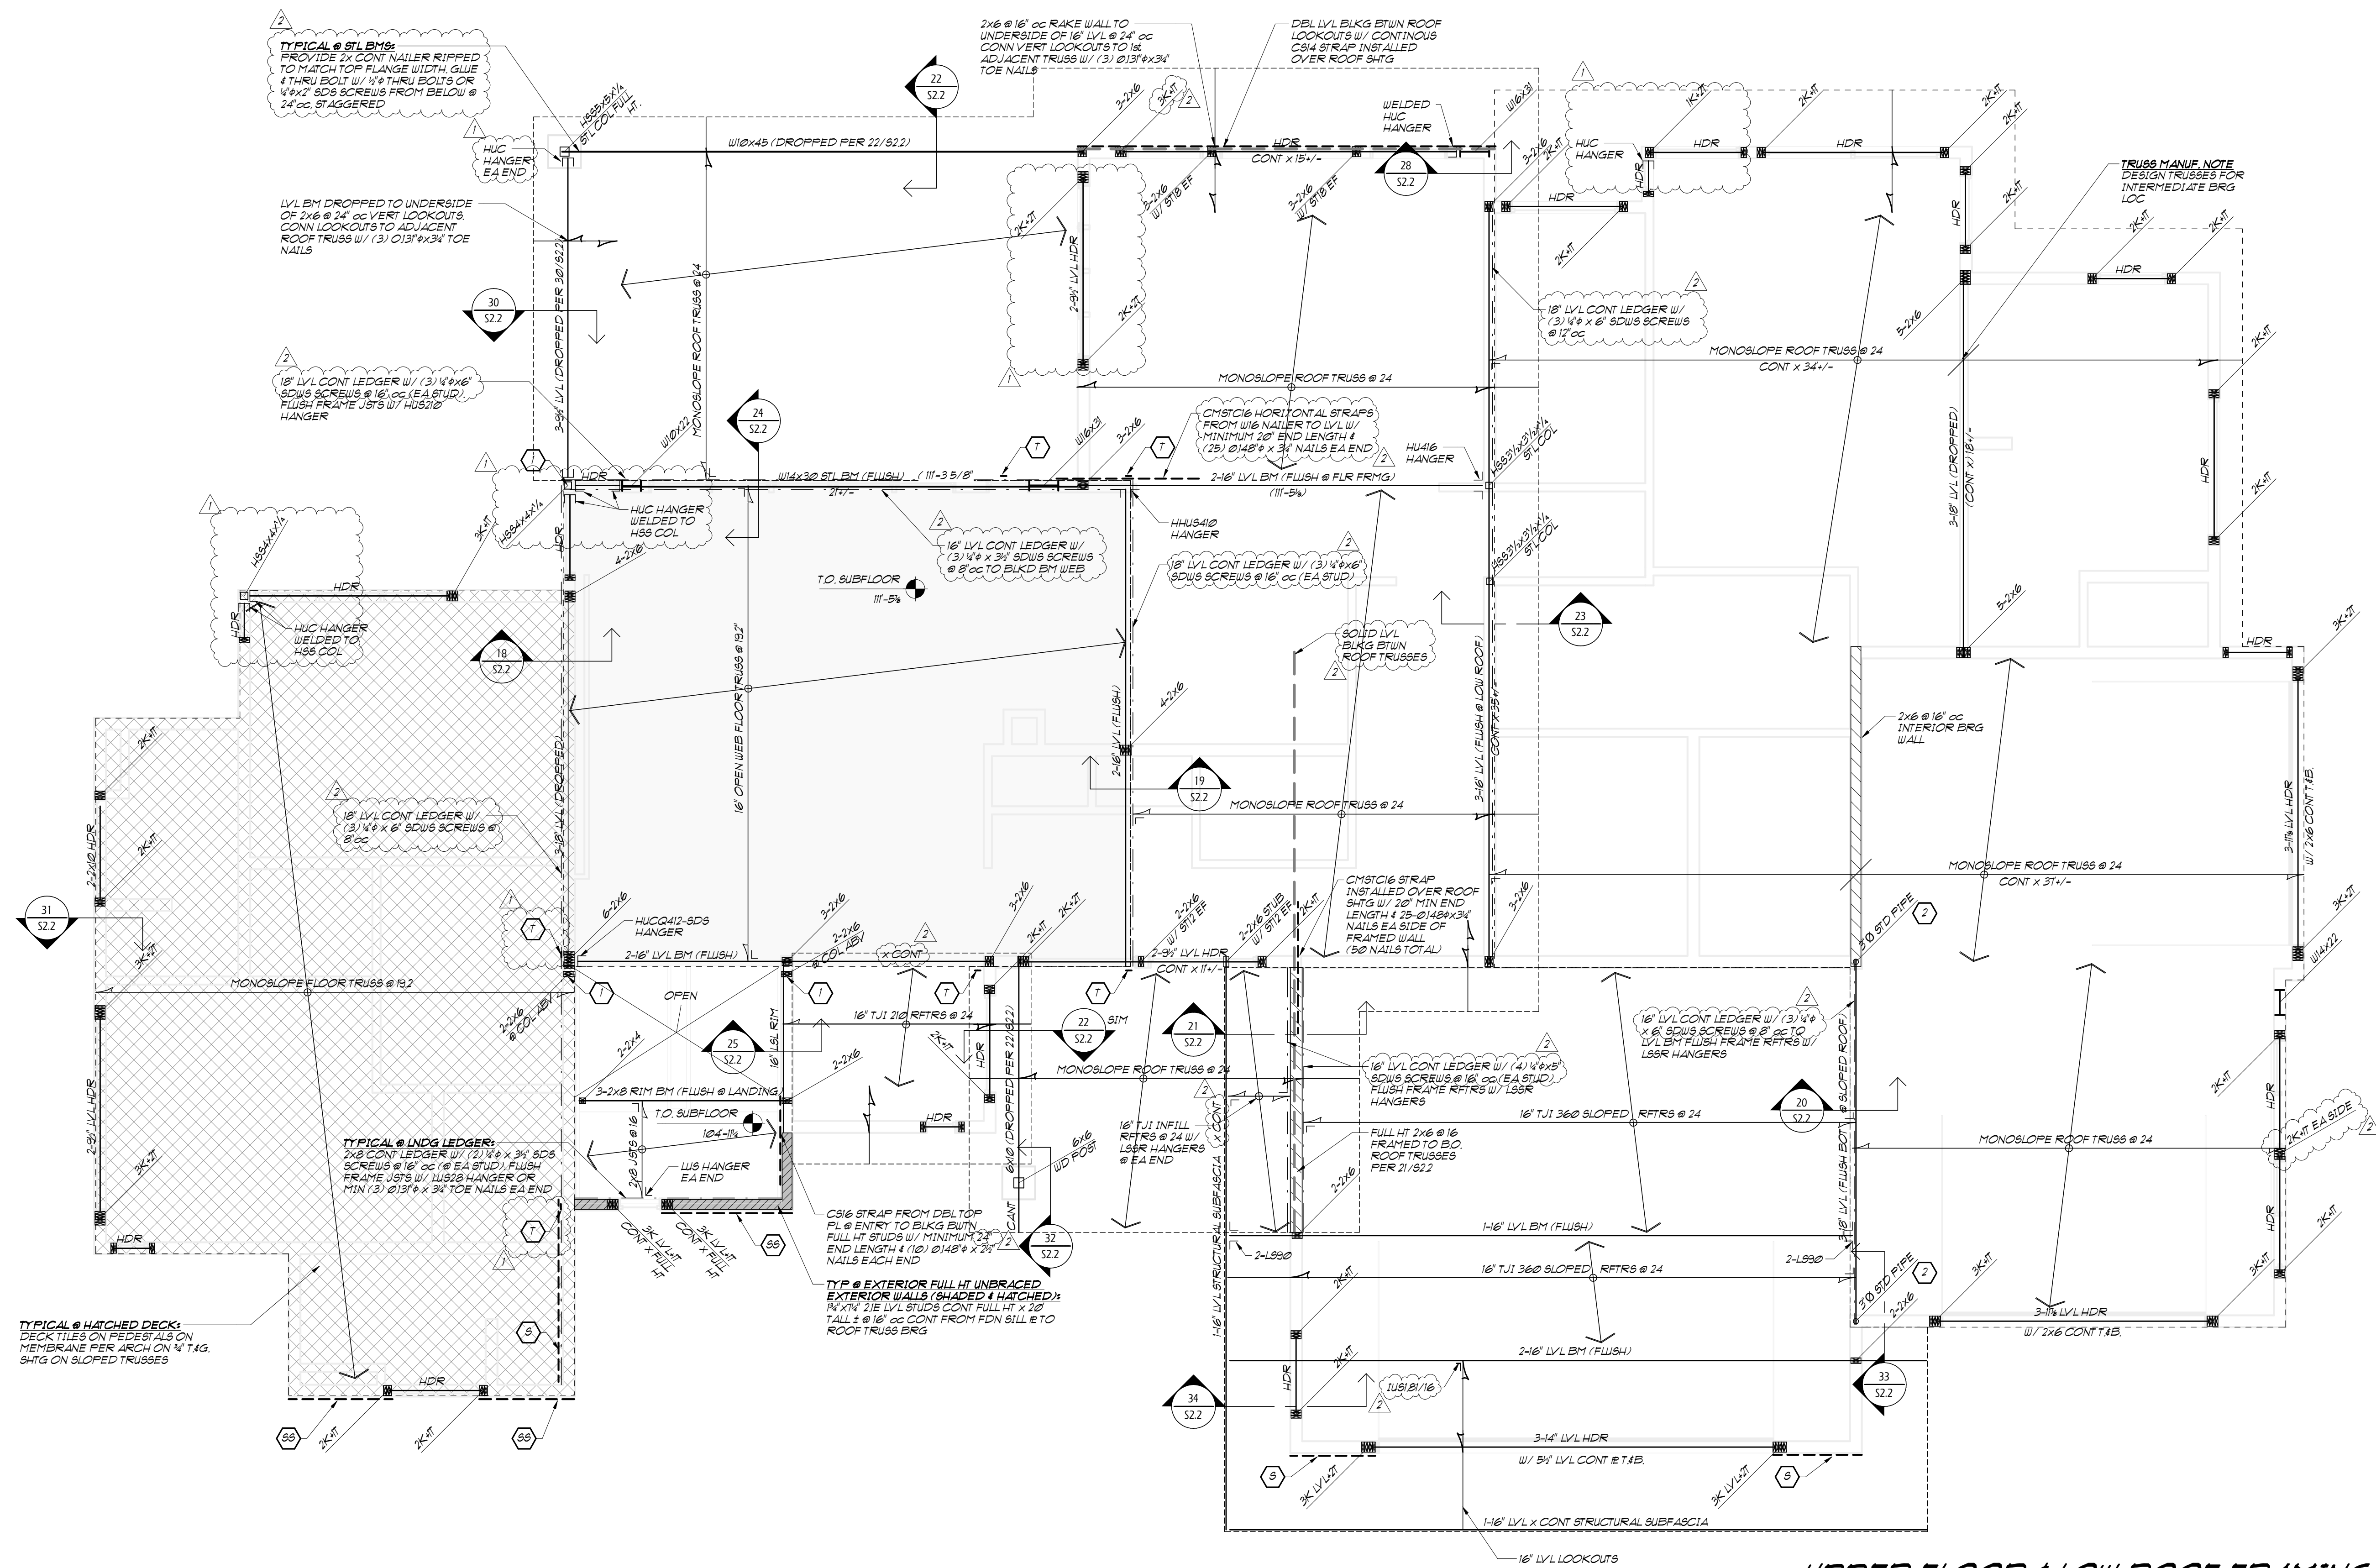


UPPER FLOOR & LOW ROOF FRAMING PLAN

- GRAPHIC SCALE: 1" = 4'-0"
- HEADERS TO BE 2x6 OR 3x2x6 W/ 1-2x6 KING (K) & 1-2x6 TRIMMER (T) EACH END OR AS NOTED ON PLANS OR GENERAL STRUCTURAL NOTES W/ ADDITIONAL CRIPPLES (C) AS NOTED AT POINT LOADS ABOVE BETWEEN TOP PLATES AND TOP OF HEADER
 - INTERIOR PARTITIONS TO BE MINIMUM 2x4 @ 24" OC W/ 1/2" GYPSUM BOARD 2-SIDES W/ 1" DRY WALL SCREWS OR EQUIVALENT @ 8" OC AT PANEL EDGES & 12" OC IN FIELDS
 - EXTERIOR WALLS TO BE MINIMUM 2x6 @ 16" OC W/ ZIP R-3 R-SHEATHING W/ 2x4 NAILS 4" OC AT PANEL EDGES & 12" OC IN FIELDS. BLOCK ALL UNSUPPORTED EDGES
 - LOCATE WALL SHEATHING SPLICES EITHER AT 2x BLOCKING PANEL WITHIN THE WALL HEIGHT, CENTERED ON ONE OF THE TOP OF WALL PLATES OR MINIMUM 1" FROM TOP AND/OR BOT OF FLOOR RIM W/ EACH SHEAR PANEL NAILLED THERETO W/ PANEL-EDGE NAILING
 - SHEATH FLOOR W/ MINIMUM 1/2" APA RATED OSB T&G SHEATHING W/ 2x4 NAILS 6" OC AT PANEL/BOUNDARY EDGES & 12" OC IN FIELDS
 - WOOD JOISTS TO BE TRUS JOIST TJI 210 SERIES OR AS NOTED
 - ENGINEERED TRUSSES TO TRUSS CONNECTIONS, BRIDGING, & PERMANENT BRACING DESIGN & SPECIFICATION BY TRUSS MANUFACTURER
 - TIE DOWN ROOF BEAMS & GIRDER TRUSSES AT BEARING W/ ST22 W/ (10) 2x6 @ 24" NAILS OR MT820 W/ (14) 2x6 @ 24" NAILS TO STUD PACK BELOW, CENTERED AT BEAM BEARING
 - TIE DOWN WOOD 1 RATTERS AT BEARINGS W/ 1/4" W/ 1/2" 2x6 @ 24" NAILS OR AS NOTED
 - PROVIDE 2x6 VERTICAL BLOCKING THROUGH FLOOR JOISTS AT COLUMN LOCATIONS ABOVE, TYPICAL THUS, OR MORE AS NOTED
 - TIE DOWN END OF SHEAR WALL ABOVE W/ 1-2x6 STRAPS TO STUD PACK ABOVE & BELOW FLOOR RIM (OR TO BEAM BELOW PER PLAN), CENTERED ON FLOOR RIM W/ MINIMUM 1" END LENGTH & (10) 2x6 @ 24" NAILS EACH END, INSTALL DIRECTLY TO FRAMING BEFORE INSTALLATION OF ZIP R-SHEATHING AT EXTERIOR CONDITION
 - INTERIOR SHEAR WALL TO BE SHEATHED W/ MINIMUM 1/2" APA RATED OSB SHEATHING NAIL W/ 2x4 NAILS 4" OC AT PANEL EDGES & 12" OC IN FIELDS. BLOCK ALL UNSUPPORTED EDGES NAIL SOLE PLATE TO BEAM/RIM BLOCKING BELOW W/ (2) 2x6 @ 24" NAILS @ 8" OC
 - EXTERIOR SHEAR WALL TO BE SHEATHED W/ MINIMUM 1/2" APA RATED OSB SHEATHING NAIL W/ 2x4 NAILS 4" OC AT PANEL EDGES & 12" OC IN FIELDS. BLOCK ALL UNSUPPORTED EDGES NAIL SOLE PLATE TO BEAM/RIM BLOCKING BELOW W/ (2) 2x6 @ 24" NAILS @ 8" OC. INSTALL DIRECTLY TO FRAMING BEFORE INSTALLATION OF ZIP R-SHEATHING
 - SEE SHEET S21 FOR GENERAL STRUCTURAL NOTES




-

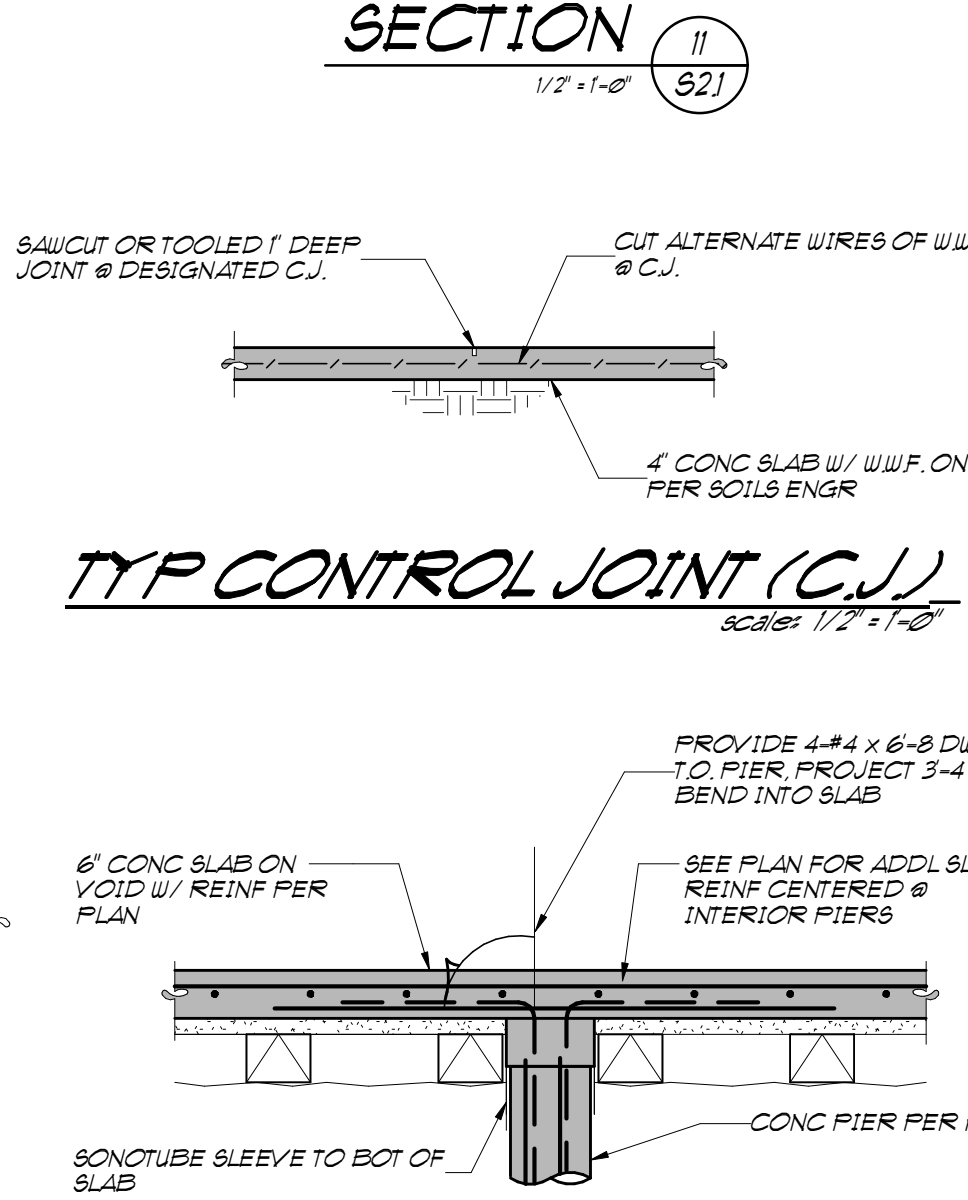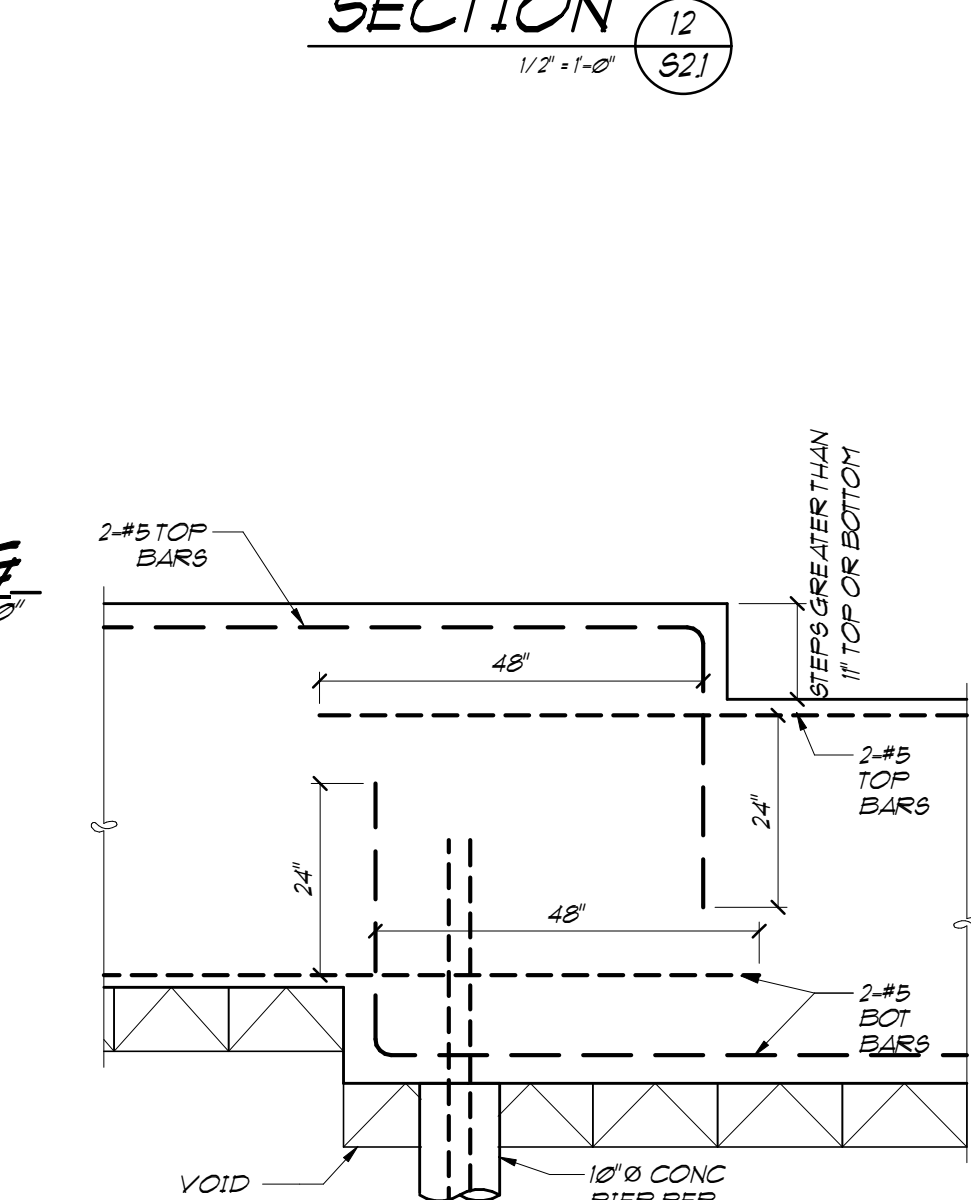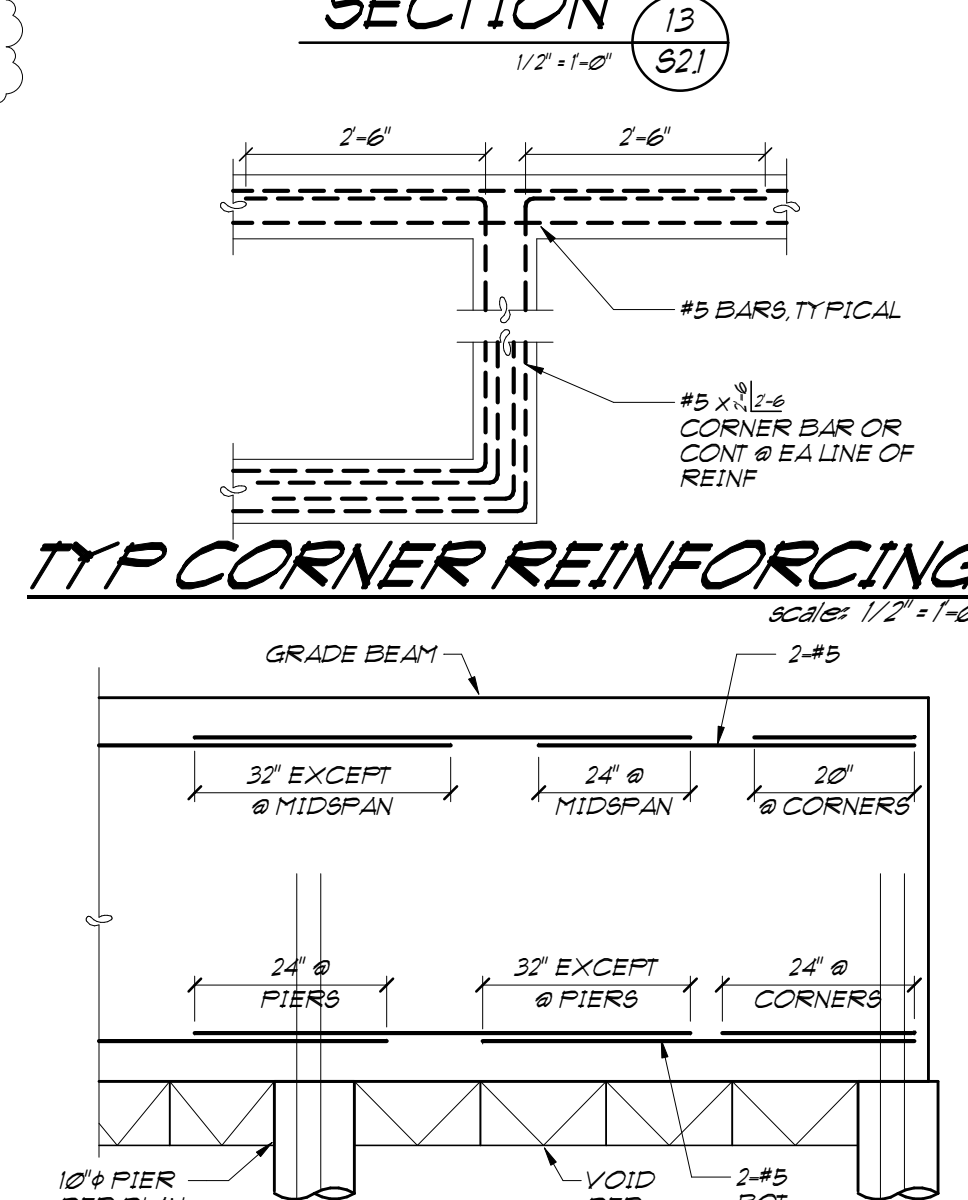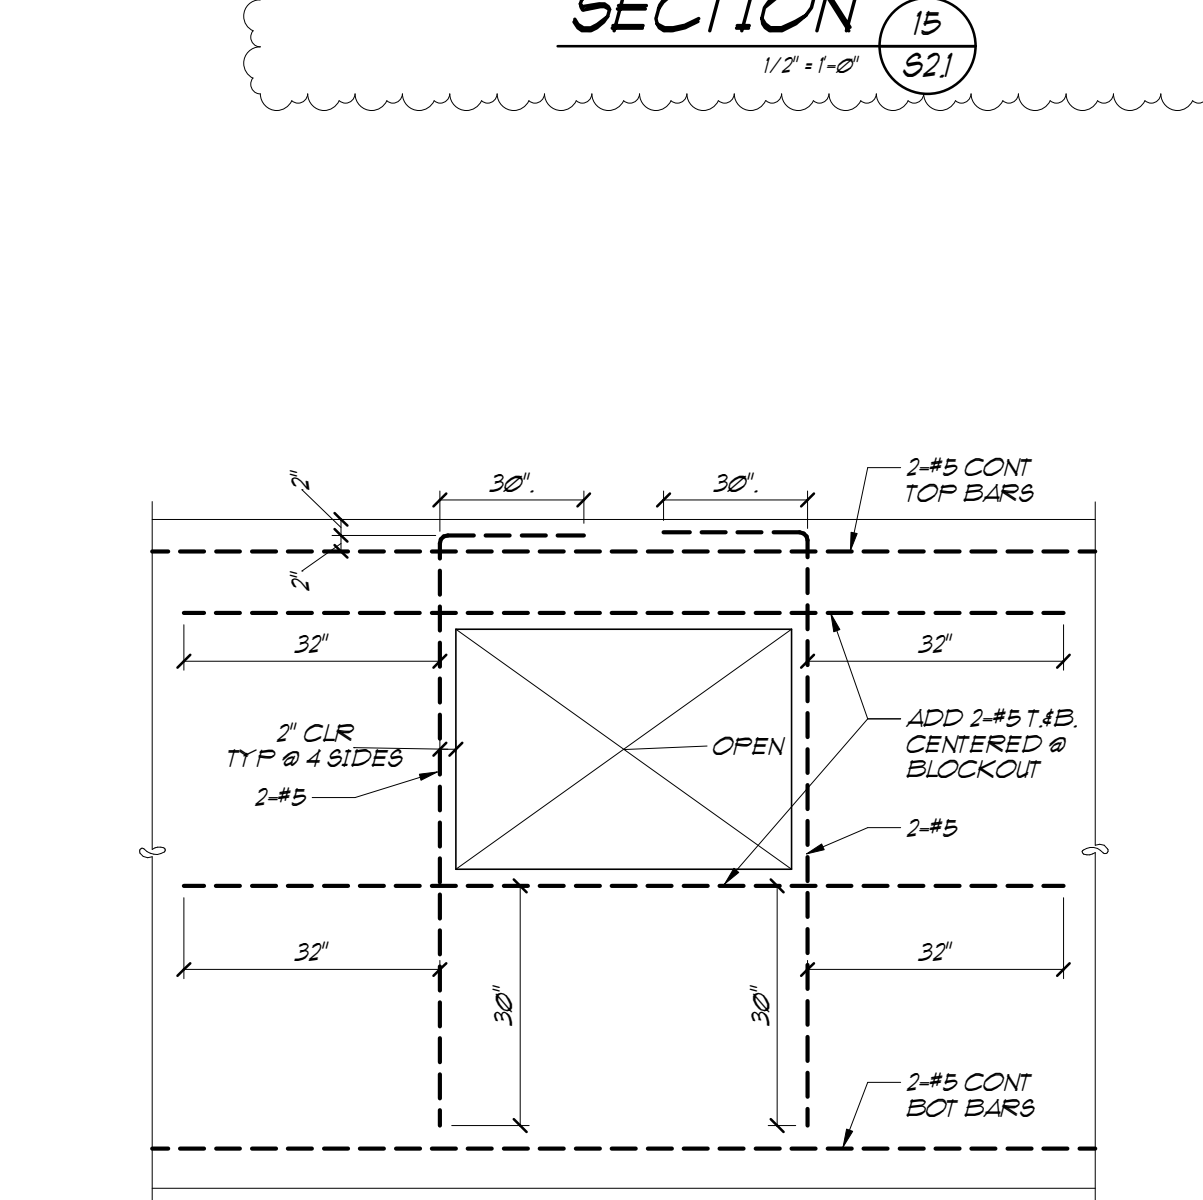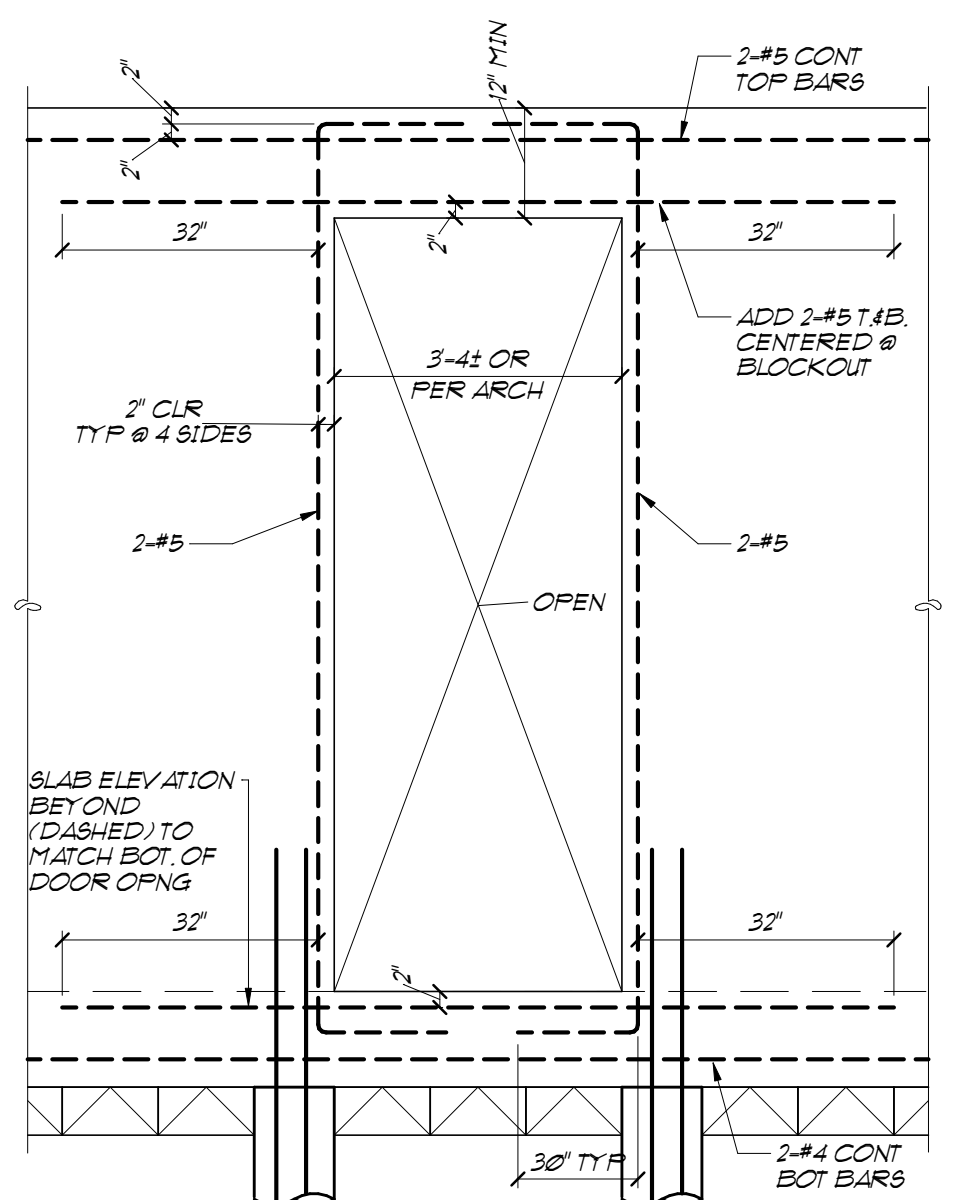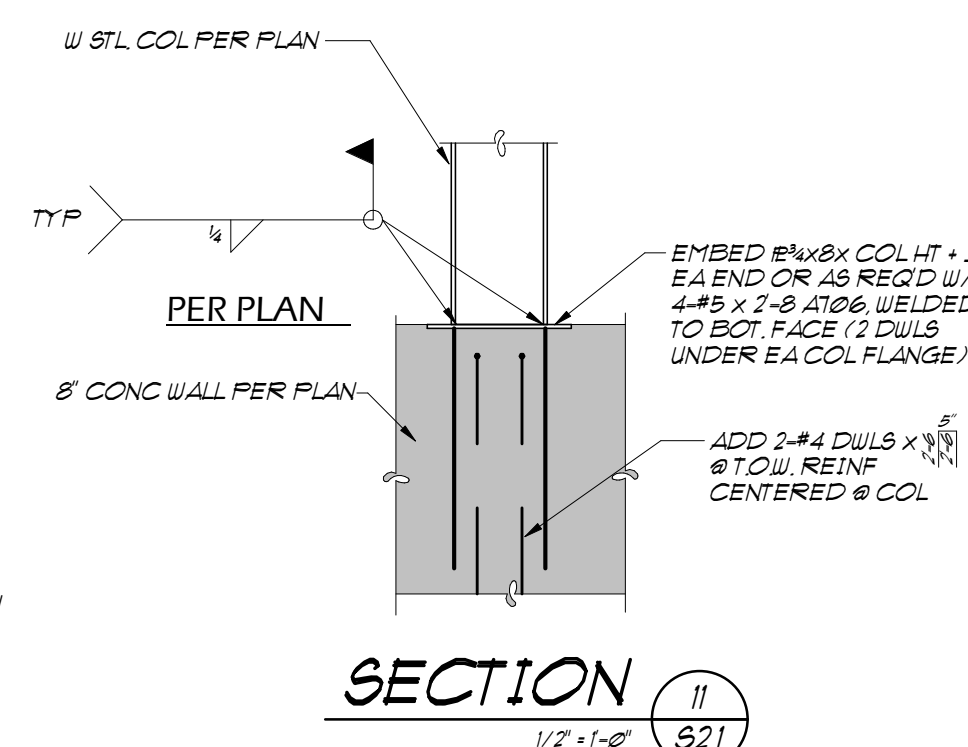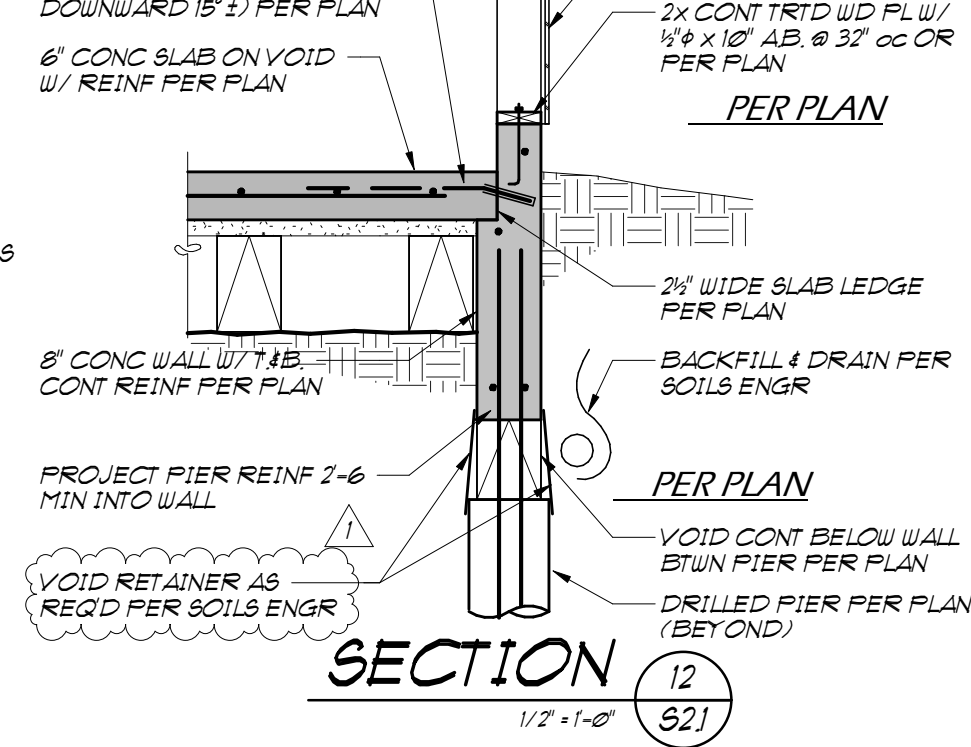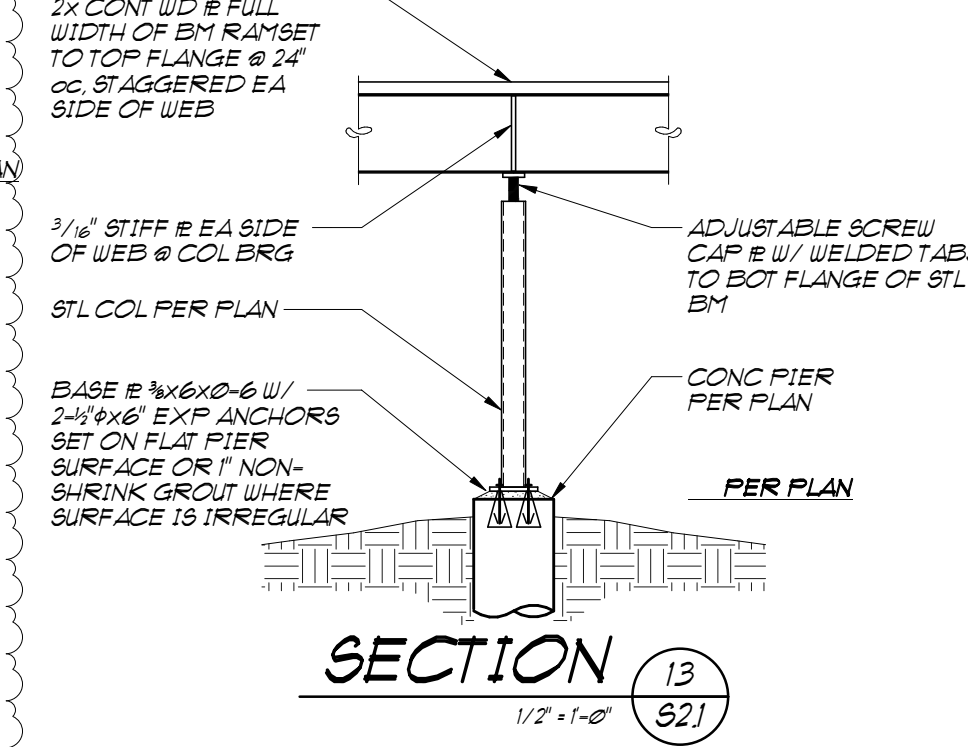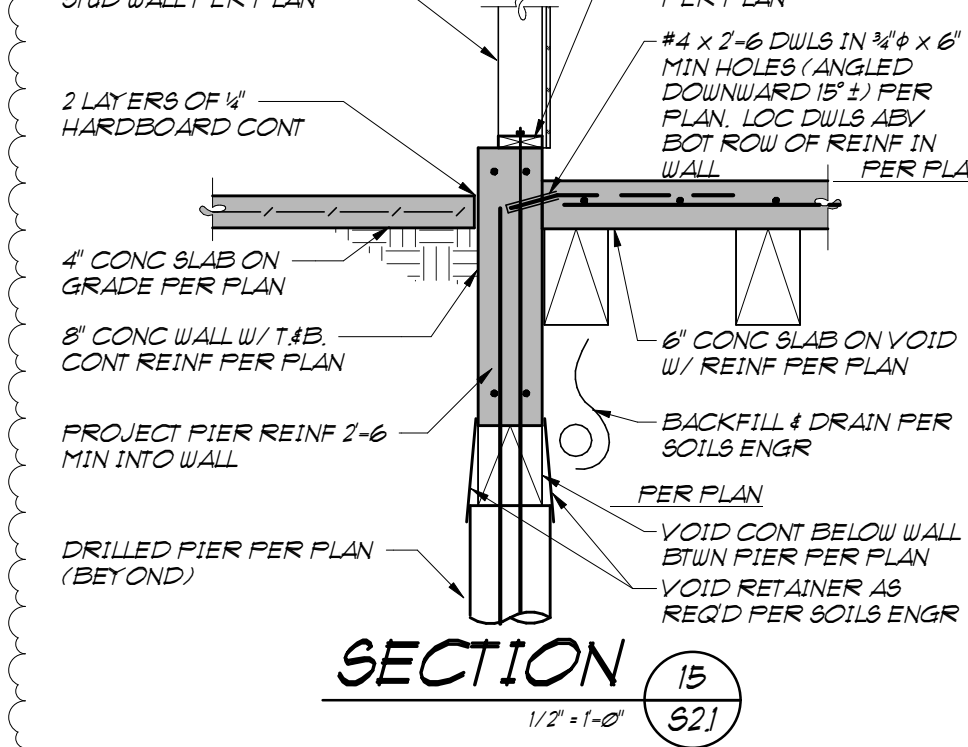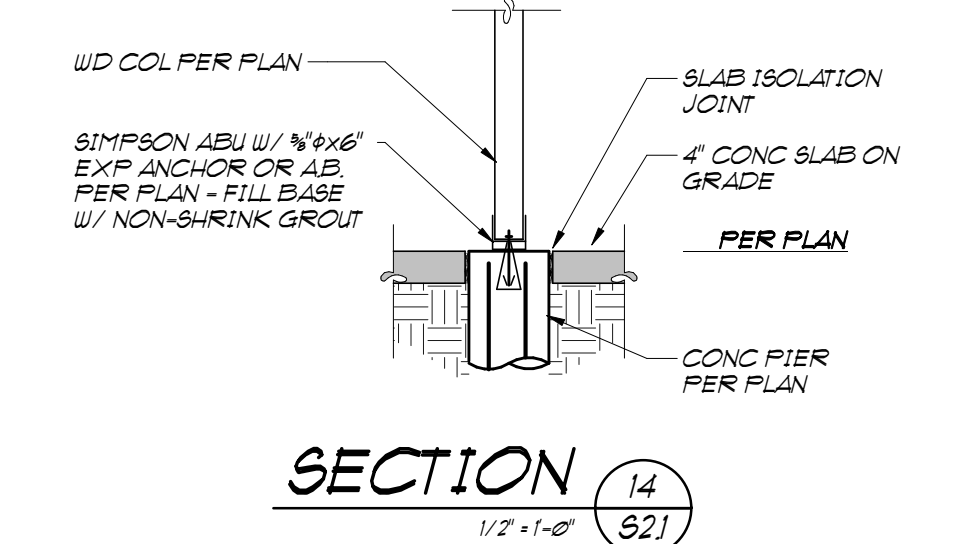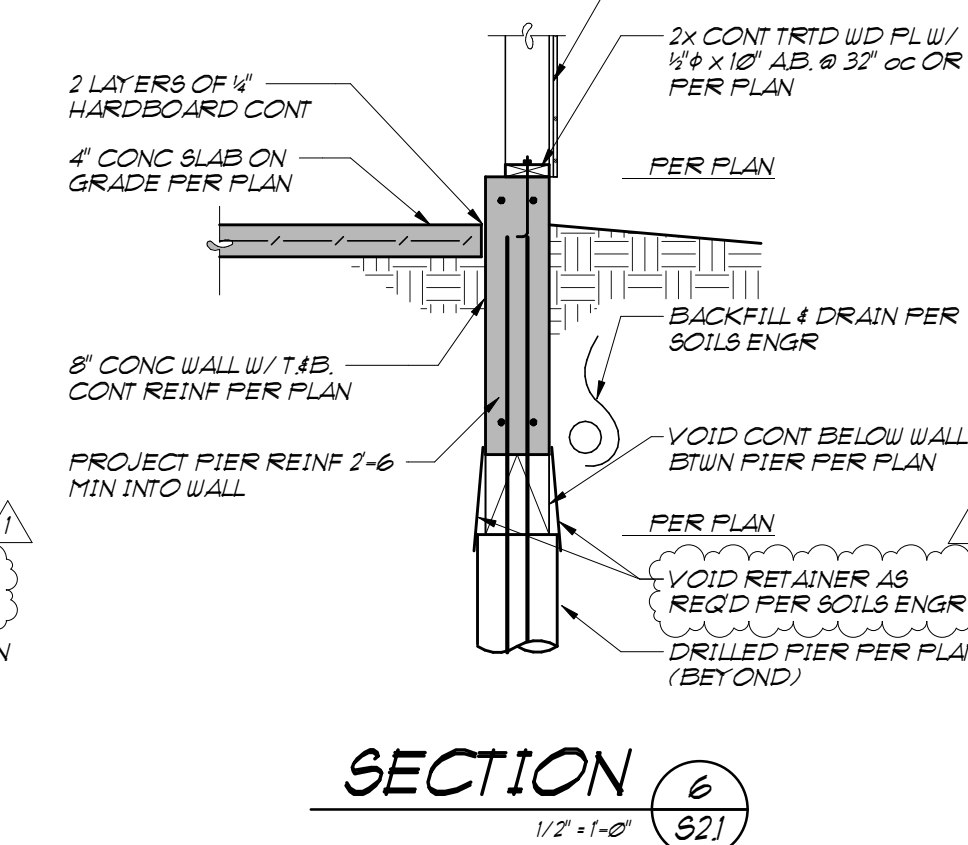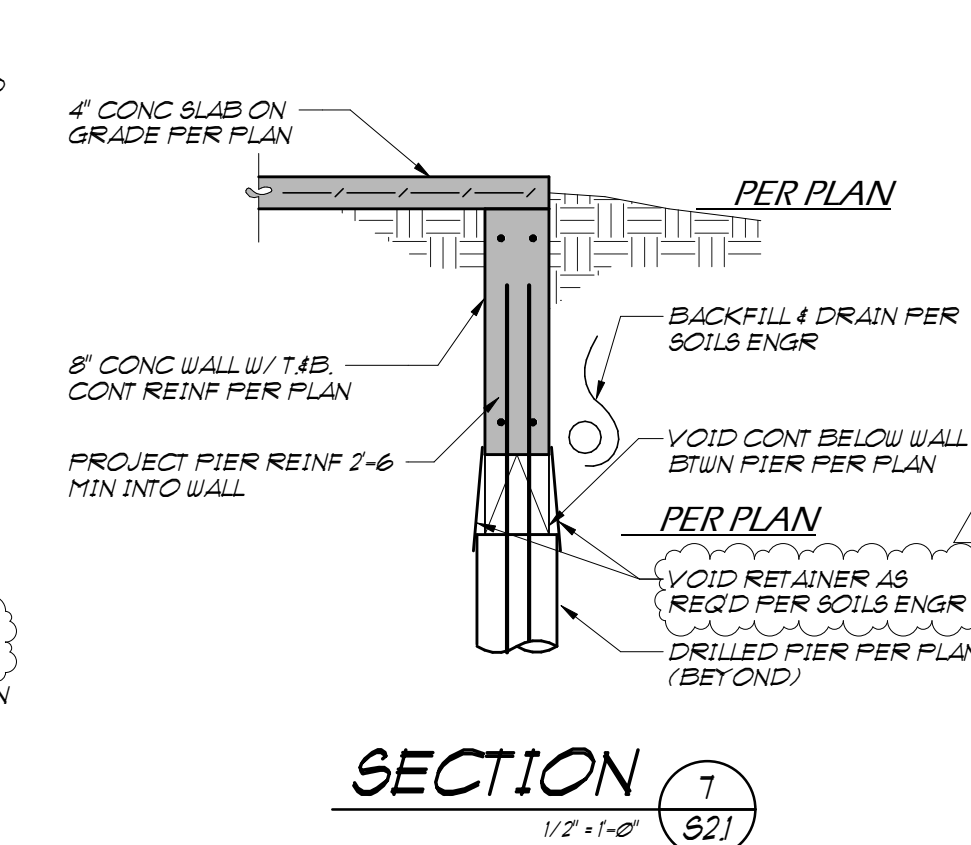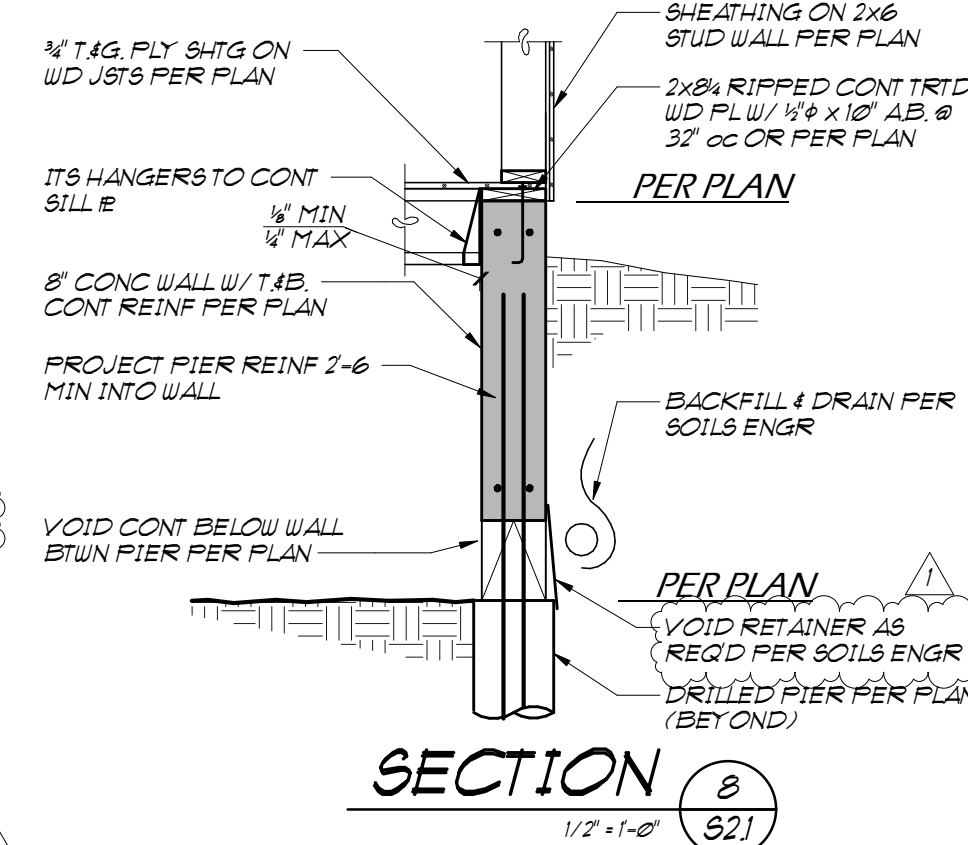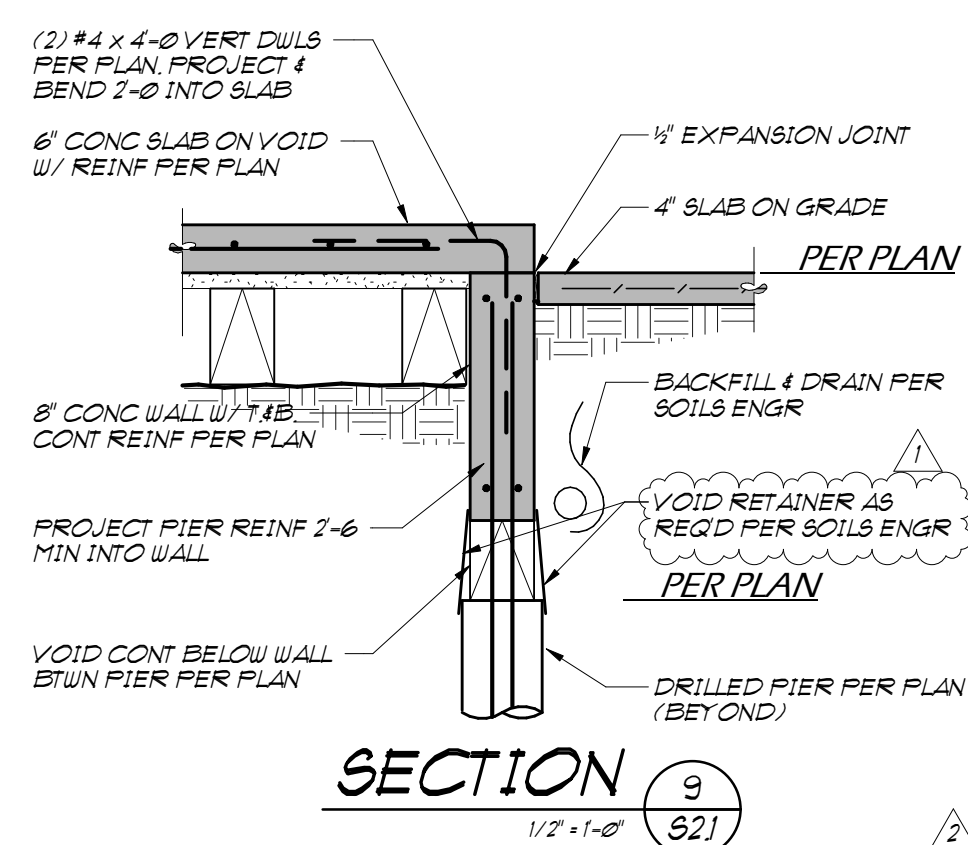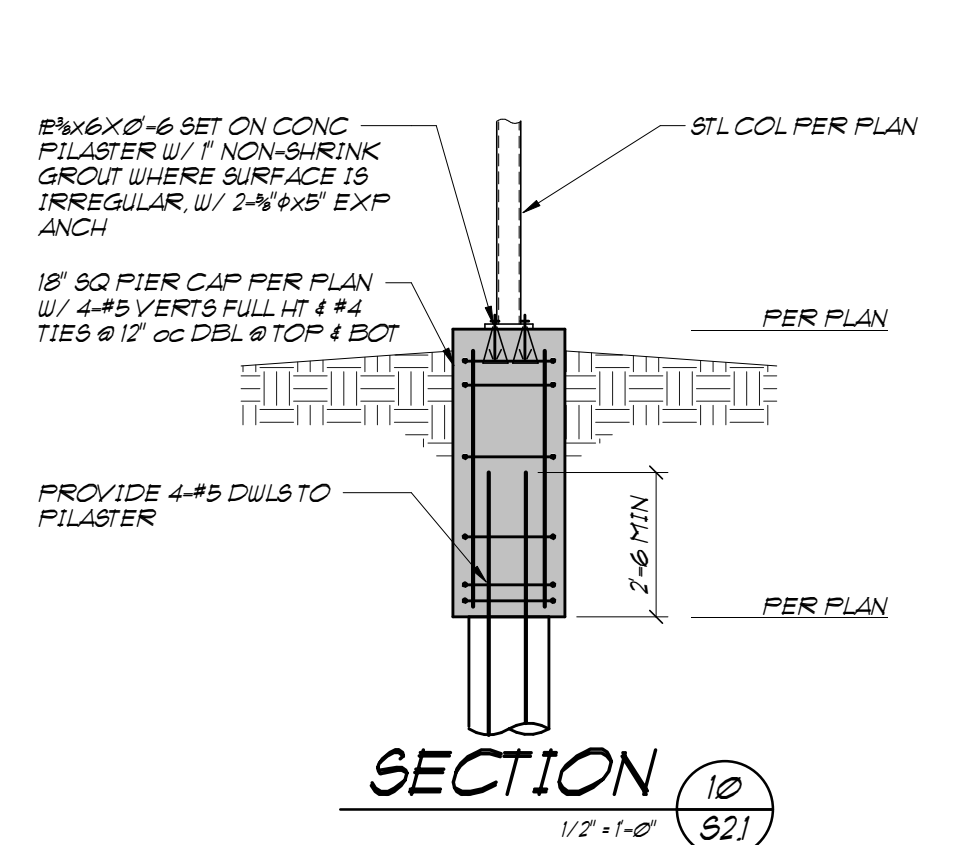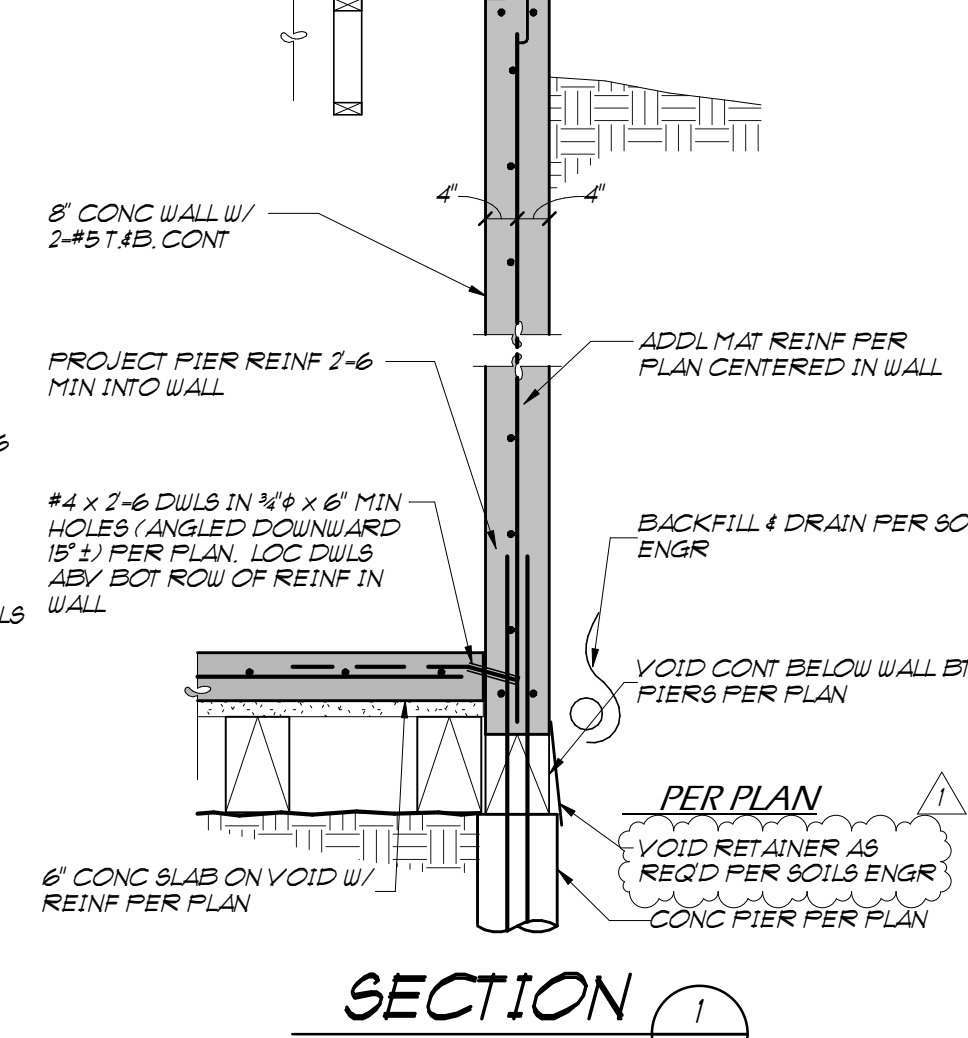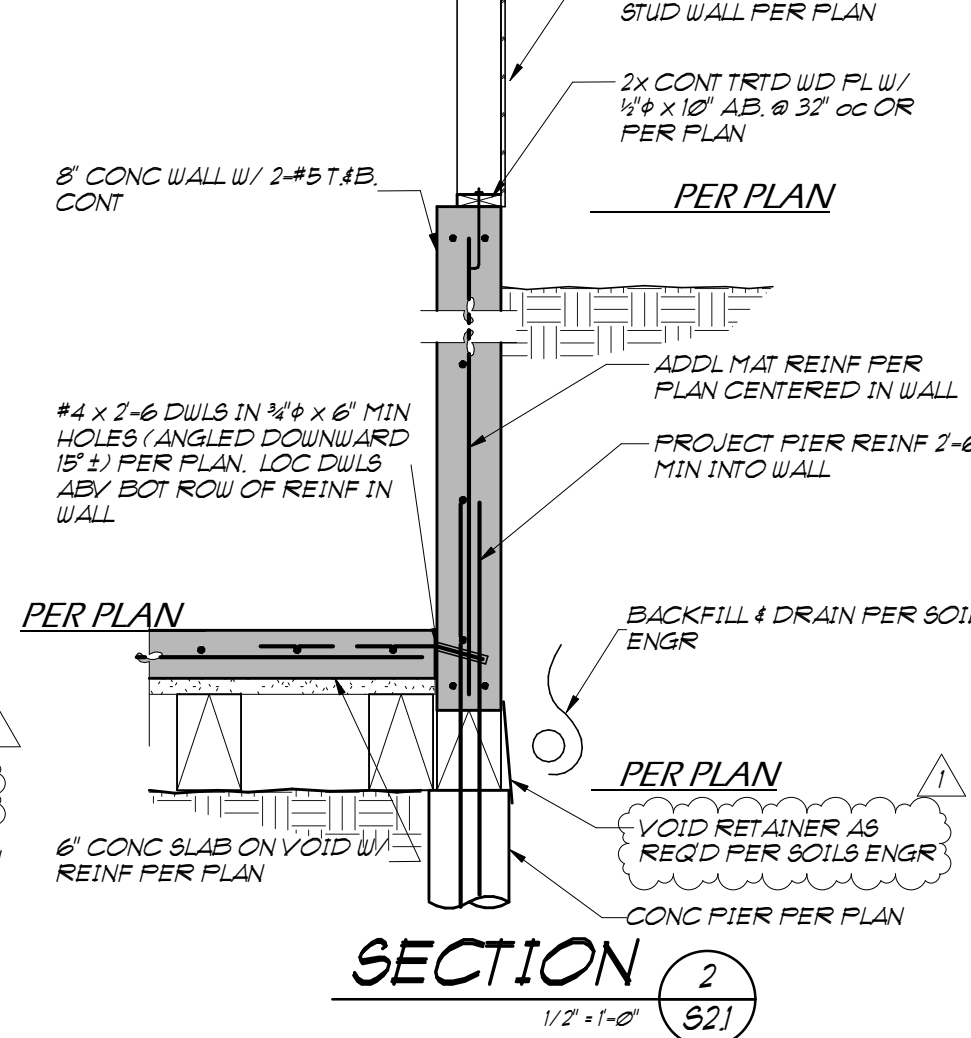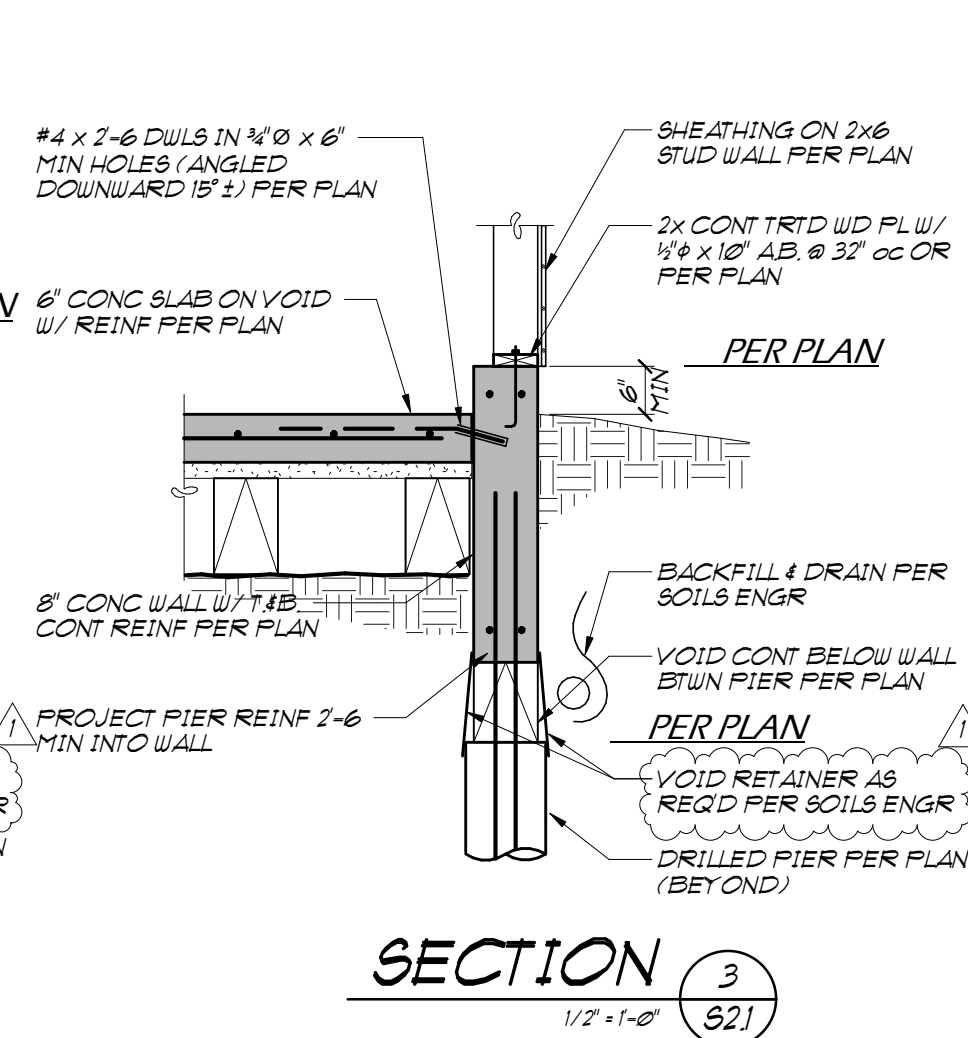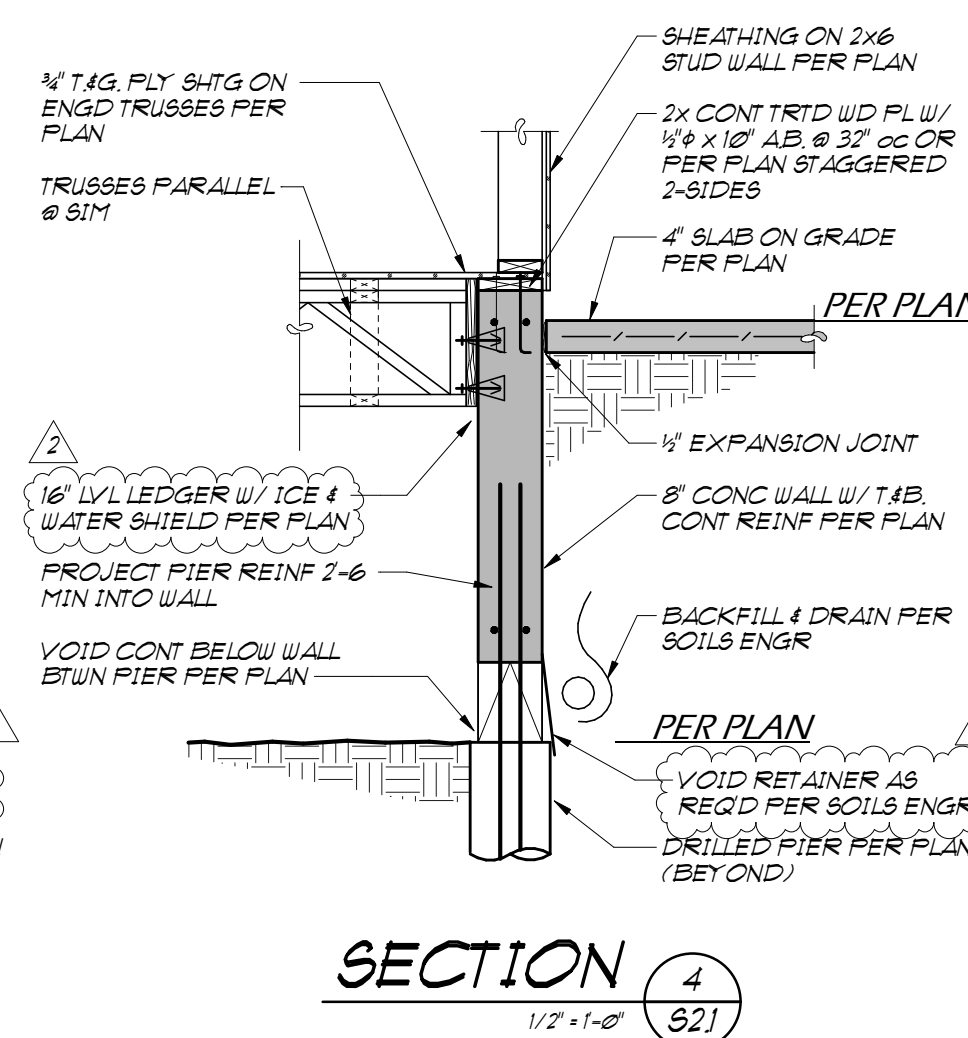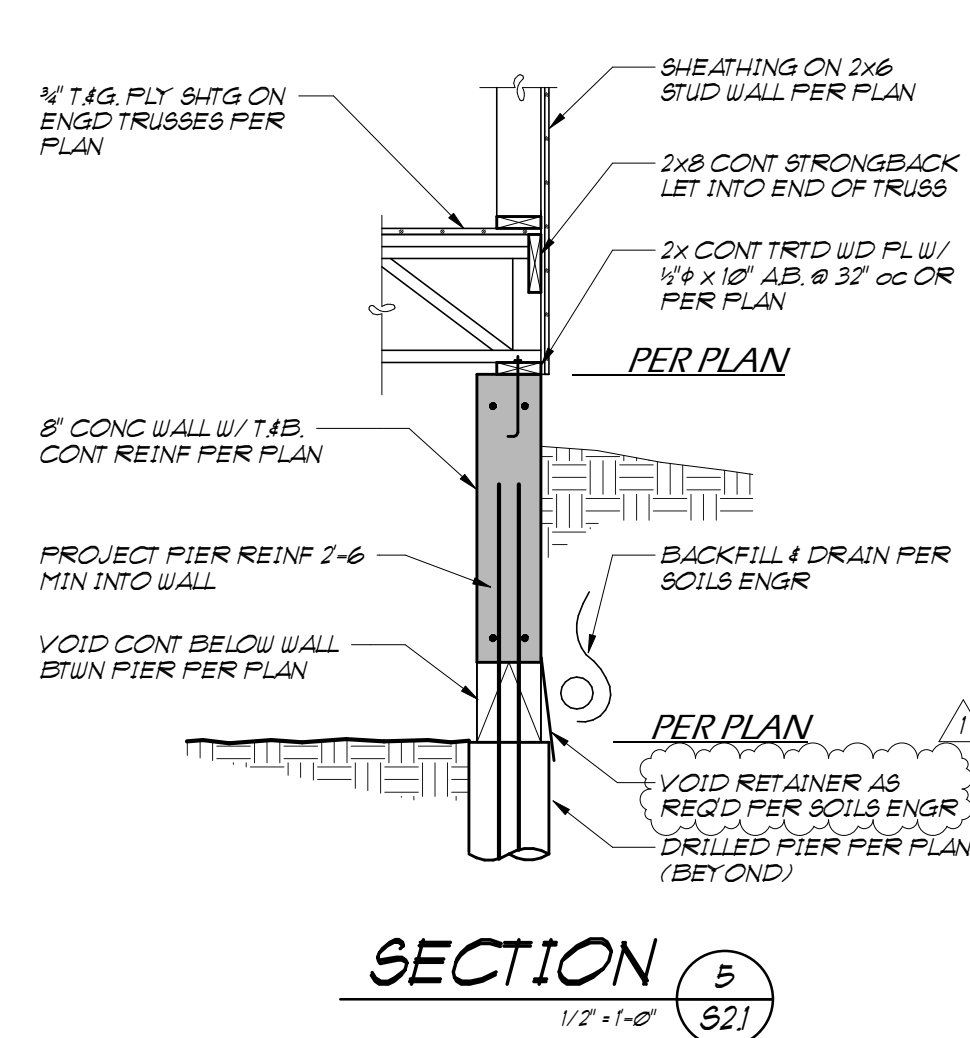


GENERAL STRUCTURAL NOTES JOB: # 2508
PROJECT: 1655 SPRING DRIVE
1655 SPRING DRIVE, UNIT 160
BOULDER COUNTY, COLORADO 80502
BY BOULDER COUNTY AMENDMENTS
BUILDER COUNTY
II

DESIGN CRITERIA
BUILDING CODE
SEISMICITY
RISK CATEGORY
DESIGN WIND
FLOOR:
DEAD LOAD 10 PSF
LIVE LOAD 40 PSF
EXTENSION (DECK):
DEAD LOAD 10 PSF
LIVE LOAD 40 PSF
ROOF:
DEAD LOAD 10 PSF
GROUND SNOW LOAD P, UNIFORM CASE FACTOR 1, 33 PSF (P, = 0.7 * P_g * C_e * C_g * C_u * I_w)
ROOF SNOW LOAD P_s, 33 PSF (P_s = 0.7 * P_g * C_e * C_g * C_u * I_w)
WIND:
V₁ 55 MPH
EXPOSURE CATEGORY B


INSPECTIONS
THE FOLLOWING ITEMS REQUIRE SPECIAL INSPECTION (FROM GEBAL INC. OR BY AN INSPECTION COMPANY) PRIOR TO GEBAL INC. BUILDING WORK:
1. FOUNDATION AND RETAINMENT WALLS PRIOR TO POUR
2. GEOTECHNICAL ENGINEER OF SECOND CLASS SHALL PERFORM OPEN HOLE VERIFICATION OF SOIL CONDITIONS PRIOR TO CONSTRUCTION
3. FOUNDATION SHALL FORMS REINFORCING ANCHORS BOLTS EMBEDDED HOLDINGS. MOMENT FRAME BEAMS AND WALLS SHOULD BE REINFORCED PRIOR TO POUR
4. REINFORCED CONCRETE STRUCTURAL FLOOR SLAB FORMS REINFORCEMENT AND WELD
5. STRUCTURAL STEEL FRAMING ELEMENTS, BOLTING, AND FIELD WELDS
6. GENERAL WOOD FRAMING, CONNECTIONS AND FASTENING
WOOD PANEL SHEAR WALL NAILING AND HOLDINGS PRIOR TO BUILDING WARP OR BEAM TIE
7. FOUNDATIONS
FOUNDATION DESIGNED IN ACCORDANCE WITH RECOMMENDATIONS CONTAINED IN SOILS BORING REPORT PREPARED BY SUBMITTER CONSULTING ENGINEERS SOILS REPORT NO. 20-035 DATED MARCH 4, 2015.
EXCEPT WHERE OTHERWISE SPECIFICALLY NOTED HEREIN, ALL RECOMMENDATIONS AND PRECAUTIONS CONTAINED IN THIS REPORT SHALL BE ADHERED TO BY THE CONTRACTOR
STRUCTURE SHALL BE FOUNDED UPON DRAILED PIERS (CASSIONS)
PIERS SHALL PENETRATE NOT LESS THAN 12 FEET INTO COMPACTED CLAYSTONE OR SANDSTONE BEDROCK
WHERE GREATER PENETRATION IS REQUIRED, SUCH PENETRATION IS NOTED ON PLANS.
BOTTOM OF EACH TIE 1 FEET BELOW EXCAVATION (MINIMUM PIER LENGTH)
MAXIMUM DESIGN END BEARING PRESSURE: 25,000 PSF
MINIMUM DEAD LOAD BEARING PRESSURE: 1,000 PSF
MAXIMUM DESIGN SIDE SHEAR: 12,000 PSF
ALL DRAILED PIERS (CASSIONS) SHALL BE REINFORCED TO FULL CIRCULAR FULL LENGTH QTY 13 BAR SIZE #4 REINFORCED @ 6" ON C/S
PROVIDE 12 INCH VOID BETWEEN PIERS (OR PADS) UNDER ALL WALLS AND GRADE BEAMS
PROVIDE 12 INCH VOID UNDER ALL REINFORCED STRUCTURAL FLOOR SLABS OR MORE AS NOTED ON PLANS
EXTEND CASSIONS REINFORCING MINIMUM 1'-6" INTO GRADE BEAM OR WALL OR MORE AS NOTED ON PLANS
FLOOR ALL PARTITIONS AND TRIM MATERIAL A MINIMUM OF 2 INCHES FROM GROUND-SUPPORTED SUBS ON CONCRETE FOUNDATIONS
DESIGN ALL LATERAL SOIL PRESSURE (EQUIVALENT FLUID PRESSURE) AS PSF (FT. / 14.7 KSI)
PROVIDE FOUNDATION PERIMETER DRAIN AND WATERPROOFING PER SOILS ENGINEER
SLOPE PERIMETER GRADING AWAY FROM BUILDING PER SOILS ENGINEER
CONCRETE AND REINFORCEMENT
CONCRETE SHALL CONFORM TO APPLICABLE PROVISIONS OF LATEST REVISION OF ACI 318-14 ACI-318 MINIMUM 18 PSI COMPRESSIVE STRENGTH AS FOLLOWS:
ALL CONCRETE: 3500 PSI
CEMENT TYPE II IN CONCRETE EXPOSED TO SOIL, ALL OTHER TYPE I OR I/II
DEFINISHED REINFORCEMENT: ASTM A63 GRADE 60
WELDED REINFORCED REINFORCEMENT: ASTM A206-GR60
WELDED WIRE FABRIC: ASTM A186
REINFORCEMENT FABRICATED AND PLACED PER PLAN OF STAND PRACTICE (ACI-308)
TYPICAL FOUNDATION REINFORCEMENT 2-#5 TOP AND 2-#5 BOTTOM
SEE PLANS FOR OTHER REQUIREMENTS
CONCRETE MUST BE PLACED CONTINUOUSLY WITHOUT HORIZONTAL JOINT, JOINT IF JOINT JOINT IS DESIRED APPROPRIATE VERTICAL REINFORCEMENT MUST BE PROVIDED
COLD WEATHER PLACEMENT: CONTRACTOR SHALL FOLLOW SET FORTH IN ACI 318-14 MANUAL OF CONCRETE PRACTICE
JOINTS: SEE SECTION 05100-1.1 (1) (2) (3) (545) (546

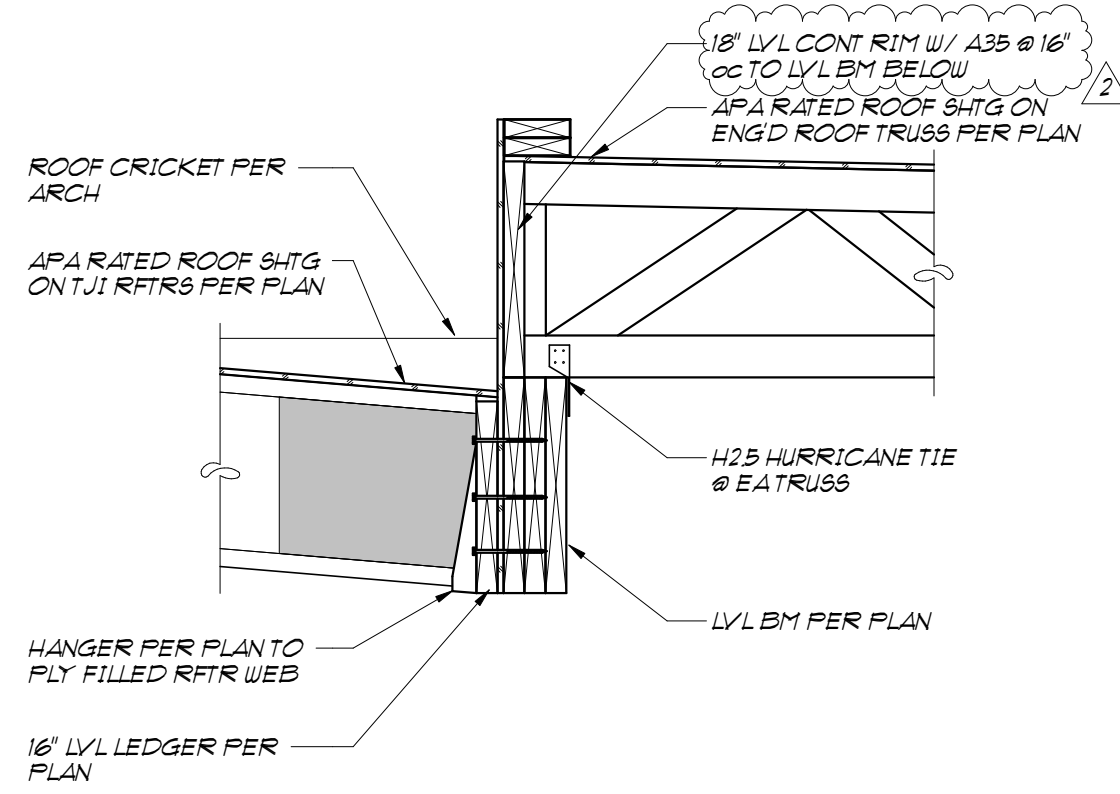


SECTION 20
3/4" x 1'-0" S2.2

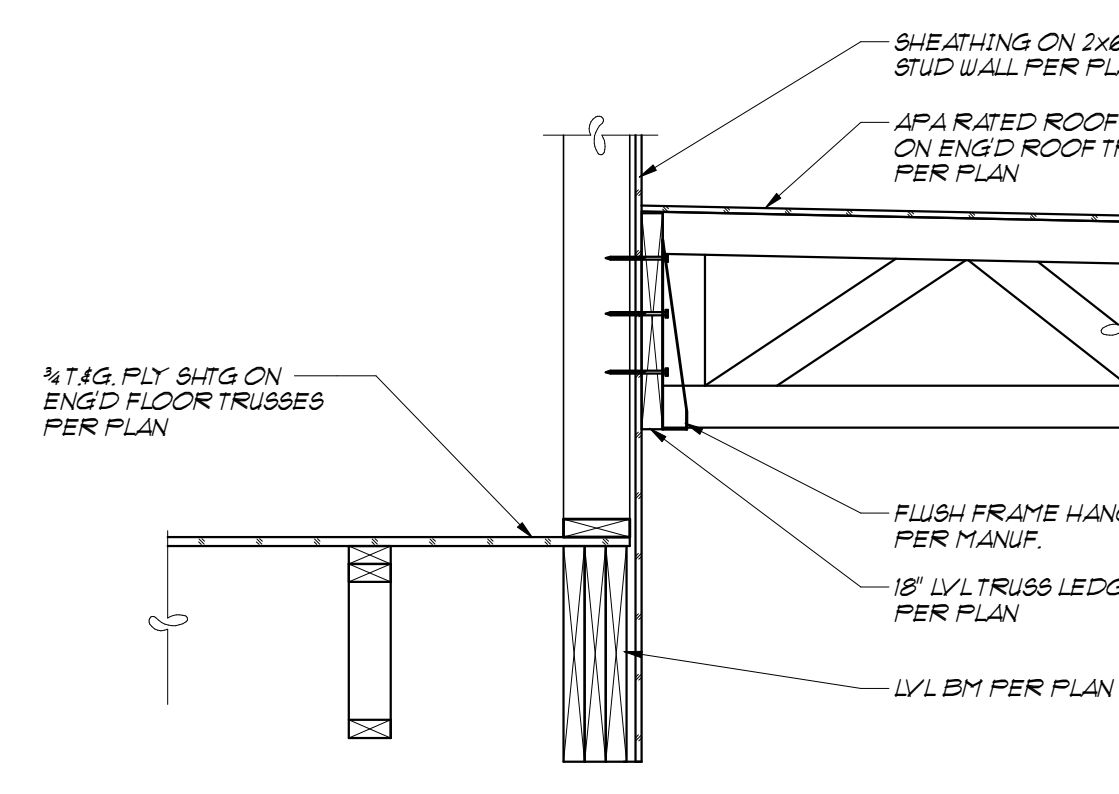


SECTION 19
3/4" x 1'-0" S2.2

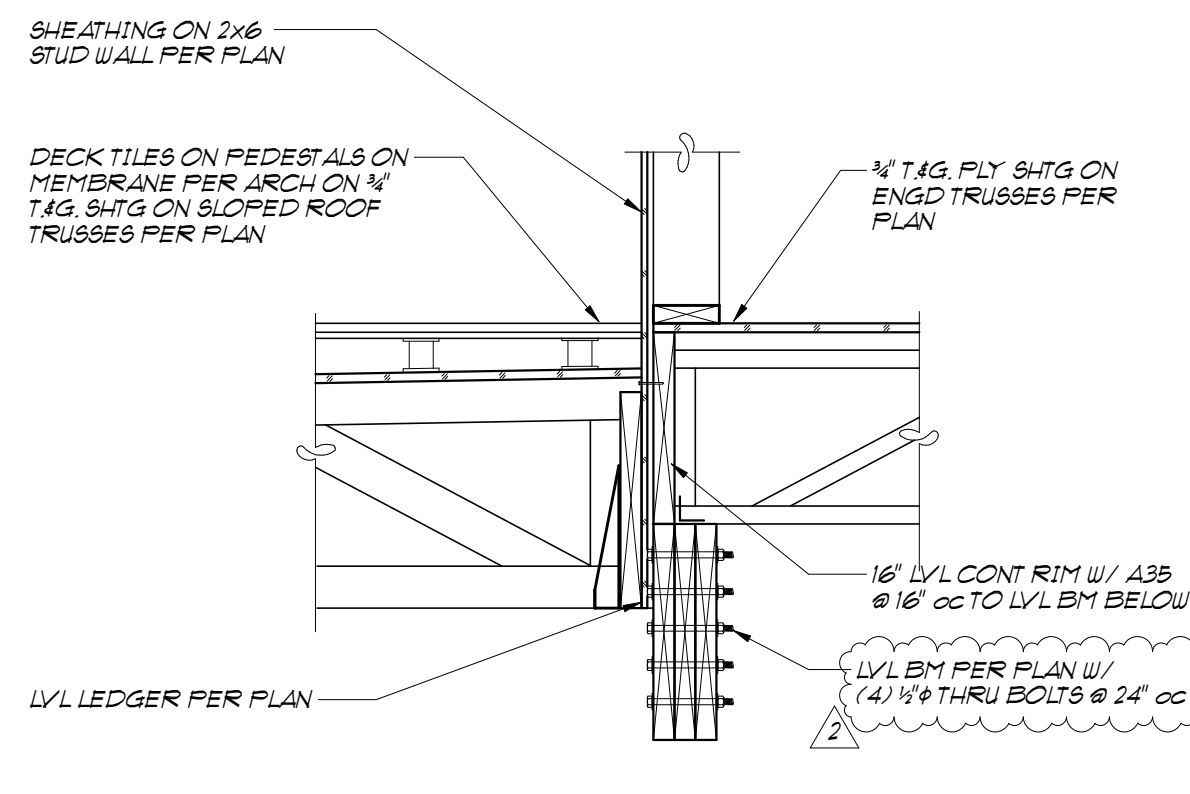


SECTION 18
3/4" x 1'-0" S2.2

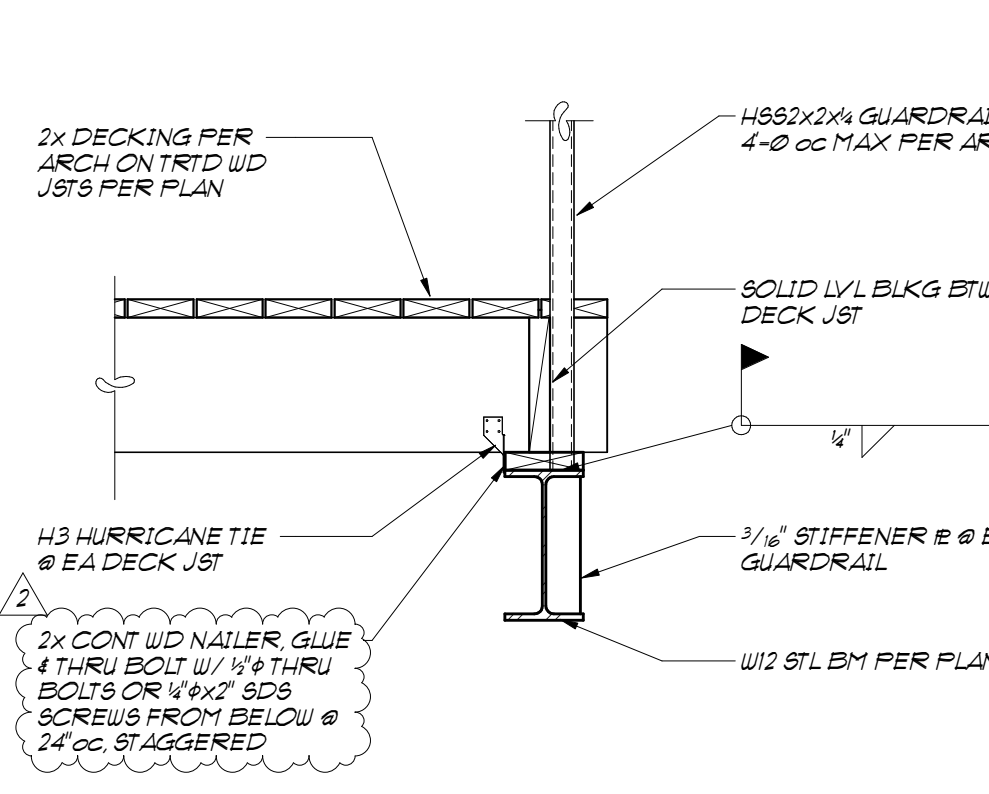


SECTION 17
3/4" x 1'-0" S2.2

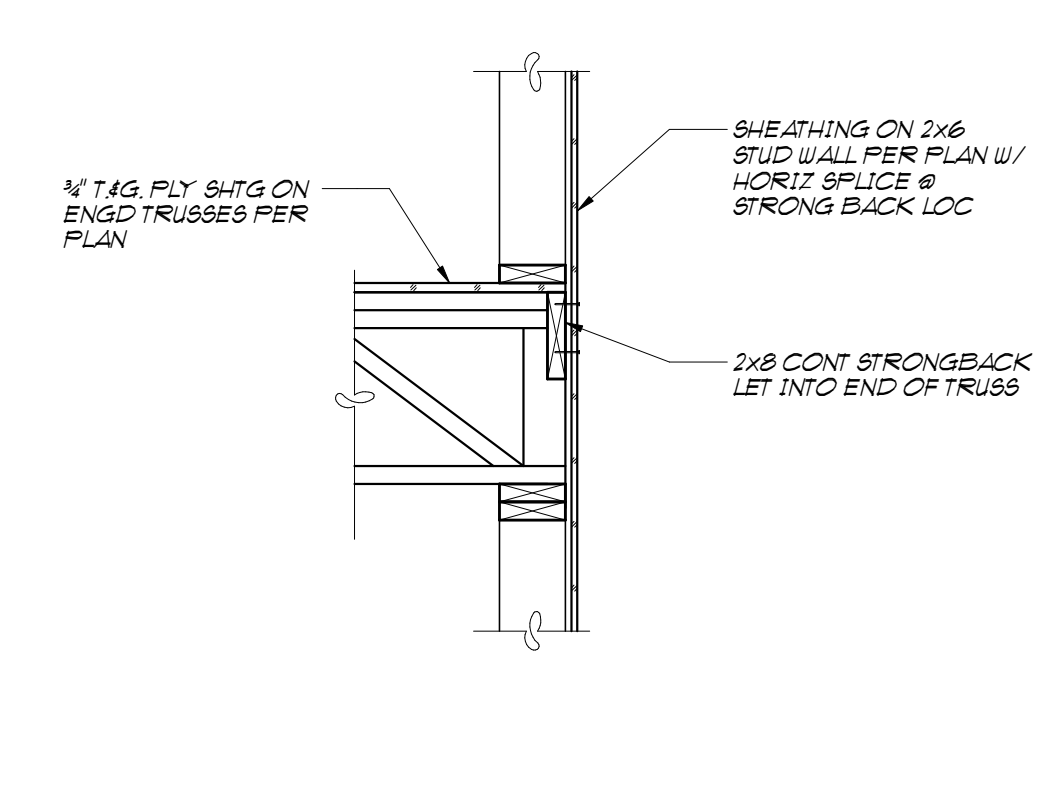


SECTION 16
3/4" x 1'-0" S2.2

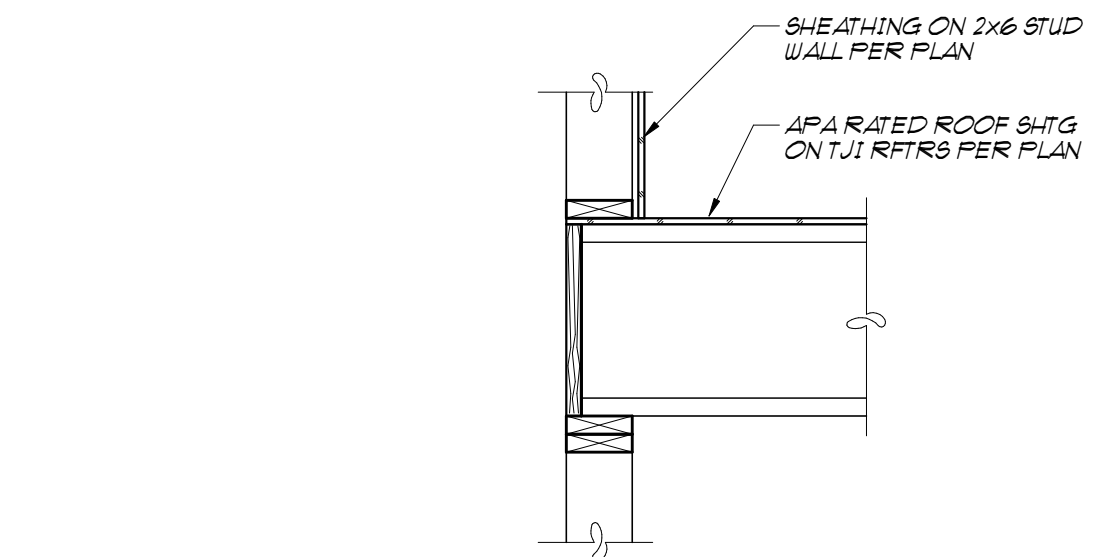


SECTION 25
3/4" x 1'-0" S2.2

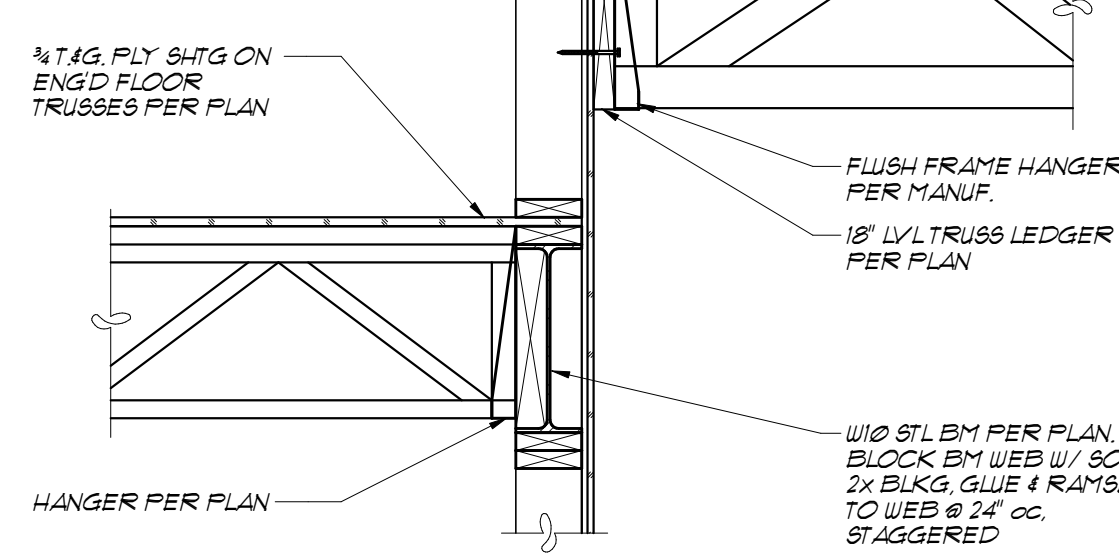


SECTION 24
3/4" x 1'-0" S2.2

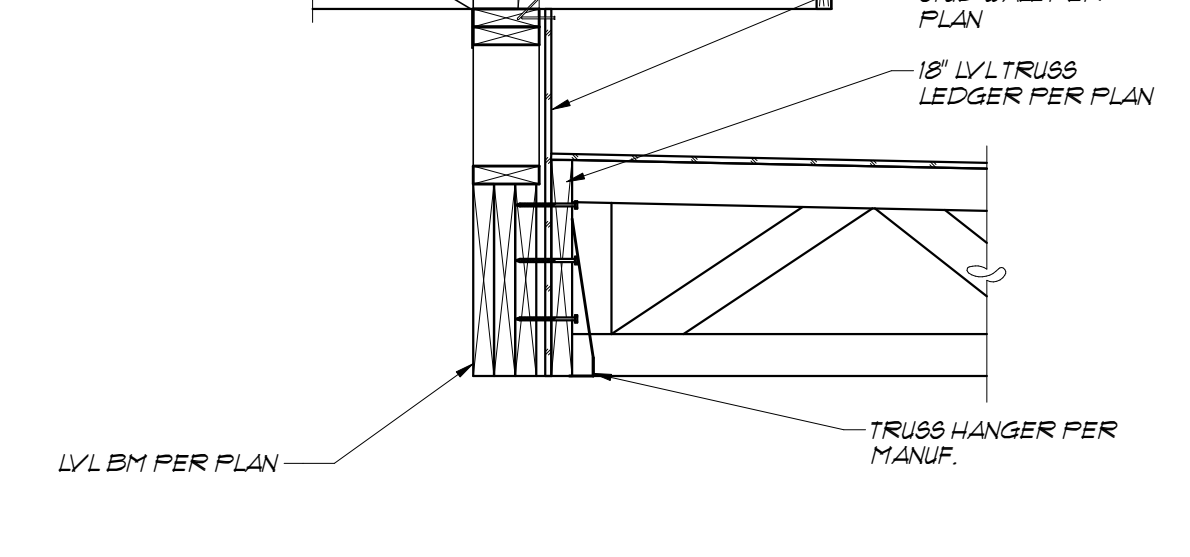


SECTION 23
3/4" x 1'-0" S2.2

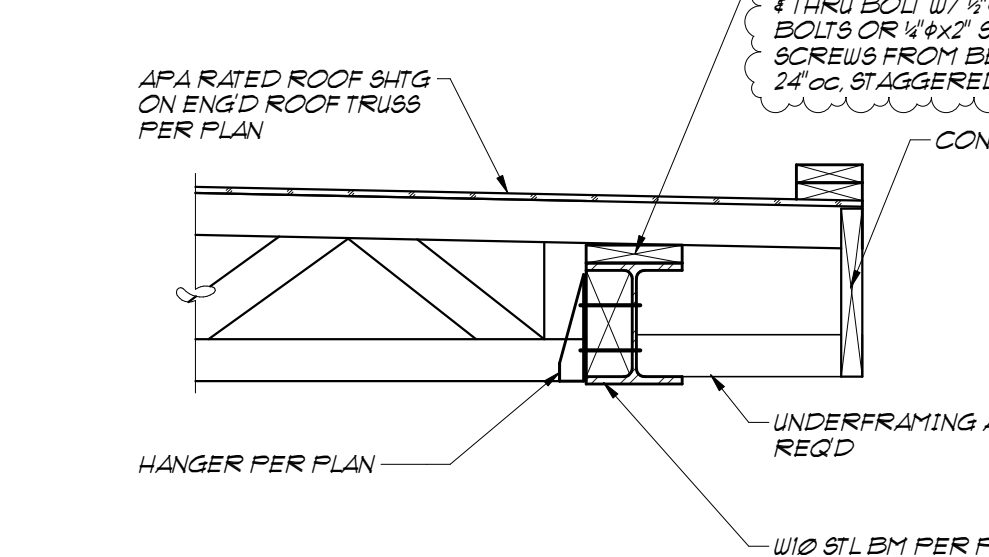


SECTION 22
3/4" x 1'-0" S2.2

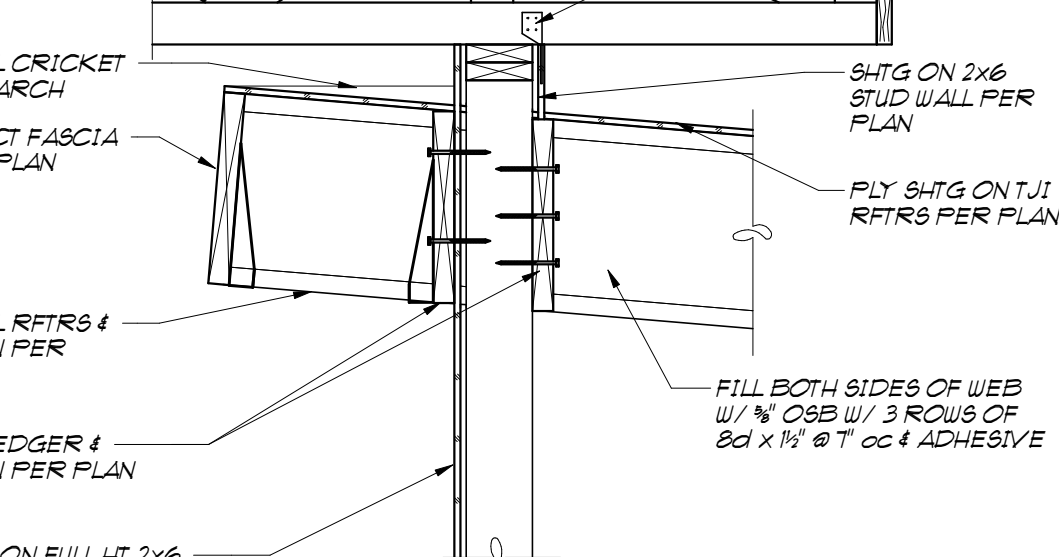


SECTION 21
3/4" x 1'-0" S2.2

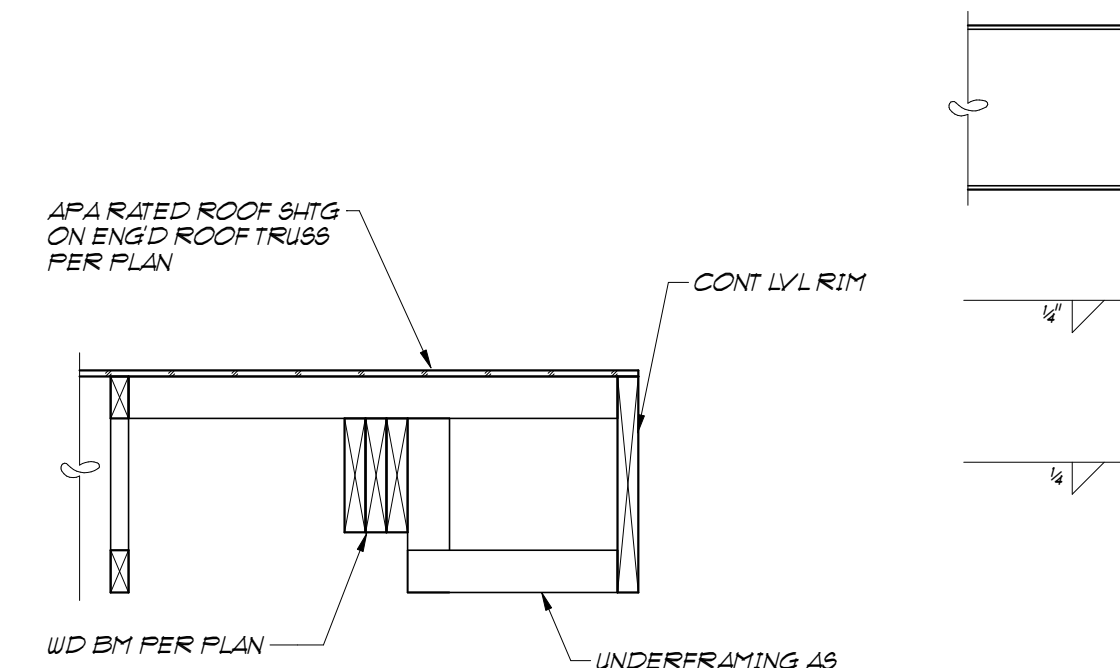


SECTION 30
3/4" x 1'-0" S2.2

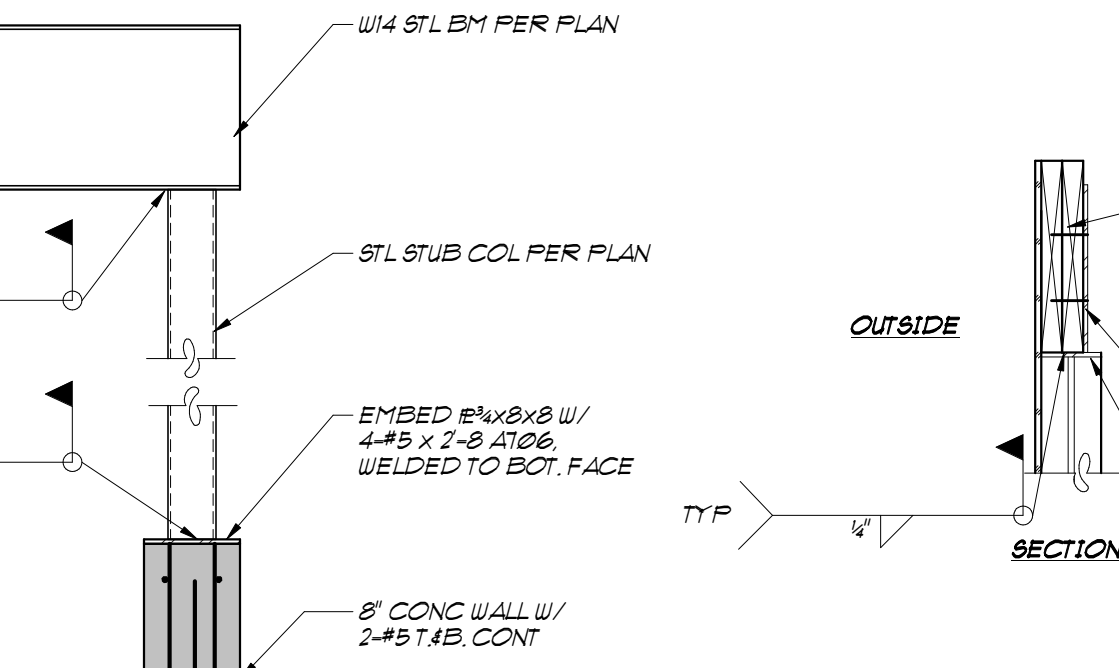


SECTION 29
3/4" x 1'-0" S2.2

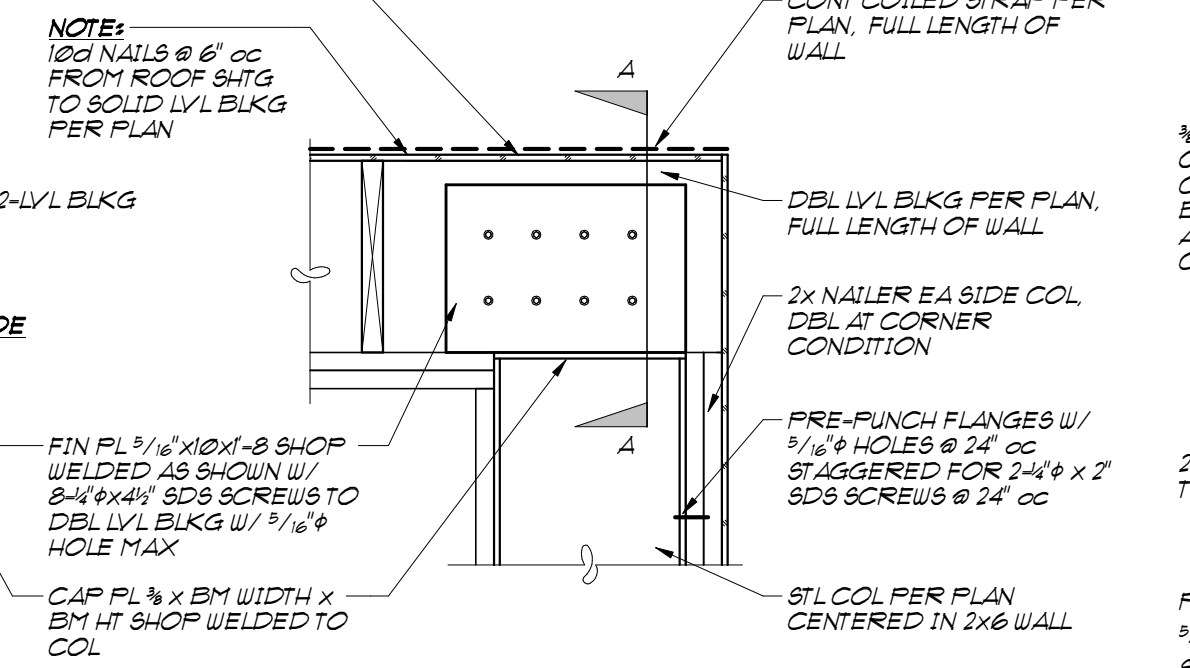


SECTION 28
3/4" x 1'-0" S2.2

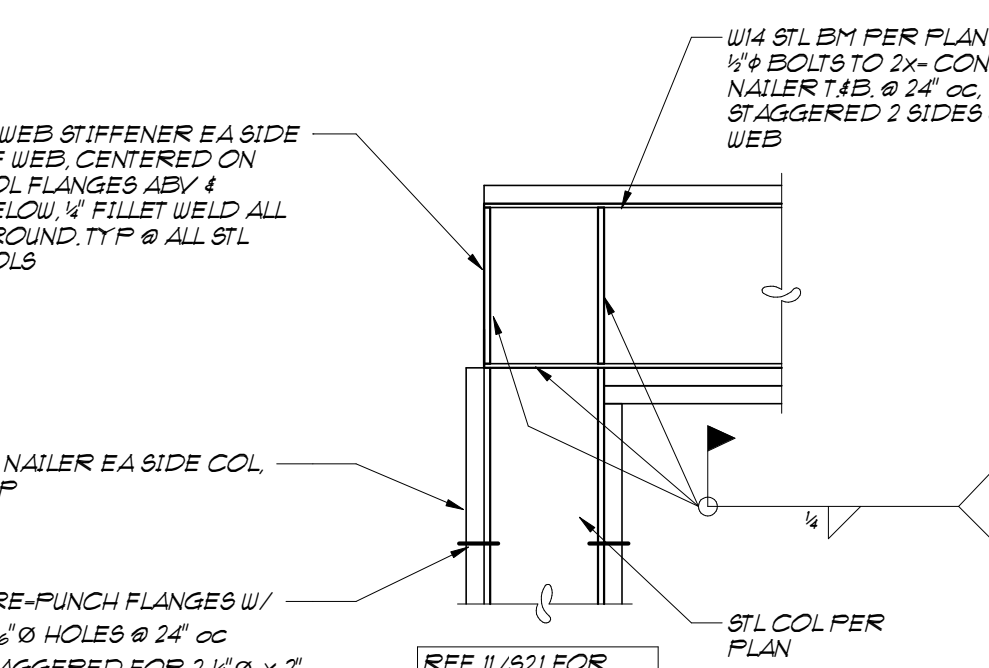


SECTION 27
3/4" x 1'-0" S2.2

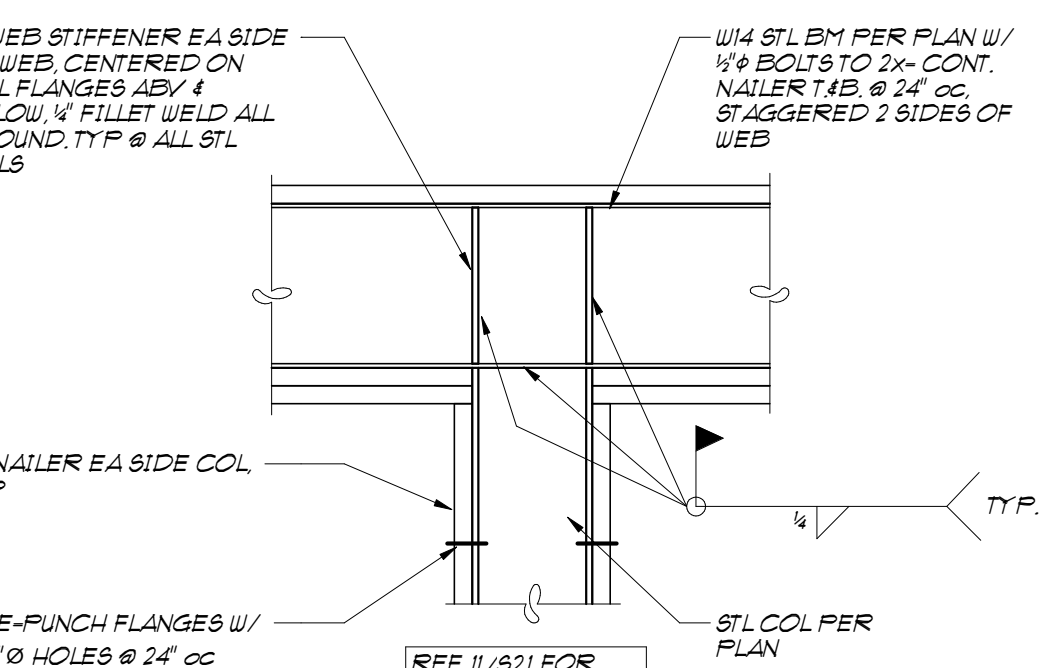


SECTION 26
3/4" x 1'-0" S2.2

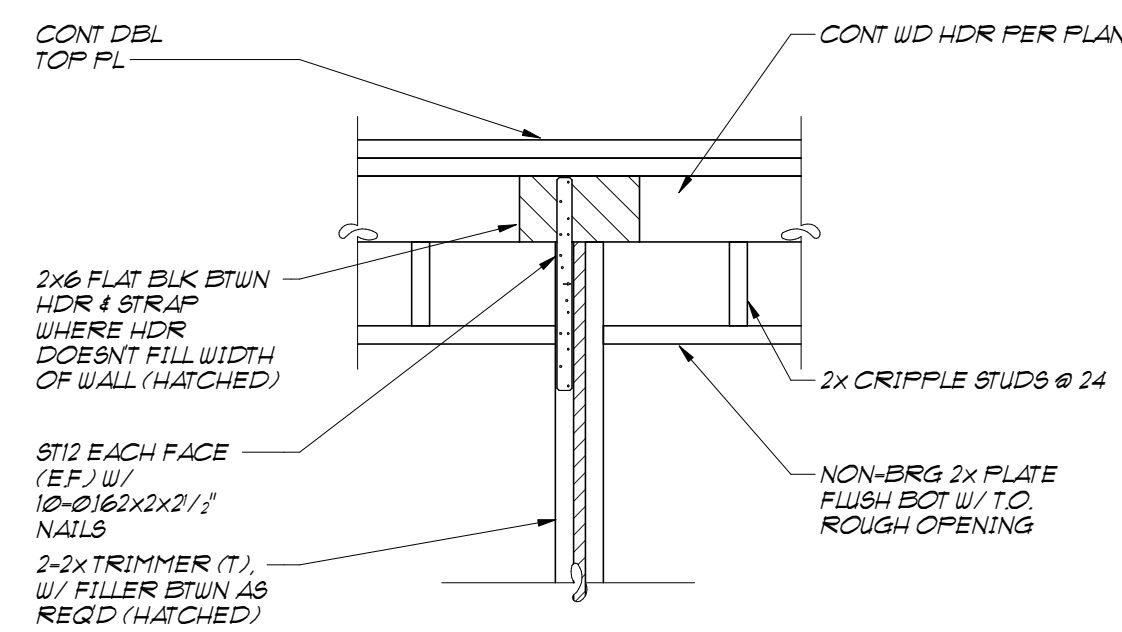


TYPICAL CONTINUOUS HEADER
3/4" x 1'-0" S2.2

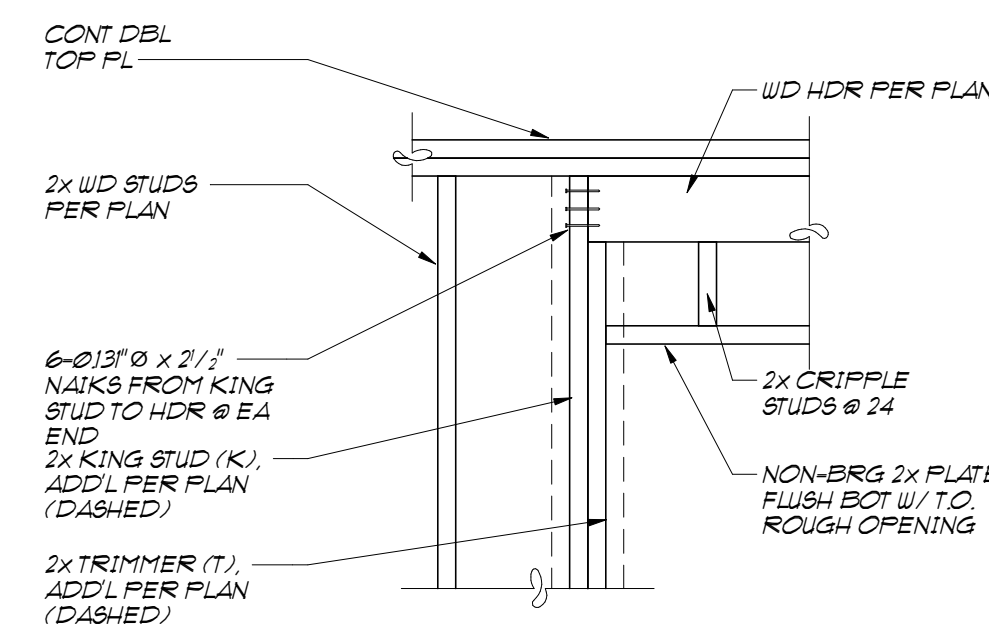


TYPICAL HEADER
3/4" x 1'-0" S2.2

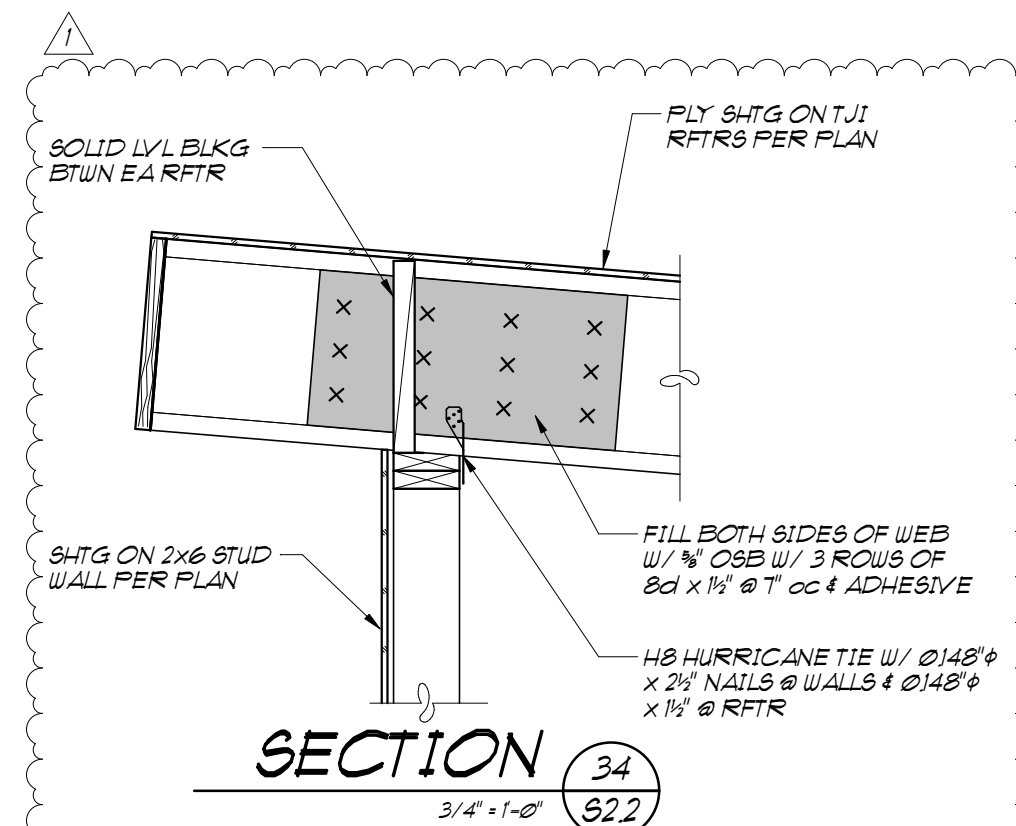


SECTION 34
3/4" x 1'-0" S2.2

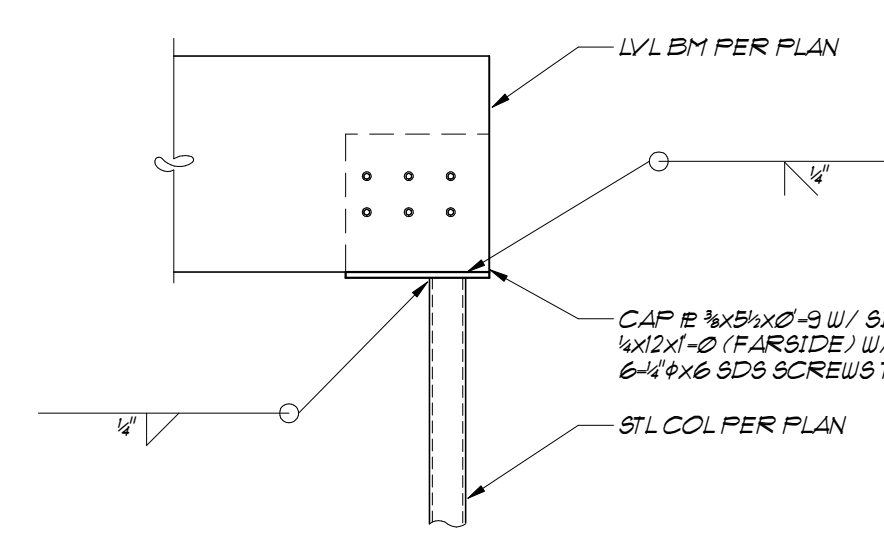


SECTION 33
3/4" x 1'-0" S2.2

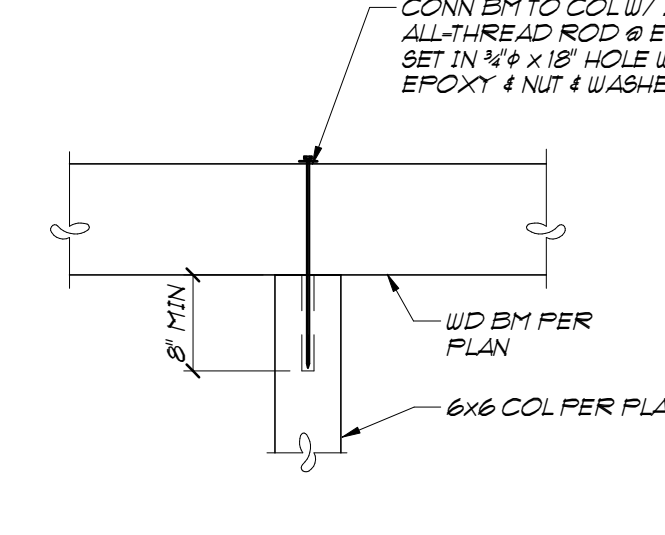

SECTION 32
3/4" x 1'-0" S2.2

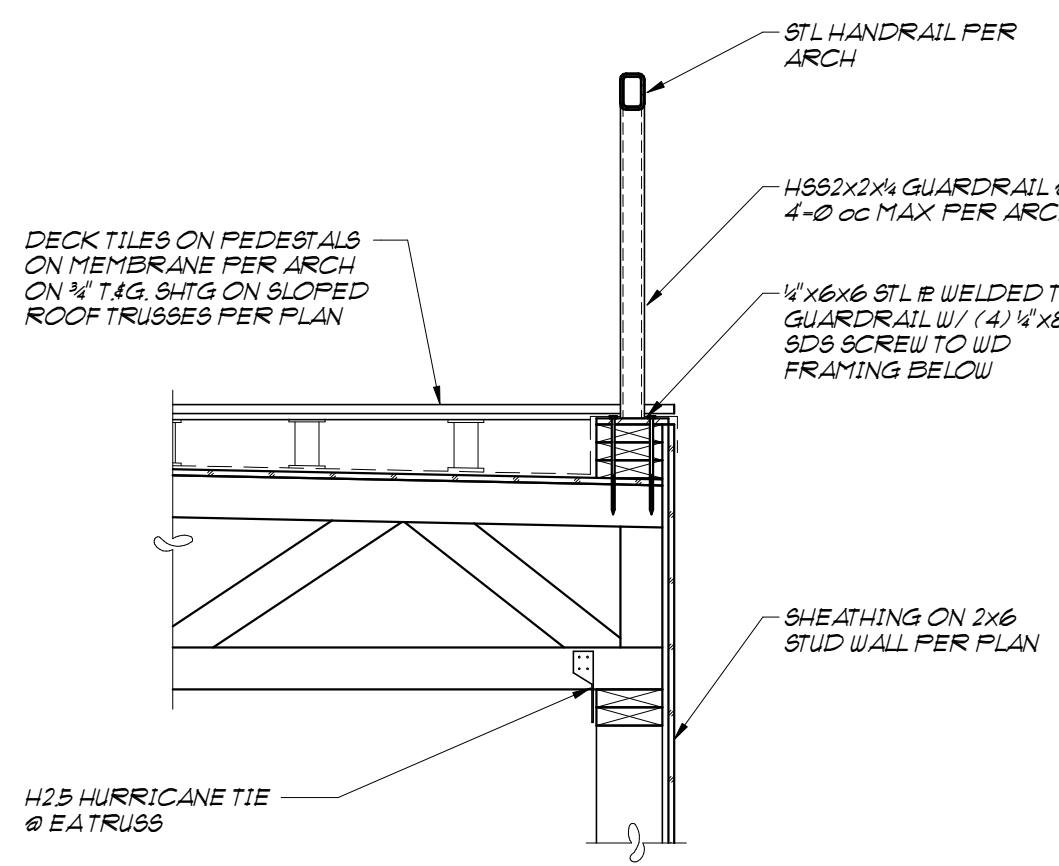

SECTION 31
3/4" x 1'-0" S2.2

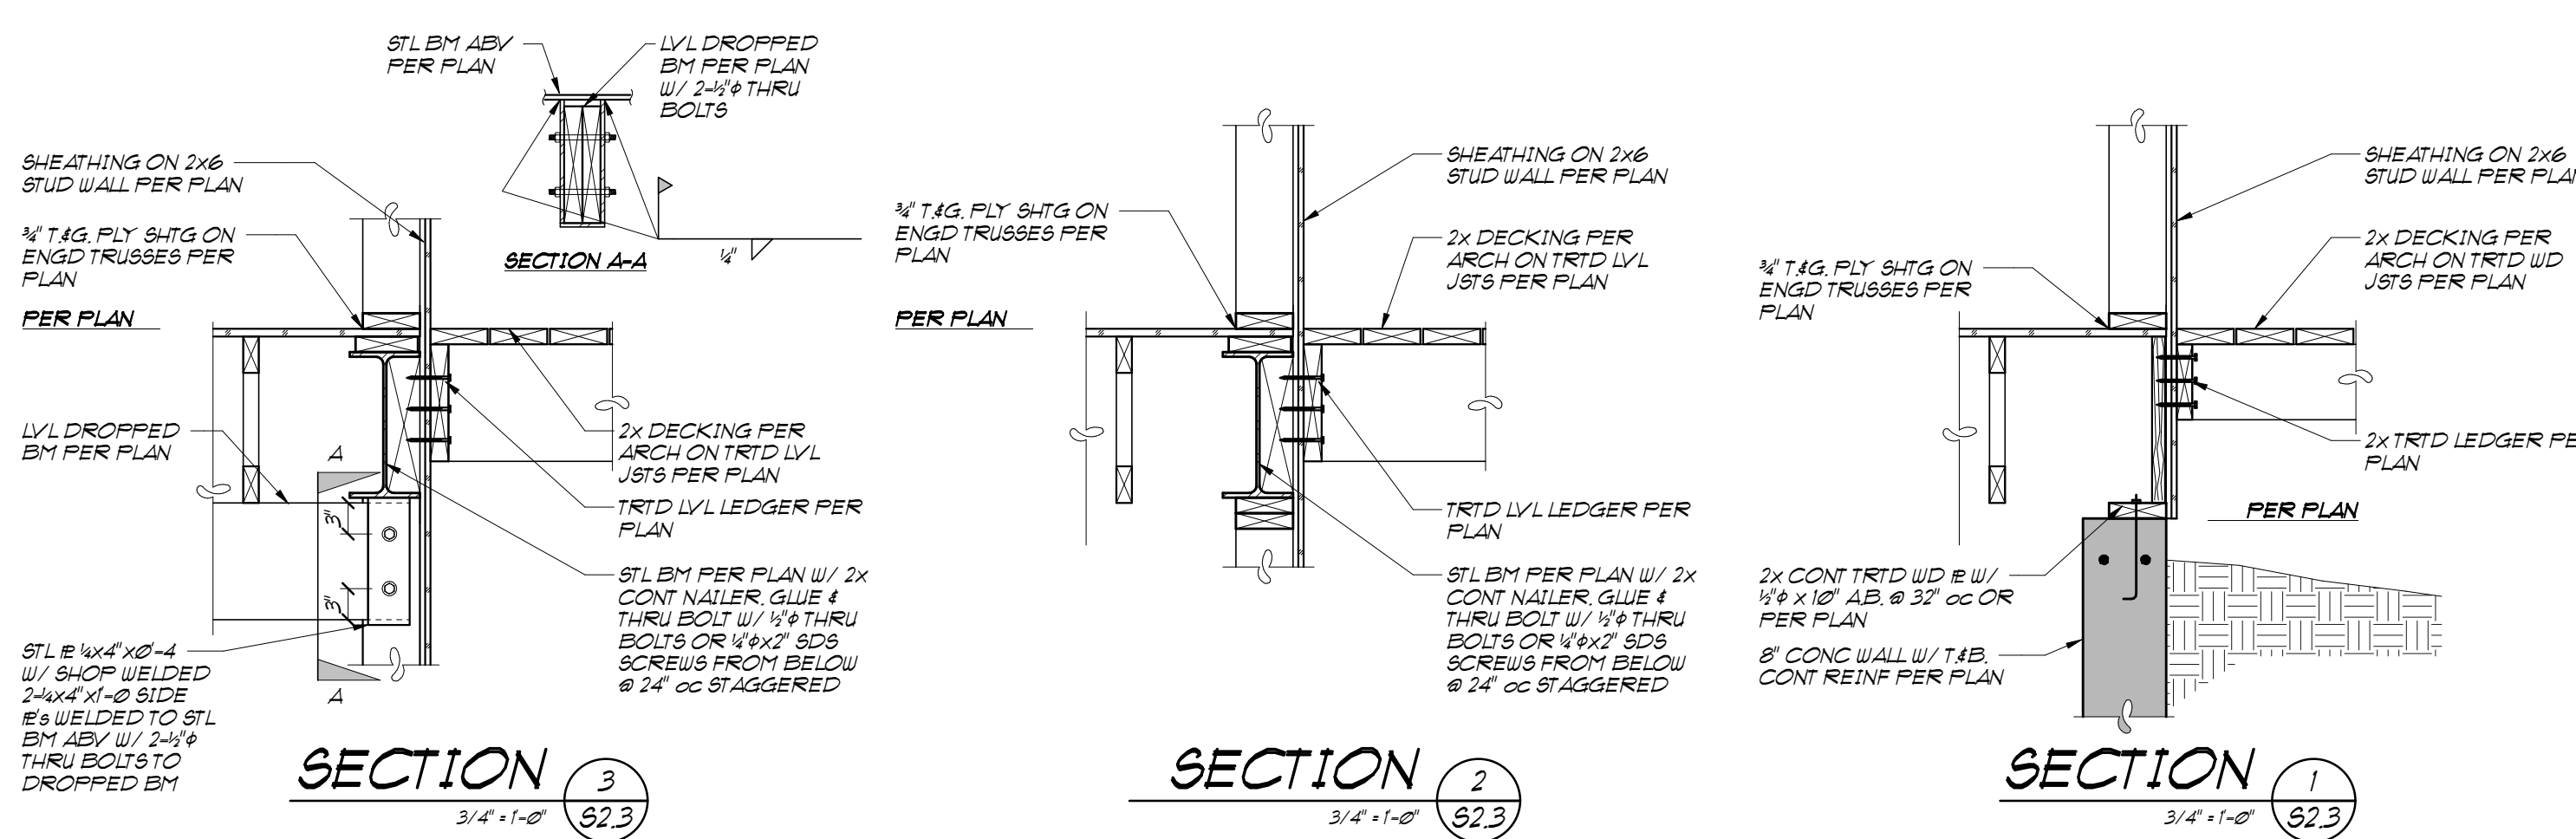

NEW RESIDENCE

1825 SPRING DRIVE

BOULDER, COLORADO

DATE: 03/28/2019

JOB #: 2508

DRAWN BY: MM

CHECKED BY: YK

REVISED: 08/25/2019

52.3

Copyright 2019 GEBAU, INC.
All Rights Reserved

GEBAU INC.

CONSULTING STRUCTURAL ENGINEERS

168 CENTRAL PARKWAY, STE. 100
BOULDER, CO 80501
(930)444-5545, FAX (930)444-3140
mail@gebau.com